


ECHO HILLS ADDITION
ZONED AA

13TH STREET

STREET

GENERAL PROVISIONS

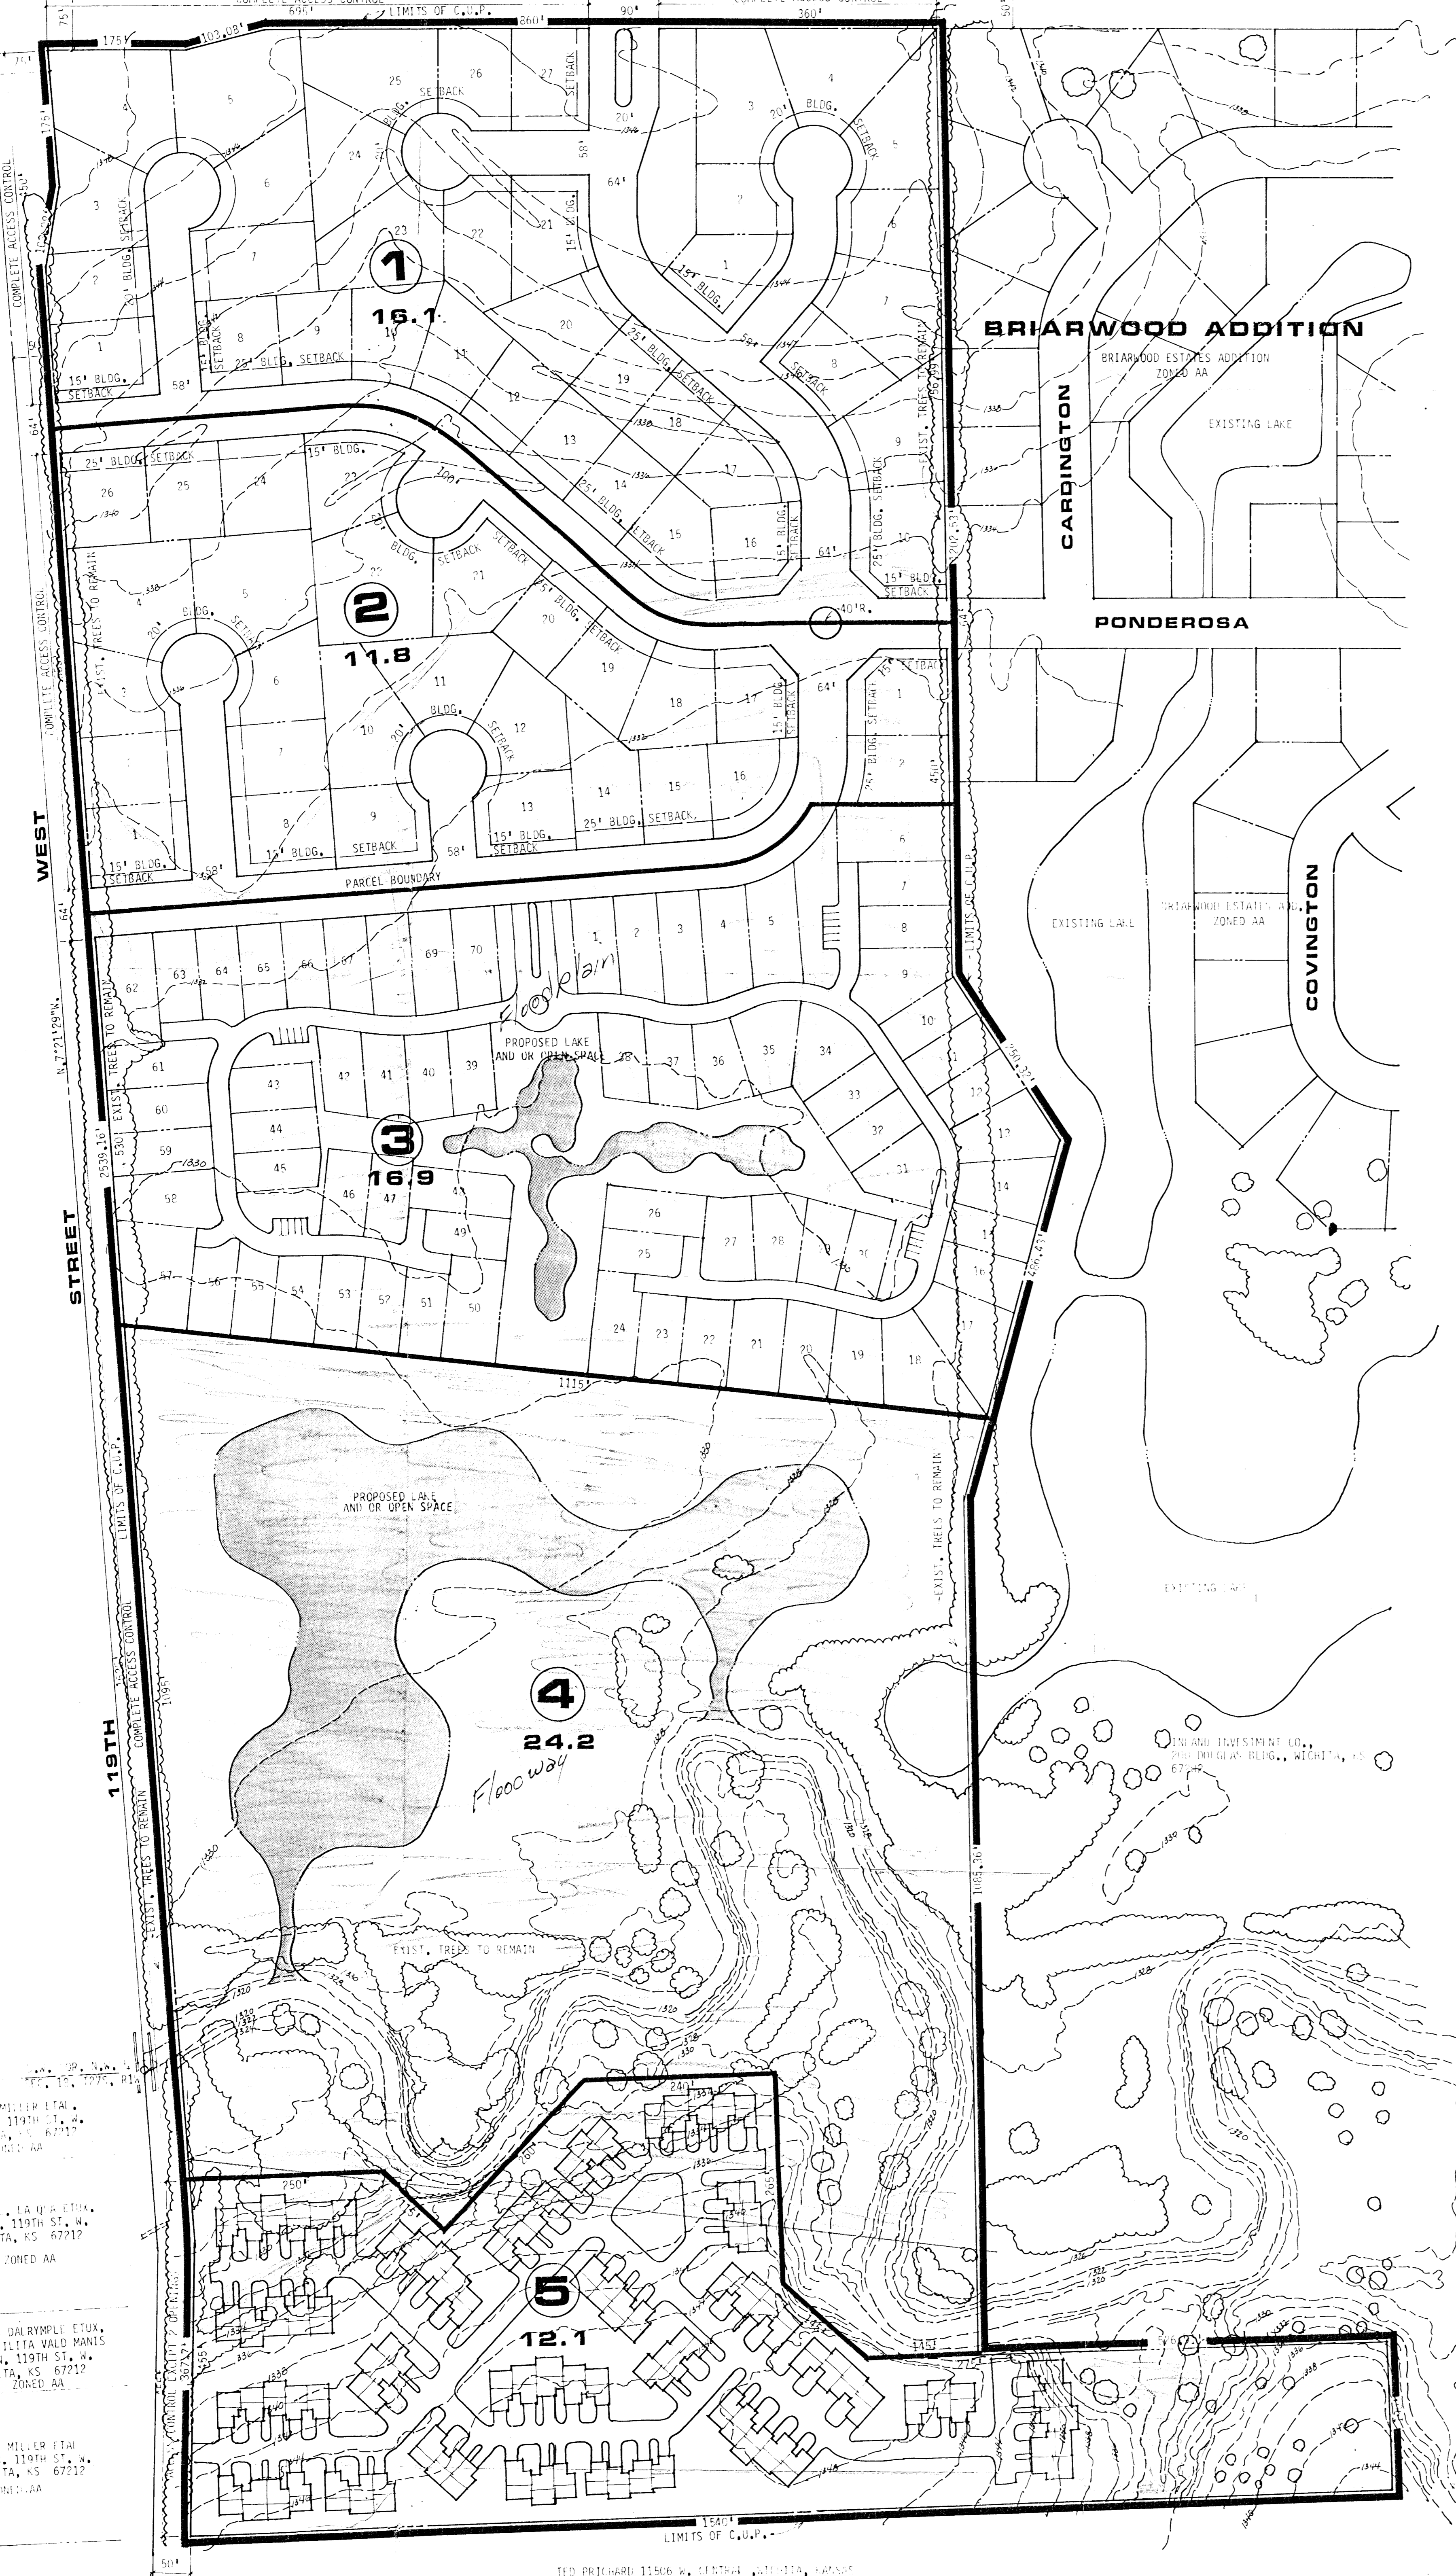

LEGEND

- PARCEL BOUNDARY
- LIMITS OF C.U.P.
- PARCEL NUMBER
- PARCEL AVERAGE

BRIARWOOD C.U.P.

