
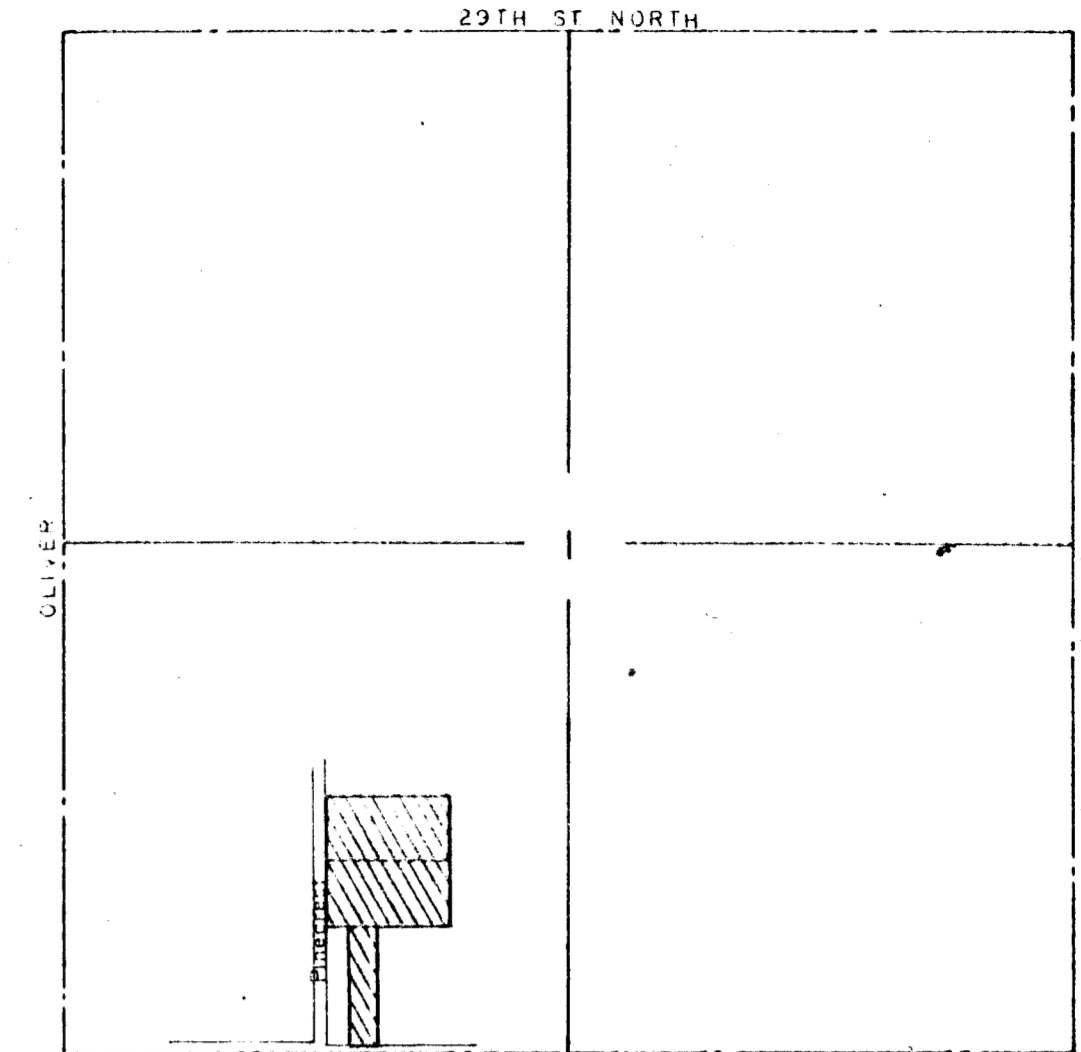


drainage plan
6-1-83

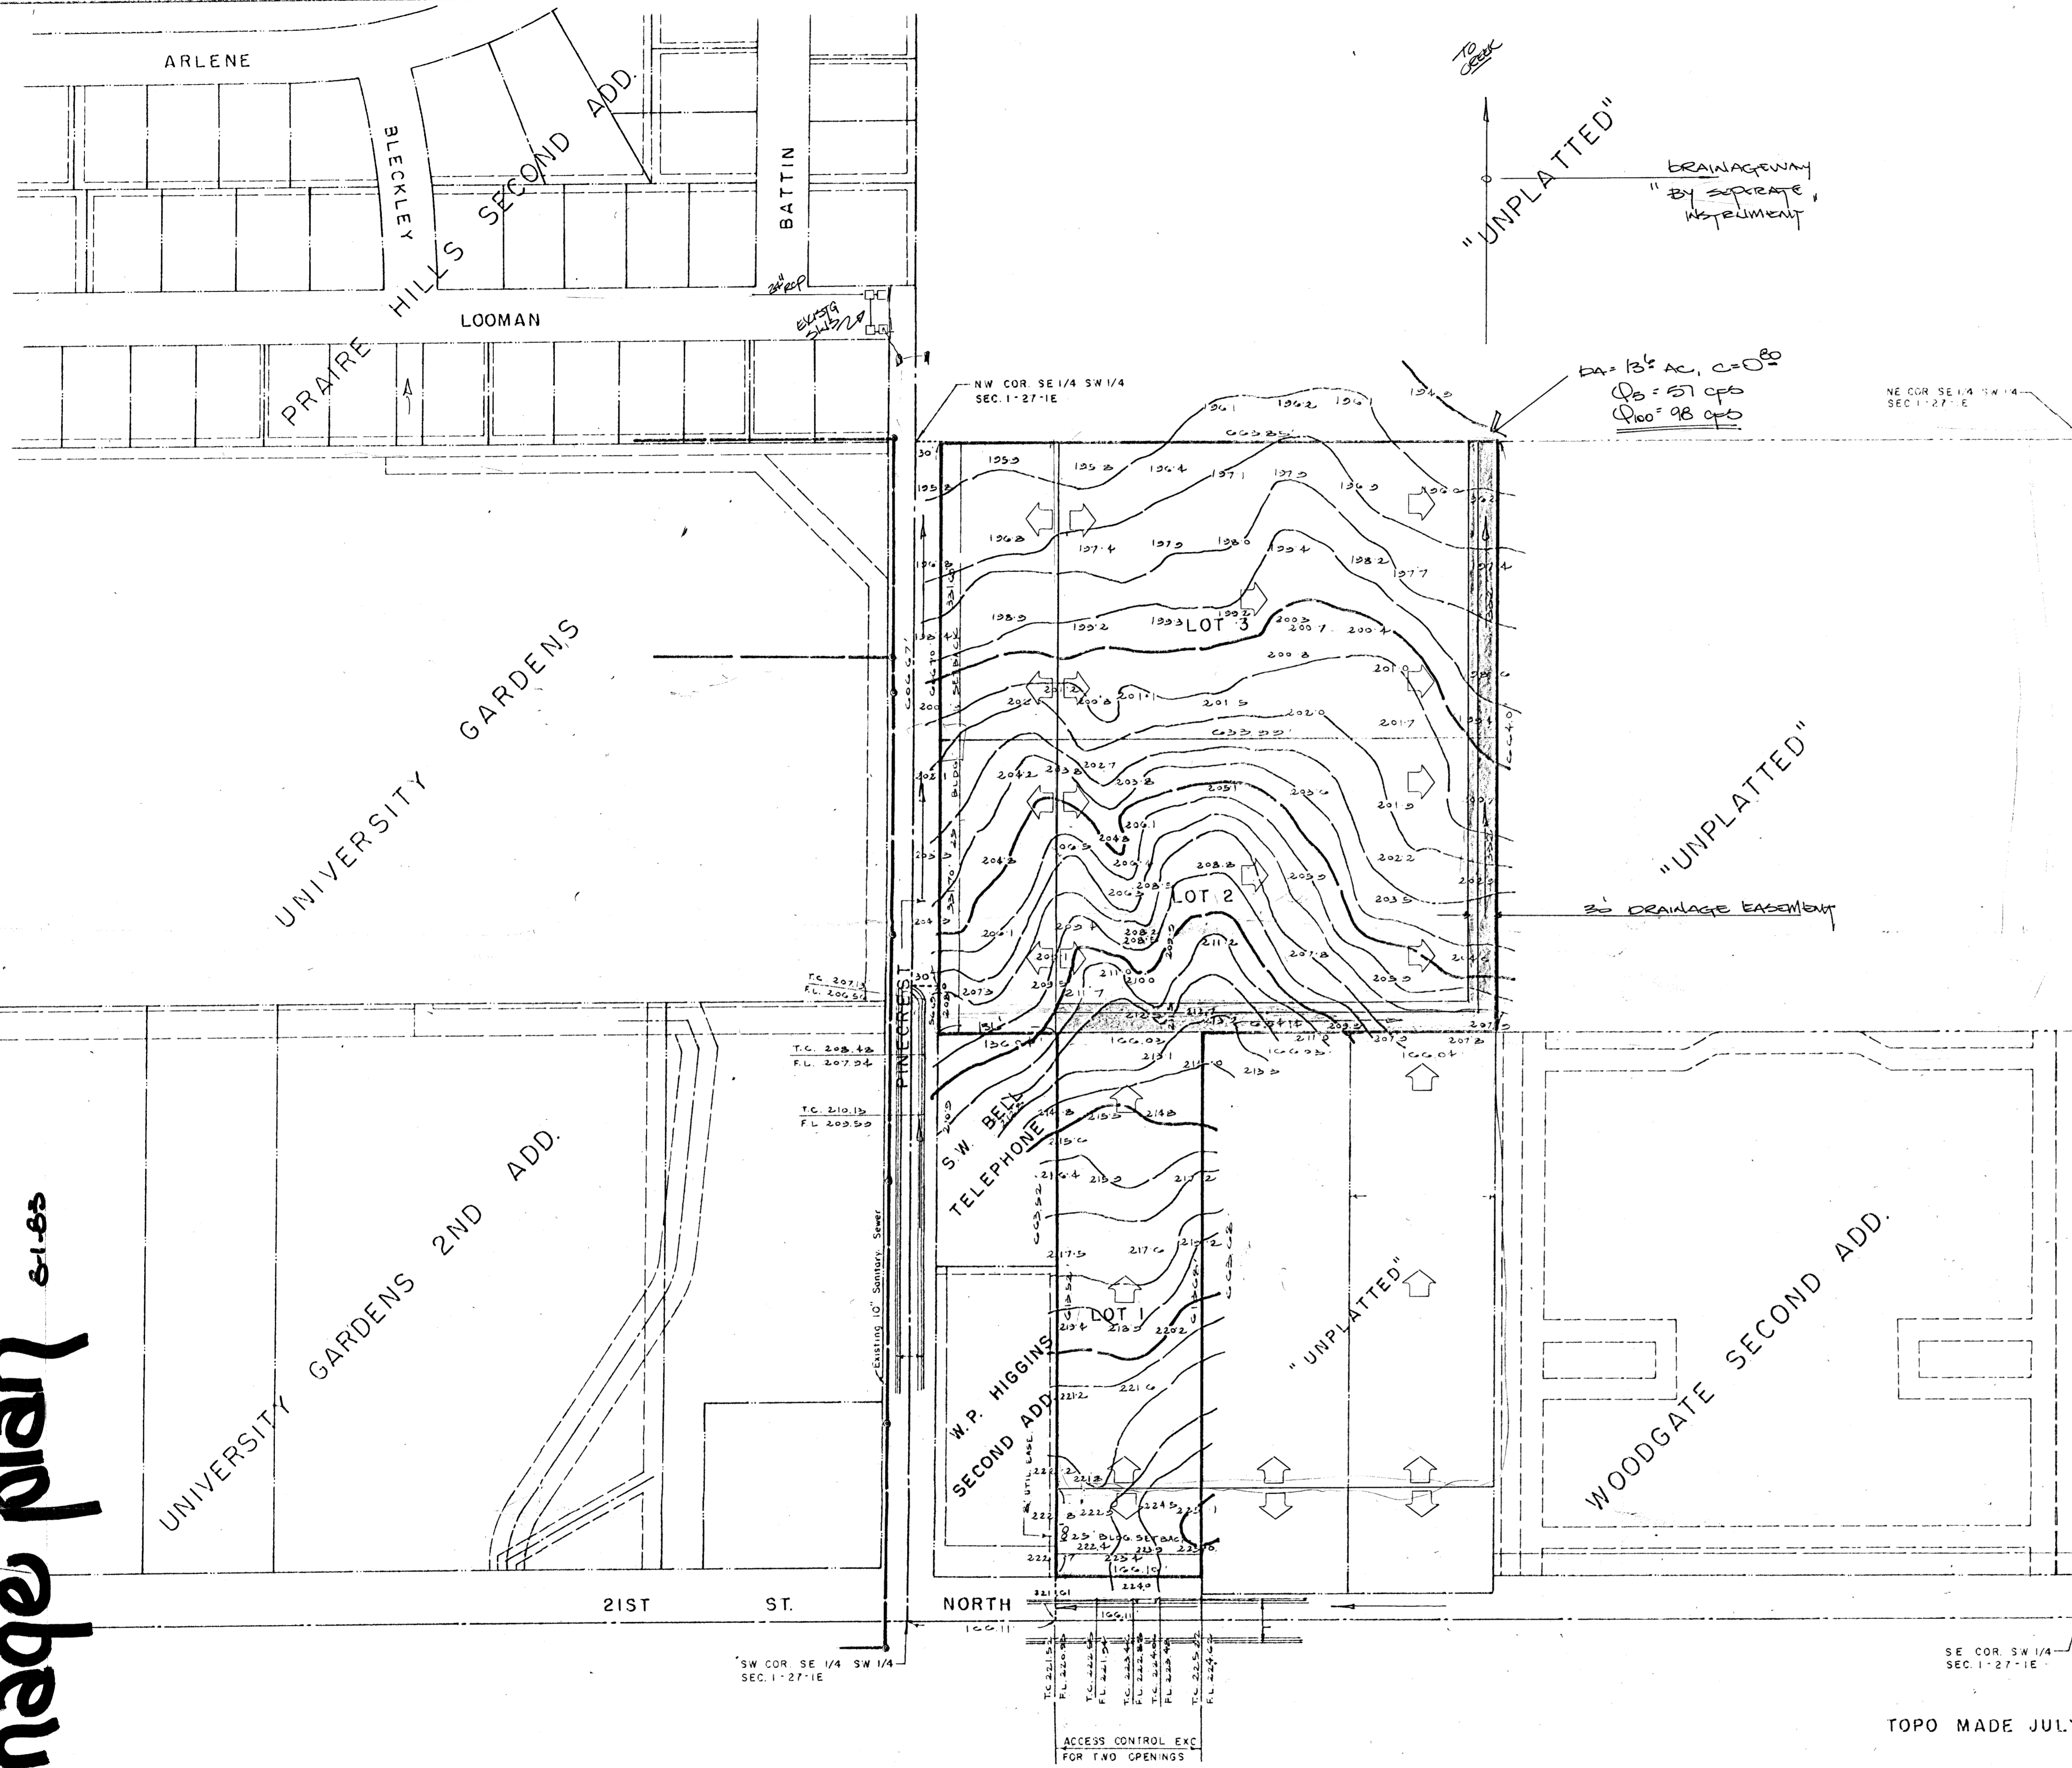

PRELIMINARY PLAT
WICHITA LAND ADDITION

FOR:
WICHITA LAND ASSOCIATES, INC.
1251 S. LONGFELLOW
WICHITA, KANSAS 67207

TOPO MADE JULY 1983

B.M. - ELEV. 221.80 - "□" CUT ON CORNER OF WALK AT SW CORNER OF "WOODGATE SECOND ADDITION."

LOWELL D. HIGH
1542 S. ST. FRANCIS
WICHITA, KS 67211
JULY 21, 1983