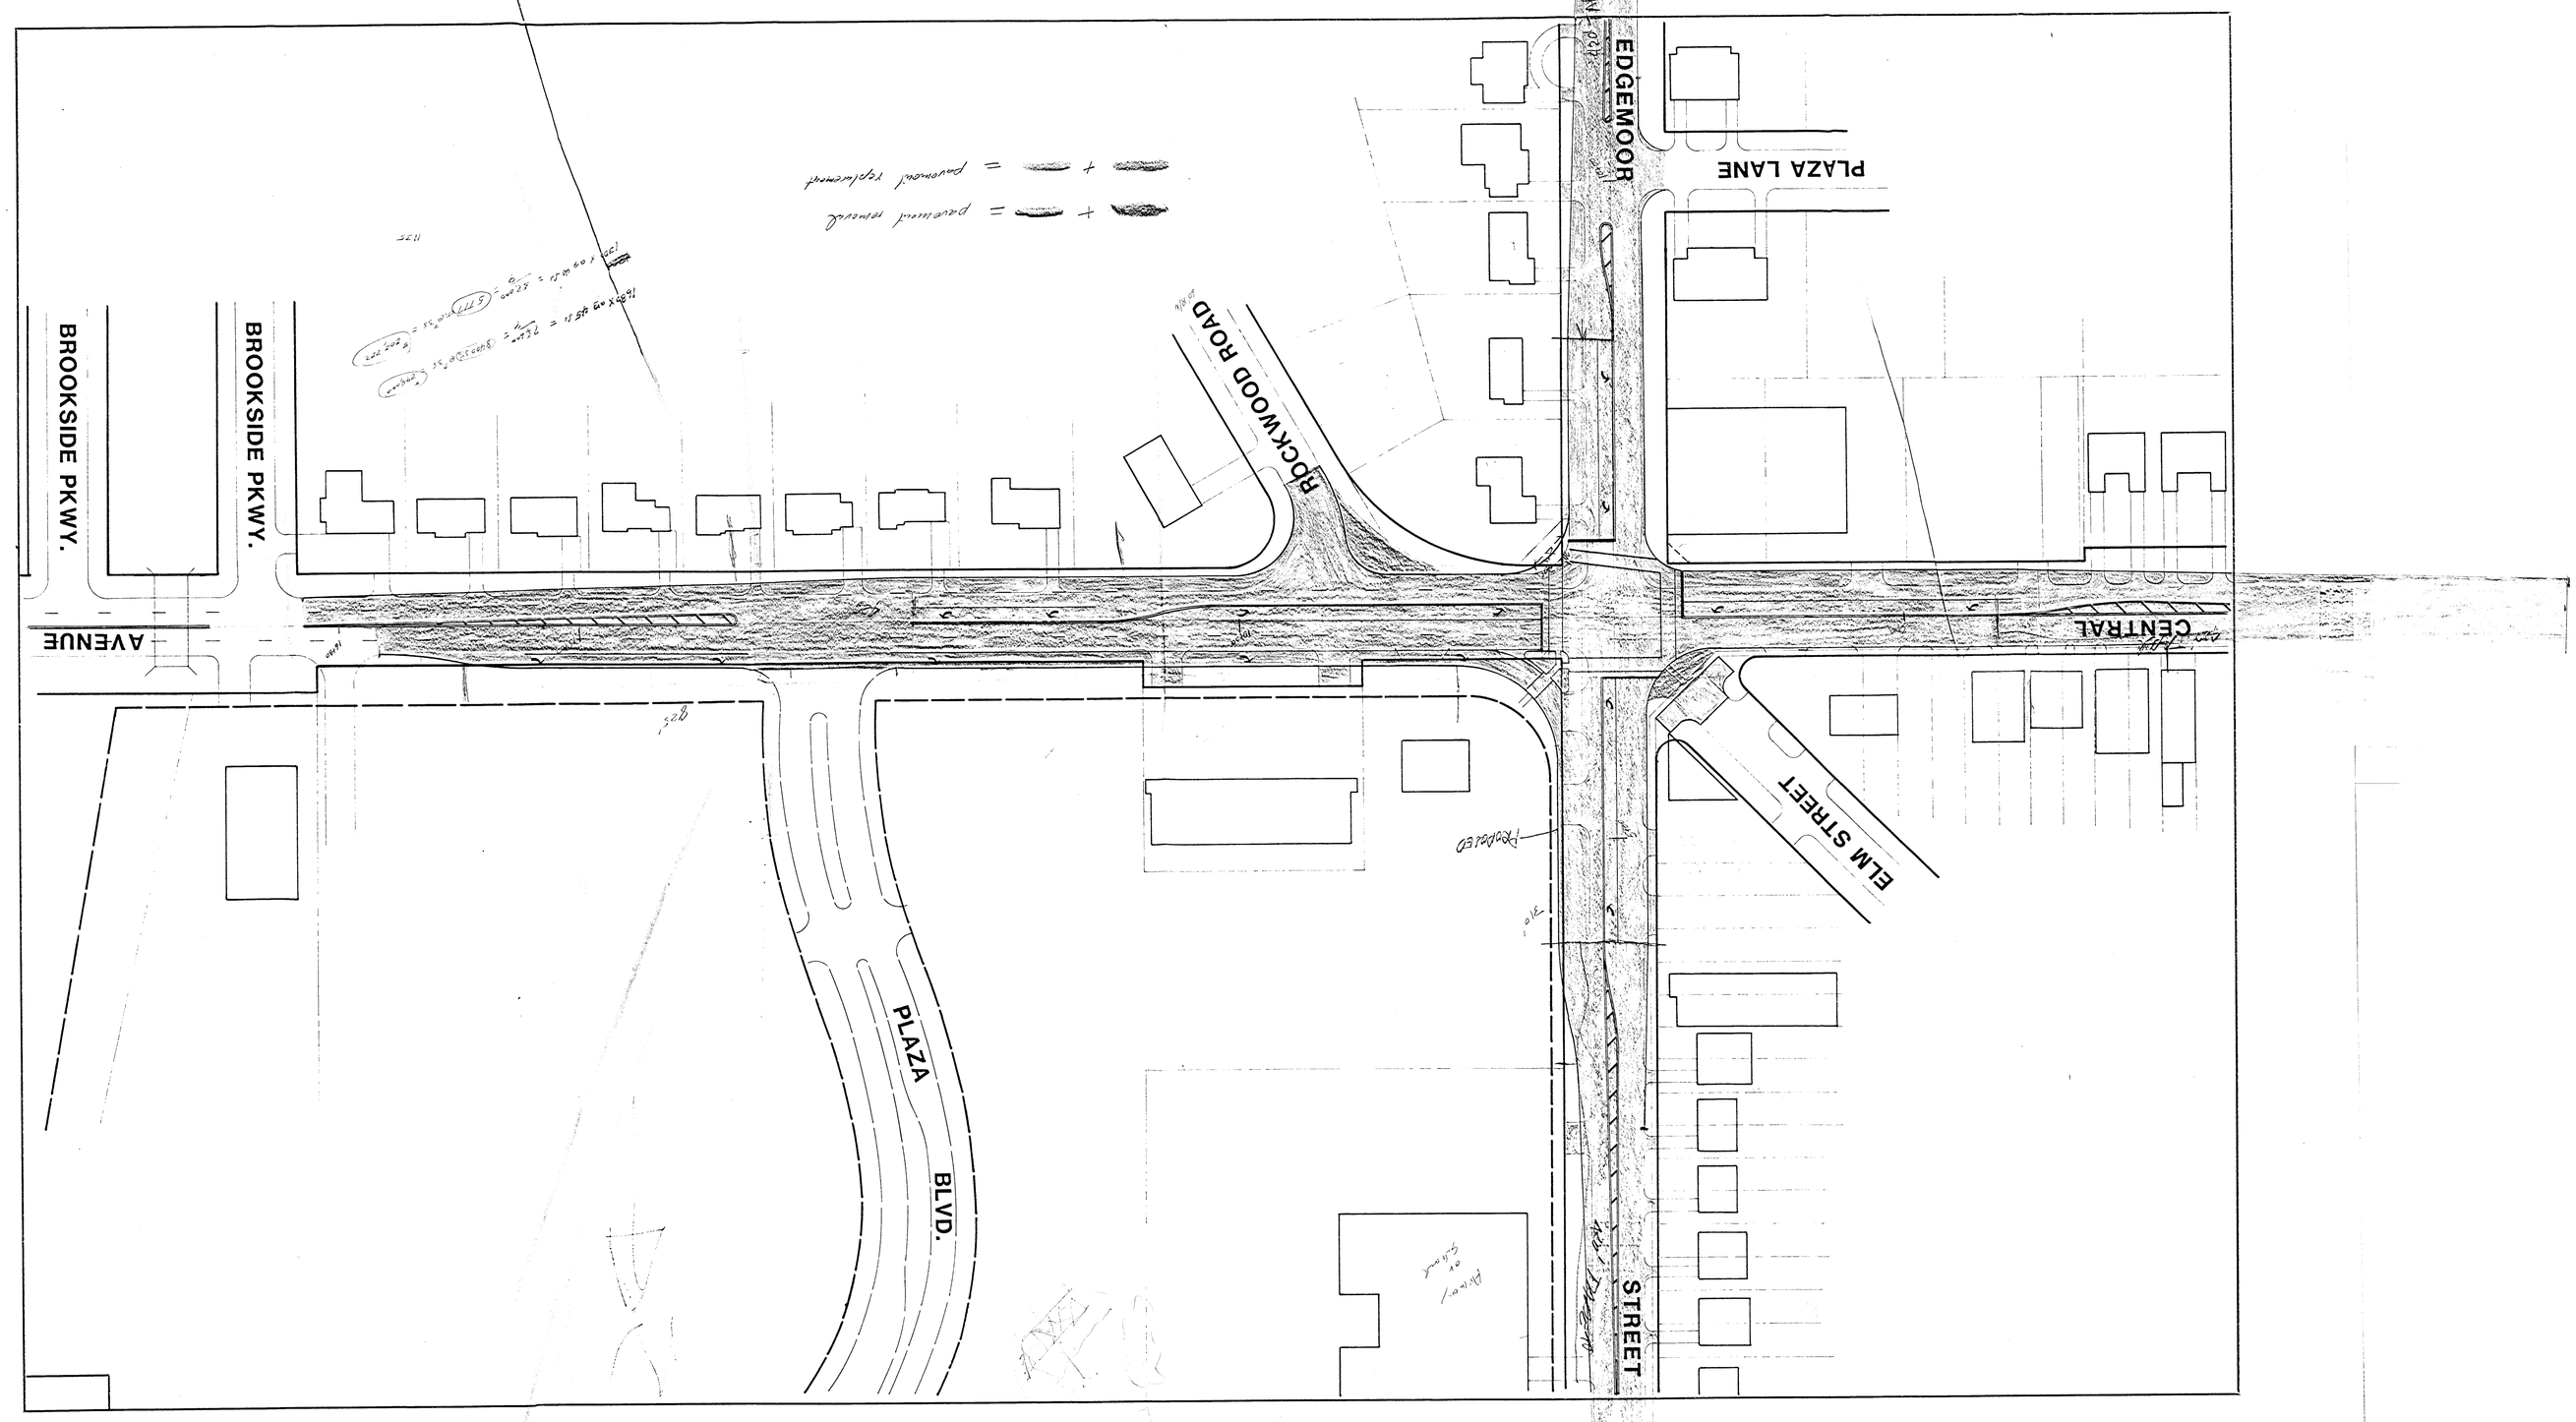
BROOKSIDE PKWY.
BROOKSIDE PKWY.
AVENUE
BOCKWOOD ROAD
EDGEMOOR
PLAZA LANE
CENTRAL
ELM STREET
PLAZA
BLVD.
STREET