

PRELIMINARY PLAT
ESTE CATE SECOND
ADDITION

GREENWOOD AVE. AS PLATTED IN ESTE CATE ADD.
TO BE VACATED AND REPLATTED AS PART OF
LOT 2 BY REPLAT.

MOBILE HOME PARK

INDIAN
SOUTHERN
BAPTIST
CHURCH

LOT 2

LOT 1

HOUSE
265-20


DENKER

DENKER

GREENWOOD

50'x141.4' N 06 MH
Cover existing GRABER ADD.
SS w/ 20' Easement

80' SS
1 MH
25' = 3000
2500 = 2500
4500
7500
6750
Use 6750

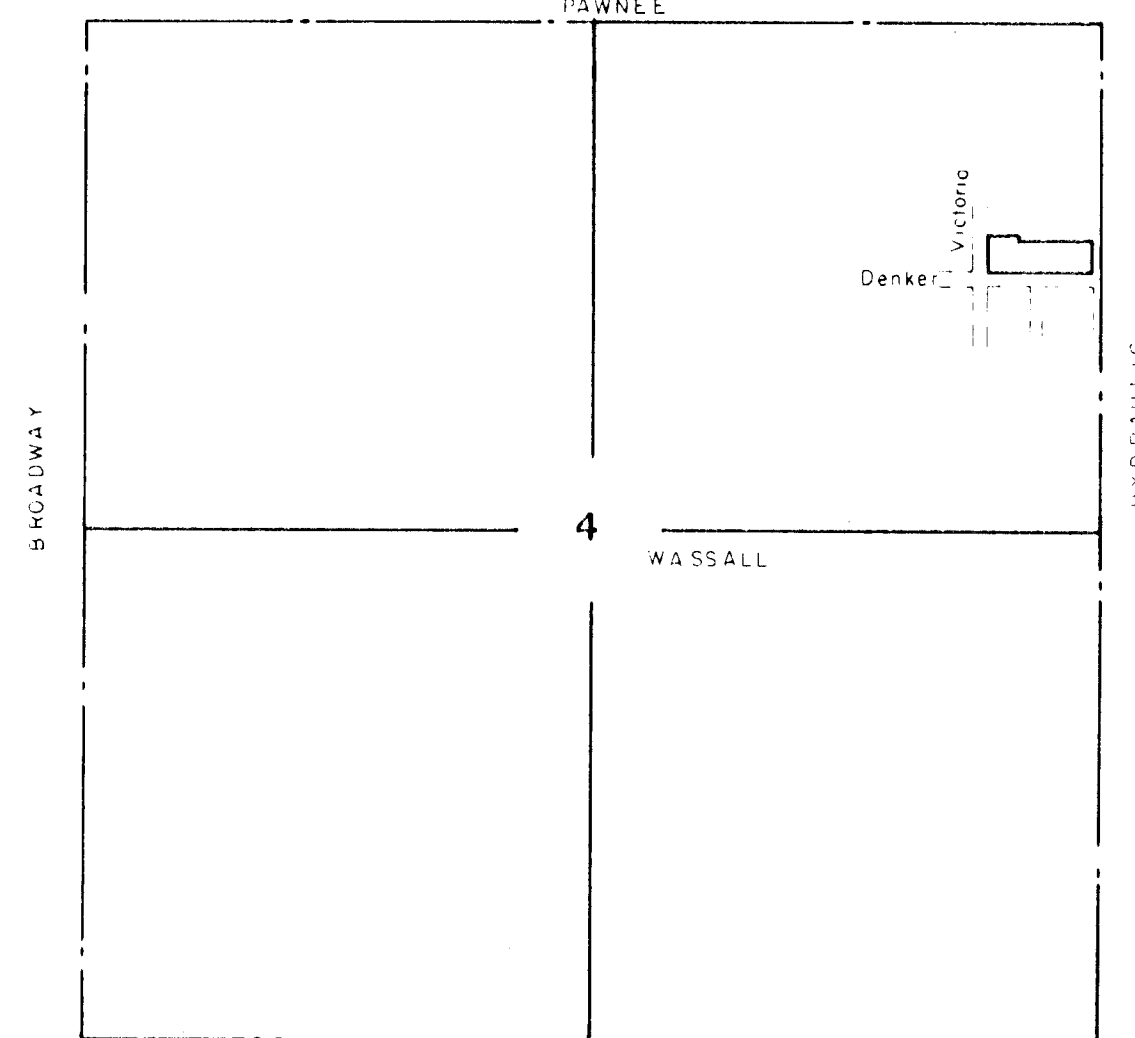

VICINITY MAP
1"=1000'

B.M. - ELEV. 94.46 - NO. RIM MH 23.5' E. & VICTORIA AND 62'
NO. & DENKER.

TOPO MADE MAY 21, 1986.

FOR:
INDIAN SOUTHERN BAPTIST CHURCH
1550 DENKER
WICHITA, KANSAS 67216

LOWELL D. HIGH, L.S.
MAY 22, 1986