



*Place FP Double Check Valve at 10+51 line 1

[illegible]



*Place 8" pvc pipe from meter Vault Line 1 10+51 to 13+69

REMARKS:



PROJECT INSPECTION DAILY REPORT

BAUGHMAN COMPANY, P.A.

WICHITA, KANSAS

PROJECT: Water distribution system improvements

DATE: 10/1/2024

to serve Brewer Community Center

DAY: Tuesday

CITY NUMBER: 2023-026216 PPW

W. D. : OF

BAUGHMAN JOB #: 24-08-E869

INSPECTOR: B.Gibler

UTILITY CONTRACTOR: McCullough Excavation

FOREMAN: Jose

INSPECTOR ON-SITE: 845am-950am, 120pm-210pm

WEATHER: Sunny LOW: 49 °F HI: 75 °F

EQUIPMENT: Loader, Excavator

MATERIALS: Sand, Rock, WCP structures

WORK PERFORMED:

*Place 8" pvc pipe from meter Vault Line 1 13+69

*Place FH at 13+69

REMARKS:



*Place 8" pvc pipe from Line 1 13+69 to 16+66

REMARKS: Dawnita approved for backfill



PROJECT INSPECTION DAILY REPORT

BAUGHMAN COMPANY, P.A. WICHITA, KANSAS

PROJECT: BREWER COMMUNITY CENTER
PRIVATE WATER DISTRIBUTION SYSTEM

DATE: 10-9-24
DAY: WEDNESDAY

CITY NUMBER: 2023-026216 PPW

BAUGHMAN JOB #: 24-08-E869

INSPECTOR: LARRY POWELL

UTILITY CONTRACTOR: McCULLOUGH EXCAVATION

FOREMAN: JOSE

INSPECTOR ON-SITE: 11:55AM - Noon

WEATHER: _____ LOW: 52 °F HI: 88 °F

EQUIPMENT: _____

MATERIALS: _____

WORK PERFORMED: * No WL work today.

REMARKS: * Thursday - Dig Tap Pit.
- P.M. = COW TAP.



PROJECT INSPECTION DAILY REPORT

BAUGHMAN COMPANY, P.A. WICHITA, KANSAS

PROJECT: BREWER COMMUNITY CENTER DATE: 10-10-24
PRIVATE WATER DISTRIBUTION SYSTEM DAY: THURSDAY

CITY NUMBER: 2023-026216 PPW

BAUGHMAN JOB #: 24-08-E869 INSPECTOR: LARRY POWELL

UTILITY CONTRACTOR: McCULLOUGH EXCAVATION FOREMAN: JOSE

INSPECTOR ON-SITE: 12:33 PM - 12:45 PM

WEATHER: Sunny, Lt. Wind LOW: 60 °F HI: 88 °F

EQUIPMENT: _____

MATERIALS: _____

WORK PERFORMED: *Crew will Cut Street Pvm't
and excavate TAP pit this PM.

REMARKS: *COW TAP Friday?



PROJECT INSPECTION DAILY REPORT

BAUGHMAN COMPANY, P.A. WICHITA, KANSAS

PROJECT: BREWER COMMUNITY CENTER

DATE: 10-11-24

PRIVATE WATER DISTRIBUTION SYSTEM

DAY: FRIDAY

CITY NUMBER: 2023-026216 PPW

BAUGHMAN JOB #: 24-08-E869

INSPECTOR: LARRY POWELL

UTILITY CONTRACTOR: McCULLOUGH EXCAVATION

FOREMAN: JOSE

INSPECTOR ON-SITE: 10:06AM-10:12AM 2:29PM-2:35PM

WEATHER: Sunny, Lt Wind LOW: 54 °F HI: 90 °F

EQUIPMENT:

MATERIALS:

WORK PERFORMED: * PC Concrete Permit now removed.

* TAP Pit being excavated.

- Exposed 8" Duct Water Main.

- TAP pit looks to be correct.

- Cleaning Duct Pipe with Wire Brush @ TAP location.

REMARKS: * No Crew work @ 10:06AM.

* TAP Monday AM.



PROJECT INSPECTION DAILY REPORT

BAUGHMAN COMPANY, P.A.

WICHITA, KANSAS

PROJECT: BREWER COMMUNITY CENTER

DATE: 10-14-24

PRIVATE WATER DISTRIBUTION SYSTEM

DAY: MONDAY

CITY NUMBER: 2023-026216 PPW

BAUGHMAN JOB #: 24-08-E869

INSPECTOR: LARRY POWELL

UTILITY CONTRACTOR: McCULLOUGH EXCAVATION

FOREMAN: JOSE

INSPECTOR ON-SITE: 11:56 AM - 12:06 PM 3:20 PM - 4:48 PM

WEATHER: Sunny, Lt. Winds LOW: 46 °F HI: 68 °F

EQUIPMENT: Excavator Komatsu, Front End Loader

MATERIALS: CLOW 8" Gate Valve, 3-20' 8" PVC Northern Pipe Products

WORK PERFORMED: * WL Work Continued.

* CLOW TAP Valve installed by COW.

3:25 PM - Crew began/continued Excavation for WL-1 between TAP Valve & Vault. UnMarked Pipe uncovered.

■ 8" DR-11 w/ Tracer Wire Black PVC with Purple Stripes (Probably Contaminated Water - Force Main).

■ This pipe in Plan "Profile" of Line 1, Conflict.
- See Sketch Page 2.

REMARKS: * I shall contact Dawnita Tuesday AM to discuss acceptable Options.

- New Fire Service Line goes down + under.

- Ex. Black PVC Pipe goes down + under.

- New Fire Service Line goes down + under AND Black Pipe is "Encased".




BAUGHMAN COMPANY, P.A.

ENGINEERING, SURVEYING & PLANNING

316/262-7271 FAX 316/262-0149 WICHITA, KANSAS 67211

Project Name	BREWER COMMUNITY CENTER - PRIVATE WATER DISTRIBUTION		
City Project No.	2023-026216 PPW	See 10-25-24 for	
Baughman No.	24-08-E869	Date:	10-14-24
Contractor	McCULLOUGH EXCAVATION	Inspector:	LARRY POWELL
Description	As-Built Measurements - LINE 1		

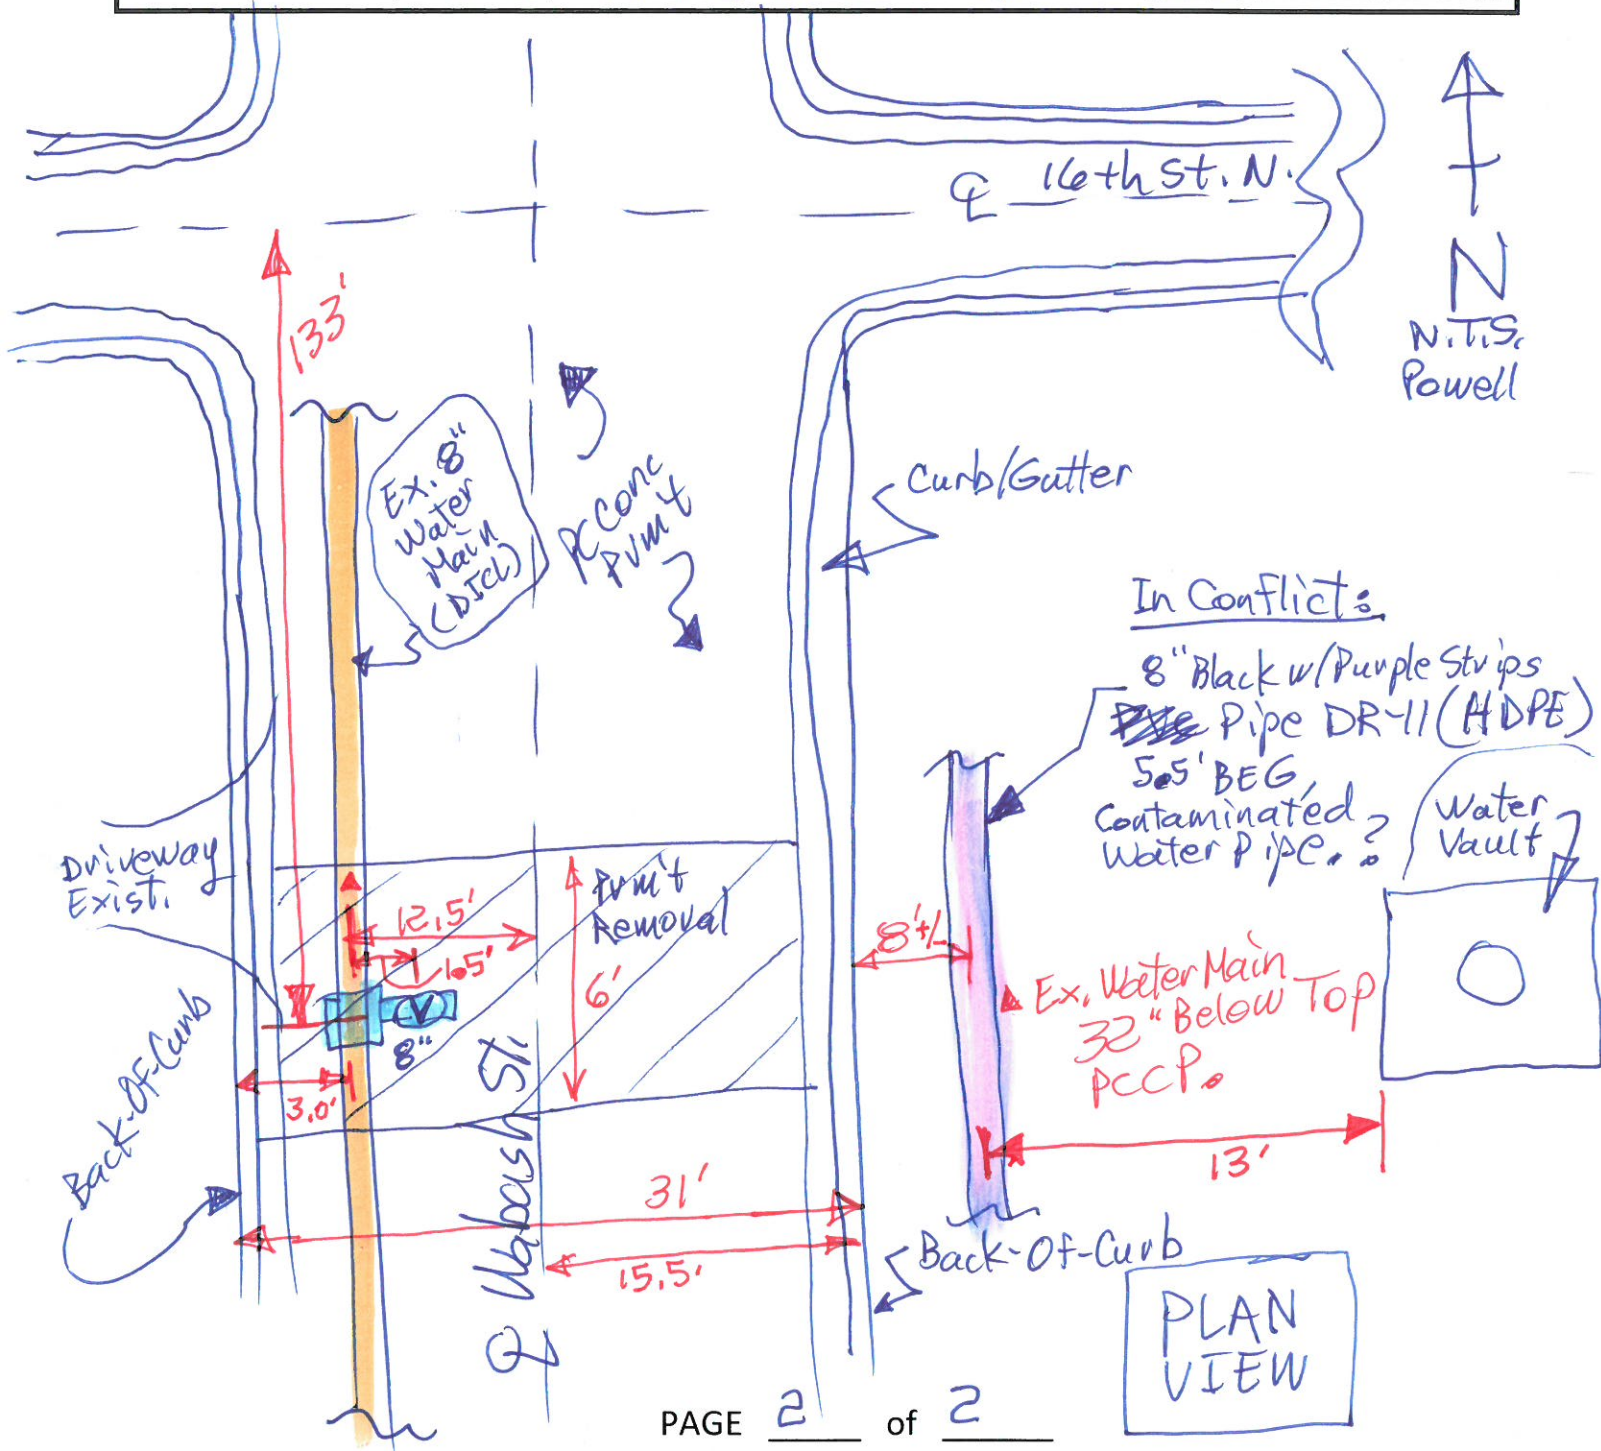



PROJECT INSPECTION DAILY REPORT

BAUGHMAN COMPANY, P.A.

WICHITA, KANSAS

PROJECT: BREWER COMMUNITY CENTER
PRIVATE WATER DISTRIBUTION SYSTEM

DATE: 10-16-24
DAY: WEDNESDAY

CITY NUMBER: 2023-026216 PPW

BAUGHMAN JOB #: 24-08-E869

INSPECTOR: LARRY POWELL

UTILITY CONTRACTOR: McCULLOUGH EXCAVATION

FOREMAN: JOSE

INSPECTOR ON-SITE: 4:11 PM - 4:25 PM

WEATHER: Sunny, Lt Wind LOW: 30 °F HI: 64 °F

EQUIPMENT: _____

MATERIALS: _____ Abbey

WORK PERFORMED: Met Ryan M. + Rob G + ~~Abbey~~ on-site.
• McCullough wants to concrete encase black
contaminated Water Pipe.
They will talk to COW.

REMARKS: 13' Water Vault to E Black Pipe.



PROJECT INSPECTION DAILY REPORT

BAUGHMAN COMPANY, P.A.

WICHITA, KANSAS

PROJECT: BREWER COMMUNITY CENTER

DATE: 10-24-24

PRIVATE WATER DISTRIBUTION SYSTEM

DAY: THURSDAY

CITY NUMBER: 2023-026216 PPW

BAUGHMAN JOB #: 24-08-E869

INSPECTOR: LARRY POWELL

UTILITY CONTRACTOR: McCULLOUGH EXCAVATION

FOREMAN: JOSE +4

INSPECTOR ON-SITE: 11:56AM - 4:10PM

WEATHER: Sunny, Windy LOW: 53 °F HI: 93 °F

EQUIPMENT: Excavator, Trench Box, Front End Loader

MATERIALS: 8" PVC Pipe^{RT}, 16" ϕ HDPE x 28.8' Length Casing Pipe, 8" DICI American

WORK PERFORMED: Westlake 20" O.D. DR-11 * Continued Water Line FP-1 Work: *

- Continued Excavation in Street Zone. Set Trench Box.
- Installed Anchor Coupling at TAP Valve (8").
- Attached 45° Bend (V) to Anchor Coupling. Installed 8" DICI Diagonal Pipe & 45° Bend (V).
- Trimmed DICI Pipe on West Side Vault. Not set into Trench yet.
- Moved Blue & Black Pipe to Street.
- Reset Orange Safety Fence around open street trench.

REMARKS: * Plan = New 8" PVC Pipe down + under (90° Bends (V))
Black Contaminated Water Pipe. New Blue PVC Pipe to
be sleeved with HDPE Pipe.


• 11" OD Blue 8" AK RT (Westlake) center-Lok C-900 DR-18

• Abbey, Rob, Ryan on-site visit @ 2:05 PM. (McCullough)

• SWS MTLid on Water Vault. = Wrong.

• Rob G - Stated when asked - Crew will place shims inside Casing Pipe. Dawnita scheduled for 2 PM.

Project Name	BREWER COMMUNITY CENTER - PRIVATE WATER DISTRIBUTION		
City Project No.	2023-026216 PPW	(see 10-25-24 for more measurements)	
Baughman No.	24-08-E869	Date:	10-24-24
Contractor	McCULLOUGH EXCAVATION	Inspector:	LARRY POWELL
Description	FPLine 1 - As-Built		

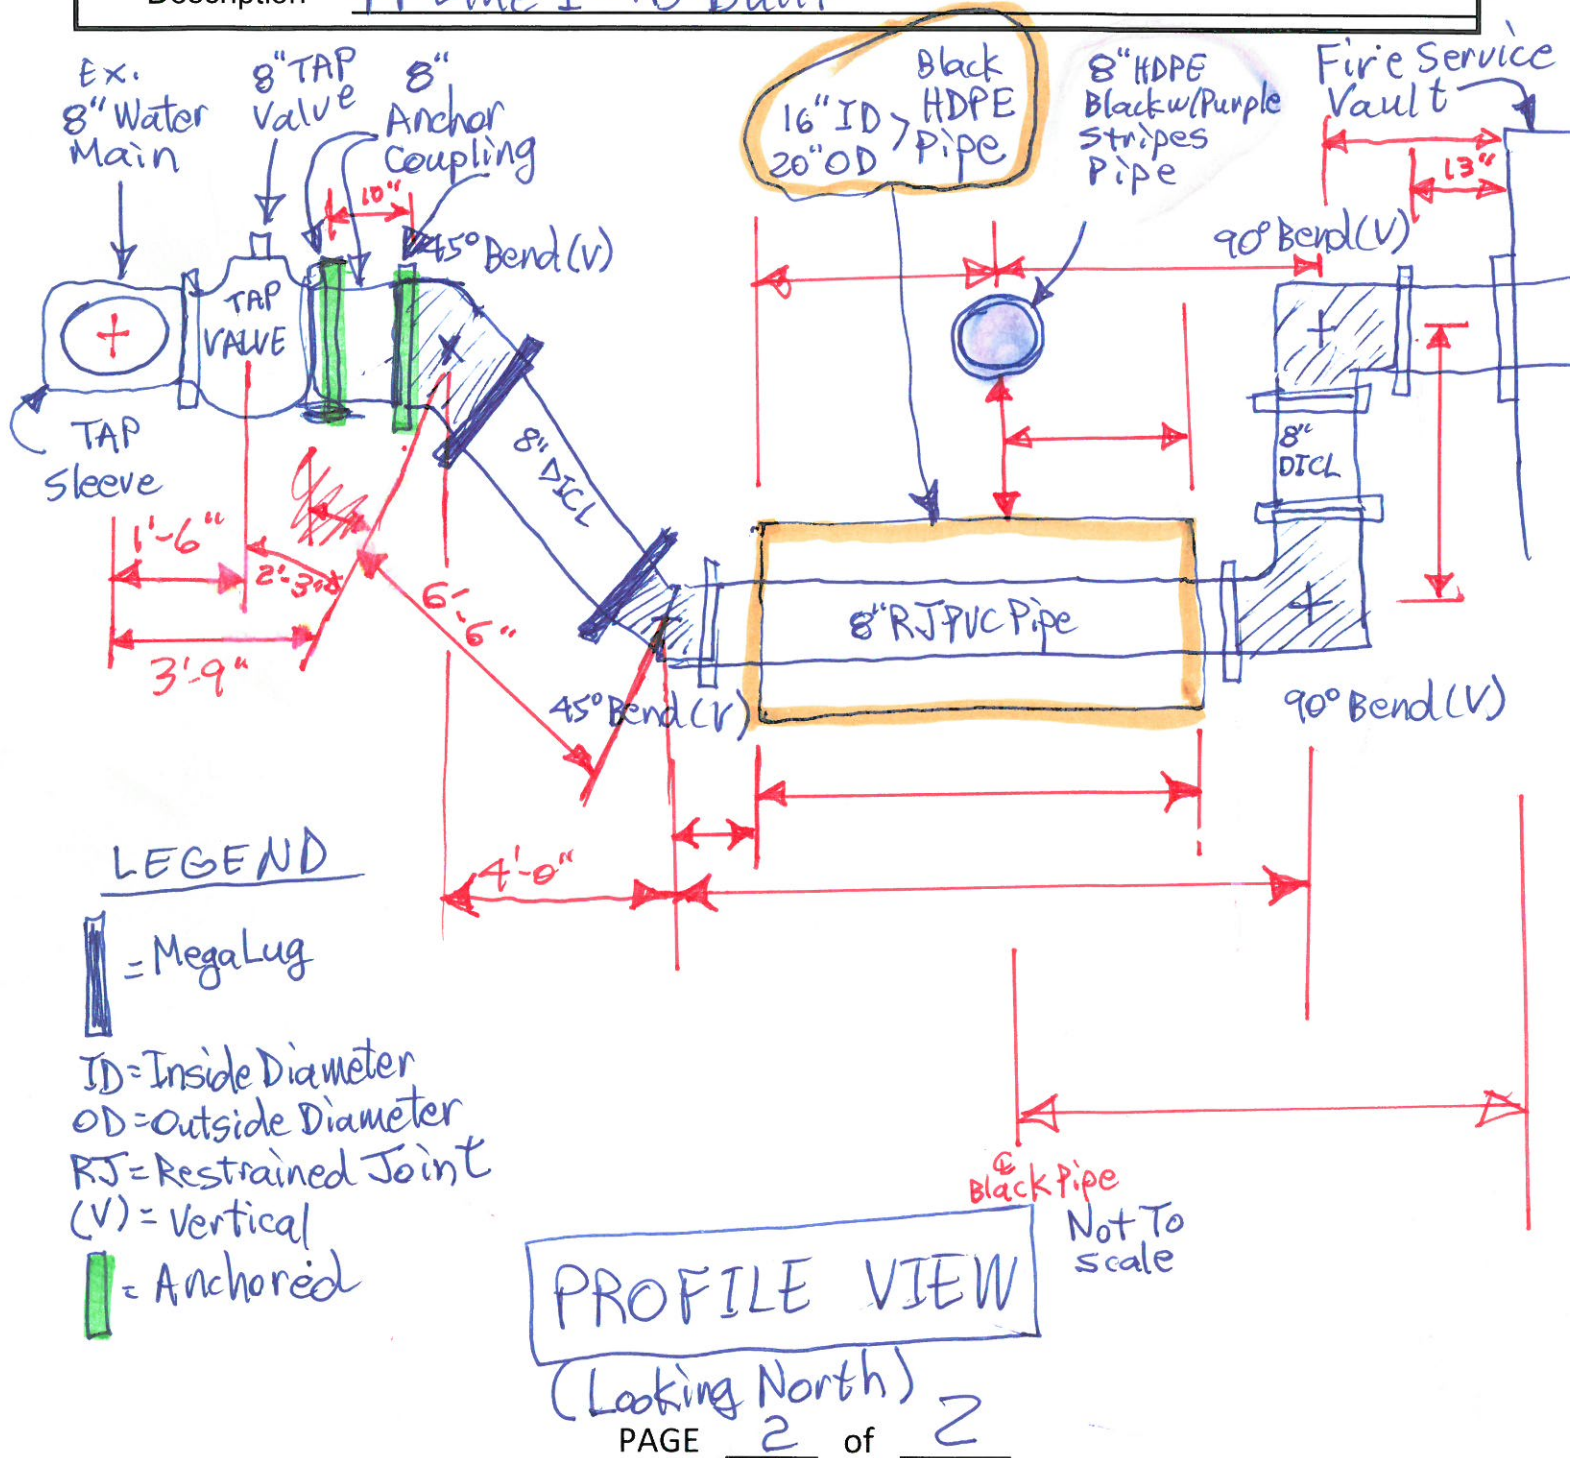



PROJECT INSPECTION DAILY REPORT

BAUGHMAN COMPANY, P.A.

WICHITA, KANSAS

PROJECT: BREWER COMMUNITY CENTER

DATE: 10-25-24

PRIVATE WATER DISTRIBUTION SYSTEM

DAY: FRIDAY

CITY NUMBER: 2023-026216 PPW

BAUGHMAN JOB #: 24-08-E869

INSPECTOR: LARRY POWELL

UTILITY CONTRACTOR: McCULLOUGH EXCAVATION

FOREMAN: JOSE Romero

INSPECTOR ON-SITE: 9:15 AM - 10:45 AM 11:34 AM - 3:05 PM

WEATHER: Sunny, Lt Wind LOW: 52 °F HI: 71 °F

EQUIPMENT: Excavator, Loader, Trench Box,

MATERIALS: 8" DfCL,

WORK PERFORMED: 74 ★ Installed 8" RJ PVC Pipe and 16" HDPE Sleeve into Trench. Attached CI Sleeve for PVC to DfCL, DfCL Pipe to 90° Bend (V), Vertical 8" DfCL and 90° Bend (V) to Pipe from Vault. Photo Taken.

- DfCL Pipe + Bends Wrapped in Plastic.

- Plastic Spacers every 7' placed on 8" RJ PVC Pipe inside Casing Pipe. Rec'd Photo from Jose.

- Tracer Wire ✓ Test Station @ TAP Valve requested.

- Thrust Blocks placed at 2-45° Bends and at 90° Bends.

- Back-filled with Sand.

REMARKS: Concrete 11 AM or After Lunch ✓

Plastic skids every 7'.

✓ Load

★ Dawnita OK'd WL-1 work from TAP Valve to Vault,

@ 2:10 PM, ✓




BAUGHMAN COMPANY, P.A.

ENGINEERING, SURVEYING & PLANNING


316/262-7271 FAX 316/262-0149 WICHITA, KANSAS 67211

Project Name	BREWER COMMUNITY CENTER - PRIVATE WATER DISTRIBUTION		
City Project No.	2023-026216 PPW		
Baughman No.	24-08-E869	Date:	10-25-24 10-24-24
Contractor	McCULLOUGH EXCAVATION	Inspector:	LARRY POWELL
Description	FPLine 1 - As-Built		

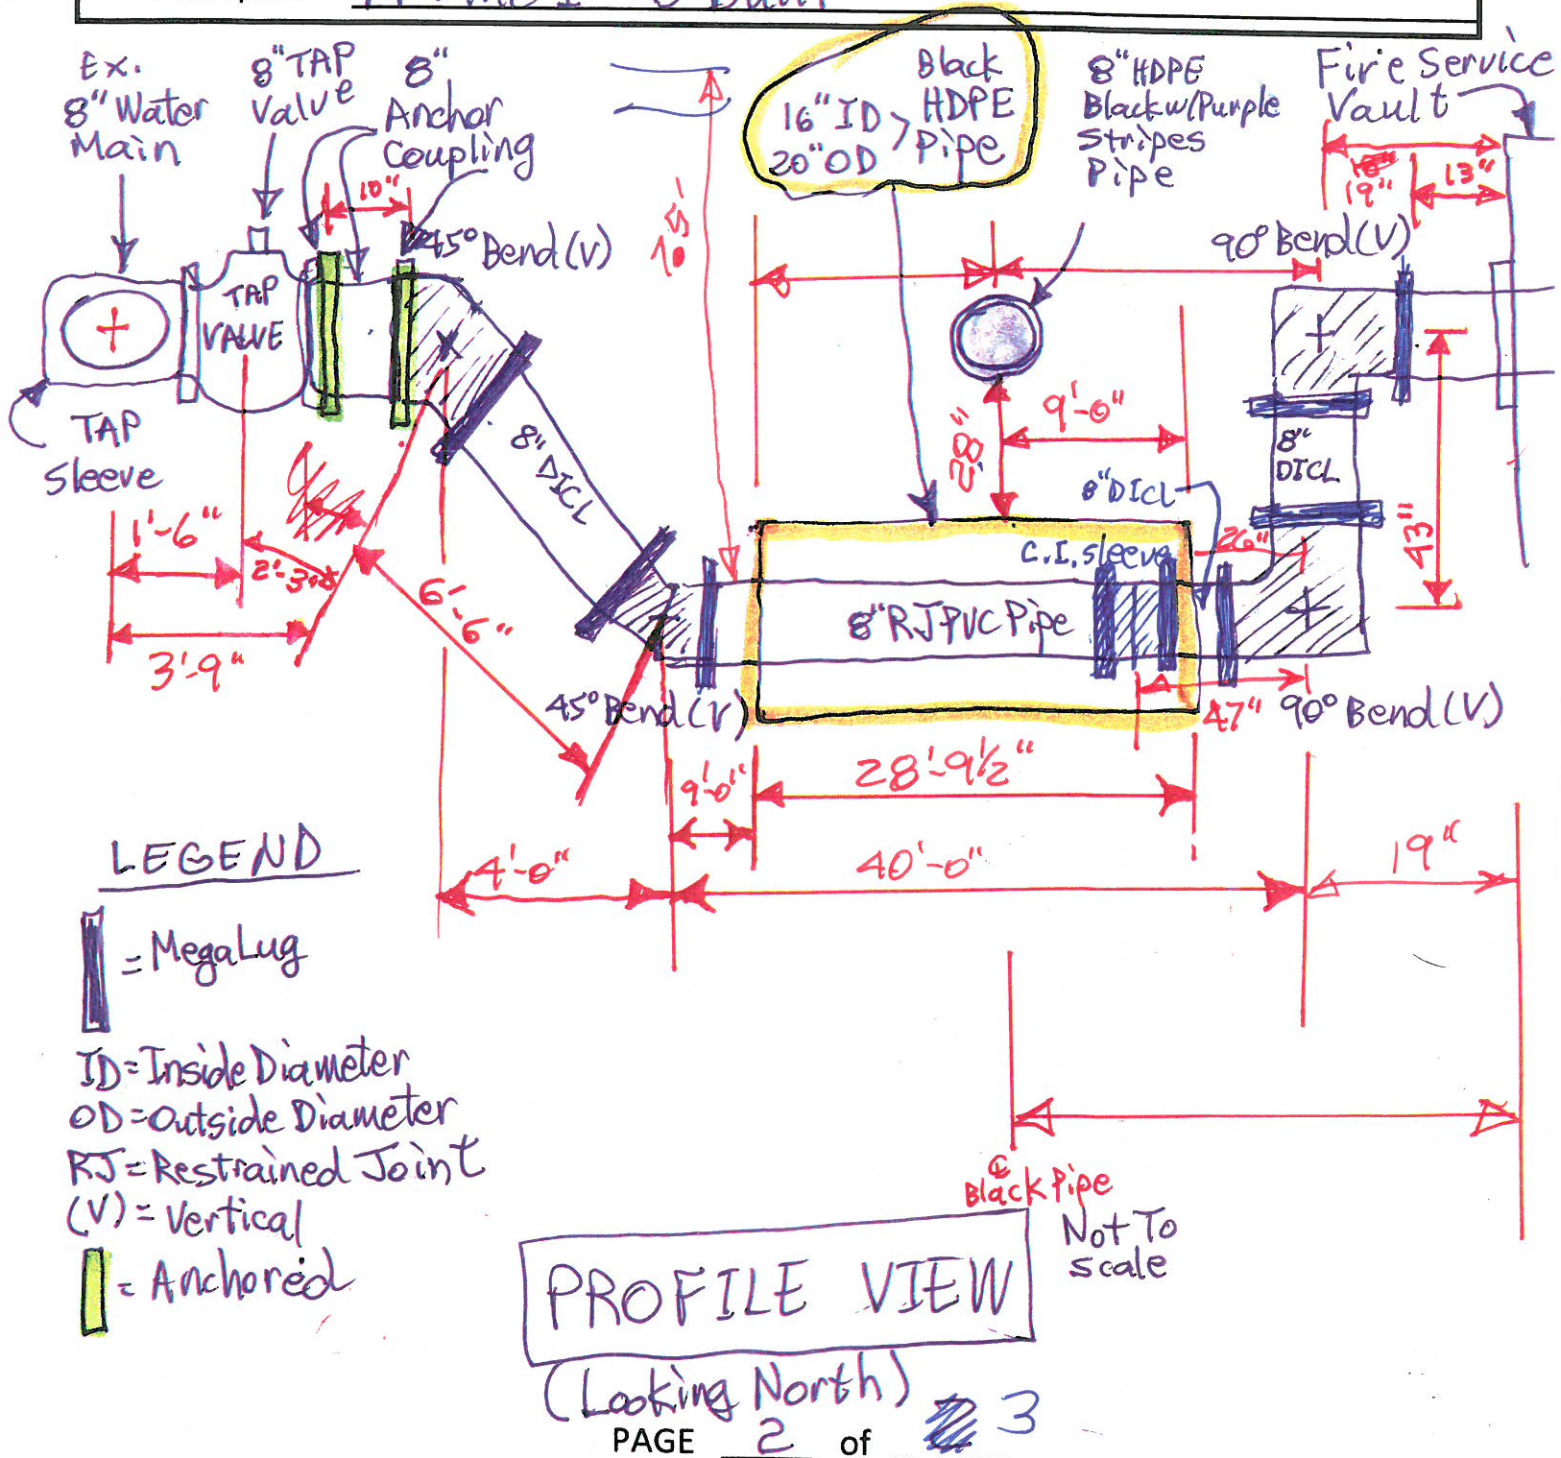

PROFILE VIEW
(Looking North)

Project Name	BREWER COMMUNITY CENTER - PRIVATE WATER DISTRIBUTION		
City Project No.	2023-026216 PPW		
Baughman No.	24-08-E869	Date:	10-25-24
Contractor	McCULLOUGH EXCAVATION	Inspector:	LARRY POWELL
Description	As-Built		

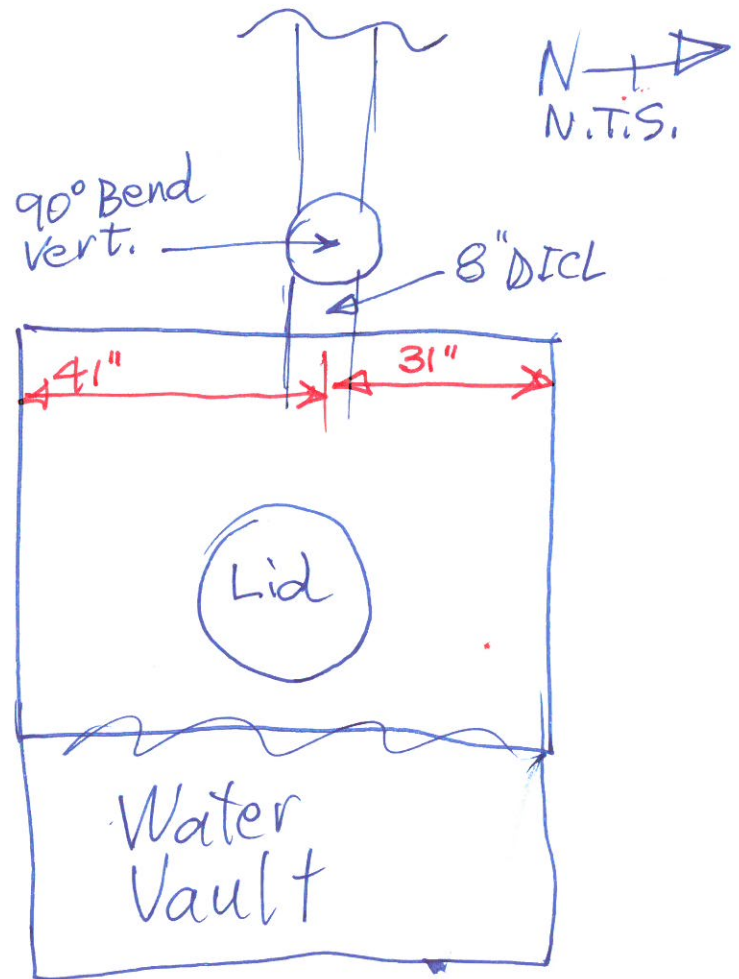

PLAN VIEW



PROJECT INSPECTION DAILY REPORT

BAUGHMAN COMPANY, P.A. WICHITA, KANSAS










INSPECTOR ON-SITE: 2:45PM - 2:55AM

WEATHER: Partly Cloudy, Windy LOW: 62 °F HI: 90 °F

EQUIPMENT: _____

MATERIALS: _____

WORK PERFORMED: * Continued WL-1 Work:

* Flushed + Vibrated

* Compacted Hot Mix Asphalt in Street Cut. (Temporary). 6" thick.

* Switched out Water Vault Lid to correct one. ✓

REMARKS: * Test Station @ TAP Valve is high w/ Valve Box Lid.





PROJECT INSPECTION DAILY REPORT
BAUGHMAN COMPANY, P.A. WICHITA, KANSAS

PROJECT: Water distribution system improvements DATE: 12/12/2024
to serve Brewer Community center DAY: Thursday
CITY NUMBER: 2023-026216PPW W. D. : OF
BAUGHMAN JOB #: 24-08-E689 INSPECTOR: B.Gibler
UTILITY CONTRACTOR: McCullough Excavation FOREMAN: Carlos
INSPECTOR ON-SITE: 905am-1001am, 1115am-100pm, 154pm-330pm
WEATHER: Sunny LOW: 31 °F HI: 55 °F
EQUIPMENT: Mini Excavator
MATERIALS: 6" US pipe DICL, Megalugs, Fittings
WORK PERFORMED: Place DICL from 16+57 into building riser
Backfill and compaction using vibrating plate.

REMARKS: COW approved backfill



PAGE 1 of

