
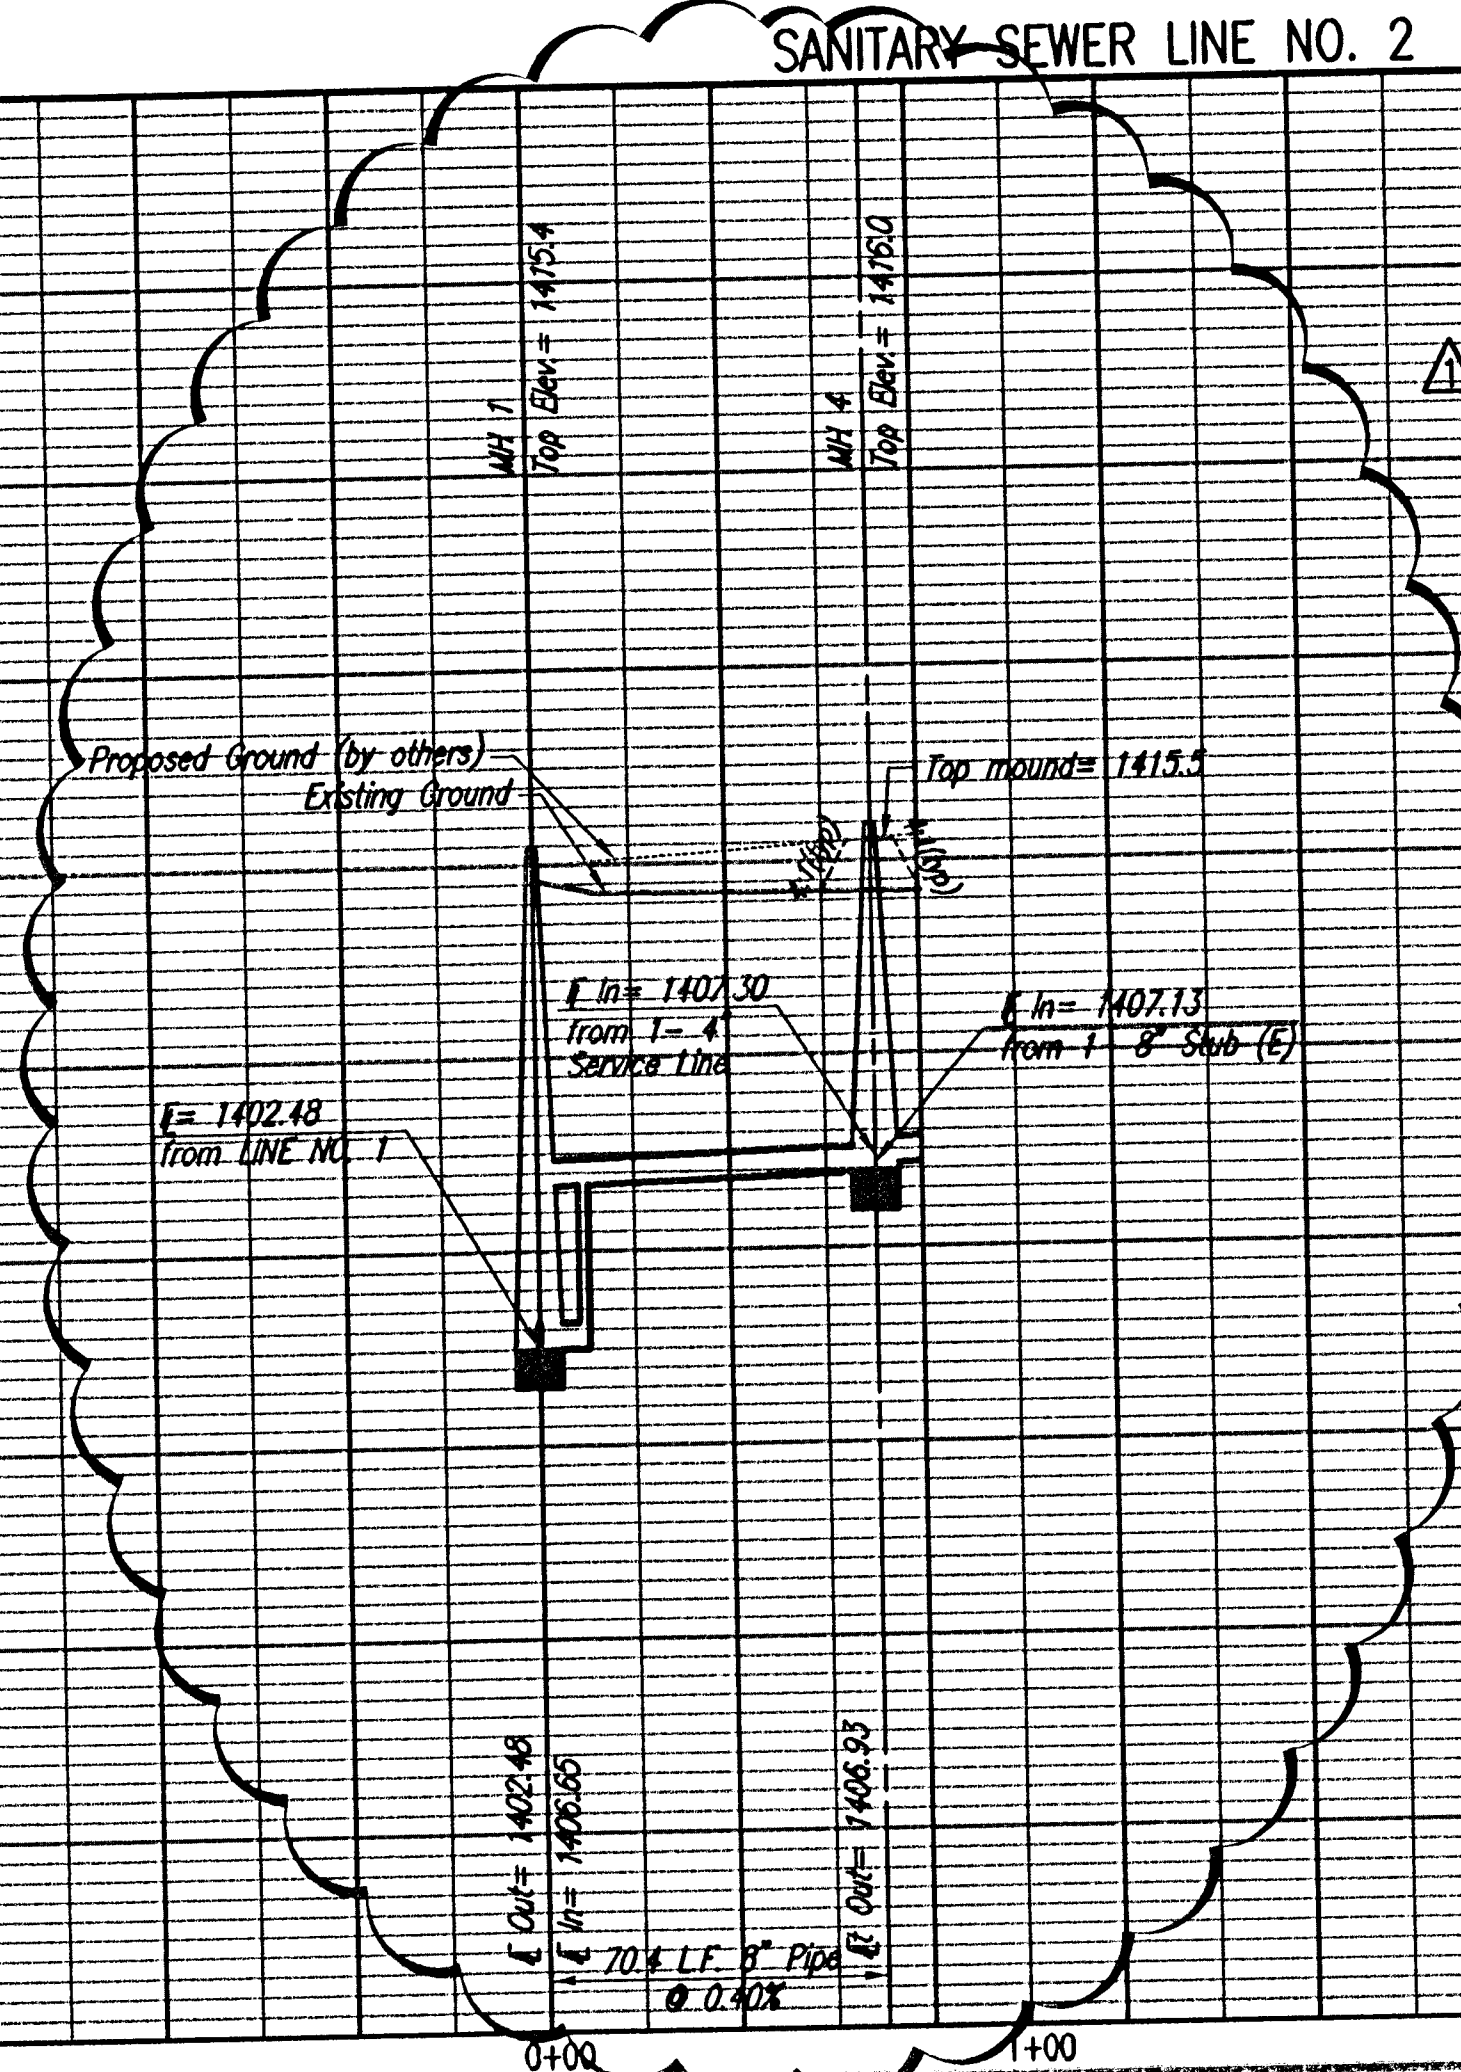


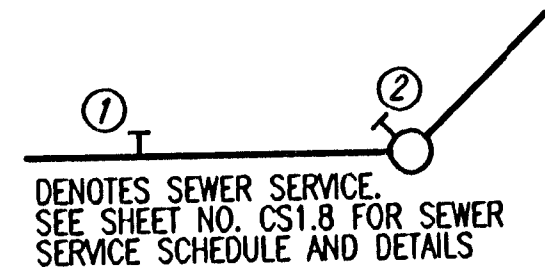

ALA	10/12/06
By	Date
Revision	
No.	

1430
1425
1420
1415
1410
1405
1400

THE WICHITA AIRPORT AUTHORITY
COLONEL JAMES JABARA AIRPORT

SANITARY SEWER LINE NO. 2

SANITARY SEWER AND WATER DISTRIBUTION SYSTEM
SOUTHWEST AREA SITE DEVELOPMENT IMPROVEMENTS



Professional Engineering Consultants, P.A.

303 S. TOPEKA • WICHITA, KANSAS 67202
316-262-2691 • FAX 316-262-3003

Date: _____

SEPTEMBER 2005

Job No. 05471-019

Received 04-11-2007 8:47:46 AM by ILS
Document: 05471-000-C-SS902-CHANGEORDER1