GENERAL NOTES:

1. The Contractor shall comply with all applicable safety regulations. All construction shall be completed following current City Standard Specifications and Special Provisions.

   a. Maintain a minimum of 10–foot horizontal separation between all water lines (mains, services, and fire hydrants) and all sanitary sewer lines (mains, services, and manholes). All separation distances are to be measured from edge–to–edge, at the closest point.

   b. Maintain a minimum of 2–foot vertical separation between all water lines (mains and services) and all gravity sanitary sewer lines (mains, services, and manholes) at crossings. All separation distances are to be measured from edge–to–edge, at the closest point.

   c. Maintain a minimum of 2–foot vertical separation between all water lines (mains and services) and all pressurized sanitary sewer lines (force mains and services) at crossings. Waterlines must always be placed above pressurized sanitary sewer lines where they cross. All separation distances are to be measured from edge–to–edge, at the closest point.

2. Contractor will be required to provide notice to utility companies a minimum of seventy–two (72) hours prior to any excavation, as follows:

   Kansas One–Call 687–2470

   The Contractor must notify the following in case of an emergency:

AT&T	1–800–246–8464
Black Hills Energy	1–800–694–8989
City of Wichita Water & Sewer	1–316–219–8921
City of Wichita Stormwater	1–316–268–4090
City of Wichita Traffic	1–316–268–4034
Cox Communications	1–888–249–3530
Kansas Gas Service	1–888–482–4950
Evergy	1–800–544–4857

3. Utility service lines, poles, etc. are to be adjusted as necessary by others prior to construction unless the plans specifically call for their adjustment by the Contractor or unless the plans specifically identify a utility to be adjusted by its owner during construction. Existing utilities and their location, as shown on the plans, represent the best information obtainable for design. The Contractor will be required to work around existing utilities within the right–of–way which do not conflict with proposed construction.

4. Rubble from the removal of miscellaneous structures and excess excavation which is to be wasted shall be disposed of on sites to be provided by the Contractor. These sites shall be approved by the Engineer as to suitability, appearance and site location. Locations, in the opinion of the Engineer, that will leave an unsightly appearance will not be approved. All disposal sites must be approved by the Kansas Department of Health and Environment. Material either stockpiled or disposed of in a flood plain will require a Kansas State Board of Agriculture permit. Any material dumped in waters of the United States or wetlands is subject to U.S. Corps. of Engineers permitting regulations. Any material buried or stockpiled beyond approved construction limits will require additional archaeological investigations unless buried in a previously approved borrow location.

5. Trees and shrubs in public right–of–way which are in direct conflict with proposed new construction shall be removed by the Contractor with the City Engineer's approval. Trees and shrubs which are not in direct conflict with proposed new construction shall be saved and protected from damage.

6. The Contractor shall give all property owners and/or tenants of developed property abutting the construction of this project a minimum of ten (10) days notice prior to start of construction.

7. The Contractor shall be responsible for preserving property irons. The Contractor will be required to re–establish any property irons which are damaged or destroyed by his construction operations. Such irons shall be re–established by a licensed land surveyor in accordance with state laws

8. The Engineering Division shall field locate water valve one time during construction when requested by the Contractor. It shall be the Contractor's responsibility to preserve such field locations during the construction process. Water valves, valve boxes or fire hydrants damaged during construction shall be repaired by Contractor at his own expense. Valve boxes and water meters within the project limits shall be adjusted to match field grades by the contractor.

9. The Contractor shall notify the consultant engineer and Dawnita Reinhardt at 316–650–0740 with the City of Wichita with the anticipated construction start date and notify them of project completion. Staking and inspection for this project will be the responsibility of the Contractor.

10. If traffic will be impacted by construction, a traffic control plan must be submitted and approved by the City Traffic Engineer at traffic@wichita.gov before construction can begin. The Contractor shall be responsible for all traffic control measures to facilitate construction. All construction zone markings and signage shall conform to the latest version of Manual on Uniform Traffic Control Devices (MUTCD) as published by the US Dept. of Transportation, Federal Highway Administration. All costs associated with construction markings and signage shall be the Contractors responsibility.

11. All elevations shown are NAVD88.

12. All areas disturbed during construction that will not be under proposed pavement shall be restored to match existing conditions per City specifications.

13. All applicable fees (tap, equity, in lieu of & main benefit) must be paid before any work on this project can commence. Quotes can be obtained on fees by calling Chris Stone at 316–268–4641.

14. City maintenance of water mains ends at easement line.

15. Opening and closing of water valves shall be done slowly to prevent damage to the water distribution system from water hammer. All valves closed by the contractor must be reopened as new construction permits. The project inspector must ascertain that any valve closed by the Contractor is reopened. The contractor will be permitted to operate water valves only when the project inspector assigned to the project is present.

16. The Contractor shall lay a Tracer Wire and Set Test Stations along all water pipe installed in accordance with City Specifications and Tracer Wire Detail on detail sheet WL–101, cost is subsidiary to pipe installation.

17. The contractor shall provide materials for temporary blowoff of waterlines. Connections to the existing waterline(s) shall be made with clean, swabbed pipe and flushed upon completion of tie–ins.

18. Requests for short term water interruptions shall be made to the City Water Distribution Division and will be subject to their approval. The Contractor shall give written notice to any property owner, business, and/or tenants that will have water service interrupted at least 5 days in advance. Such notifications should indicate the time and date that the water will be turned off and when the service will be restored. No business, property owner, and/or tenants shall be without water service for more than 8 hours. Proposed tie in locations which will affect water service to property owners shall be performed during non–peak hours.

19. The Contractor must schedule the connections to the existing main with the City such that there is a minimum disruption of service. Connections shall be made during periods of low water usage. The Contractor shall submit his proposed schedule for completing work for City approval at least 10 days prior to beginning construction.

20. Deflections at pipe joint or couplings shall not exceed the pipe manufacturers recommended maximum. Where deflections are greater than the maximum allowed, the contractor shall utilize fittings.

21. Any existing joint exposed during excavation shall be replaced if within four feet of proposed joint.

22. Valves 12 inches and larger are to be operated by the City Water Distribution Division, 48 hours of advance notice is required.

23. All wet taps shall be installed by the City of Wichita. The Contractor will reimburse the City for tapping fees prior to tap being made. Unless noted on plans.

24. The Contractor shall protect from damage and support existing utilities through construction as approved by the utility owner and the Engineer at the contractor's expense.

25. Contractor shall limit the extent of trench openings overnight and weekends to less than 50 feet.

26. Wichita Fire Department inspections may be scheduled by calling Dawnita Reinhardt at 316–650–0740.

27. All existing and proposed erosion control measures including silt fencing, erosion control mat, straw bales, inlet barriers, and const. entrance shall be maintained throughout construction by the contractor and until project is accepted by the City of Wichita. The on–site engineer shall complete weekly reports on the status of erosion control measures. The contractor shall be required to comply with maintenance and/or replacement of erosion control measures as determined by the on–site engineer until project is accepted by City of Wichita. Maintenance and/or replacement of erosion control measures to be paid by L.S. bid item "Maintain Existing BMPs".

28. All excess excavation shall remain on–site and shall be spread or stockpiled at a location to be determined by developer.

29. All areas disturbed during construction are to be seeded as follows:

    Seed –– Rye grass; 5 lbs./1000 Sq. Ft.

    All costs associated with seeding including mobilization, preparation of ground, seeding, fertilizing, mulching, etc. shall be included in the L.S. bid item "Seeding".

30. The Contractor shall not begin work on the project until the Project Inspector is assigned and on site. Any work completed without inspection will be required to be uncovered for inspection at the Contractor's expense.

Benchmarks

BM #1: "□" on the south end of the median in N. Boulder Drive.
Elevation = 1396.66 (NAVD 88)

BM #2: "□" on top of curb at the north end curb return in the east side of N. Boulder Drive and north of E. 27th Street N.
Elevation = 1396.95 (NAVD 88)

BM #3: "□" on the southwest corner of the storm sewer curb inlet lid on the south side of E. 27th Street N. and north of the DSW store.
Elevation = 1387.51 (NAVD 88)

Control Point used for As-Built GPS Survey:
CP501:
N=388,301.44 E=17,585,719.69
Elev=1386.44

Construction Began = May 2026 5/12/26
Construction End = June 2026 6/18/26
Water Quality Testing = July 2026 7/7/26

AS- BUILT PLANS

WATER DISTRIBUTION SYSTEM

to serve

STONEY POINTE 6TH ADD.

11616 E 27th St N

~~N. BOULDER DRIVE~~

CITY OF WICHITA, KANSAS

Paul Gunzelman, P.E. City Engineer
2026-007887PPW
54030980

Utility Contractor = SoKan Excavating.
Inspector = Fred Smith -
Baughman Company

As-Built Plans = F. Smith + Larry Powell
August 13, 2026
Revised August 13, 2026 (2:30 PM)

150 0 150

29TH ST. N.

Fire Hydrant = Mueller
Valves = Mueller
Fittings = SIP
6" + 8" DICL Pipe = McWane Ductile
8" PVC Pipe = Northern Pipe Products

STONEY POINTE 6TH ADDITION


1 2 3 4

BM #1
LINE 2
LINE 1
BM #2
BM #3
BOULDER DR.
27TH ST. N.
Existing 8" Water
WTR

Baughman Job # 26-05-E500

Benefit District

Northings (N) & Eastings (E): State Plane Coordinates - Kansas Grid South - NAD83 (2011), EPOCH 2023.
Elevations: NAVD88 (Geoid 18).
As-Built Survey Shots By: Baughman Company, P.A.

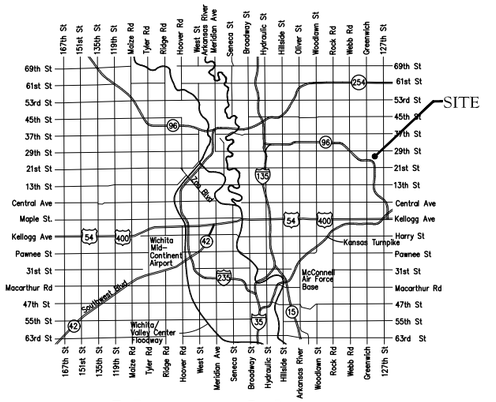

Vicinity Map

Sheet Index

Title Sheet	1
Lines 1 & 2	2
Erosion Control Plan	3
Std. Water Assembly Detail	4
Miscellaneous Water Details	5
Erosion Control BMP Details	6–10
Copy of Plat	11

APPROVED AS NOTED
BY WICHITA PUBLIC WORKS
ENGINEERING DIVISION
& BY WICHITA FIRE DEPARTMENT

Engineering — Approved by Bethany Mally (04/24/2026)
Utilities — Approved by Scott Macey (04/24/2026)
Fire Dept. — Approved by Battalion Chief Jose Ocadiz (04/24/2026)

NOTE TO CONTRACTORS

Public Property:
Inspection and testing for the waterline is to be provided by a Licensed Consulting Engineering Firm under contract with the Owner/Developer. Said Inspection is to be in accordance with the City of Wichita standard construction engineering practices and certified by a Professional Engineer Licensed in the state of Kansas. No work shall be performed in dedicated easements or public right–of–way by the Contractor without such inspection nor shall any work be commenced without written authorization by City Engineering. All Construction and Materials shall comply with the City of Wichita Specifications and Standards and Special Provisions (on file and available in the City Engineer's Office) or on the City's Website.

Private Property:
Installation and testing for the fire protection line is to be performed by a City of Wichita licensed fire protection contractor in accordance with the fire codes as adopted by the City of Wichita. All material and construction practices for the fire protection line shall comply with the fire codes as adopted by the City of Wichita (available from the City of Wichita Fire Department). The Contractor shall not commence work without notification and approval of the Wichita Fire Department. Inspection of the fire protection line is to be provided by a licensed Engineering Firm under contract with the Owner/Developer and the Fire Department. The contractor shall not start work until the project inspector is assigned to the project and present on the site. Any work done without inspection will be required to be uncovered for inspection.

An approved copy of these plans signed by City staff are required on–site.

TREVOR JAMES WOOTEN LICENSED 21190 4.27.26 KANSAS PROFESSIONAL ENGINEER

April 27, 2026

BAUGHMAN COMPANY
315 Ellis St. Wichita, KS 67211 316-262-7271
BaughmanCo.com

E:\Projects\Stoney Pointe Lot2Blk A Grav\Engineering\Phase 1\Water\Water.dwg

BENCHMARKS:
BM #1: "□" on the south end of the median in N. Boulder Drive.
Elevation = 1396.66 (NAVD 88)

BM #2: "□" on top of curb at the north end curb return in the east side of N. Boulder Drive and north of E. 27th Street N.
Elevation = 1396.95 (NAVD 88)

BM #3: "□" on the southwest corner of the storm sewer curb inlet lid on the south side of E. 27th Street N. and north of the DSW store.
Elevation = 1387.51 (NAVD 88)

WATER LINE FITTING COORDINATES

LINE	STA.	ITEM	NORTHING	EASTING	ELEV.
1	0+00	90	388,313.35	17,585,774.14	
1	1+41.5	90	388,315.58	17,585,914.64	
1	2+83.6	Tee	388,456.75	17,585,915.50	
1	2+93.6	FH Tee	388,456.08	17,585,924.36	
1	2+93.6	FH Valve	388,456.41	17,585,925.90	1392.35
1	2+93.6	Fire Hyd	388,461.46	17,585,924.80	1392.50
2	0+00	Tee	388,456.75	17,585,915.50	
2	0+02.0	Valve	388,456.46	17,585,911.80	1390.61
2	0+39.2	Blow Off	388,456.75	17,585,875.14	1388.82
VALVE ELEV. = TOP OF BOX			FIRE HYD ELEV. = BURY LINE		

FH 17528
6" V 56482

2" BO 46381

8" V 56481

GREENWICH BUSINESS CENTER ADDITION

STONEY POINTE 6TH ADDITION

Parcel A | Parcel B | Parcel D

LINE 1 | LINE 2

Sta. 0+00: 90° Bend (H)
34' North & 403' West of C/L 27th St N. & Boulder Drive

Sta. 0+00.00, Begin Line 1
1 – 8"x8" Tapping Saddle
1 – 8" Tapping Valve & Valve Box
Tapping saddle, tapping valve & valve box to be furnished and installed by the City of Wichita Water Dept. Contractor to set valve box to grade.
Valve Box Elev. = 1388.50
N=388,313.35 E=17,585,774.13

NOTE:
Sta. 0+00:
Installed 90° Bend (H).
Existing 2" Blow-Off Valve was Removed.
Existing Water Main Pipe was cut 4' +/- to get to Sta 0+00 for new 90° Bend (H).

Sta. 0+39.2: Blow Off
177' North & 301' West of C/L 27th St N. & Boulder Drive

Sta. 0+39.24, End Line 2
1 – Valve Assembly, Blowoff 2"
Valve Box Elev. = ~~1388.20~~
N=388,455.66 E=17,585,876.29

~~39.24~~ L.F. 8" Pipe
40.4'

~~142.01~~ L.F. 8" Pipe
141.2'

~~141.59~~ L.F. 8" Pipe
140.5

Sta. 2+93.60, End Line 1
1 – Fire Hydrant Assy.
L = 5' Facing South
1 – 8" CIMJ Plug (E)
Bury Line Elev. = ~~1392.50~~
Valve Box Elev. = ~~1391.60~~
~~N=388,455.72 E=17,585,925.53~~

Sta. 2+93.6:
Tee: 176' North & 251' West
Plug (E): 176' North & 250' West
FH Valve: 177' North & 251' West
Fire Hydrant.: 181' North & 251' West of C/L 27th St N. & Boulder Drive.

6" FH Valve = 4' South of Fire Hydrant.

~~10.00~~ L.F. 8" DICL Pipe
8.9'

Sta. 2+83.60, Line 1
= Sta. 0+00.00, Line 2
1 – 8"x8" CIMJ Tee
1 – Valve Assembly, Gate 8" (W)
Valve Box Elev. = ~~1391.30~~
~~N=388,455.71 E=17,585,915.53~~

Sta. 2+83.6:
Tee: 177' North & 261' West
Valve (W): 177' North & 263' West of C/L 27th St N. & Boulder Drive.

Sta. 1+41.59, Line 1
1 – 8" CIMJ 90° Bend
~~N=388,313.70 E=17,585,915.71~~

Sta. 1+41.5:
90° Bend (H): 36' North & 262' West of C/L 27th St N. & Boulder Drive

CAUTION!
Ex. 8" Sewer Crossing

Existing 8" Water Valve

Existing 8" Sewer
Existing 15" SWS
Existing 6" Water
Existing Pvm't
Proposed Pvm't
20' Drng. Esmt.
15' Util. Esmt. (By Sep. Inst.)
10'-20'
30' R/W

27TH ST. N.

CL Boulder Drive

20 0 20
Scale: 1" = 20' Horizontal
1" = 5' Vertical
• = Iron


LEGEND


TS = Test Station.
C/L = Centerlines of
H = Horizontal.

Pipe layout is shown with horizontal and vertical deflections. Contractor to use short pipe lengths, high deflection couplers, and manufacturer recommended pipe deflections to meet planned alignment.

Contractor to maintain a minimum of 10' of horizontal separation (O.D.–O.D.) between sanitary sewer and water line.

Contractor to maintain a minimum of 2' of vertical separation (O.D.–O.D.) between sanitary sewer and water line.

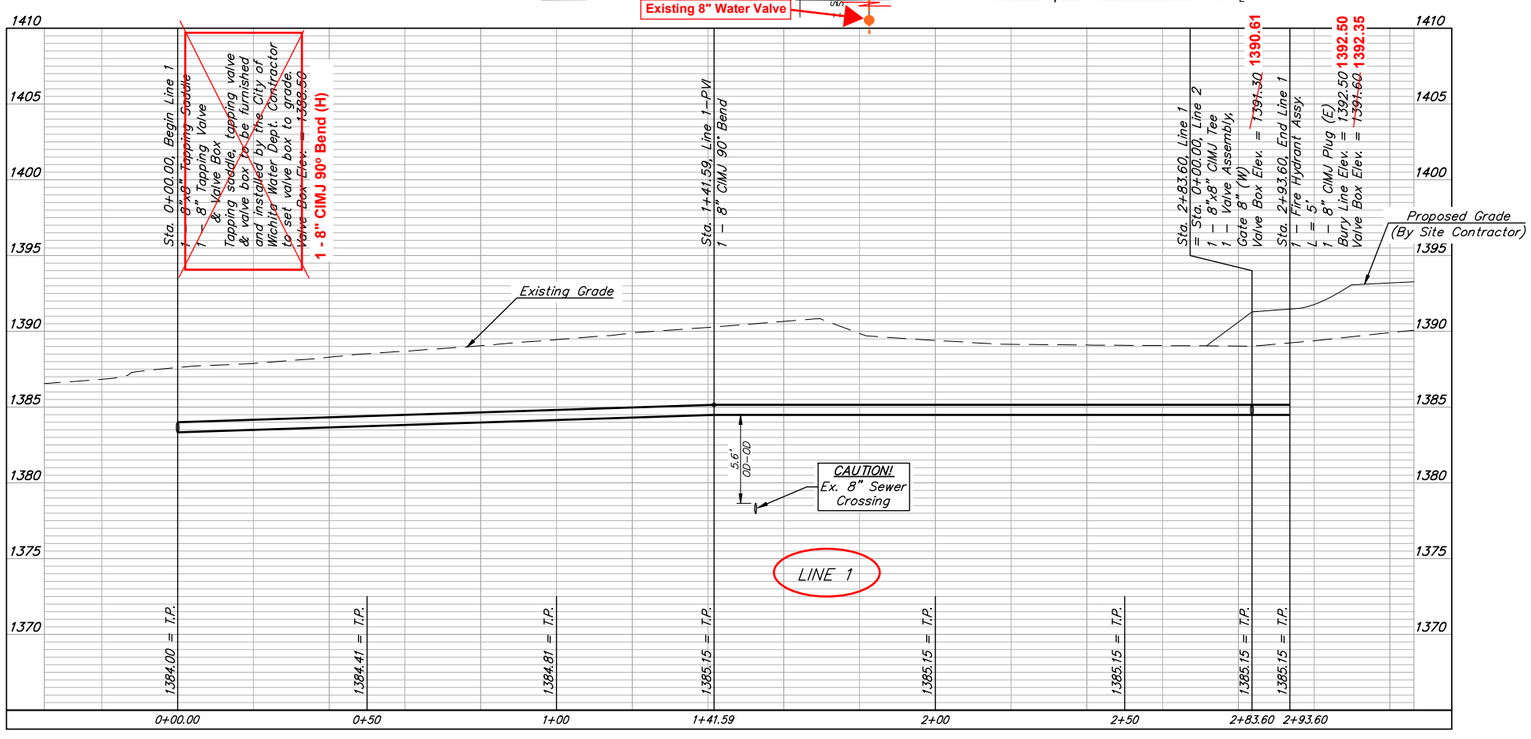

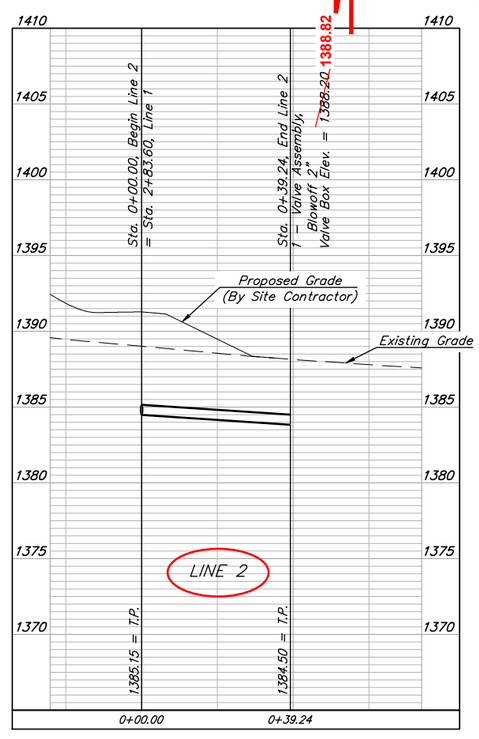

DEPTH UNKNOWN
Contractor to Verify Depth & Location of Existing Water Line Prior to Construction.

BAUGHMAN COMPANY
315 Ellis St.
Wichita, KS 67211
316-262-7271
BaughmanCo.com

STONEY POINTE 6TH ADD.

LINES 1 & 2

WATER DISTRIBUTION SYSTEM


PROJECT NUMBER: 25-06-E159

DESIGN: AH DRAWN: TMS

DATE: April 27, 2026

SHEET 2 OF 11

File: E:\Projects\Stoney Pointe Lot2Blk4 Gray\Engineering\Phase 1\Water\Water.dwg

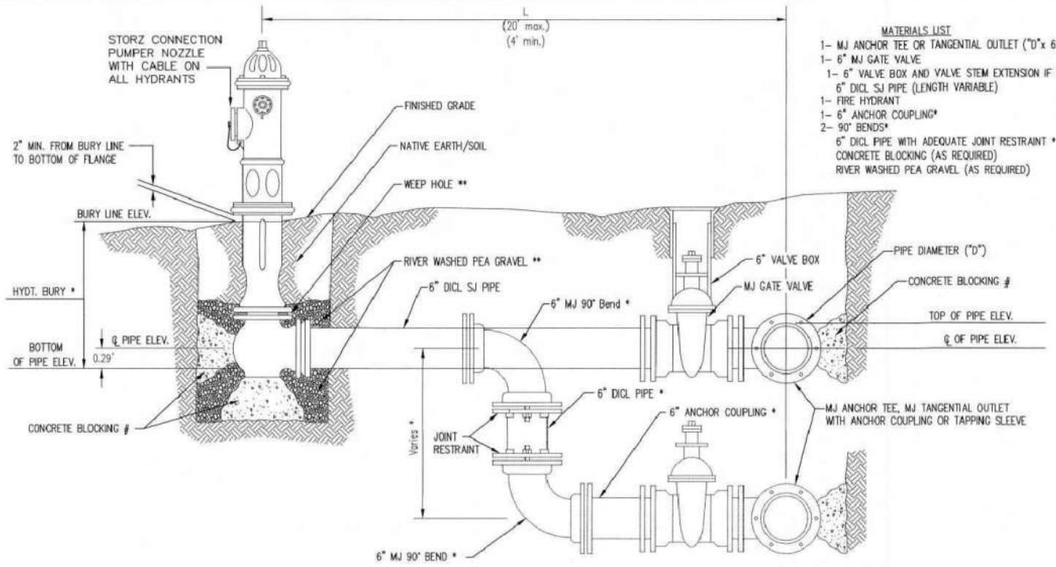

MATERIALS LIST
1– MJ ANCHOR TEE OR TANGENTIAL OUTLET ("D"x 6")
1– 6" MJ GATE VALVE
1– 6" VALVE BOX AND VALVE STEM EXTENSION IF REQUIRED *
6" DICL SJ PIPE (LENGTH VARIABLE)
1– FIRE HYDRANT
1– 6" ANCHOR COUPLING*
2– 90° BENDS*
6" DICL PIPE WITH ADEQUATE JOINT RESTRAINT *
CONCRETE BLOCKING (AS REQUIRED)
RIVER WASHED PEA GRAVEL (AS REQUIRED)


* IF THE REQUIRED HYDRANT BURY IS IN EXCESS OF 5', BUT LESS THAN 7', CONTRACTOR SHALL USE STANDARD 5' HYDRANT BURY AND HYDRANT BARREL EXTENSIONS AS NECESSARY. IF THE REQUIRED HYDRANT BURY IS GREATER THAN 7', CONTRACTOR SHALL USE 5' HYDRANT BURY, 2–MJ 90° BENDS, 6" ANCHOR COUPLING AND 6" DICL PIPE AS NECESSARY FOR VERTICAL ADJUSTMENT. THE CONTRACTOR SHALL PROVIDE ADEQUATE THRUST BLOCKING AT HYDRANT AND MEGALUGS, OR SIMILAR RESTRAINT BETWEEN 90° BENDS TO SECURE ALL FITTINGS DURING TESTING AND OPERATION. THE CONTRACTOR SHALL PROVIDE A VALVE STEM EXTENSION PER DETAIL THIS SHEET.

** CAUTION: WEEP HOLES TO BE KEPT CLEAR DURING CONSTRUCTION AND BACKFILL. CONCRETE FOR THRUST BLOCKING SHALL NOT OBSTRUCT WEEP HOLES. PLACE 1 CUBIC FOOT OF RIVER WASHED PEA GRAVEL AROUND EACH WEEP HOLE.

CONCRETE THRUST BLOCKING SHALL BE KEPT CLEAR OF BOLTS, NUTS, AND MJ ACCESSORIES.

FIRE HYDRANT ASSEMBLY

PER CITY OF WICHITA SPECIFICATIONS

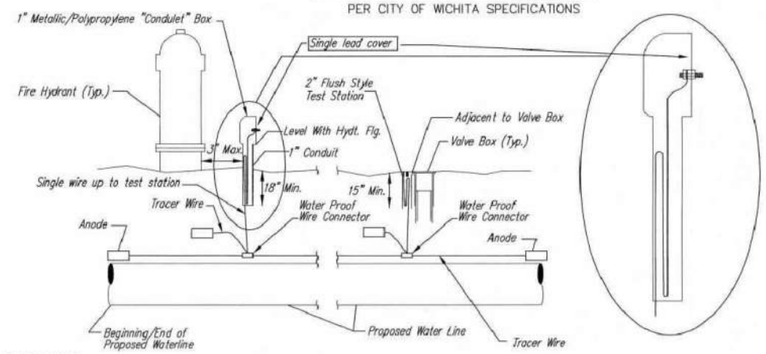

TRACER WIRE

Conductive type pipe locator/tracer wire shall be install to locate all waterline pipe regardless of pipe material. The wire shall extend the entire length of the proposed pipe. The wire shall be taped to the waterline and pulled with the pipe. A waterproof connector shall be used at splice locations. A complete list of approved tracer wire and waterproof connectors can be found on the City of Wichita's website at www.wichita.gov.

WIRE

The tracer wire shall be Blue No. 12 AWG CCS with 45 mil HDPE insulation. To allow for grade adjustment, a minimum of 12" of excess wire shall be coiled at the bottom of the test station for all wires. Wire connectors shall be installed per manufacturer recommendations. Contractor shall attach wire being installed with proposed water main to any tracer wire installed with adjacent waterline projects.

TEST STATIONS

*The test station for fire hydrant application shall be a 1" "conduit" style station as manufactured by AGRA Industries with a removable solid cover having a single lead extending from the face or approved equal. The "conduit" style test station shall be attached to a 1" rigid galvanized conduit with a minimum length of 36" and plastic end bushing. The flush style shall have the word "WATER" stamped or molded into the lid. The test station for valve applications shall be a 2" flush style test station with wire connector on lid. Model # T2PH7B1LP Handley Industries or CD14*TP SnakePit as manufactured by Copperhead Industries or approved equal. The flush style shall have the word "WATER" stamped or molded into the lid. All test stations shall be manufactured using molded blue tops or sufficiently coated with blue enamel paint. The tracer wire and the anode wire shall be install to allow 12" of wire within the test station. The location of all test stations shall be recorded, and shown in the as–built drawings. Flush style test stations shall not be installed in pavement or sidewalk unless approved by the Engineer. Contractor shall extend tracer wire & move flush mount test station to nearest location out of pavement or sidewalk.*


ANODES

The anodes shall be 3 lb. bare zinc or magnesium. The anodes shall be buried at the same elevation as the waterline at each test station. The anodes shall be connected to 12 AWG CCS which shall be extended to the test station.

TRACER WIRE DETAIL


COST IS SUBSIDIARY TO PIPE INSTALLATION

FIRE HYDRANTS REQUIRED					
STATION	BURY LINE ELEVATION	TOP OF PIPE ELEVATION	FIRE HYDRANT BURY REQUIRED*	VALVE STEM EXT. REQUIRED (ft)*	BARREL EXTENSION
2+93.60	1392.50	1385.15	8.0'	NO	36"
	1392.50				

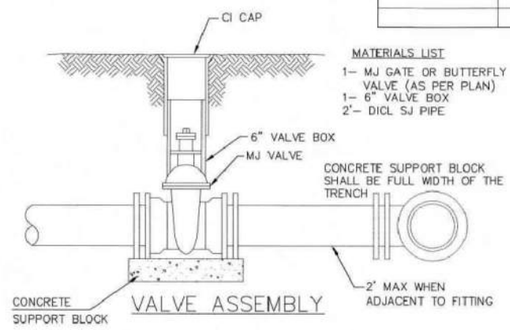

MATERIALS LIST
1– MJ GATE OR BUTTERFLY VALVE (AS PER PLAN)
1– 6" VALVE BOX
2'– DICL SJ PIPE


VALVE ASSEMBLY

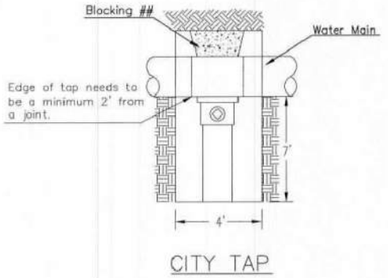


CITY TAP

When the City of Wichita makes tap, blocking is to be done by Contractor

MATERIALS LIST
1–MJ GATE OR BUTTERFLY VALVE (AS PER PLAN)
1–MJ ANCHOR COUPLING (12" OR SMALLER)
1–6" VALVE BOX
CONCRETE SUPPORT BLOCK SHALL BE FULL WIDTH OF THE TRENCH

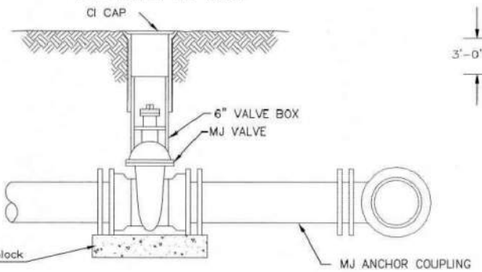


ANCHORED VALVE ASSEMBLY

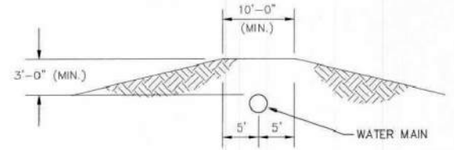

PROTECTIVE FILL DETAIL


MINIMUM PROTECTIVE FILL SHALL BE PROVIDED IN ALL INSTANCES WHERE COVER OVER THE PROP. WATER LINE IS LESS THAN 3'.
(COST SUBSIDIARY TO PIPE INSTALLATION)

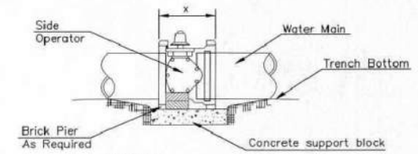

NOTES


1. This detail covers Butterfly Valve installation, inclusive, regardless of type of pipe or joint used. 24" and larger lines to be detailed on plans.
2. 6" Valve Box and Cover required per City of Wichita Std. Specifications.
3. Conc. Support Block to be full width of trench.

CONCRETE SUPPORT BLOCKING FOR BUTTERFLY VALVE INSTALLATION

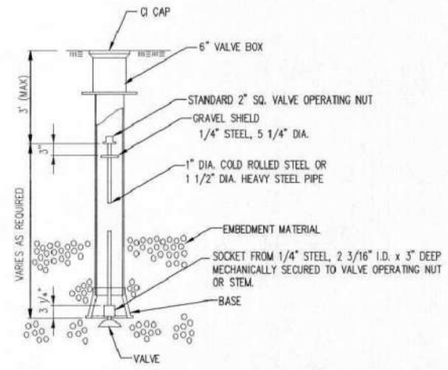

VALVE STEM EXTENSION DETAIL

NOTE: ONE VALVE STEM EXTENSION FOR EACH VALVE BURIED GREATER THAN 5'.

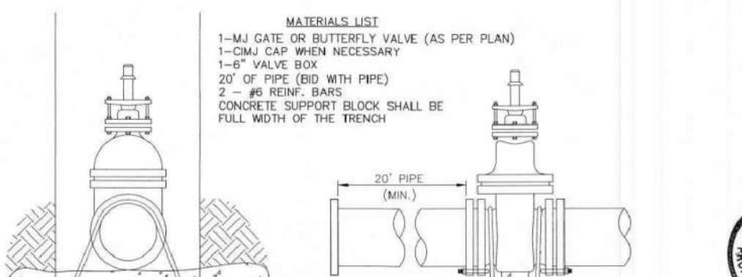


MATERIALS LIST
1–MJ GATE OR BUTTERFLY VALVE (AS PER PLAN)
1–CIMJ CAP WHEN NECESSARY
1–6" VALVE BOX
20' OF PIPE (BID WITH PIPE)
2 – #6 REINF. BARS
CONCRETE SUPPORT BLOCK SHALL BE FULL WIDTH OF THE TRENCH

Notes:
1. Concrete Block at Valve to have sufficient bearing in undisturbed soil to prevent thrust movement as shown in table at right. Field Engineer to determine thrust loading of undisturbed soil and final size of thrust block.
2. The thrust block shall be constructed such that bolts, nuts, and other MJ accessories are kept clear of concrete.
3. All valves at dead ends and at other locations as called out on the plans shall be blocked as shown here.

THRUST AT VALVES	
VALVE	THRUST AT 150 #/in²
4"	1809 lbs.
6"	4245 lbs.
8"	7540 lbs.
12"	16965 lbs.

ANCHORED VALVE ASSEMBLY, SPECIAL

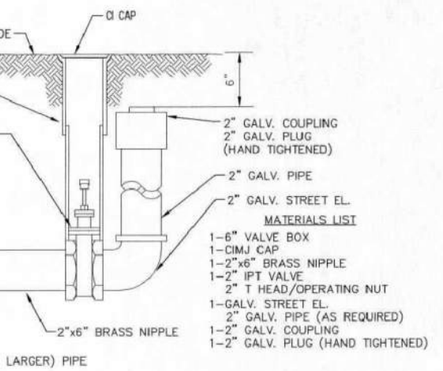

MATERIALS LIST
1–6" VALVE BOX
1–CIMJ CAP
1–2"x6" BRASS NIPPLE
1–2" IPT VALVE
2" T HEAD/OPERATING NUT
1–GALV. STREET EL.
2" GALV. PIPE (AS REQUIRED)
1–2" GALV. COUPLING
1–2" GALV. PLUG (HAND TIGHTENED)

2" BLOWOFF ASSEMBLY

GARY L. JANZEN LICENSED 16284 KANSAS PROFESSIONAL ENGINEER
10/27/16

REVISED: OCTOBER 2016

CITY OF WICHITA
PUBLIC WORKS & UTILITIES ENGINEERING DIVISION

STANDARD WATER ASSEMBLY DETAIL

CITY ENGINEER
GARY JANZEN, P.E.

PROJECT NUMBER	OCA NUMBER	DATE

CITY ENGINEER'S OFFICE
CITY HALL - SEVENTH FLOOR
455 NORTH MAIN STREET
WICHITA, KANSAS 67202-1620
(316) 268-4501


SHEET


WL-101

PC 226-4

Stoney Pointe Addition
Wichita, Sedgwick County, Kansas

Part of the NW 1/4, Section 3
Township 27 South, Range 2 East, of the 6th. P.M.

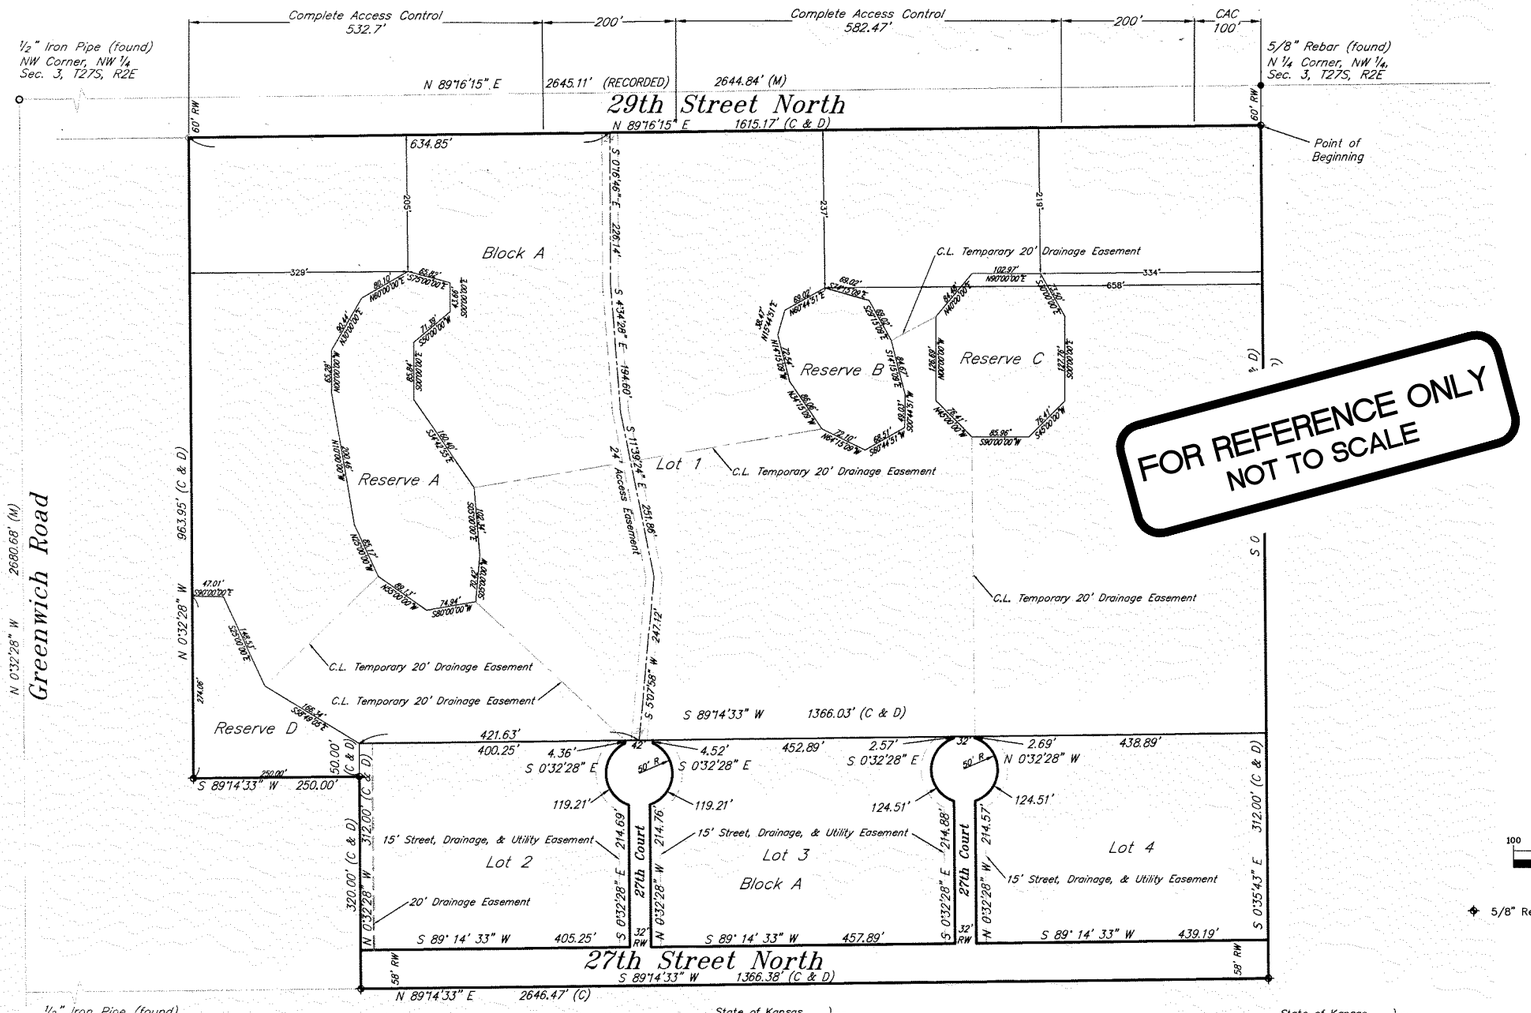

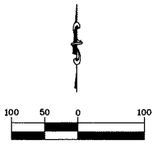

✦ 5/8" Rebar (set) KEMPA CLS #157

½" Iron Pipe (found)
W ¼ Corner, NW ¼
Sec. 3, T27S, R2E

State of Kansas
County of Sedgwick } SS

Know all men by these presents, that we, the undersigned, have caused the land described in the surveyor's certificate to be platted into Lots and a Block, reserves and streets to be known as Stoney Pointe Addition, Wichita, Sedgwick County, Kansas. The streets are hereby dedicated to and for the use of the public. The streets, drainage and utility easements are hereby granted as indicated for street and drainage purposes and for the construction and maintenance of all public utilities. Temporary drainage easements are hereby granted for the conveyance of storm water and shall automatically vacate at such time as the conveyance of storm water is confined to permanent 20' drainage easements, to be accepted by the City and recorded by separate instrument with the Sedgwick County Register of Deeds. The access easement is hereby dedicated for the benefit of the adjoining properties. Reserves A, B, C, and D are dedicated for storm water detention, landscaping, irrigation and beautification. A drainage plan has been developed for the plat and all drainage easements, rights-of-way, and reserves A, B, C, and D shall remain at established grades or as modified with the approval of the applicable City or County Engineer, and unobstructed to allow for the conveyance of storm water. Minimum pad elevations for Lot 1 are detailed on the master grading plan. Reserves A, B, C and D shall be owned and maintained by the owner of Lot 1, for the use as a drainage reserve and utility easement. Complete access control except for 2 openings shall be as shown on the plat. And further, that the land contained herein is held and shall be conveyed subject to any applicable restrictions, reservations and covenants now on file or hereafter filed in the Office of the Register of Deeds of Sedgwick County, Kansas.

By: NORTH GREENWICH / 29TH LLC, a Kansas limited liability company

3/7/2011
Kevin Mullen, President, Ritchie Investment Company, Inc., Manager of NORTH GREENWICH/ 29TH, LLC, a Kansas limited liability company — Date

State of Kansas
County of Sedgwick } SS

This instrument was acknowledged before me on this 7th day of March 2011, by Kevin Mullen, President, Ritchie Investment Company, Inc., Manager of North Greenwich/29th LLC, a Kansas limited liability company
IN WITNESS WHEREOF, I have hereunto set my hand and affixed my official seal, the day last above written.

Angie M. Sizemore
Notary Public
My Commission Expires: 7/25/11

ANGIE M. SIZEMORE Notary Public - State of Kansas My Appt. Expires 7/25/11

State of Kansas
County of Sedgwick } SS

Intrust Bank, N.A. holders of a mortgage on the above decribed property, does hereby consent to the plat at Stoney Pointe Addition.

Intrust Bank, N.A.
Gary Schmitt, Executive Vice President

State of Kansas
County of Sedgwick } SS

This instrument was acknowledged before me on this 7th day of March 2011, by Gary D. Schmitt, Executive Vice President of Intrust Bank, N.A.
IN WITNESS WHEREOF, I have hereunto set my hand and affixed my official seal, the day last above written.

Susan K. Cook
Notary Public
My Commission Expires: 11/3/12

SUSAN K. COOK Notary Public - State of Kansas My Appt. Expires 11/3/12

State of Kansas
City of Wichita } SS

This plat of Stoney Pointe Addition, Wichita, Sedgwick County, Kansas, has been submitted to and approved by the Wichita-Sedgwick County Metropolitan Area Planning Commission, Wichita, Kansas. Dated this 23rd day of December 2010.
Wichita-Sedgwick County Metropolitan Area Planning Commission.

Debra Miller Stevens, Chair
John L. Schlegel, Secretary

WICHITA-SEDGWICK COUNTY METROPOLITAN AREA PLANNING COMMISSION KANSAS

SEAL Planning Commission KANSAS

State of Kansas
City of Wichita } SS

This plat approved and all dedications shown hereon accepted by the City Council of the City of Wichita, Kansas, this 5th day of April 2011.

At the Direction of the City Council

Carl Brewer, Mayor

Karen Sublett, City Clerk

CLERK OF SEDGWICK COUNTY SEDGWICK COUNTY KANSAS

Entered on transfer record this 12 day of April, 2011.

Kelly B. Arnold, County Clerk

Benchmark:
Brass disc on top of curb in front of fire hydrant, Lot 1, Block 1, Regency Park Addition to Wichita, Sedgwick County, Kansas
Elevation=1378.96 (NGVD 29) (191.56 City of Wichita datum)

Notes:
1. This Addition is subject to conditions of Protective Overlay No. 74.
2. Developer shall provide and record with the appropriate governing body permanent drainage and access easements at the time of construction to allow access to the reserves through and from public and or private streets and easements.

Sedgwick County
Register of Deeds - Bill Meek
DOC.#/FLM-PG: 29212156
Receipt #: 1773309 Recording Fee: $20.00
Pages Recorded: 1
Cashier Initials: JP Authorized By:
Date Recorded: 4/12/2011 9:24:37 AM

State of Kansas
County of Sedgwick } SS

This is to certify that this plat has been filed for record in the Office of the Register of Deeds this 12th day of April, 2011, at 9:24:37 o'clock A.M. and is duly recorded.

Bill Meek, Register of Deeds
Tonya Buckingham, Deputy

Reviewed in accordance with K.S.A. 58-2005 on this 12th day of April, 2011.

RICHARD L. ROBELLO LICENSED LS-1246 KANSAS LAND SURVEYOR

Tricia L. Robello, L.S. #1246
Deputy County Surveyor
Sedgwick County, Kansas

TREVOR JAMES WOOTEN LICENSED 21190 4-27-26 KANSAS PROFESSIONAL ENGINEER

BAUGHMAN COMPANY
315 Ellis St.
Wichita, KS 67211
316-262-7271
BaughmanCo.com

STONEY POINTE 6TH ADD.

COPY OF PLAT

WATER DISTRIBUTION SYSTEM

PROJECT NUMBER: 25-06-E159

DESIGN: DRAWN:

DATE: April 27, 2026

SHEET 11 OF 11

Filename: 10088\Stoney Pointe Final Plat.dwg Prepared: 2-3-11

kemiller engineering
516 S. Market, Wichita, KS 67202 316/264-0242

File: E:\Projects\Stoney Pointe Lot2Blk A Gray\Engineering\Phase 1\Water\Water.dwg

PC 226-5