GENERAL NOTES

1. THE CONTRACTOR SHALL COMPLY WITH ALL APPLICABLE SAFETY REGULATIONS. ALL CONSTRUCTION SHALL BE COMPLETED FOLLOWING CURRENT CITY STANDARD SPECIFICATIONS AND SPECIAL PROVISIONS.
2. CONTRACTOR WILL BE REQUIRED TO PROVIDE NOTICE TO UTILITY COMPANIES A MINIMUM OF SEVENTY-TWO (72) HOURS PRIOR TO ANY EXCAVATION, AS FOLLOWS:

KANSAS ONE-CALL	1-316-687-2470

THE CONTRACTOR MUST NOTIFY THE FOLLOWING IN CASE OF AN EMERGENCY:

AT&T	1-800-246-8464
BLACK HILLS ENERGY	1-800-694-8989
CITY OF WICHITA WATER & SEWER	1-316-219-8921
CITY OF WICHITA STORMWATER	1-316-268-4498
CITY OF WICHITA TRAFFIC	1-316-268-4501
COX COMMUNICATIONS	1-888-249-3530
KANSAS GAS SERVICE	1-888-482-4950
EVERGY	1-800-544-4857

3. UTILITY SERVICE LINES, POLES, ETC., ARE TO BE ADJUSTED AS NECESSARY BY OTHERS PRIOR TO CONSTRUCTION UNLESS THE PLANS SPECIFICALLY CALL FOR THEIR ADJUSTMENT BY THE CONTRACTOR OR UNLESS THE PLANS SPECIFICALLY IDENTIFY A UTILITY TO BE ADJUSTED BY ITS OWNER DURING CONSTRUCTION. EXISTING UTILITIES AND THEIR LOCATION, AS SHOWN ON THE PLANS, REPRESENT THE BEST INFORMATION OBTAINABLE FOR DESIGN. THE CONTRACTOR WILL BE REQUIRED TO WORK AROUND EXISTING UTILITIES WITHIN THE RIGHT-OF-WAY WHICH DO NOT CONFLICT WITH PROPOSED CONSTRUCTION.
4. RUBBLE FROM THE REMOVAL OF MISCELLANEOUS STRUCTURES AND EXCESS EXCAVATION WHICH IS TO BE WASTED SHALL BE DISPOSED OF ON SITES TO BE PROVIDED BY THE CONTRACTOR. THESE SITES SHALL BE APPROVED BY THE ENGINEER AS TO SUITABILITY, APPEARANCE AND SITE LOCATION. LOCATIONS, IN THE OPINION OF THE ENGINEER, THAT WILL LEAVE AN UNSIGHTLY APPEARANCE WILL NOT BE APPROVED. ALL DISPOSAL SITES MUST BE APPROVED BY THE KANSAS DEPARTMENT OF HEALTH AND ENVIRONMENT. MATERIAL EITHER STOCKPILED OR DISPOSED OF IN A FLOOD PLAIN WILL REQUIRE A KANSAS STATE BOARD OF AGRICULTURE PERMIT. ANY MATERIAL DUMPED IN WATERS OF THE UNITED STATES OR WETLANDS IS SUBJECT TO U.S. CORPS OF ENGINEERS PERMITTING REGULATIONS. ANY MATERIAL BURIED OR STOCKPILED BEYOND APPROVED CONSTRUCTION LIMITS WILL REQUIRE ADDITIONAL ARCHEOLOGICAL INVESTIGATIONS UNLESS BURIED IN A PREVIOUSLY APPROVED BORROW LOCATION.
5. TREES AND SHRUBS IN PUBLIC RIGHT-ON-WAY WHICH ARE IN DIRECT CONFLICT WITH PROPOSED NEW CONSTRUCTION SHALL BE REMOVED BY THE CONTRACTOR WITH THE CITY ENGINEER'S APPROVAL. TREES AND SHRUBS WHICH ARE NOT IN DIRECT CONFLICT WITH PROPOSED NEW CONSTRUCTION SHALL BE SAVED AND PROTECTED FROM DAMAGE.
6. THE CONTRACTOR SHALL GIVE ALL PROPERTY OWNERS AND/OR TENANTS OF DEVELOPED PROPERTY ABUTTING THE CONSTRUCTION OF THIS PROJECT A MINIMUM OF TEN (10) DAYS NOTICE PRIOR TO START OF CONSTRUCTION.
7. THE CONTRACTOR SHALL BE RESPONSIBLE FOR PRESERVING PROPERTY IRONS. THE CONTRACTOR WILL BE REQUIRED TO REESTABLISH ANY PROPERTY IRONS WHICH ARE DAMAGED OR DESTROYED BY HIS CONSTRUCTION OPERATIONS. SUCH IRONS SHALL BE REESTABLISHED BY A LICENSED LAND SURVEYOR IN ACCORDANCE WITH STATE LAWS.
8. THE ENGINEERING DIVISION SHALL FIELD LOCATE WATER VALVES ONE TIME DURING CONSTRUCTION WHEN REQUESTED BY THE CONTRACTOR. IT SHALL BE THE CONTRACTOR'S RESPONSIBILITY TO PRESERVE SUCH FIELD LOCATIONS DURING THE CONSTRUCTION PROCESS. WATER VALVES, VALVE BOXES OR FIRE HYDRANTS DAMAGED DURING CONSTRUCTION SHALL BE REPAIRED BY CONTRACTOR AT HIS OWN EXPENSE. VALVE BOXES AND WATER METERS WITHIN THE PROJECT LIMITS SHALL BE ADJUSTED TO MATCH FINAL GRADES BY THE CONTRACTOR.
9. THE CONTRACTOR SHALL NOTIFY THE INSPECTING ENGINEER AND DAWNITA REINHARDT AT 316-650-0740 WITH THE CITY OF WICHITA WITH THE ANTICIPATED CONSTRUCTION START DATE AND NOTIFY THEM OF PROJECT COMPLETION, STAKING AND INSPECTION FOR THIS PROJECT WILL BE THE RESPONSIBILITY OF THE CONTRACTOR.
10. IF TRAFFIC WILL BE IMPACTED BY CONSTRUCTION, A TRAFFIC CONTROL PLAN MUST BE SUBMITTED AND APPROVED BY THE CITY TRAFFIC ENGINEER AT traffic@wichita.gov BEFORE CONSTRUCTION CAN BEGIN. THE CONTRACTOR SHALL BE RESPONSIBLE FOR ALL TRAFFIC CONTROL MEASURES TO FACILITATE CONSTRUCTION. ALL CONSTRUCTION ZONE MARKINGS AND SIGNAGE SHALL CONFORM TO THE LATEST VERSION OF THE MANUAL ON UNIFORM TRAFFIC CONTROL DEVICES (MUTCD) AS PUBLISHED BY THE US DEPT. OF TRANSPORTATION, FEDERAL HIGHWAY ADMINISTRATION. ALL COSTS ASSOCIATED WITH CONSTRUCTION MARKINGS AND SIGNAGE SHALL BE THE CONTRACTOR'S RESPONSIBILITY.
11. ALL ELEVATIONS SHOWN ARE NAVD 88.
12. ALL AREAS DISTURBED DURING CONSTRUCTION THAT WILL NOT BE UNDER PROPOSED PAVEMENT SHALL BE RESTORED TO MATCH EXISTING CONDITIONS.
13. ANY SIDEWALK, DRIVE APPROACH, CURB, OR STREET PAVEMENT REMOVED TO CONSTRUCT PROJECT MUST HAVE A PAVEMENT CUT PERMIT AND BE REPLACED BY THE CITY CONTRACTOR. PERMITS CAN BE OBTAINED BY CALLING 316-268-4501 OR 316-268-4480.
14. ALL APPLICABLE FEES (TAP, EQUITY, IN LIEU OF & MAIN BENEFIT) MUST BE PAID BEFORE ANY CONNECTIONS CAN BE MADE ON THIS PROJECT. QUOTES CAN BE OBTAINED ON FEES BY CALLING CHRIS STONE AT 316-268-4641.
15. CITY MAINTENANCE OF WATER MAINS ENDS AT RIGHT-OF-WAY OR EASEMENT LINE OR WITHIN TWO FEET OF VAULT.
16. OPENING AND CLOSING OF WATER VALVES SHALL BE DONE SLOWLY TO PREVENT DAMAGE TO THE WATER DISTRIBUTION SYSTEM FROM WATER HAMMER. ALL VALVES CLOSED BY THE CONTRACTOR MUST BE REOPENED AS NEW CONSTRUCTION PERMITS. THE PROJECT INSPECTOR MUST ASCERTAIN THAT ANY VALVE CLOSED BY THE CONTRACTOR IS REOPENED. THE CONTRACTOR WILL BE PERMITTED TO OPERATE WATER VALVES ONLY WHEN THE PROJECT INSPECTOR ASSIGNED TO THE PROJECT IS PRESENT.
17. THE CONTRACTOR SHALL LAY A TRACER WIRE AND SET TEST STATIONS ALONG ALL WATER PIPE INSTALLED IN ACCORDANCE WITH CITY SPECIFICATIONS AND TRACER WIRE DETAIL ON DETAIL SHEET WL-101. COST IS SUBSIDIARY TO PIPE INSTALLATION.
18. THE CONTRACTOR SHALL PROVIDE MATERIALS FOR TEMPORARY BLOWOFF OF WATERLINES. CONNECTIONS TO THE EXISTING WATERLINE(S) SHALL BE MADE WITH CLEAN, SWABBED PIPE AND FLUSHED UPON COMPLETION OF TIE-INS.
19. REQUESTS FOR SHORT TERM WATER INTERRUPTIONS SHALL BE MADE TO THE CITY WATER DISTRIBUTION DIVISION AND WILL BE SUBJECT TO THEIR APPROVAL. THE CONTRACTOR SHALL GIVE WRITTEN NOTICE TO ANY PROPERTY OWNER, BUSINESS, AND/OR TENANTS THAT WILL HAVE WATER SERVICE INTERRUPTED AT LEAST 5 DAYS IN ADVANCE. SUCH NOTIFICATIONS SHOULD INDICATE THE TIME AND DATE THAT THE WATER WILL BE TURNED OFF AND WHEN THE SERVICE WILL BE RESTORED. NO BUSINESS, PROPERTY OWNER, AND/OR TENANTS SHALL BE WITHOUT WATER SERVICE FOR MORE THAN 8 HOURS. PROPOSED TIE-IN LOCATIONS WHICH WILL AFFECT WATER SERVICE TO PROPERTY OWNERS SHALL BE PERFORMED DURING NON-PEAK HOURS.
20. THE CONTRACTOR MUST SCHEDULE THE CONNECTIONS TO THE EXISTING MAIN WITH THE CITY SUCH THAT THERE IS A MINIMUM DISRUPTION OF SERVICE. CONNECTIONS SHALL BE MADE DURING PERIODS OF LOW WATER USAGE. THE CONTRACTOR SHALL SUBMIT HIS PROPOSED SCHEDULE FOR COMPLETING WORK FOR CITY APPROVAL AT LEAST 10 DAYS PRIOR TO BEGINNING CONSTRUCTION.
21. DEFLECTIONS AT PIPE JOINT OR COUPLINGS SHALL NOT EXCEED THE PIPE MANUFACTURER'S RECOMMENDED MAXIMUM. WHERE DEFLECTIONS ARE GREATER THAN THE MAXIMUM ALLOWED, THE CONTRACTOR SHALL UTILIZE FITTINGS.
22. ANY EXISTING JOINT EXPOSED DURING EXCAVATION SHALL BE REPLACED IF WITHIN FOUR FEET OF PROPOSED JOINT.
23. VALVES 12 INCHES AND LARGER ARE TO BE OPERATED BY THE CITY WATER DISTRIBUTION DIVISION, 48 HOURS OF ADVANCE NOTICE IS REQUIRED WITH THE WATER DISPATCH AT 316-291-8921.
24. THE CONTRACTOR SHALL PROTECT FROM DAMAGE AND SUPPORT EXISTING UTILITIES THROUGH CONSTRUCTION AS APPROVED BY THE UTILITY OWNER AND THE ENGINEER AT THE CONTRACTOR'S EXPENSE.
25. CONTRACTOR SHALL LIMIT THE EXTENT OF TRENCH OPENINGS OVERNIGHT AND WEEKENDS TO LESS THAN 50 FEET.
26. WICHITA FIRE DEPARTMENT INSPECTIONS MAY BE SCHEDULED BY CALLING DAWNITA REINHARDT AT 316-268-4574.
27. MAINTAIN A MINIMUM 10-FOOT HORIZONTAL SEPARATION BETWEEN ALL WATER LINES (MAINS, SERVICES, AND FIRE HYDRANTS) AND ALL SANITARY SEWER LINES (MAINS, SERVICES, AND MANHOLES). ALL SEPARATION DISTANCES ARE TO BE MEASURED FROM EDGE-TO-EDGE, AT THE CLOSEST POINT.
28. MAINTAIN A MINIMUM OF 2-FOOT VERTICAL SEPARATION BETWEEN ALL WATER LINES (MAINS AND SERVICES) AND ALL GRAVITY SANITARY SEWER LINES (MAINS, SERVICES, AND MANHOLES) AT CROSSINGS, ALL SEPARATION DISTANCES ARE TO BE MEASURED EDGE-TO-EDGE, AT THE CLOSEST POINT. IF THE WATER PIPE IS BELOW THE SANITARY SEWER, REGARDLESS OF CLEAR SPACE, THE SANITARY SEWER SHALL BE REINFORCED CONCRETE ENCASED FOR A DISTANCE OF TEN FEET (10') EACH WAY FROM THE WATER LINE CROSSING.
29. MAINTAIN A MINIMUM OF 2-FOOT VERTICAL SEPARATION BETWEEN ALL WATER LINES (MAINS AND SERVICES) AND ALL PRESSURIZED SANITARY SEWER LINES (FORCE MAINS AND SERVICES) AT CROSSINGS. WATER LINES MUST ALWAYS BE PLACED ABOVE PRESSURIZED SANITARY SEWER LINES WHERE THEY CROSS. ALL SEPARATION DISTANCES ARE TO BE MEASURED EDGE-TO-EDGE, AT THE CLOSEST POINT.

PLOT DATE: 5/6/2026 11:28 AM
FILE PATH: X:\1115\R2300\06-Site Development\Operations Building Site Development\06-Site Development\4. Site Production\b. Sheets\Public Packages\PPW

PRIVATE WATER DISTRIBUTION SYSTEM

TO SERVE

AS-BUILT PLANS


WILKINS STADIUM EXPANSION PROJECT - PHASE 1B

1845 FAIRMOUNT ST.,
WICHITA, KS 67260

THE CITY OF WICHITA, KANSAS
PAUL GUNZELMAN, P.E. - CITY ENGINEER

PROJECT NUMBER
2026-008320PPW (54030980)

Baughman # 26-05-E498

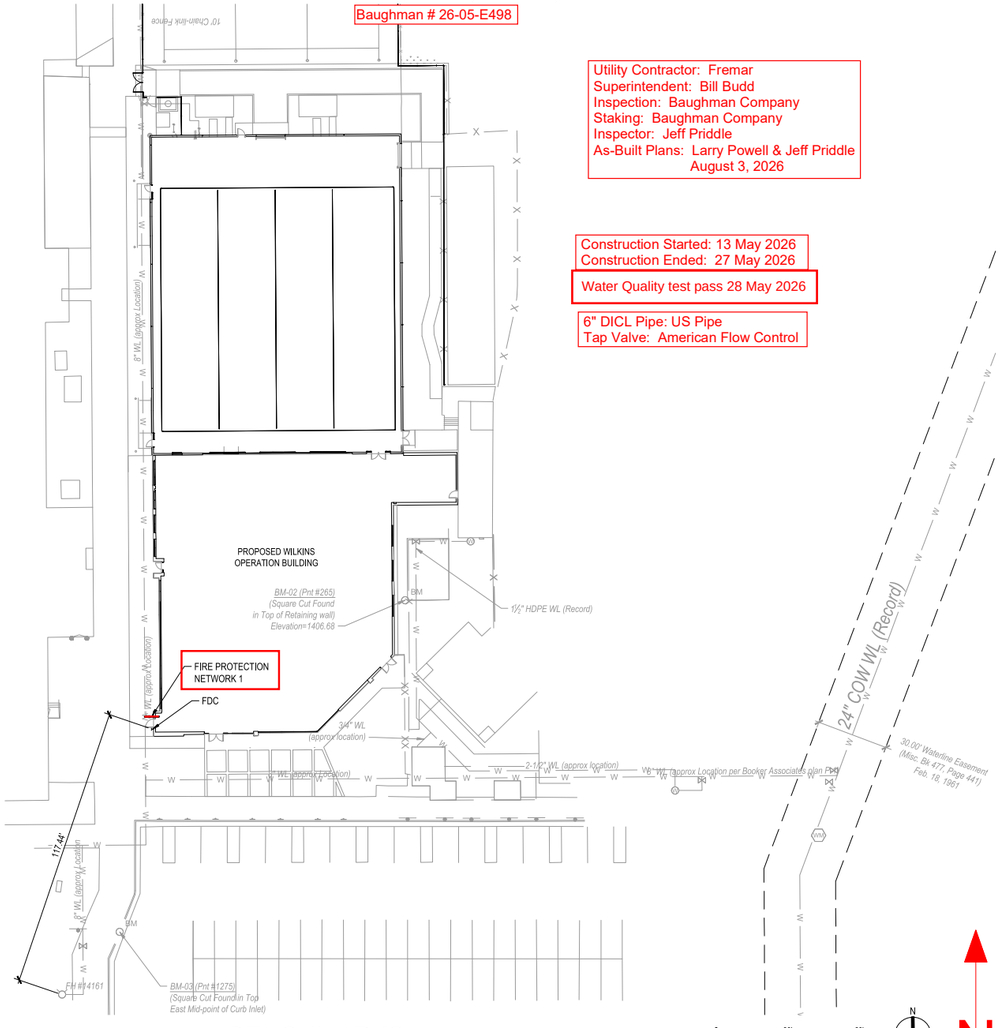

Utility Contractor: Fremar
Superintendent: Bill Budd
Inspection: Baughman Company
Staking: Baughman Company
Inspector: Jeff Priddle
As-Built Plans: Larry Powell & Jeff Priddle
August 3, 2026

Construction Started: 13 May 2026
Construction Ended: 27 May 2026

Water Quality test pass 28 May 2026

6" DICL Pipe: US Pipe
Tap Valve: American Flow Control

BENCHMARKS

BM-01
SQUARE CUT SET IN TOP CURB
N: 383,554.6788 E: 17,560,336.2351
ELEV = 1394.42

BM-02
SQUARE CUT FOUND IN TOP OF RETAINING WALL
N: 383,167.0526 E: 17,560,455.7888
ELEV = 1406.68

BM-03
SQUARE CUT FOUND IN TOP EAST MID-POINT OF CURB INLET
N: 383,028.0746 E: 17,560,336.0893
ELEV = 1402.19

Benchmarks used for As-Built GPS Survey.

CP-100
#4 IRON BAR W/BLUE "MERESTONE GPS CONTROL" CAP
N: 383,580.1886 E: 17,560,294.0246


CP-101
#4 IRON BAR W/BLUE "MERESTONE GPS CONTROL" CAP
N: 383,532.6385 E: 17,560,489.2799

CP-102
#4 IRON BAR W/BLUE "MERESTONE GPS CONTROL" CAP
N: 382,965.8643 E: 17,560,288.2470

CP-103
MAG NAIL SET IN ASPHALT
N: 382,974.8270 E: 17,560,483.8158

NOTE

TOPOGRAPHICAL SURVEY WAS PROVIDED BY MERESTONE SURVEYING. SEE SHEET GS001_SITE-SURVEY FOR BENCHMARK AND CONTROL POINT LOCATIONS.

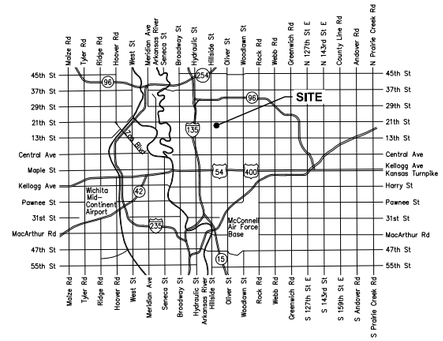

Vicinity Map

INDEX OF DRAWINGS

SHEET NO.	SHEET NAME
CU130	PPW COVER SHEET
CU230	WATER PLAN & PROFILE
CU530	WATER DETAILS
CU531	WATER DETAILS
CU532	WATER DETAILS
CU533	WATER DETAILS
CE101	EROSION CONTROL PLAN
CE501	EROSION CONTROL DETAILS
CE502	EROSION CONTROL DETAILS
CE503	EROSION CONTROL DETAILS
CE504	EROSION CONTROL DETAILS
CE505	EROSION CONTROL DETAILS
GS001	SITE SURVEY

APPROVED AS NOTED
BY WICHITA PUBLIC WORKS
ENGINEERING DIVISION
& BY WICHITA FIRE DEPARTMENT

Engineering	BETHANY MALLY 05/05/2026
Utilities	SCOTT MACEY 05/05/2026
Fire Department	JOSE OCADIZ 05/05/2026

NOTE TO CONTRACTORS

Public Property:
Inspection and testing for the waterline is to be provided by a Licensed Consulting Engineering Firm under contract with the Owner/Developer. Said inspection is to be in accordance with the City of Wichita standard construction engineering practices and certified by a Professional Engineer Licensed in the state of Kansas. No work shall be performed in dedicated easements or public rights-of-way by the Contractor without such inspection nor shall any work be commenced without written authorization by City Engineer. All Construction and Materials shall comply with the City of Wichita Specifications and Standards and Special Provision (on file and available in the City Engineer's office) or on the City's Website.

Private Property:
Installation and testing for the fire protection line is to be performed by a City of Wichita licensed fire protection contractor in accordance with the fire codes as adopted by the City of Wichita. All material and construction practices for the fire protection line shall comply with the fire codes as adopted by the City of Wichita (available from the City of Wichita Fire Department). The Contractor shall not commence work without notification and approval of the Wichita Fire Department. Inspection of the fire protection line is to be provided by a licensed Engineering Firm under contract with the Owner/Developer and the Fire Department. The contractor shall not start work until the project inspector is assigned to the project and present on the site. Any work done without inspection will be required to be uncovered for inspection.

An approved copy of these plans signed by City staff is required on-site.

TESSERE
www.tessere.com

All work herein is the exclusive property of TESSERE and is not to be copied or used in any way without the express written consent of TESSERE. All drawings, specifications, ideas, designs, and arrangements appearing herein constitute the original and unpublished Work of:
© 2025 TESSERE

LARRY L. HERSHEY
LICENSED
24435
05/06/2026
KANSAS
PROFESSIONAL ENGINEER

WILKINS PHASE 1b: TEAM OPERATIONS BUILDING

WICHITA STATE UNIVERSITY
1845 FAIRMOUNT STREET, WICHITA, KS 67260 - BUILDING NUMBER 71500-00097


△	DESCRIPTION	DATE
PROJECT NO:		A-014854(a)
STATUS:	PRELIMINARY REVIEW	
DATE:		04/29/2025
DRAWN BY:		LM
CHECKED BY:		KLH

PPW COVER SHEET

CU130


NOTE: CONTRACTOR RESPONSIBLE FOR INSTALLATION OF TAPPING SLEEVE & VALVE AND TAPPING OF EXISTING PRIVATE WATER MAIN.

6" V 53641

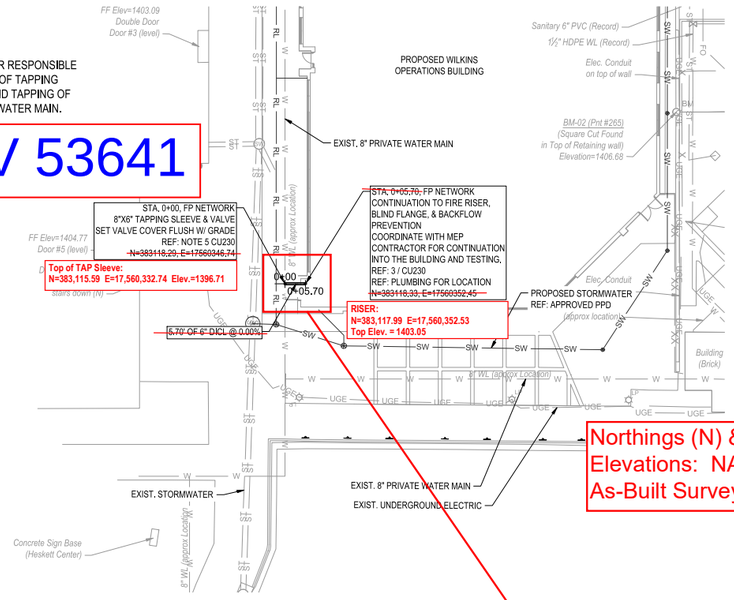

1 FIRE PROTECTION NETWORK - PLAN

GRAPHIC SCALE 20'

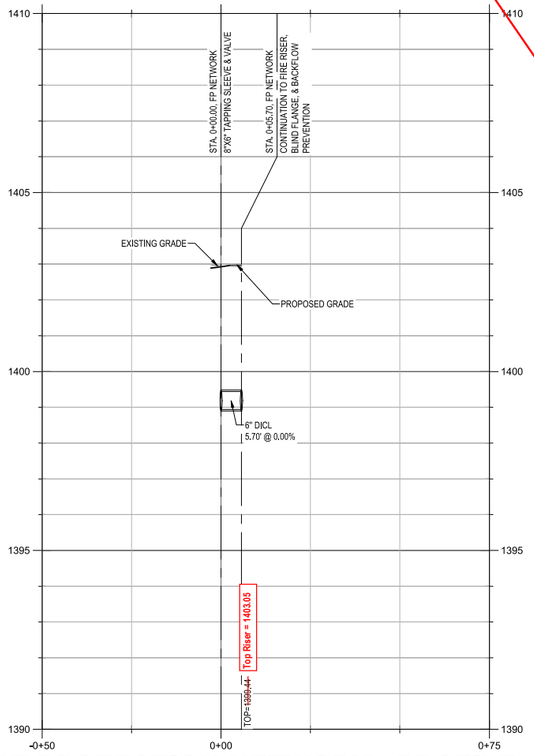

2 FIRE PROTECTION NETWORK - PROFILE

HORIZONTAL: 1" = 20', VERTICAL: 1" = 2

NOTES:


1 - Existing Water Main was located approximately 14 feet West of Plan Location.

2 - Fire Line TAP was offset 3' to South to avoid existing AC Pipe Bell in Water Main.

LEGEND


TS = Test Station

Northings (N) & Eastings (E): State Plane Coordinates - Kansas Regional Coordinate System, Wichita / Zone 17 (KRCS,Wichita).
Elevations: NAVD88 (Geoid 18).
As-Built Survey Shots By: Baughman Company, P.A.

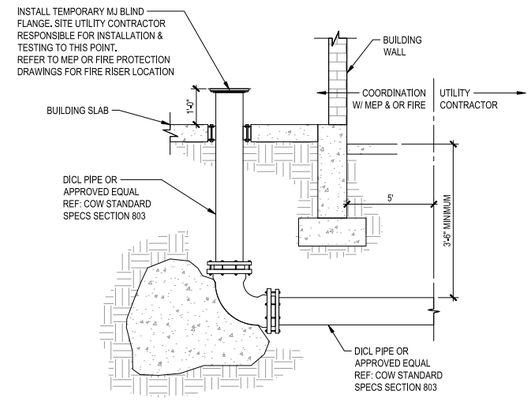

3 FIRE PROTECTION CONNECTION

NTS

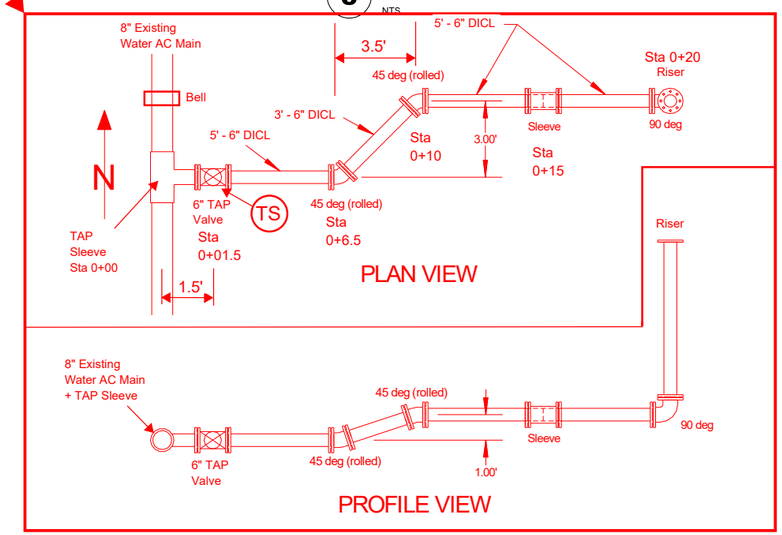

NOTES

1. CONTRACTOR TO VERIFY LOCATION AND ELEVATION OF EXISTING WATER LINE PRIOR TO CONSTRUCTION.
2. STUB ALL CONNECTIONS TO WITHIN 5' OF THE BUILDING TO PROVIDE CONNECTION INTO THE BUILDING BY MECHANICAL PLUMBING CONTRACTOR.
3. UTILITY CONTRACTOR TO COORDINATE BUILDING CONNECTION POINTS WITH PLUMBING PLAN AND BUILDING CONTRACTOR.
4. UTILITY CONTRACTOR RESPONSIBLE FOR MATERIALS AND TAPPING OF EXISTING WATER MAIN.
5. LOCATION AND DEPTH OF 8" WATER MAIN IS AN APPROXIMATION. FIELD VERIFICATION DURING PHASE 1A IDENTIFIED THE WATERLINE AS FURTHER WEST THAN DEPICTED. EXACT CONNECTION TO THE WATER MAIN MUST BE VERIFIED IN THE FIELD AND MAY NOT REFLECT THESE PLANS.

TESSERE
www.tessere.com

All work herein is the exclusive property of TESSERE and is not to be copied or used in any way without the express written consent of TESSERE. All drawings, specifications, ideas, designs, and arrangements appearing herein constitute the original and unpublished Work of:
© 2025 TESSERE

LUKE L. HERSKY
CENSED
24435
05/06/2026
KANSAS
PROFESSIONAL ENGINEER

WILKINS PHASE 1b:
TEAM OPERATIONS BUILDING


WICHITA STATE UNIVERSITY
1845 FAIRMOUNT STREET, WICHITA, KS 67260 - BUILDING NUMBER 71500-00097

△	DESCRIPTION	DATE
PROJECT NO:		A-014854(a)
STATUS:		PRELIMINARY REVIEW
DATE:		04/29/2025
DRAWN BY:		LM
CHECKED BY:		KLH

WATER PLAN & PROFILE


CU230

PLOT DATE: 5/6/2026 11:14 AM
FILE PATH: X:\111158\R23003\06-Site Development\Operations Building Site Development\06-Site Development\4. Site Production\b. Sheets\Public Packages\PPW

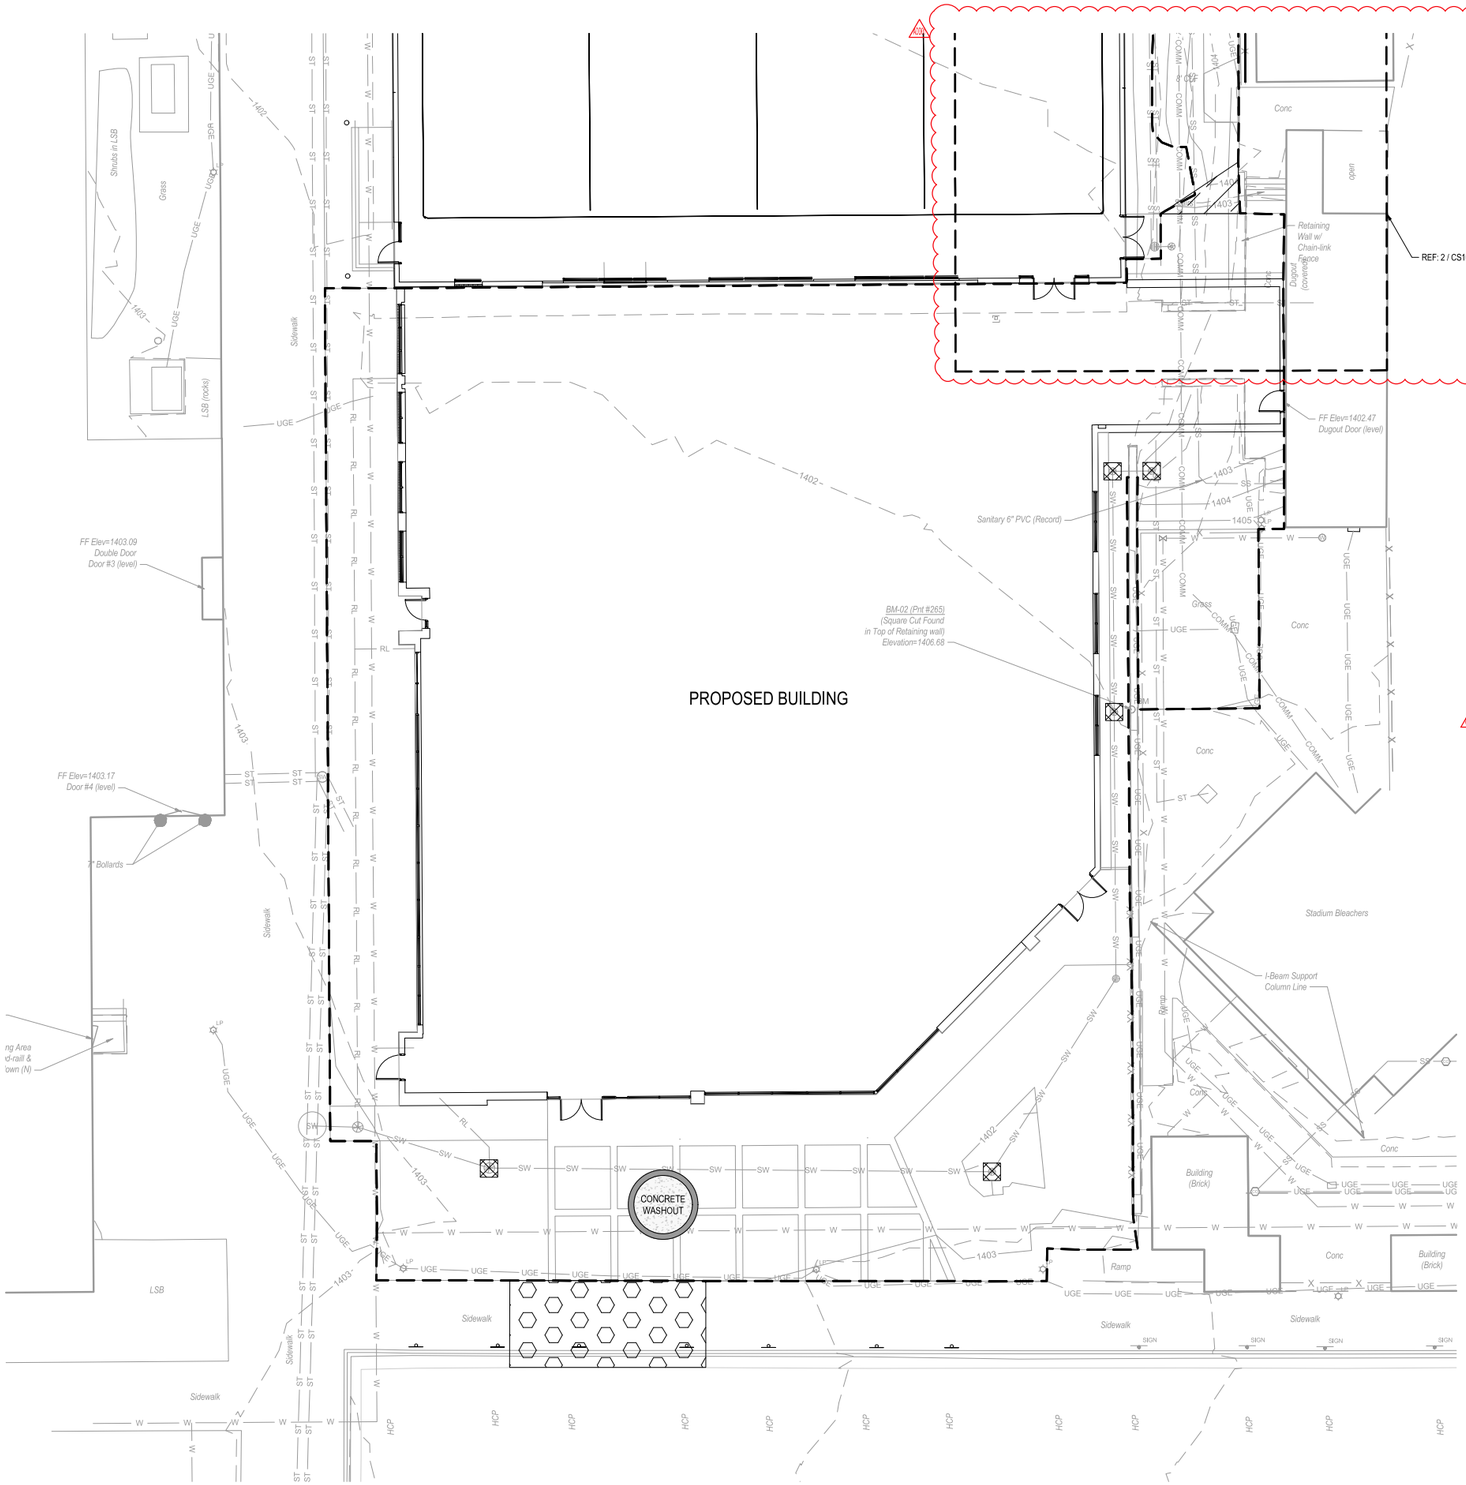

1 **EROSION CONTROL PLAN**

GRAPHIC SCALE 10'

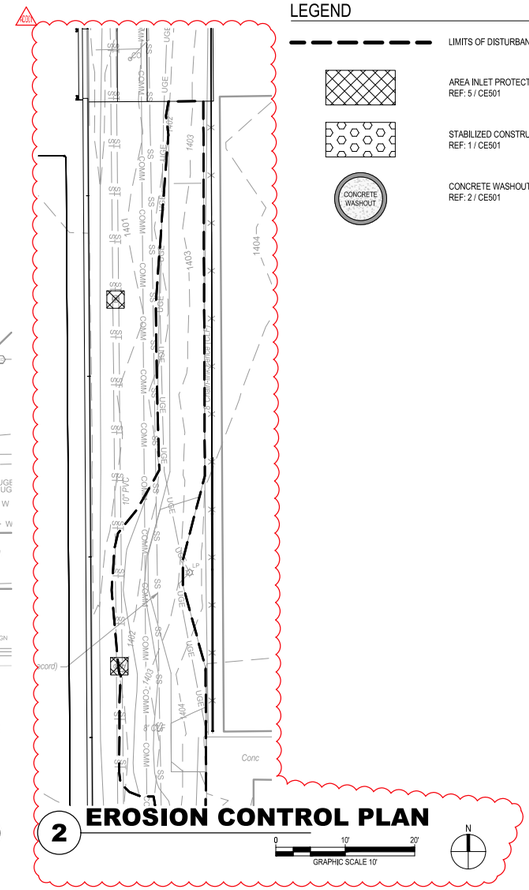

2 **EROSION CONTROL PLAN**

GRAPHIC SCALE 10'

EROSION CONTROL NOTES

1. REFERENCE C-010 FOR GENERAL NOTES APPLICABLE TO THIS DRAWING.
2. TOTAL DISTURBED AREA: 0.43 ACRES (17,350 S.F.)
3. TO PREVENT EROSION AND SEDIMENT FROM LEAVING THE CONSTRUCTION SITE, THE FOLLOWING STEPS SHALL BE TAKEN DURING CONSTRUCTION:
   - 3.1. PRIOR TO STARTING ANY SOIL DISTURBING ACTIVITIES, THE CONTRACTOR SHALL INSTALL PERIMETER EROSION AND SEDIMENT CONTROL MEASURES AND GRAVEL CONSTRUCTION ENTRANCES.
   - 3.2. INSTALL SILT FENCE AT INDICATED LOCATIONS AND OTHER LOCATIONS, AS NECESSARY, TO CONTROL SOIL EROSION. SILT FENCE SHALL BE KEPT IN PLACE UNTIL THE PROJECT HAS REACHED FINAL STABILIZATION.
   - 3.3. CONSTRUCTION ENTRANCE SHALL BE MAINTAINED BY THE CONTRACTOR IN A CONDITION THAT WILL PREVENT TRACKING OR FLOWING OF SEDIMENT ONTO PUBLIC RIGHT-OF-WAYS AND PAVED STREETS. THIS MAY INCLUDE PERIODIC TOP DRESSING WITH ADDITIONAL CRUSHED STONE AS CONDITIONS WARRANT. REPAIR OF ENTRANCE(S) AND CLEANING OF RIGHT-OF-WAYS AND PAVED STREETS THAT HAVE BEEN SOILED BY CONSTRUCTION ACTIVITIES SHALL BE THE CONTRACTOR'S RESPONSIBILITY.
   - 3.4. DURING ALL SOIL DISTURBING ACTIVITIES, THE CONTRACTOR SHALL TAKE APPROPRIATE STEPS USING ACCEPTED CONSTRUCTION METHODS TO MINIMIZE THE TIME OF EXPOSURE OF UNPROTECTED SOIL AND OTHER CONSTRUCTION MATERIALS TO RAINFALL. PARTICULAR CARE MUST BE EXERCISED WHEN DEALING WITH STOCKPILES OF TOPSOIL OR FILL MATERIALS AND WITH SOIL ON SLOPES.
   - 3.5. SOIL STOCKPILED FOR MORE THAN 7 DAYS SHALL HAVE SILT FENCE PLACED ON THE DOWNHILL SIDE TO TRAP SEDIMENT.
   - 3.6. NO GROUND SHALL BE LEFT DISTURBED FOR MORE THAN 14 DAYS OF NON-ACTIVITY WITHOUT BEING TEMPORARILY MULCHED AND/OR SEEDED.
   - 3.7. EROSION CONTROLS SHALL BE INSPECTED AND MAINTAINED BY THE CONTRACTOR NOT LESS THAN WEEKLY AND WITHIN 24 HOURS AFTER A RAINFALL EVENT OF 0.5 INCHES OR MORE. MAINTENANCE SHALL INCLUDE, BUT NOT BE LIMITED TO, SEDIMENT REMOVAL AND SILT FENCE REPAIR AND/OR REPLACEMENT.
   - 3.8. WHENEVER DIRT, ROCK, OR OTHER MATERIALS ARE EXPORTED FOR PLACEMENT IN AREAS OFF THE PRIMARY CONSTRUCTION SITE, THE CONTRACTOR IS RESPONSIBLE FOR DETERMINING THAT ALL JURISDICTIONAL AUTHORITY REQUIREMENTS ARE MET. THE CONTRACTOR WILL FURNISH THE ENGINEER WITH A WRITTEN AGREEMENT, SIGNED BY EACH LANDOWNER WHO WILL RECEIVE EXPORTED MATERIALS, STATING THAT THE RECEIVING SITE WILL BE PROPERLY PERMITTED, WHEN REQUIRED.

EROSION CONTROL INSTALLATION SEQUENCE

THE RECOMMENDED SEQUENCE OF CONSTRUCTION ACTIVITIES AND OF THE INSTALLATION AND REMOVAL OF EROSION AND SEDIMENT CONTROL MEASURES IS AS FOLLOWS:

1. INSTALL STABILIZED CONSTRUCTION ENTRANCE AND LINEAR PERIMETER CONTROLS AS SHOWN ON PLAN.
2. BEGIN CONSTRUCTING SITE IMPROVEMENTS. INSTALL BMP'S PER PLAN AS SITE DEVELOPMENT PROGRESSES TOWARDS FINAL DESIGN.
3. SEED, FERTILIZE, AND MULCH ALL SLOPES AND DISTURBED AREAS.
4. REMOVE TEMPORARY PRACTICES AND PERIMETER CONTROLS ONCE FINAL STABILIZATION HAS BEEN ACHIEVED.

LEGEND

- LIMITS OF DISTURBANCE
- AREA INLET PROTECTION — REF: 5 / CE501
- STABILIZED CONSTRUCTION ENTRANCE — REF: 1 / CE501
- CONCRETE WASHOUT — REF: 2 / CE501

SHEET SEQ: 010
PLOT DATE: 5/6/2026 10:04 AM
FILE PATH: X:\11158P23005\06-Site Development\Operations Building Site Development\06-Site Development\4. Site Production\b. Sheets
TESSERE Project #: 11158P23005

TESSERE
www.tessere.com

All work herein is authored by TESSERE and is not to be copied or used in any way without the express written consent of Wichita State University. All drawings, specifications, ideas, designs, and arrangements appearing herein constitute the original and unpublished Work of.
© 2025 TESSERE

KURT L. HEASLIP
LICENSED
24435
05/06/2026
KANSAS
PROFESSIONAL ENGINEER

DESCRIPTION	DATE
ADD01 ADDENDUM 1	01/07/2026

WICHITA STATE UNIVERSITY
FACILITIES PLANNING
WICHITA STATE UNIVERSITY
1845 Fairmount St.
Wichita, KS 67260
Tel: (316) 978-3444
www.wichita.edu

WICHITA STATE UNIVERSITY
WILKINS PHASE 1b: TEAM OPERATIONS BUILDING
1845 Fairmount St., Wichita, KS 67260
BUILDING NUMBER 71500-00097

DATE: 04/30/2025 DRAWN BY: LM CHECKED BY: KLH


EROSION CONTROL PLAN

A-014854(a)


CE101

ORIGINAL CONTRACT DOCUMENTS

TOPOGRAPHIC SURVEY FOR
WICHITA STATE UNIVERSITY WILKENS STADIUM

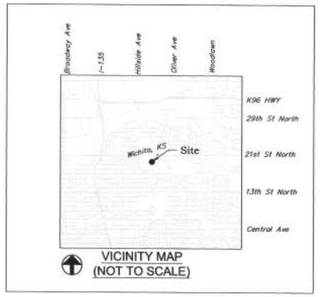

VICINITY MAP
(NOT TO SCALE)

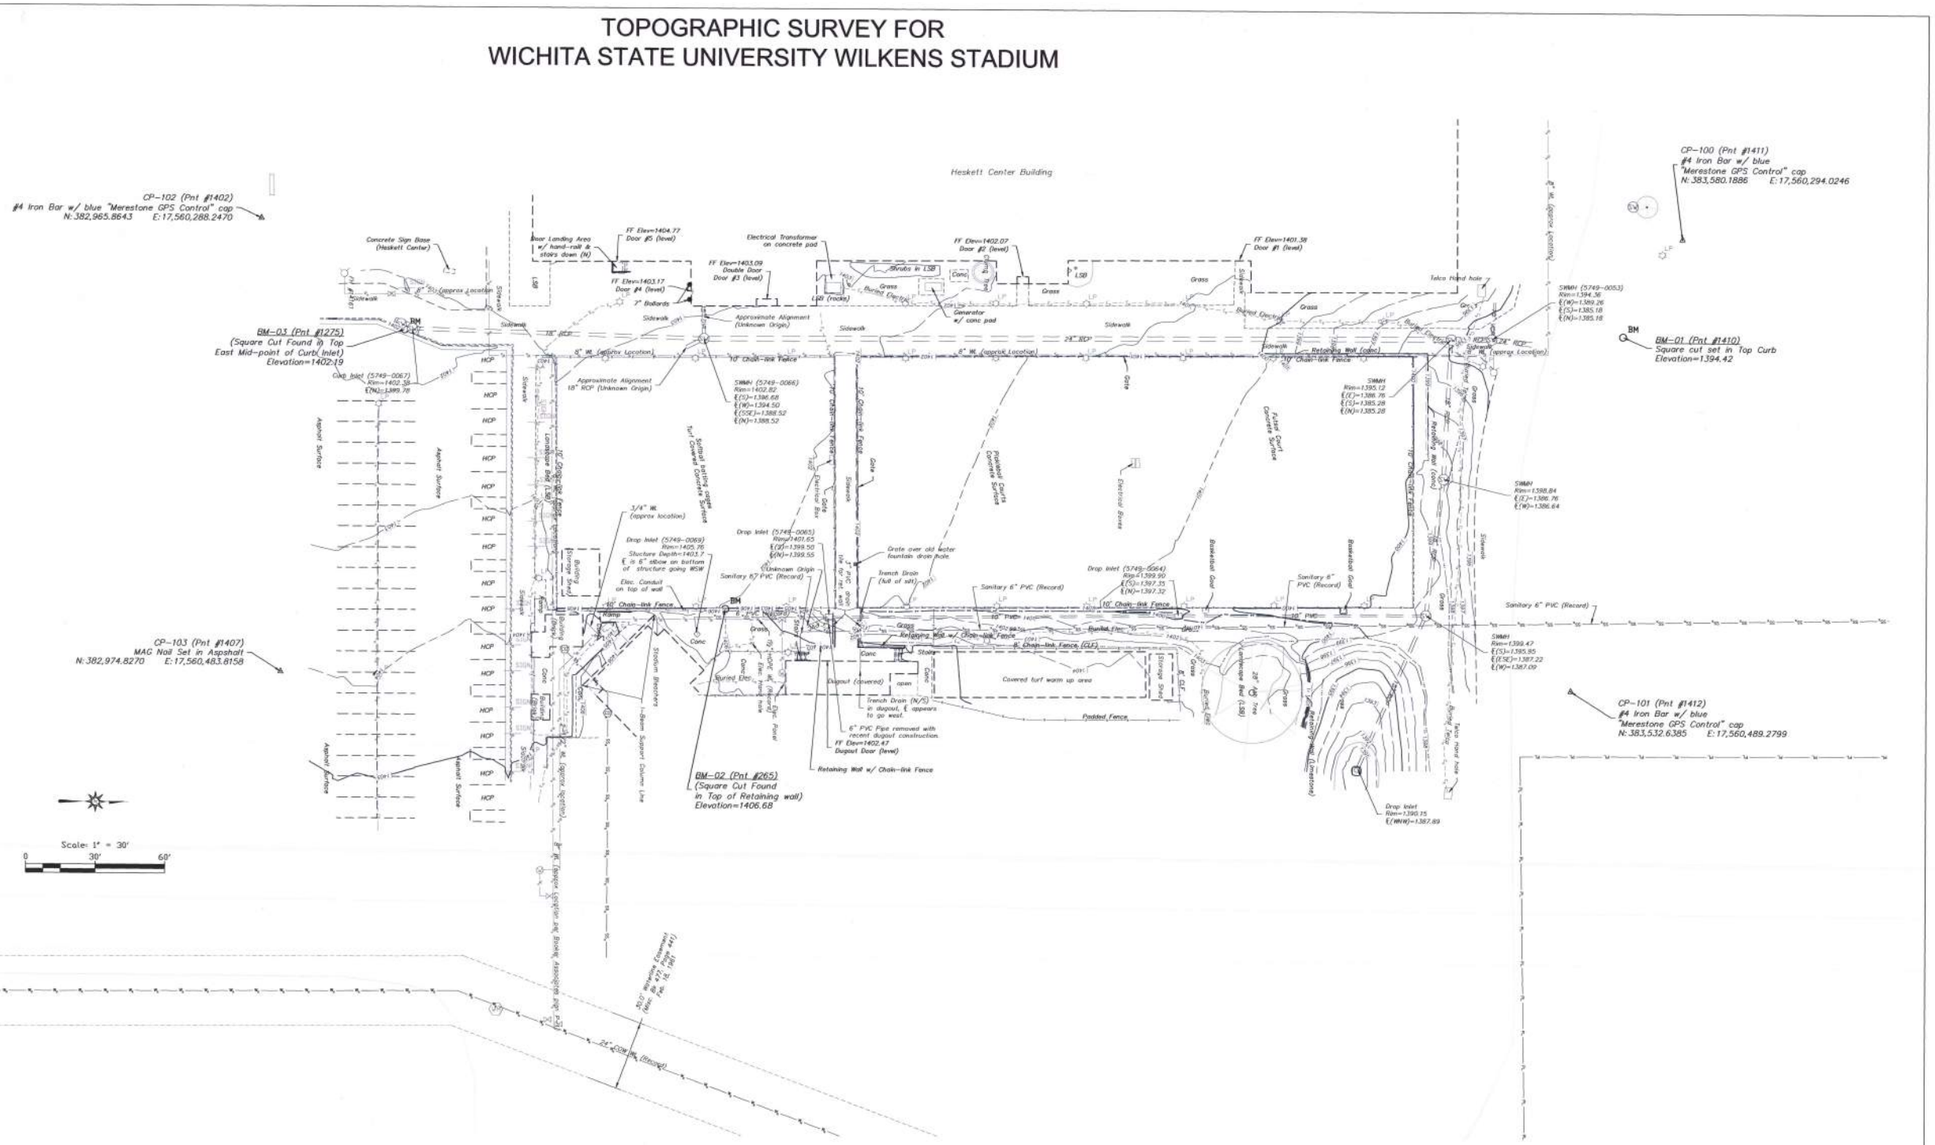

Legend:

- Control Point
- Benchmark
- Communication Pedestal
- Telco Manhole
- Guy Anchor
- Light Pole
- Utility Pole
- Sign
- Sanitary Sewer Manhole
- Cleanout
- Water Meter
- Water Valve
- Fire Hydrant
- Storm Water Manhole
- Storm Water Catch Basin
- (P) Per Plat
- (M) Measured
- (CM) Calc'd from Measured
- (D) per Deed (as described)
- Tree
- Gas Meter
- Traffic Control Box
- Monitoring Well
- Building Line
- Building Overhang/Canopy
- Building Setback Line
- Overhead Communication Line
- Underground Communication Line
- Underground Gas Line
- Overhead Electric Line
- Underground Electric Line
- Parking Strip
- Asphalt Pavement Edge
- Concrete Pavement Edge
- Concrete Curb & Gutter
- Gravel Edge
- Existing Fence
- Landscape Bed
- Wall/Retaining Wall
- Sanitary Sewer Line
- Storm Water Pipe
- Sidewalk (Concrete)
- Ground Contour Index (5')
- Ground Contour Minor (1')

SURVEY NOTES:

1. This Topographic survey does not constitute a Boundary Survey and should not be relied upon for such.
2. Horizontal Coordinate System: USA COUNTY KS/KRCS 17 Wichita NAD83 (2011) LCC (US Ft)
3. Vertical Datum: NAVD88 (Geoid18)

UTILITY NOTES:

1. Kansas One Call System : (800) 344-7233 or 811 Ticket No. 23475479.
2. The utilities as shown on this drawing were developed from the information available (existing utility maps, aboveground observations and or surface markings placed on the ground by the utility company or a representative thereof). This company has made no attempt to excavate or go below surface to locate utilities and does not extend or imply a guaranty or warranty as to the exact location of or complete inventory of utilities in this area. It shall be the contractors responsibility to verify the location and depth of all utilities (whether shown or not) prior to excavation or construction and to protect said utilities from damage.

Topographic Survey Certification

We, MERESTONE SURVEYING, certify that this Topographic Survey project was completed under my direct and responsible charge from an actual survey made under my supervision; that the original data was obtained on September 8th, 2023; that the survey was completed on September 19th, 2023; and all coordinates are based on NAD83 Kansas Regional Coordinate System (KRCS), Zone 17, in US Survey Feet and all elevations are based on the NAVD88 datum with Geoid18 model applied.

TODD P. HORNBAKER LS-1532 KANSAS LAND SURVEYOR

Todd P. Hornbaker
Kansas P.S. #1532,
CLS #179

Merestone Surveying

TOPOGRAPHIC SURVEY
Wilkens Stadium WSU Campus
1845 FAIRMOUNT
WICHITA, KS 67260

216 W. Rosewood St., Rose Hill, KS 67133 P:316-425-7770 F:316-425-7773
ENGINEERING | SURVEYING | GIS | MAPPING

PROJECT NUMBER	DESIGN	DRAWN
23-09-384	—	TPH
REVISIONS: -	APPROVED BLP	DATE 10/2/23
	SCALE AS NOTED	
	SHEET 1 OF 1	

K:\CAD\Design Survey\F_GLMV\23-09-384 Wilkins Stadium\DWG

Plot Date: October 2, 2023
Paper Size: ARCH D