PROJECT INSPECTION DAILY REPORT

WL

BAUGHMAN COMPANY, P.A. WICHITA, KANSAS

PROJECT: Private Water Distribution System Improvements to serve WICHITA BIOMEDICAL CAMPUS

DATE: 7-14-26

DAY: TUESDAY

CITY NUMBER: #2024-006370 PPW

BAUGHMAN JOB #: 24-07-E833

INSPECTOR: Larry Powell

UTILITY CONTRACTOR: McCullough Excavation

FOREMAN: Carlos

INSPECTOR ON-SITE: 10:11AM-10:21AM 2:22PM-2:38PM

WEATHER: Sunny, Lt. Winds

LOW: 71 °F HI: 90 °F

EQUIPMENT: Mini-Excavator

MATERIALS:

WORK PERFORMED: * Began Work on Relocating FH
* Kansas Concrete Saw Cutting on-site. Will cut sidewalk/street.
* McCullough crew Pot Holing for electric line.
* McCullough removing PCCP from Street @ FH location #2.
* TAP Pit being excavated, further West due to Repair/Joint on existing Water Main.

REMARKS: * Carlos says COW may TAP on Wednesday.

WL PROJECT INSPECTION DAILY REPORT

BAUGHMAN COMPANY, P.A. WICHITA, KANSAS

PROJECT: Private Water Distribution System Improvements to serve WICHITA BIOMEDICAL CAMPUS

DATE: 7-16-26

DAY: THURSDAY

CITY NUMBER: #2024-006370 PPW

BAUGHMAN JOB #: 24-07-E833

INSPECTOR: Larry Powell

UTILITY CONTRACTOR: McCullough Excavation

FOREMAN: Carlos

INSPECTOR ON-SITE: 7:42AM - 8:37AM, 1:14PM - 1:50PM

WEATHER: cloudy, Lt. Winds, Rain = Trace FH LOW: 73 °F HI: 92 °F

EQUIPMENT: Mini-Ex (Komatsu) 6" Valve = American Flow

MATERIALS: 8" TAP Valve = CLOW, 6" DICL = McWane, FH's = American Darling

WORK PERFORMED: ★ Continued Fire Hydrant Work.

- Location #2 is now TAP'd, By COW on 7-15-26 (8" PVC).
- Location #2 old FH now excavated. Nothing removed yet.
- Location #2 = Installed new FH. To be Adjusted Up later.
- Location #1 being hydro-excavated. Crew waiting for a 8"x8"x6" TEE. No Wet TAP necessary.
- Crew removed old FH + Valve + Pipe, Capped ex. 8" Pipe to South. Installed Tee just 2' South of Ex. 8" Valve. New 6" FH Valve installed on TEE, (Location #1).

REMARKS: ★ I have Sept '24 plans for this job.
★ McCullough (Carlos) has Aug '24 Plans. Sept Plans called for FH Valve removal. Rob Gray wants to leave Valve per Sept '24 Plans. Rob to call Dawnita for final decision.
★ Sketched Location #2, and Location #1.
★ Taylor Ratzlaff - JeDun GC = OK with work @ Location #1.
★ Conc. Thrust Blocks Friday 1PM

WL

PROJECT INSPECTION DAILY REPORT

BAUGHMAN COMPANY, P.A. WICHITA, KANSAS

PROJECT: Private Water Distribution System Improvements to serve WICHITA BIOMEDICAL CAMPUS

DATE: 7-17-26

DAY: FRIDAY

CITY NUMBER: #2024-006370 PPW

BAUGHMAN JOB #: 24-07-E833

INSPECTOR: Larry Powell

UTILITY CONTRACTOR: McCullough Excavation

FOREMAN: Carlos

INSPECTOR ON-SITE: 12:12PM – 2:12PM

WEATHER: AM Rain = Trace, Partly cloudy, Lt Wind LOW: 69 °F HI: 91 °F

EQUIPMENT: Mini-Excavator

MATERIALS: Pea Gravel, Fill Sand, Valve Boxes (Plastic)

WORK PERFORMED: ★ Continued Fire Hydrant Work:

★ Installed Test Stations. FH Barells wrapped in black Plastic, at Locations 1+2.

★ Installed 12" Raised Extensions to both FH's.

★ ~~Partially~~ Backfilled with Sand both locations (Dry).

★ Placed Thrust Blocks at both Locations. Good ✓.

★ Placed Pea Gravel @ Loc. #2 (2-Buckets) + Loc. #1 (2-Buckets). Good ✓

★ Placed Warning Tape @ Loc's #2 + #1.

★ Placed Valve Boxes @ Loc's #1 + #2.

REMARKS: ★ Pressure Tests next week (Gabriel). No Q needed.


★ Photos Taken.

★ Sand Fill, Flush + Vibrate Monday July 20th.

★ FH + Valve Removal on Monday July 20th.


BAUGHMAN COMPANY, P.A.
ENGINEERING, SURVEYING & PLANNING
316/262-7271 FAX 316/262-0149 WICHITA, KANSAS 67211

Project Name	WICHITA BIOMEDICAL CAMPUS - FIRE HYDRANT RELOCATIONS		
City Project No.	#2024-006370 PPW	Date:	7-17-26 + 7-22-26 + 7-16-26
Baughman No.	24-07-E833		
Contractor	McCULLOUGH EXCAVATION	Inspector:	Larry Powell
Description	As-Built Sketch Location #2 (on Alignment ✓)		

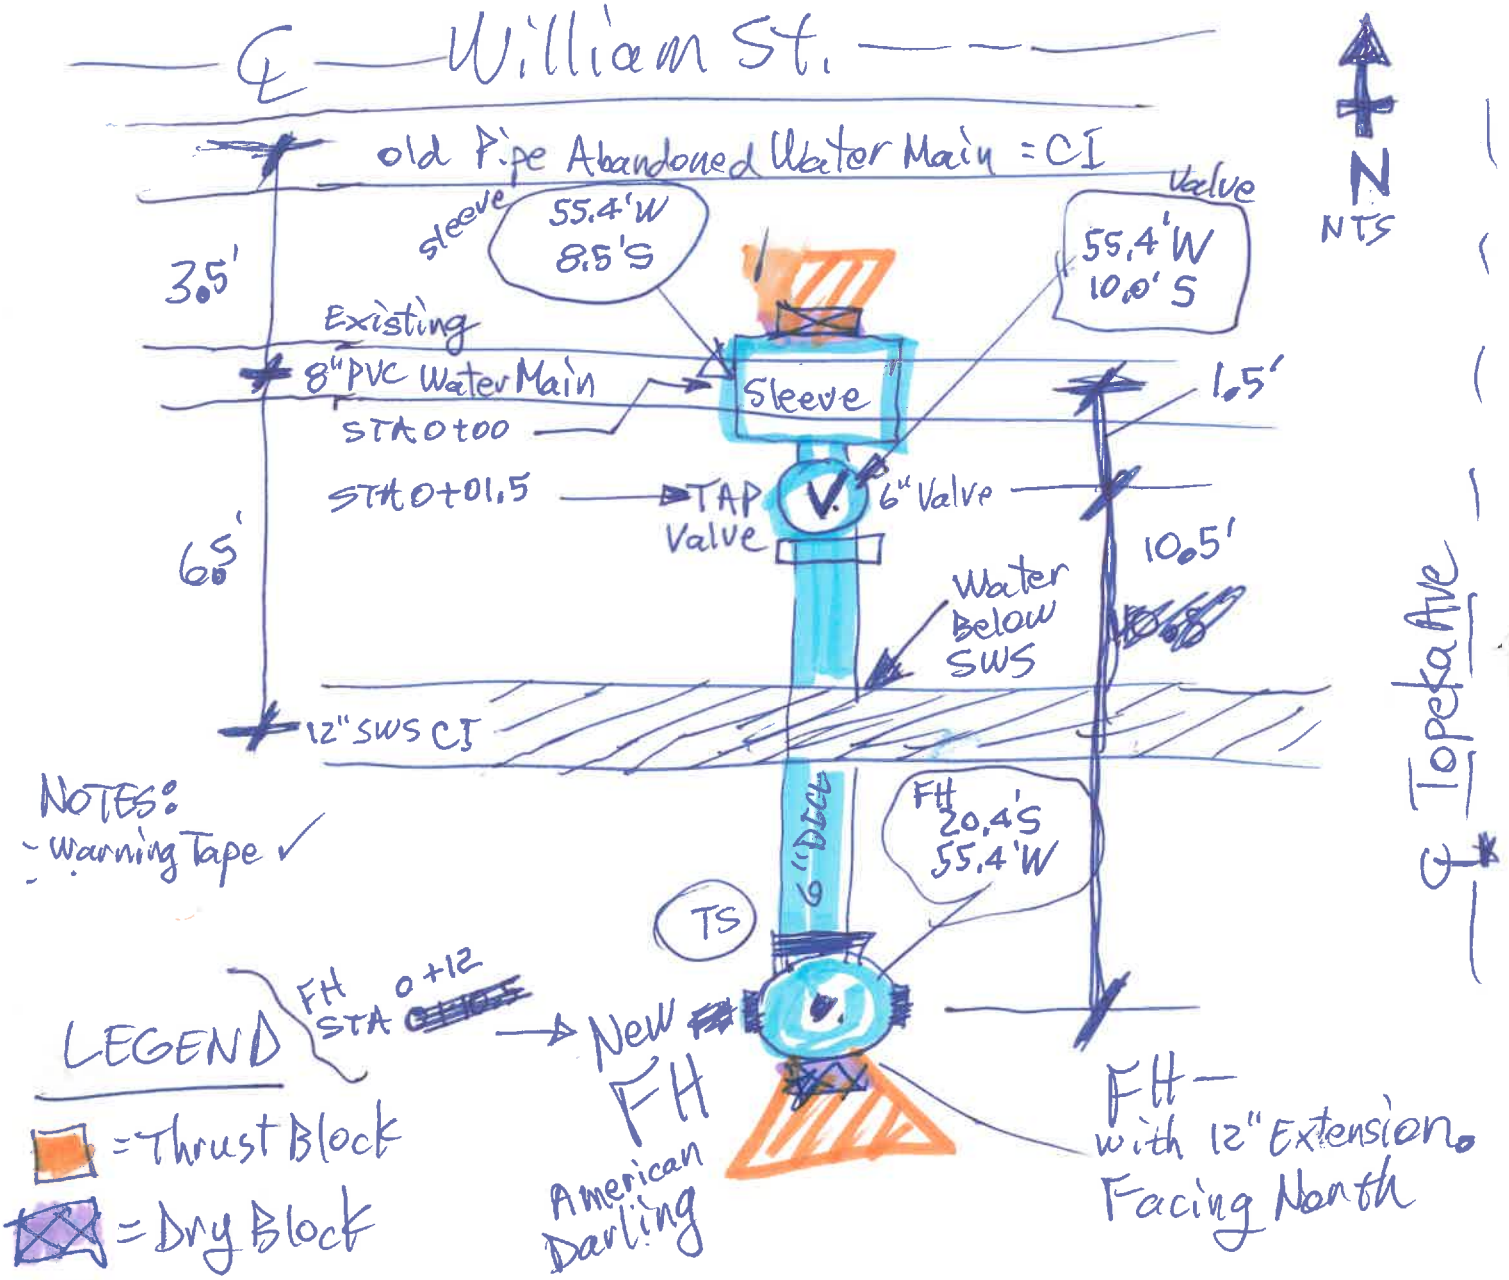

BAUGHMAN COMPANY, P.A.
ENGINEERING, SURVEYING & PLANNING
316/262-7271 FAX 316/262-0149 WICHITA, KANSAS 67211

Project Name	WICHITA BIOMEDICAL CAMPUS - FIRE HYDRANT RELOCATIONS		
City Project No.	#2024-006370 PPW		7-17-26 + 7-22-26
Baughman No.	24-07-E833	Date:	7-16-26
Contractor	McCULLOUGH EXCAVATION	Inspector:	Larry Powell
Description	As-Built Sketch - Location #1 FH Relocation		

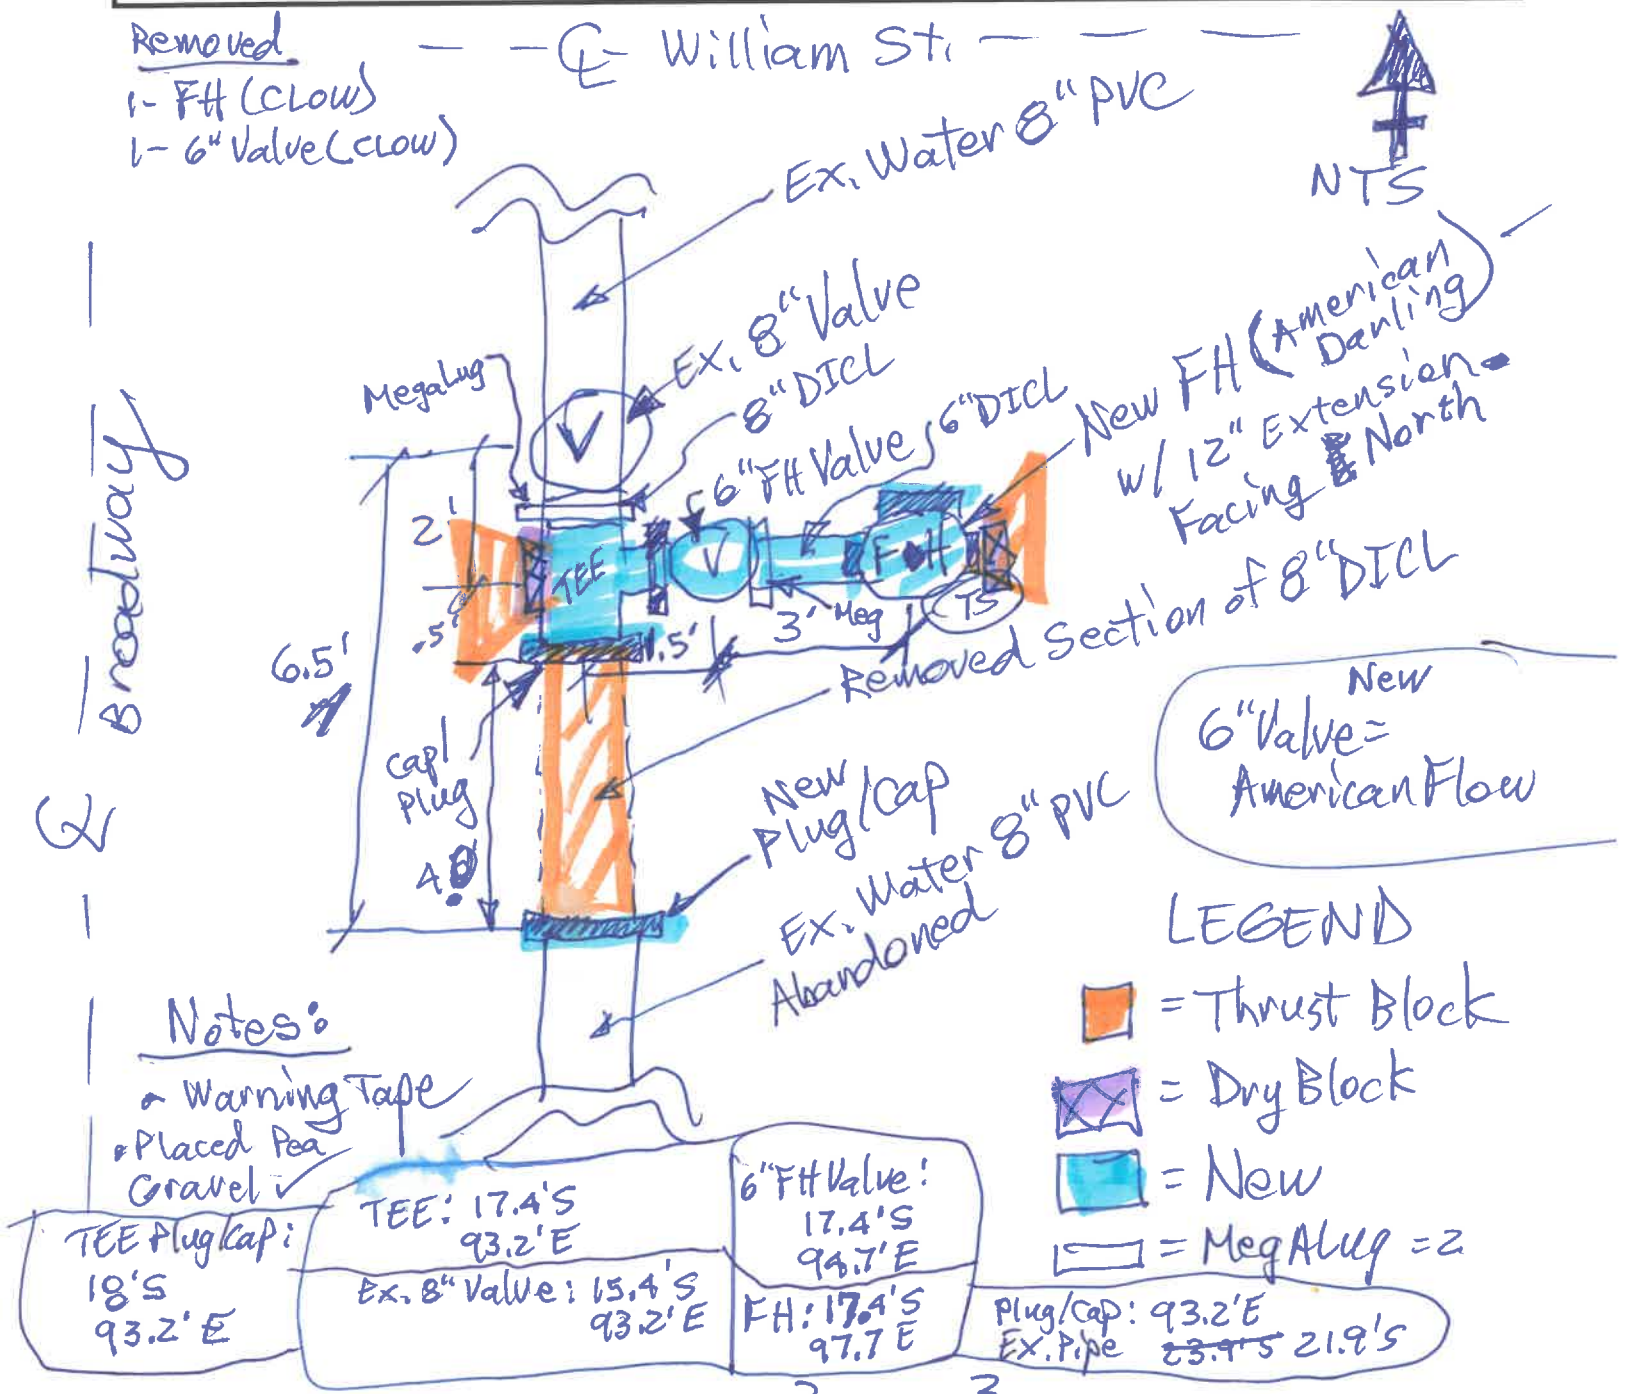

WL

PROJECT INSPECTION DAILY REPORT

BAUGHMAN COMPANY, P.A. WICHITA, KANSAS

PROJECT: Private Water Distribution System Improvements to serve WICHITA BIOMEDICAL CAMPUS

DATE: 7-20-26

DAY: MONDAY

CITY NUMBER: #2024-006370 PPW

BAUGHMAN JOB #: 24-07-E833

INSPECTOR: Larry Powell

UTILITY CONTRACTOR: McCullough Excavation

FOREMAN: Carlos

INSPECTOR ON-SITE: 9:04 AM – 10:04 AM & 1:33 PM – 1:53 PM

WEATHER: Sunny, Lt. Winds

LOW: 74 °F HI: 100 °F

EQUIPMENT: Mini-Excav.

MATERIALS: PCconc sand Mix, CI Cap/Plug,

WORK PERFORMED: ★ Continued Fire Hydrant Works

★ Shut off Water Mains. (only for 2hrs-Max). – 3 Total Valves.

★ Removed Fire Hydrant + 6" Valve + 6" DICL Pipe (6").

★ Removed items back to TOP of 90° BEND (Vertical).

★ Installed CI Plug/Cap.

★ Installed Thrust Block (Dry Blocks) + ~~Concrete Sand Mix (Bgs).~~

★ Installed Wood Shims to lock Dry Blocks against old FH thrust Block.

★ Placed Pre-Mix Concrete Sand Mix over all Dry Blocks.

★ Turned Water back on @ 10 AM +/-.

★ Sand-Fill & Flush - Vibrated all 3 locations.

REMARKS: ★ Took Photos of old FH + Valve removed.


★ Took Photos of all work in excavation.

★ Gen. Contr. wants Temp. Pvmt in all 3 locations.

★ Now ready for Pressure Testing. Time/Date = Unknown.

BAUGHMAN COMPANY, P.A.
ENGINEERING, SURVEYING & PLANNING
316/262-7271 FAX 316/262-0149 WICHITA, KANSAS 67211

Project Name	WICHITA BIOMEDICAL CAMPUS - FIRE HYDRANT RELOCATIONS		
City Project No.	#2024-006370 PPW	Date:	7-22-26 + 7-20-26
Baughman No.	24-07-E833		
Contractor	McCULLOUGH EXCAVATION	Inspector:	Larry Powell
Description	Fire Hydrant + 6" Valve Removal + Thrust Block		

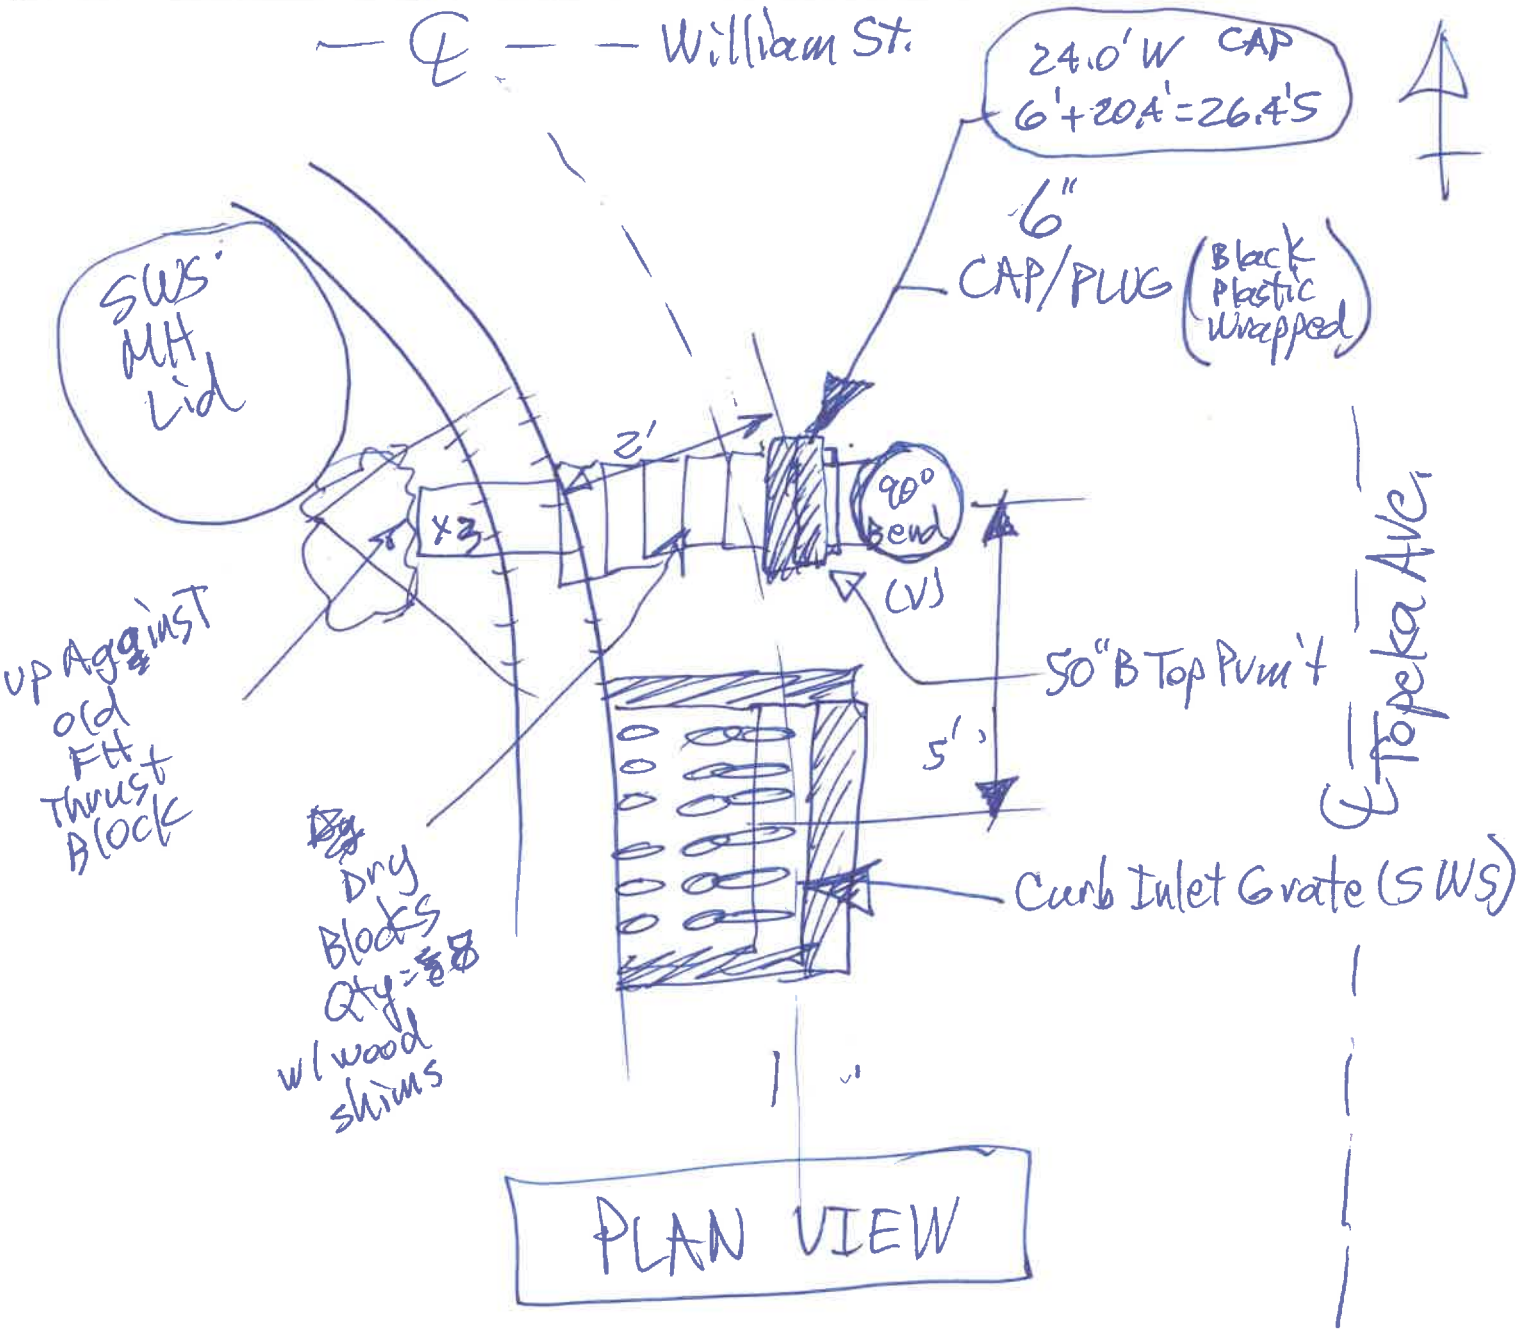

PROJECT INSPECTION DAILY REPORT

WL

BAUGHMAN COMPANY, P.A. WICHITA, KANSAS

PROJECT: Private Water Distribution System Improvements to serve WICHITA BIOMEDICAL CAMPUS

DATE: 7-21-26

DAY: TUESDAY

CITY NUMBER: #2024-006370 PPW

BAUGHMAN JOB #: 24-07-E833

INSPECTOR: ~~Larry Powell~~ Eric Purk EP

UTILITY CONTRACTOR: McCullough Excavation

FOREMAN: Carlos / Gabriel

INSPECTOR ON-SITE:

WEATHER: Sunny, Lt. Winds LOW: 75 °F HI: 99 °F

EQUIPMENT: Mini-Excavation

MATERIALS: Hot Asphalt Mix,

WORK PERFORMED: * Continued Work at FH location:

* Performed Pressure Tests at Locations #1 + #2.
Location #2 = PASS. Location #1 = FAIL.
Gabriel excavated location #1 to FH Elbow and tightened bolts.

* Crew installed hot asphalt mix temporary pavement patches at Location #2 and Removed FH location. Thickness = 8" (min.). Partial patch placed at location #1.

REMARKS: * Retest Pressure at Location #1 tomorrow at 7AM.

* Eric Purk witnessed Pressure Testing.
10:45 AM 165 psi > Location # 2 (East).
12:45 PM 167 psi
Gauge to zero

PROJECT INSPECTION DAILY REPORT

WL BAUGHMAN COMPANY, P.A. WICHITA, KANSAS

PROJECT: Private Water Distribution System Improvements to serve WICHITA BIOMEDICAL CAMPUS

DATE: 7-22-26

DAY: WEDNESDAY

CITY NUMBER: #2024-006370 PPW

BAUGHMAN JOB #: 24-07-E833

INSPECTOR: Larry Powell

UTILITY CONTRACTOR: McCullough Excavation

FOREMAN: Gabriel/Carlos

INSPECTOR ON-SITE: 6:45AM - 9:50AM

WEATHER: Sunny, Lt. Winds LOW: 73 °F HI: 90 °F

EQUIPMENT: Mini-Excavator, Skid Loader, Vibratory Plate, Test Truck,

MATERIALS: Hot ~~Cold~~ Asphalt Mix,

WORK PERFORMED: * Work continued on Fire Hydrants:

* Retest Pressure on FH @ location #1 (West).

* Pressure Test: 7:31AM @ 165psi.
9:31AM @ 160psi = PASS.

* Gabriel performed Valve Verification, ✓ ALL OPEN. at Locations #1 + #2.

*Crew prepared Location #1 for Temp. HMA patch.
- Placed Temp HMA patch. ✓

REMARKS: * I + Crew attended 7-7:15AM site safety Meeting.

* Obtained reference ties with Gabriel's assistance.

* I requested Gabriel to test pressure From existing 8" Valve to FH. He complied.


BAUGHMAN COMPANY, P.A.
ENGINEERING, SURVEYING & PLANNING
316/262-7271 FAX 316/262-0149 WICHITA, KANSAS 67211

WATERLINE PRESSURE TEST

PROJECT: WSU Biomedical Campus
LOCATION: Broadway + William St (SEC)
COW PROJECT NUMBER: #2024-006370 PPW
BAUGHMAN JOB NUMBER: 24-07-E833
DATE: 7-22-26
WATERLINE I.D.: LINE- Location #1
PRESSURE TEST SPECIFICATION: [X] 150 PSI [ ] 200 PSI
TEST PERFORMED BY: Gabriel (McCullough)
WATERLINE CONTRACTOR: McCullough Excavation

TIME	GAUGE READING	COMMENTS	PICTURE
7:31 AM	165 psi	Begin	Yes
7:53 AM	161 psi		
8:19 AM	160 psi		
8:33 AM	160 psi		
8:46 AM	160 psi		
9:15 AM	160 psi		
9:31 AM	160 psi	(-5 psi) Final = PASS	No

PRESSURE RELEASED: GAUGE TO ZERO PSI? [X] YES [ ] NO

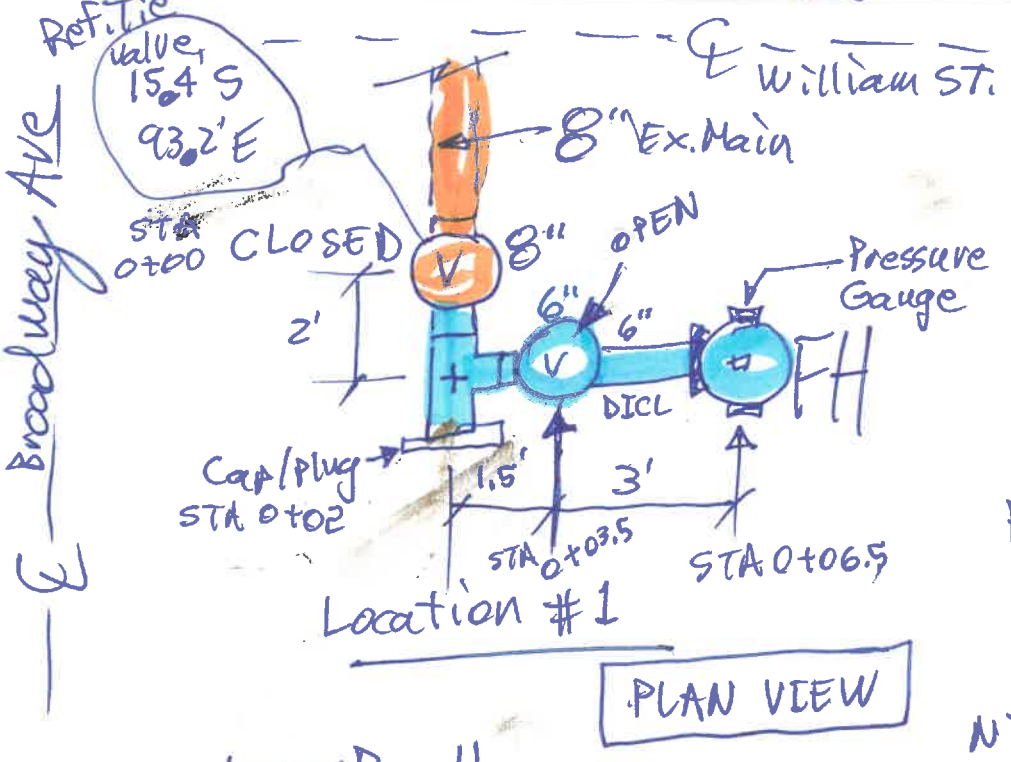

INSPECTED BY: Larry Powell

BAUGHMAN COMPANY, P.A.
ENGINEERING, SURVEYING & PLANNING
316/262-7271 FAX 316/262-0149 WICHITA, KANSAS 67211

WATERLINE VALVE OPEN or CLOSED VERIFICATION

Project Name: Wichita Biomedical Center

Project Location:

COW Project #: 2024-006370 AFW **OCA No.:**

Contractor: McCullough Excavation (Gabriel)

Baughman Job #: 24-07-E833 **Inspector:** Larry Powell

Date	Line No.	WL Station	WL Valve Description	WL Valve Open or Closed	Inspector's Signature
7-22-26	2	0+01.5	6" FH Valve	OPEN	Larry Powell
7-22-26	1	0+00	8" Ex. Valve	OPEN	Larry Powell
7-22-26	1	0+03.5	6" FH Valve	OPEN	Larry Powell

WL

PROJECT INSPECTION DAILY REPORT

BAUGHMAN COMPANY, P.A. WICHITA, KANSAS

PROJECT: Private Water Distribution System Improvements to serve WICHITA BIOMEDICAL CAMPUS

DATE: 8-13-26

DAY: THURSDAY

CITY NUMBER: #2024-006370 PPW

BAUGHMAN JOB #: 24-07-E833

INSPECTOR: Larry Powell

UTILITY CONTRACTOR: McCullough Excavation

FOREMAN:

INSPECTOR ON-SITE: 12:06PM - 12:08PM

WEATHER: Sunny, Lt Winds LOW: 84 °F HI: 106 °F

EQUIPMENT:

MATERIALS:

WORK PERFORMED: * Project Complete.

REMARKS: * Old FH's not on-site.
* Received 6" DICL Pipe Cert.