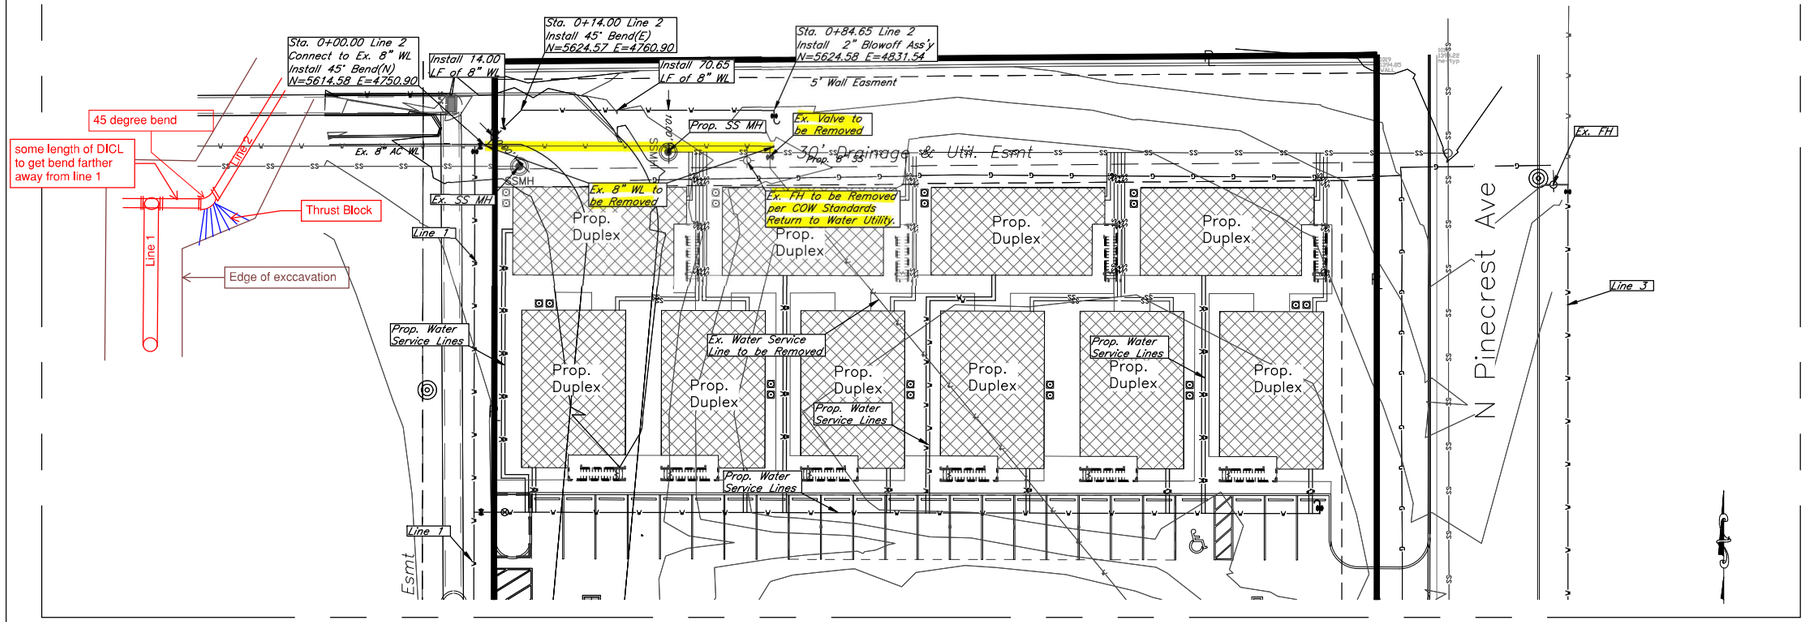


VERTICAL SCALE
(IN FEET)
1 inch = 5 ft.

HORIZONTAL SCALE
(IN FEET)
1 inch = 20 ft.

MICHAEL J. EDWARDS
LICENSED
DATE: 10.08.2024
26045
KANSAS
PROFESSIONAL ENGINEER

THIS SHEET HAS BEEN SIGNED, SEALED AND DATED DIGITALLY

University Gardens 2nd Addition

WL Plan & Profile- Line 2

Wichita, Kansas

KEMILLER ENGINEERING PA
117 E. Lewis, Wichita, KS 67202 (316)264-0242

PROJECT NUMBER			
KEM NO. 23042	FILE	DATE 10/2023	SHEET 3.1
DESIGN	DRAWN KJ	REVISED	

October 9, 2024