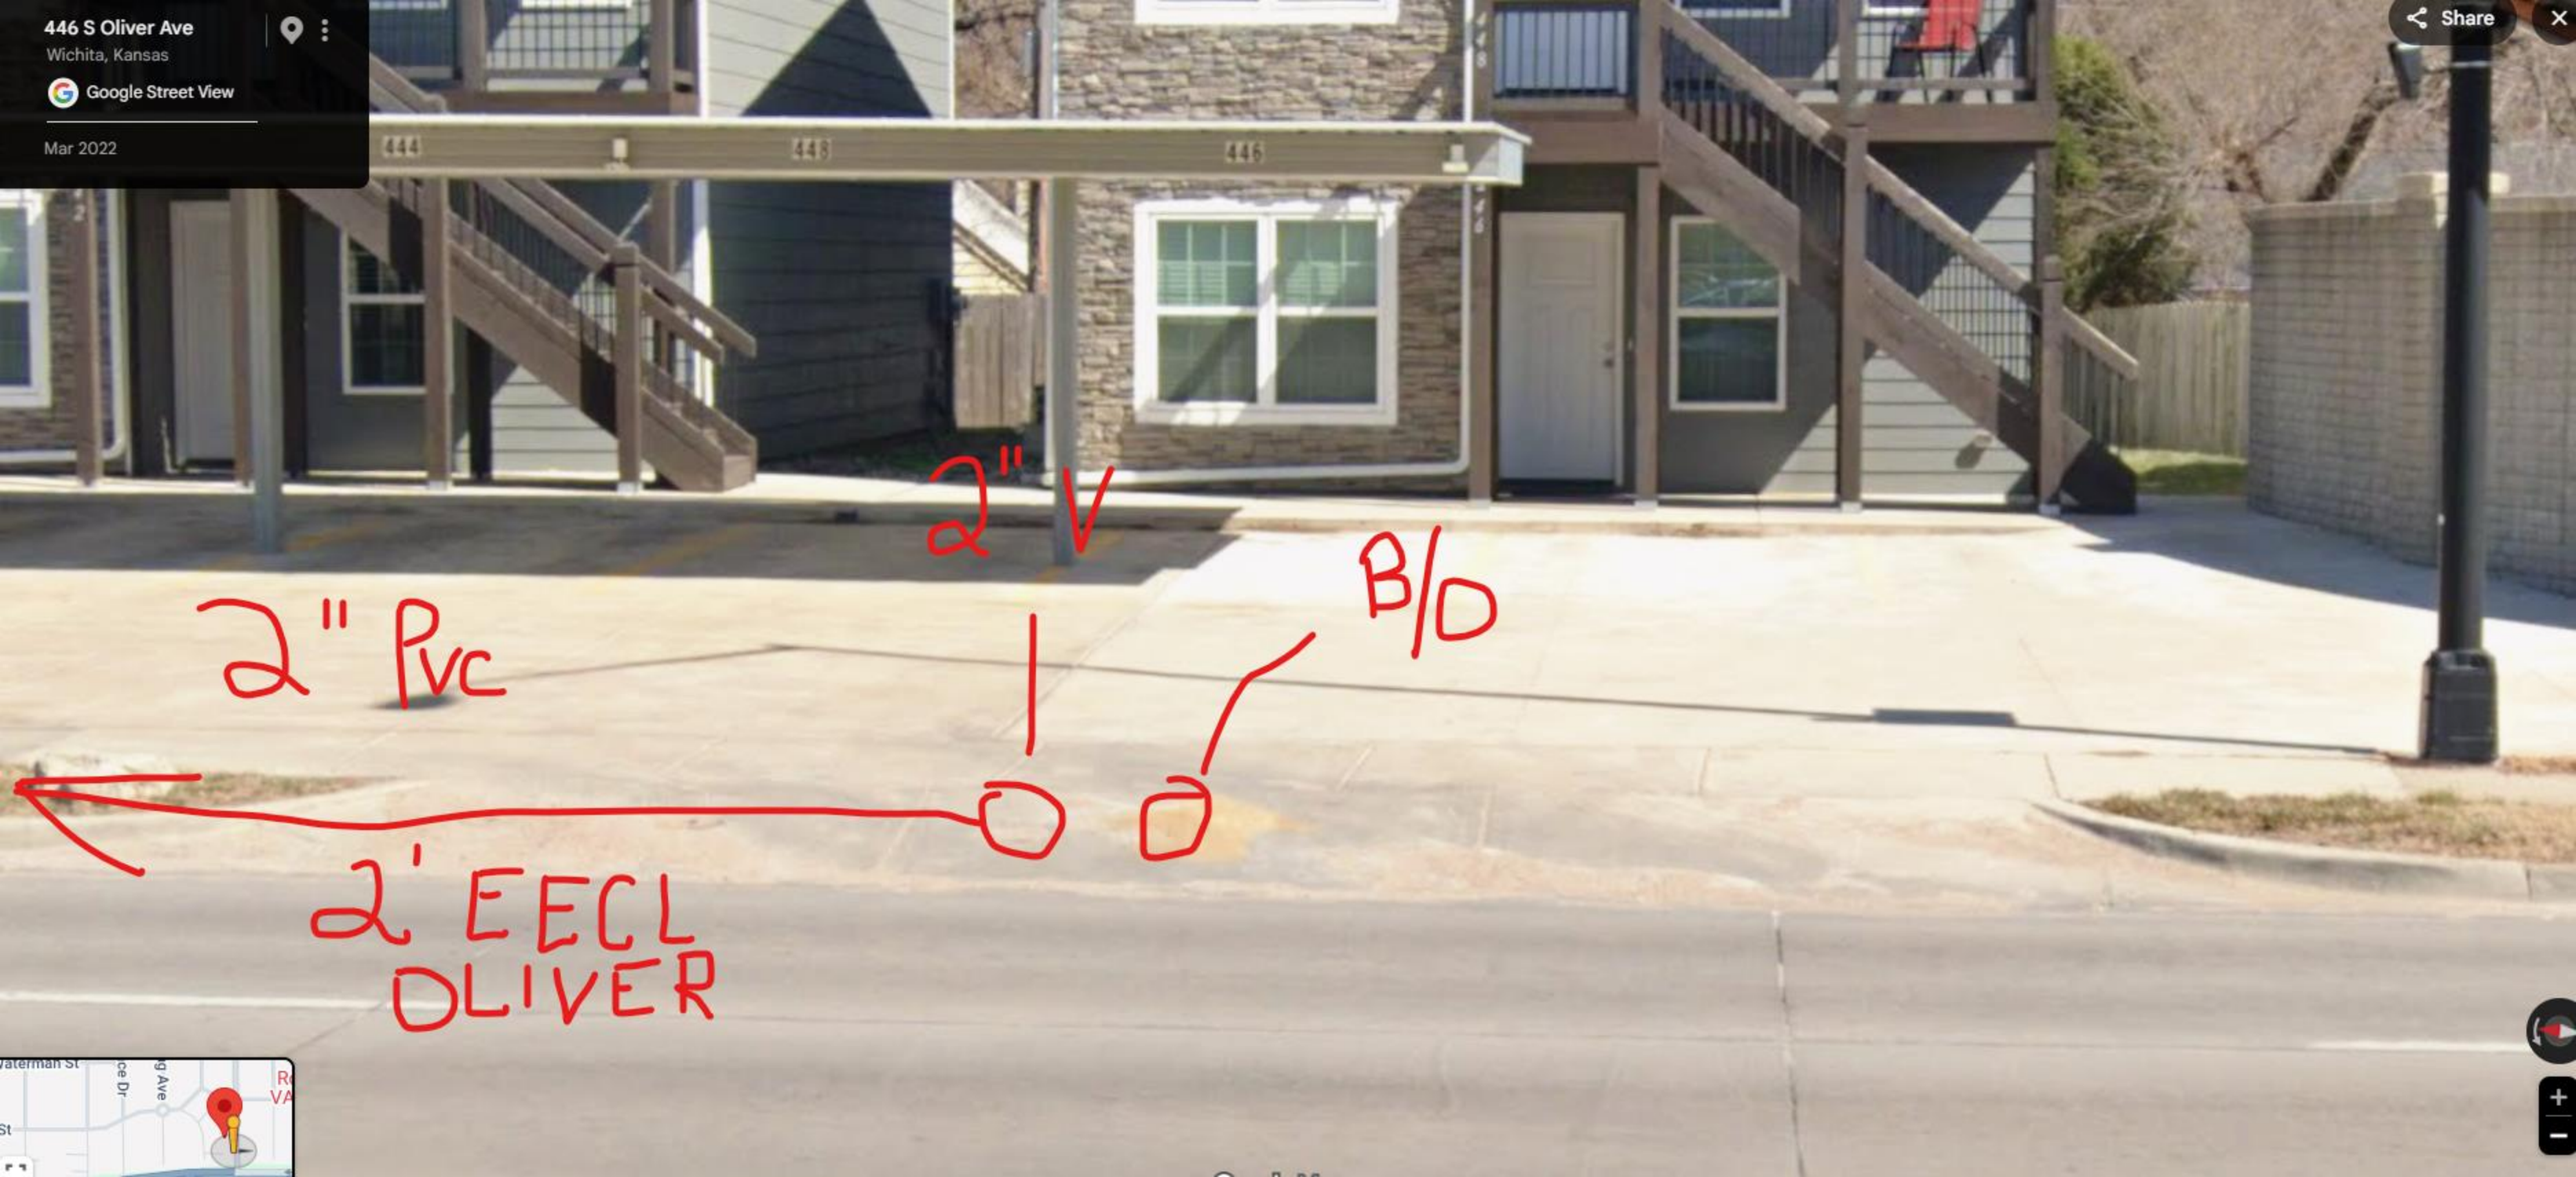

446 S Oliver Ave
Wichita, Kansas
Google Street View
Mar 2022
Share
444
446
448
2" V
B/D
2" Pvc
2' EECL
OLIVER