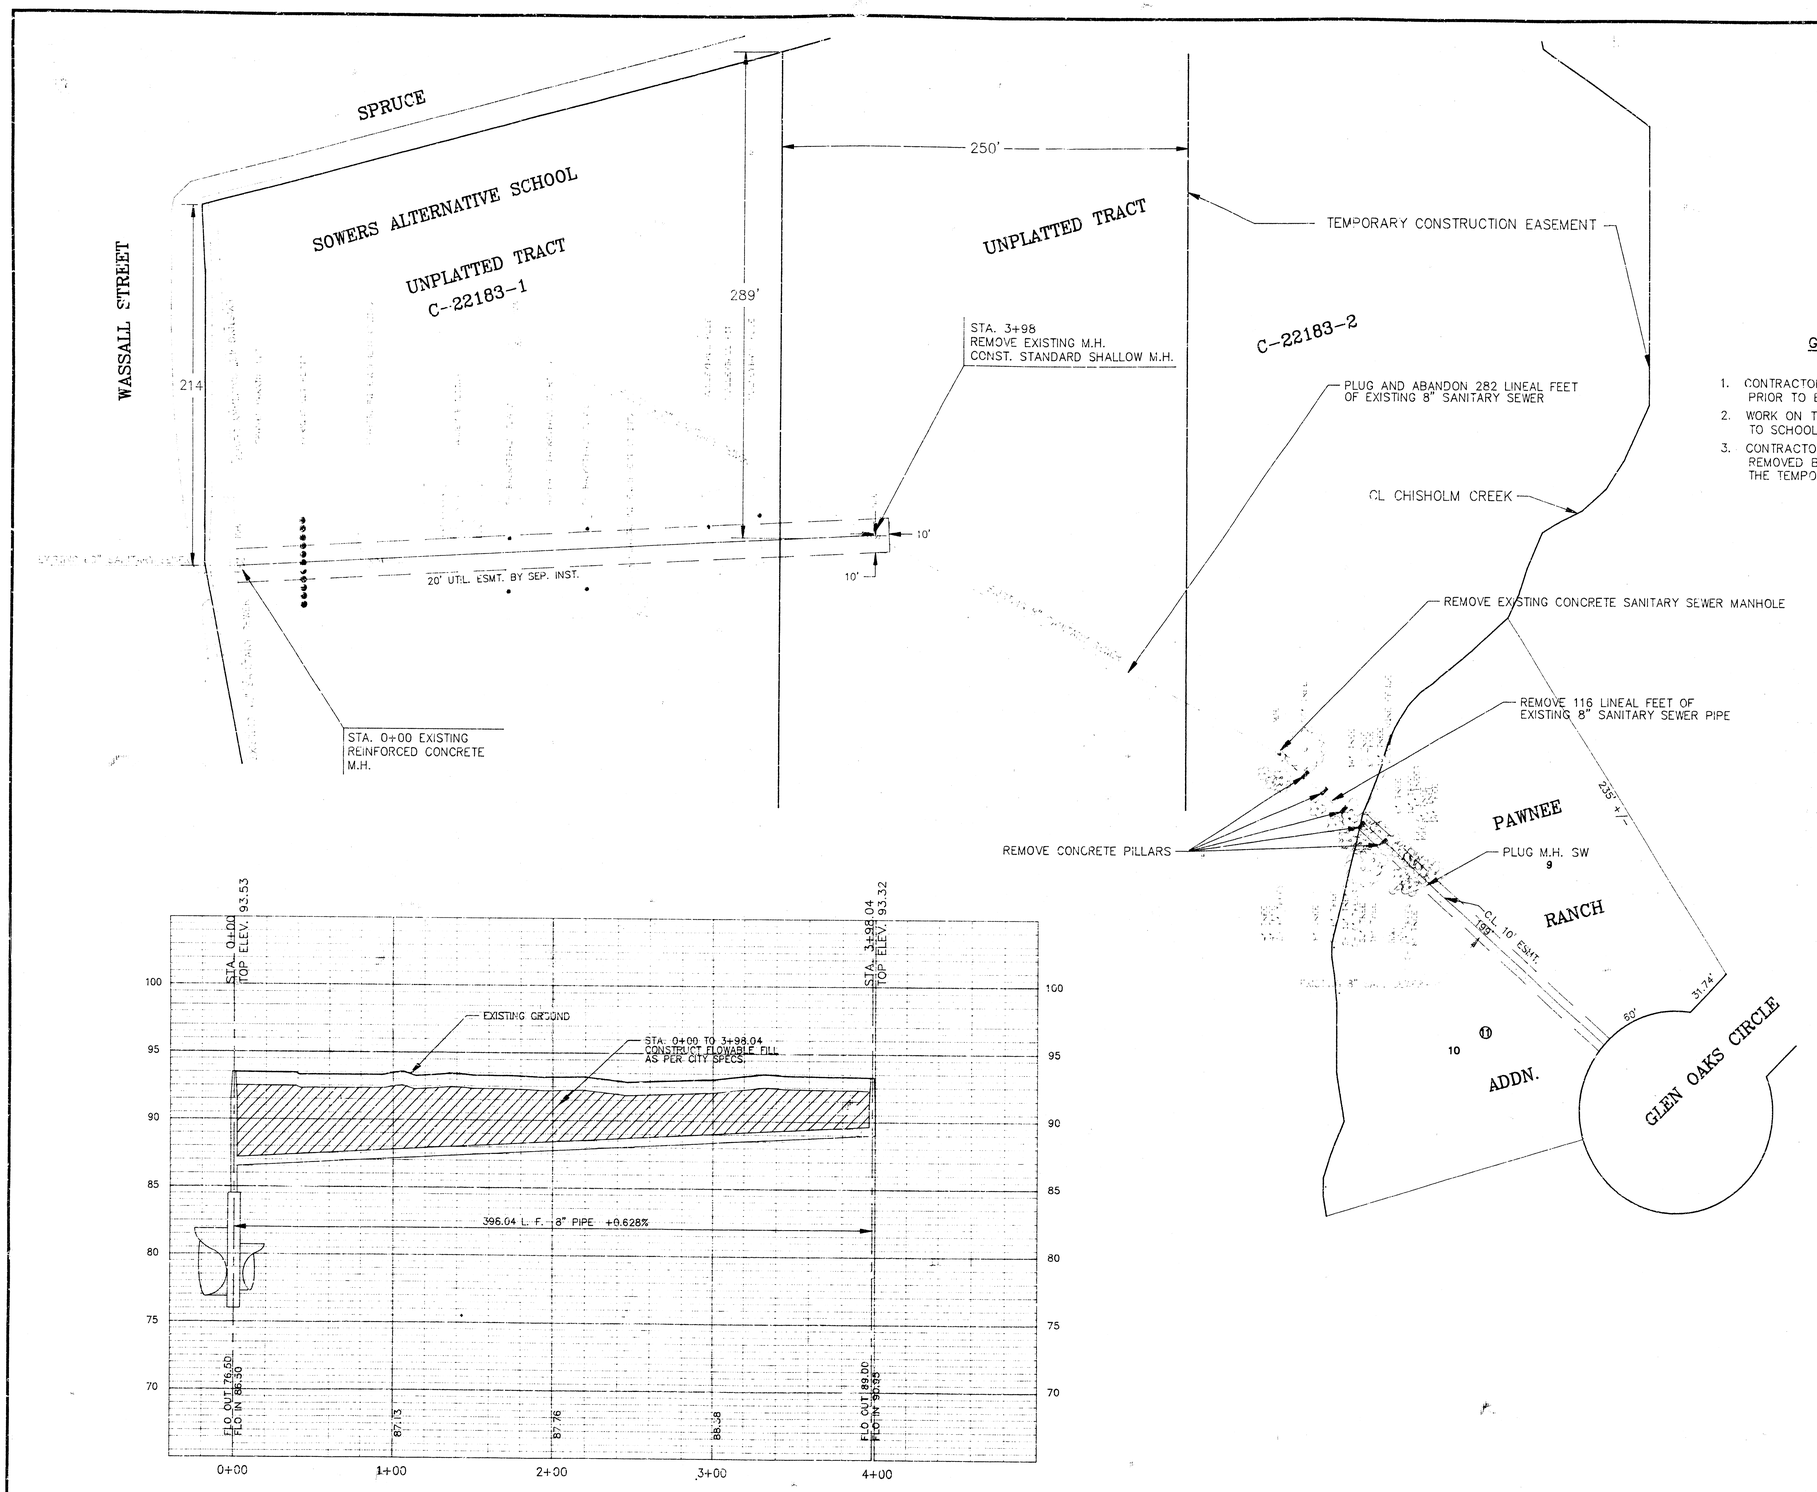


SCALE: PLAN 1" = 40'
PROFILE 1" = 40' HORIZ.
1" = 5' VERT.

GENERAL NOTES

1. CONTRACTOR SHALL CONTACT THE SCHOOL PRINCIPAL PRIOR TO BEGINNING CONSTRUCTION.
2. WORK ON THIS PROJECT SHALL BE COMPLETED PRIOR TO TO SCHOOL STARTING.
3. CONTRACTOR MAY ACCESS THE CREEK CROSSING TO BE REMOVED BY WAY OF SPRUCE STREET ACROSS THE THE TEMPORARY CONSTRUCTION EASEMENT.

Booked 2-16-95
SJKB
As Per Plan

CHRIS J. BREITENSTEIN
LICENSED
PROFESSIONAL ENGINEER

1994 Sanitary Sewer Rehabilition Program Phase II

PROJ. NO.
INDEX NO. 623124
DRAWN BY J. BRIGGS

SHEET 1 OF 1