

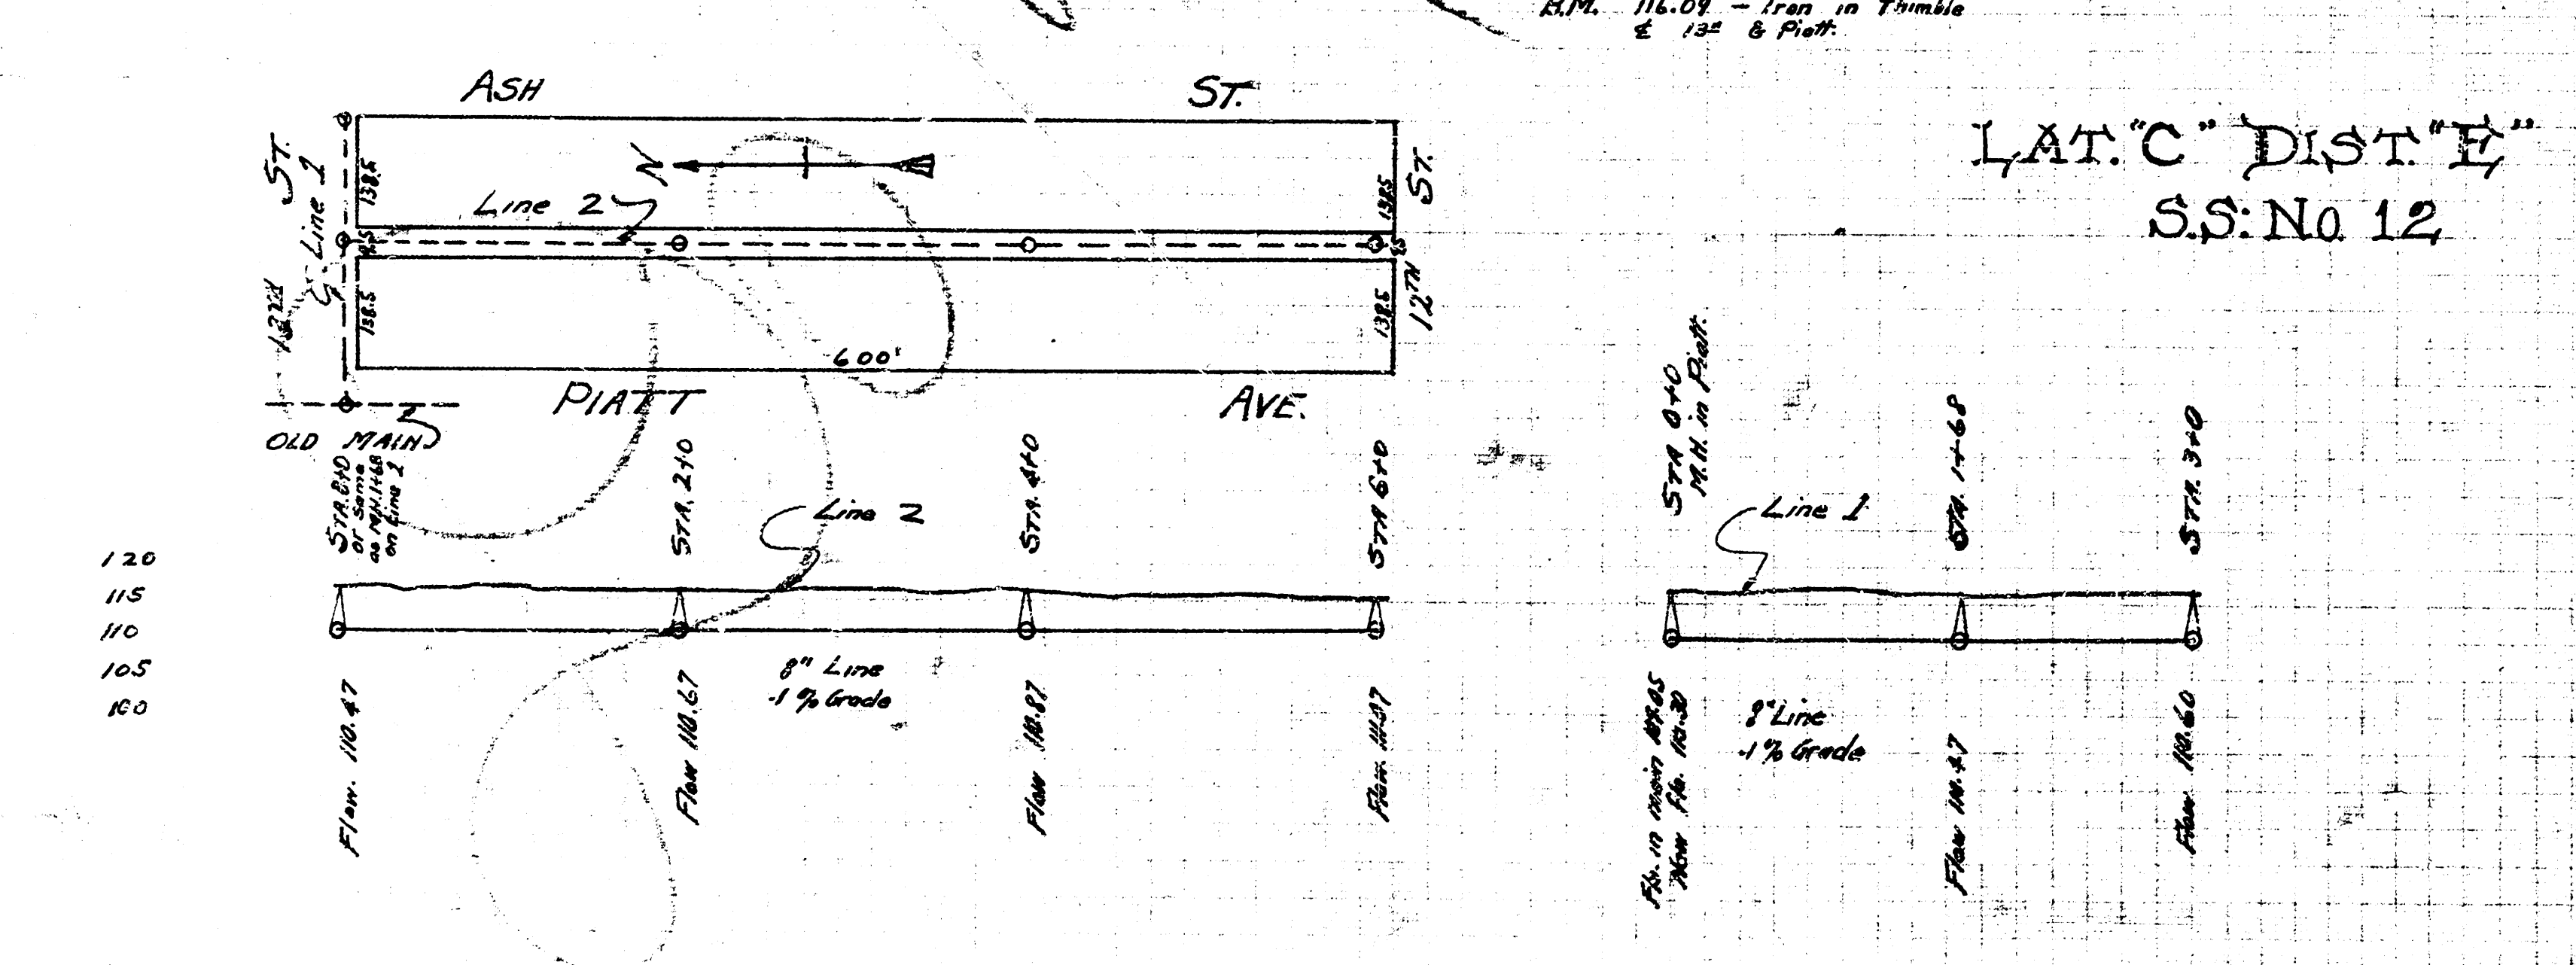
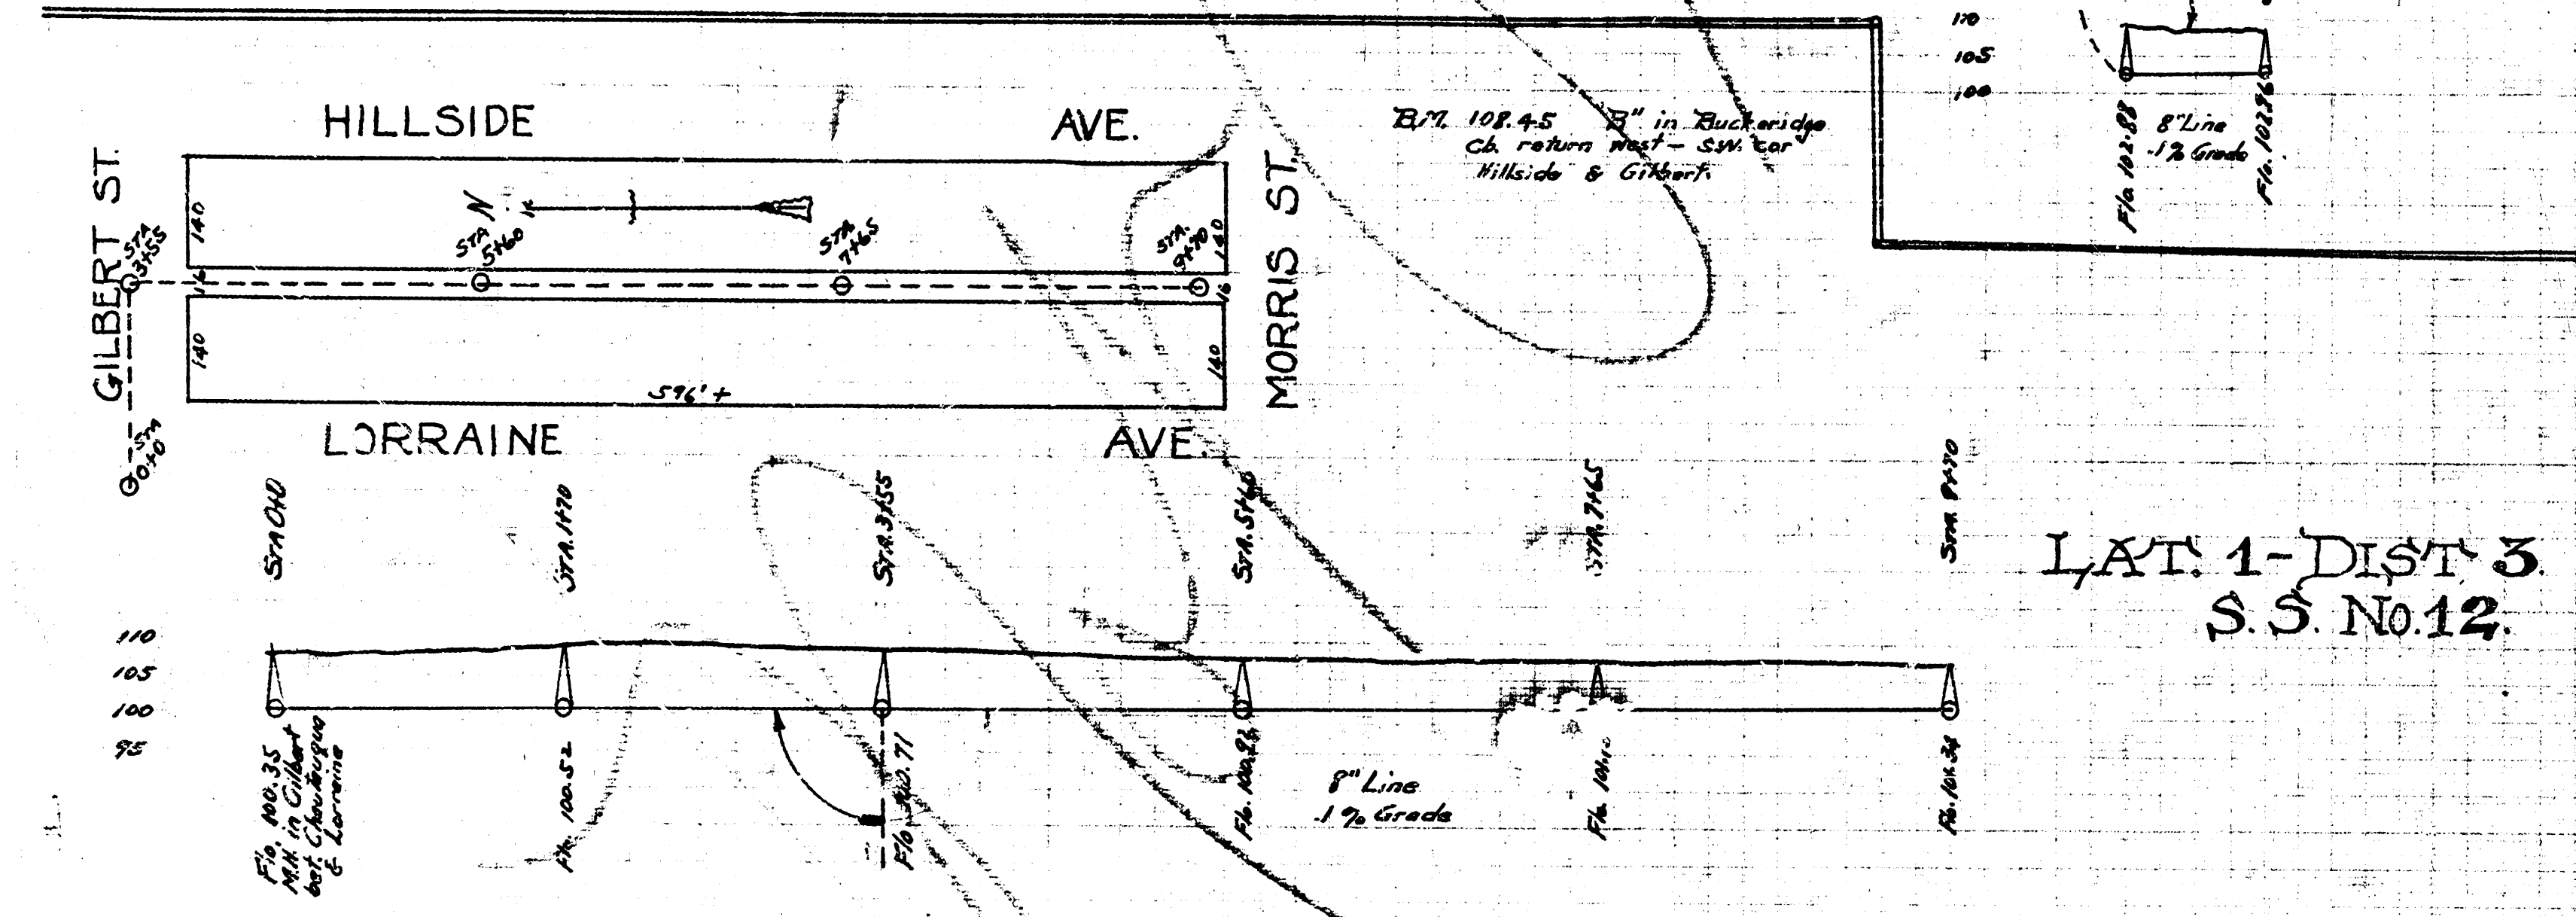
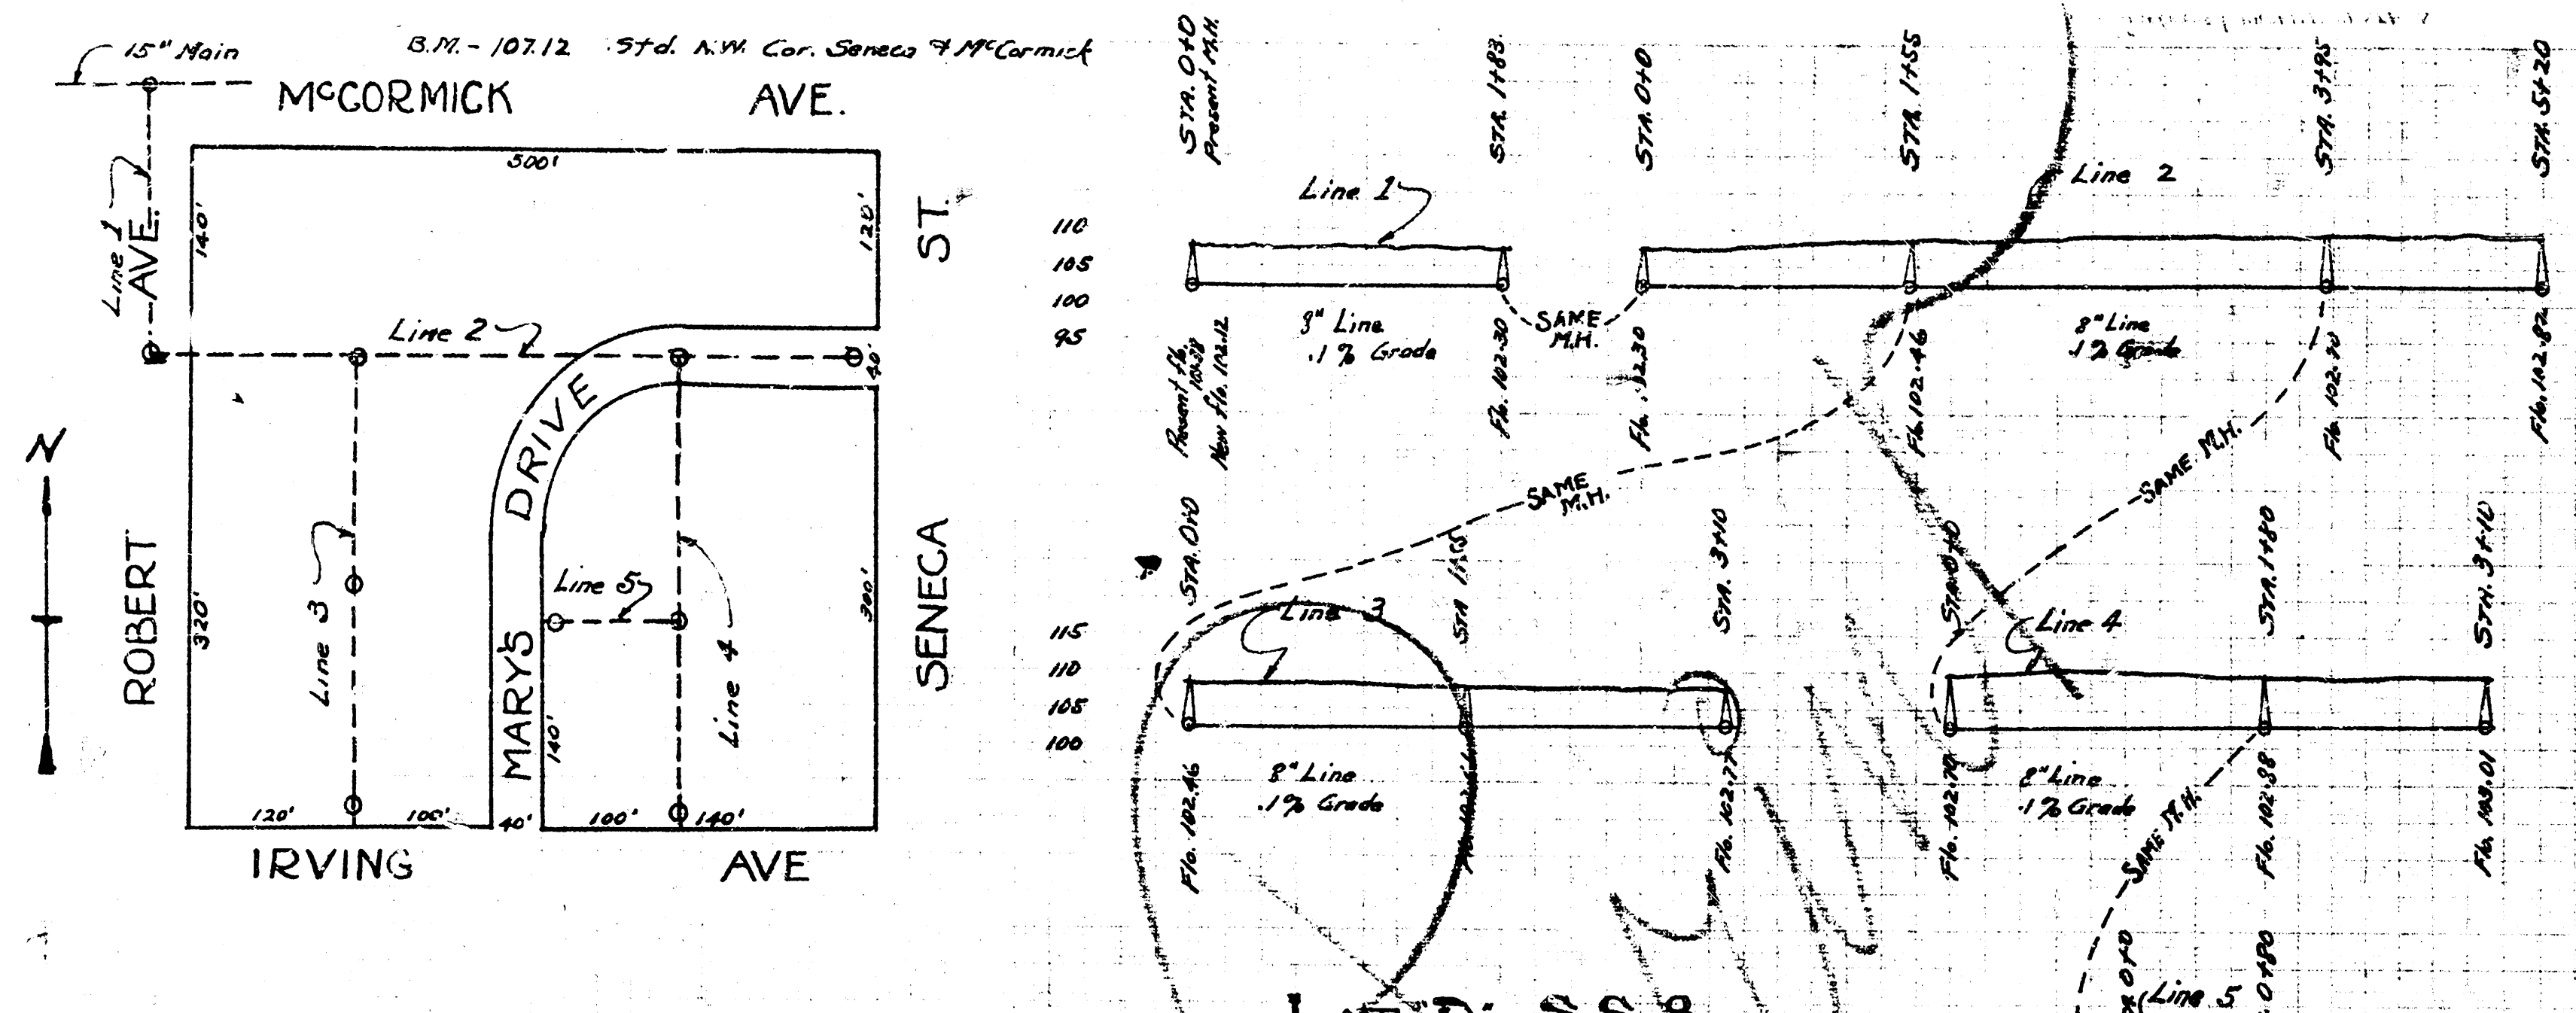
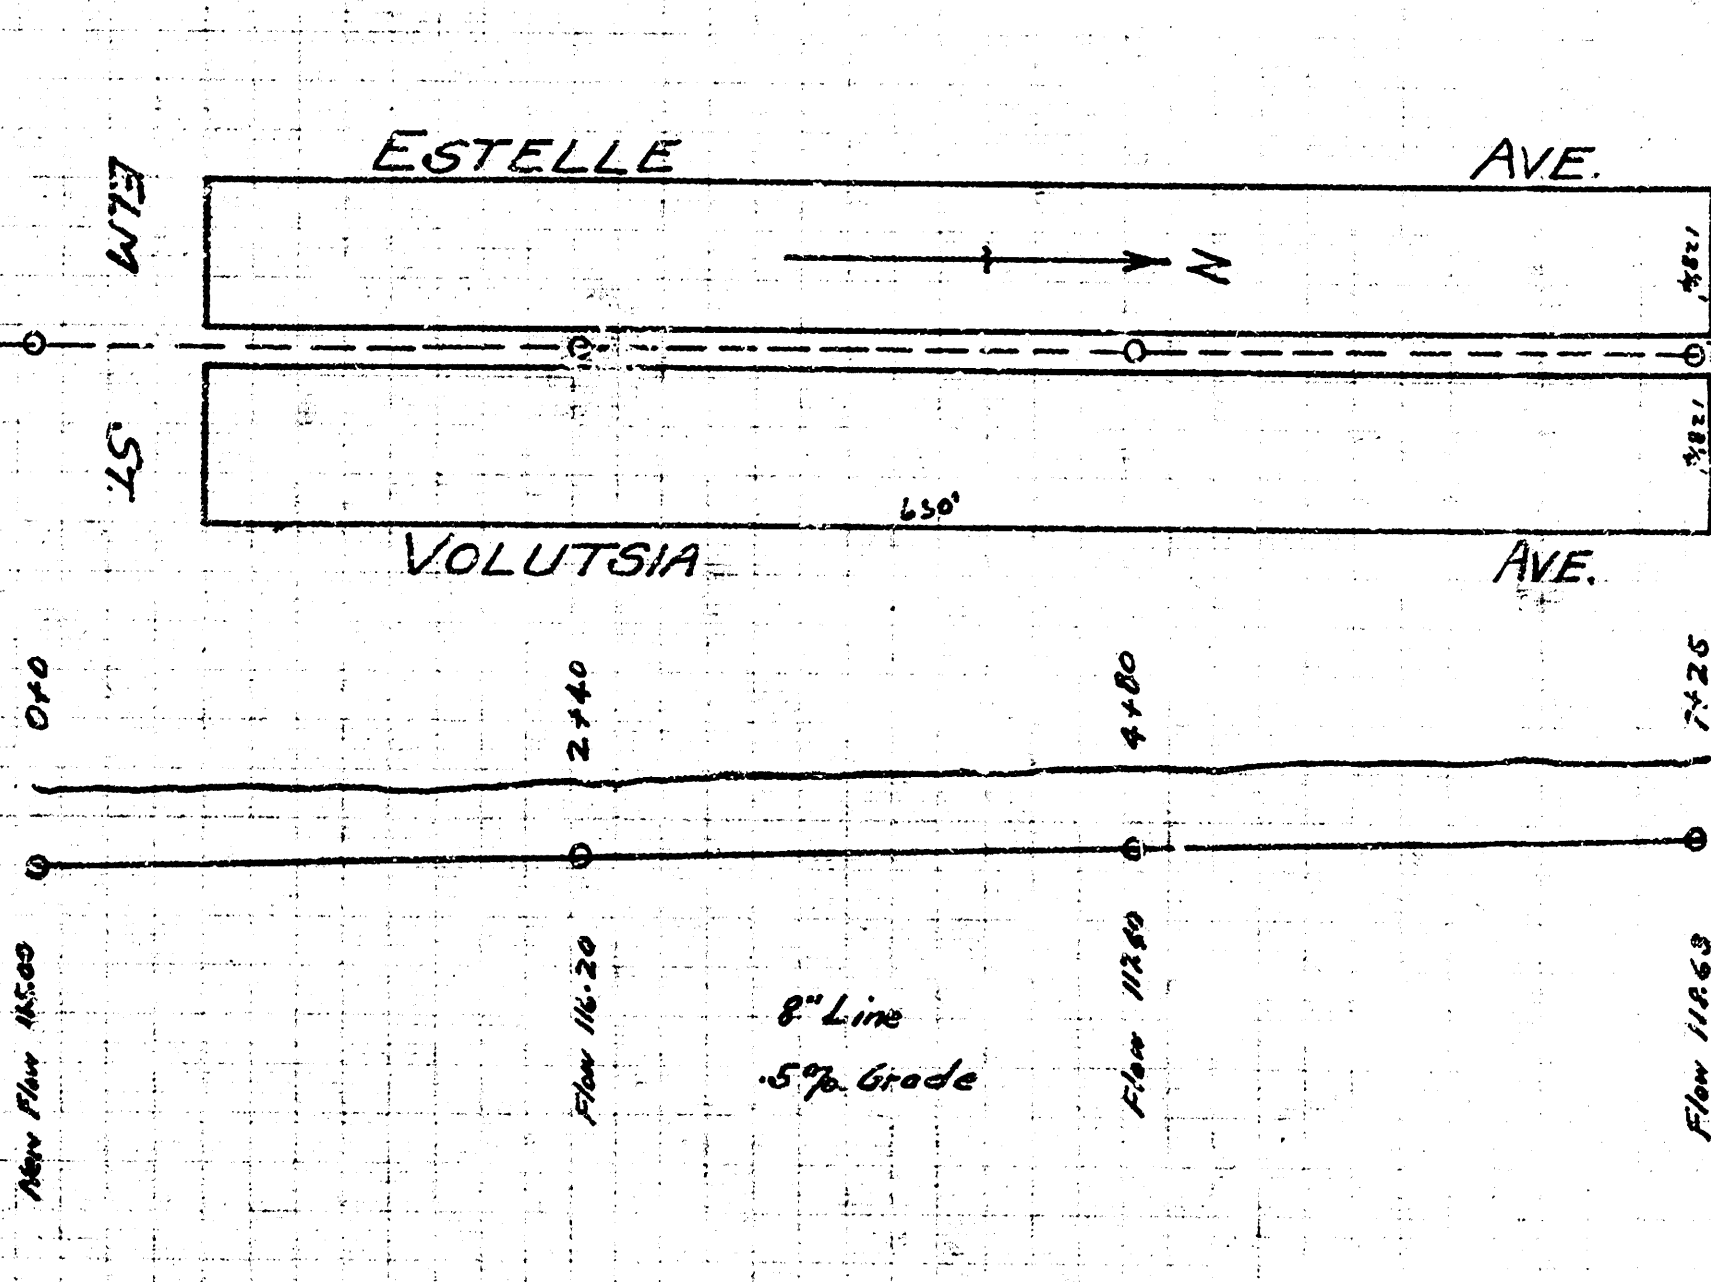


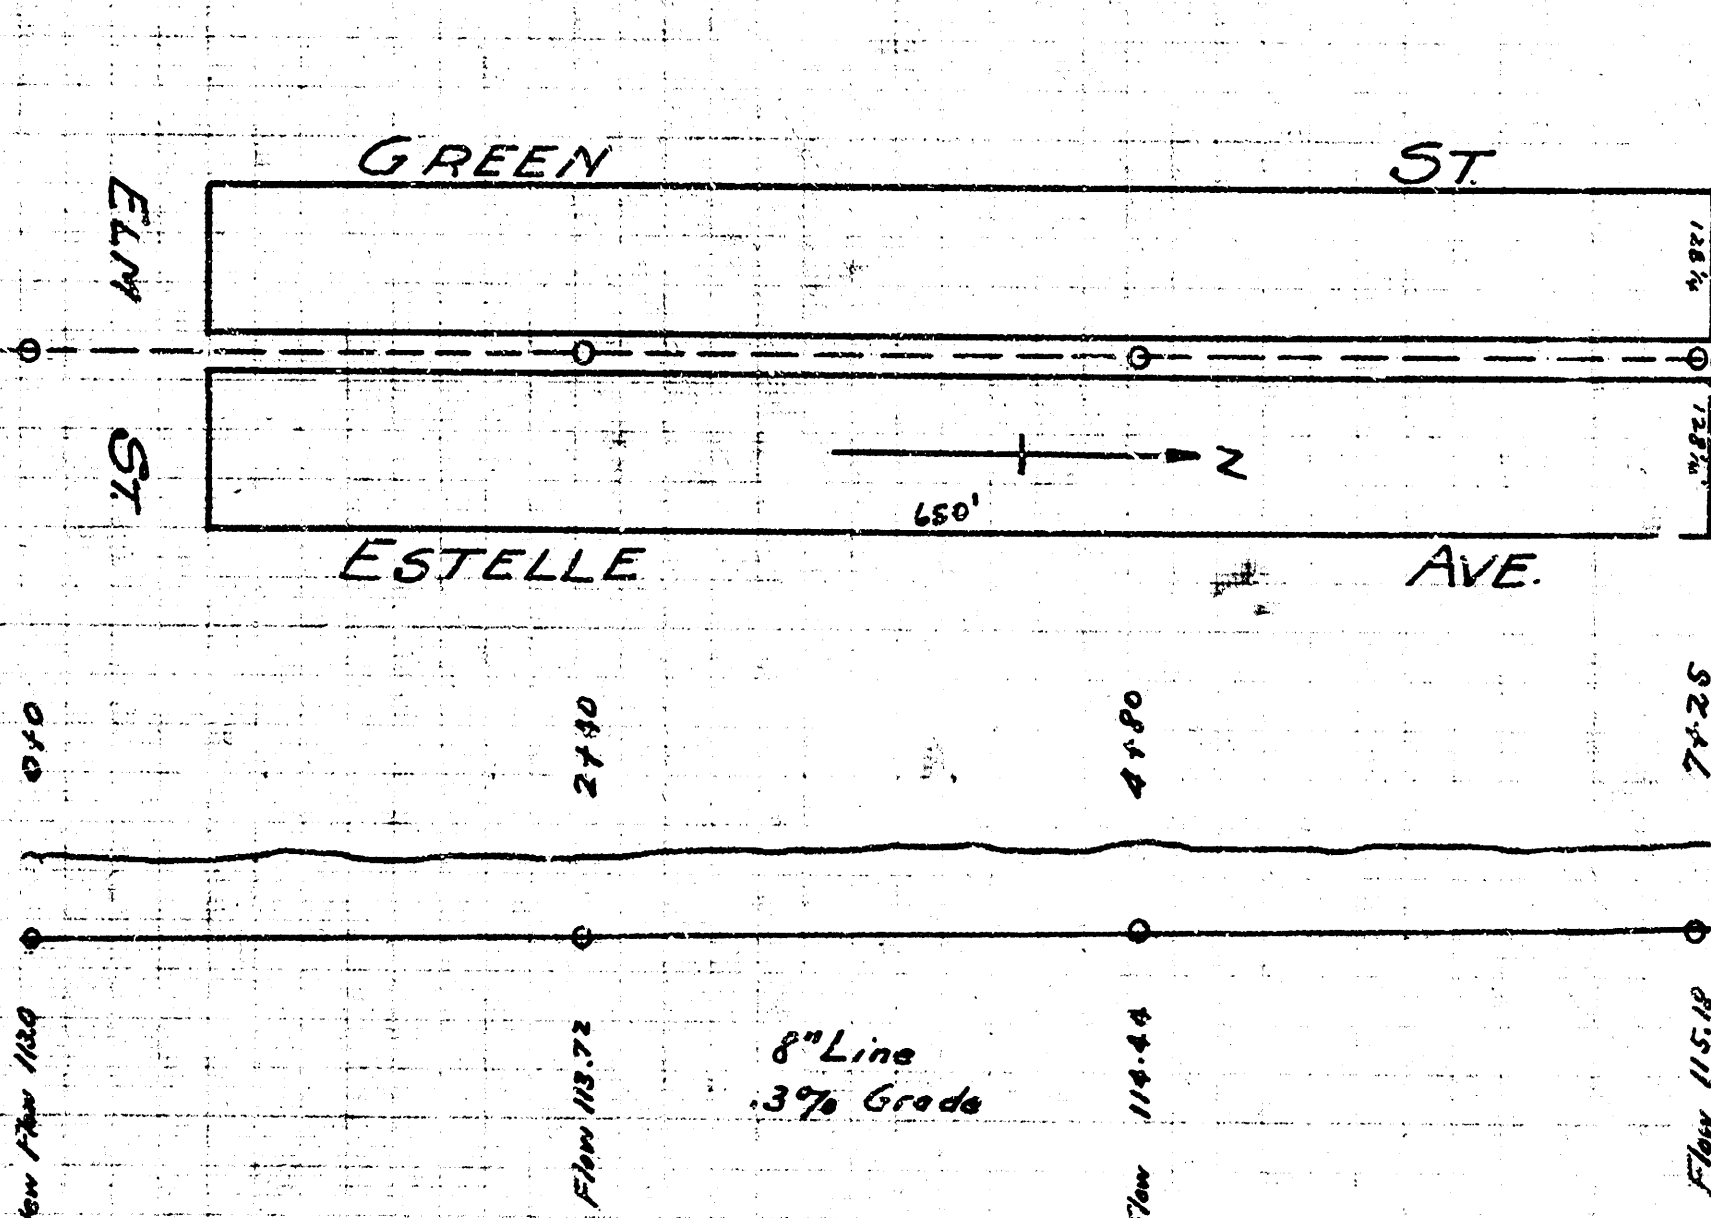

Print to right of this line only

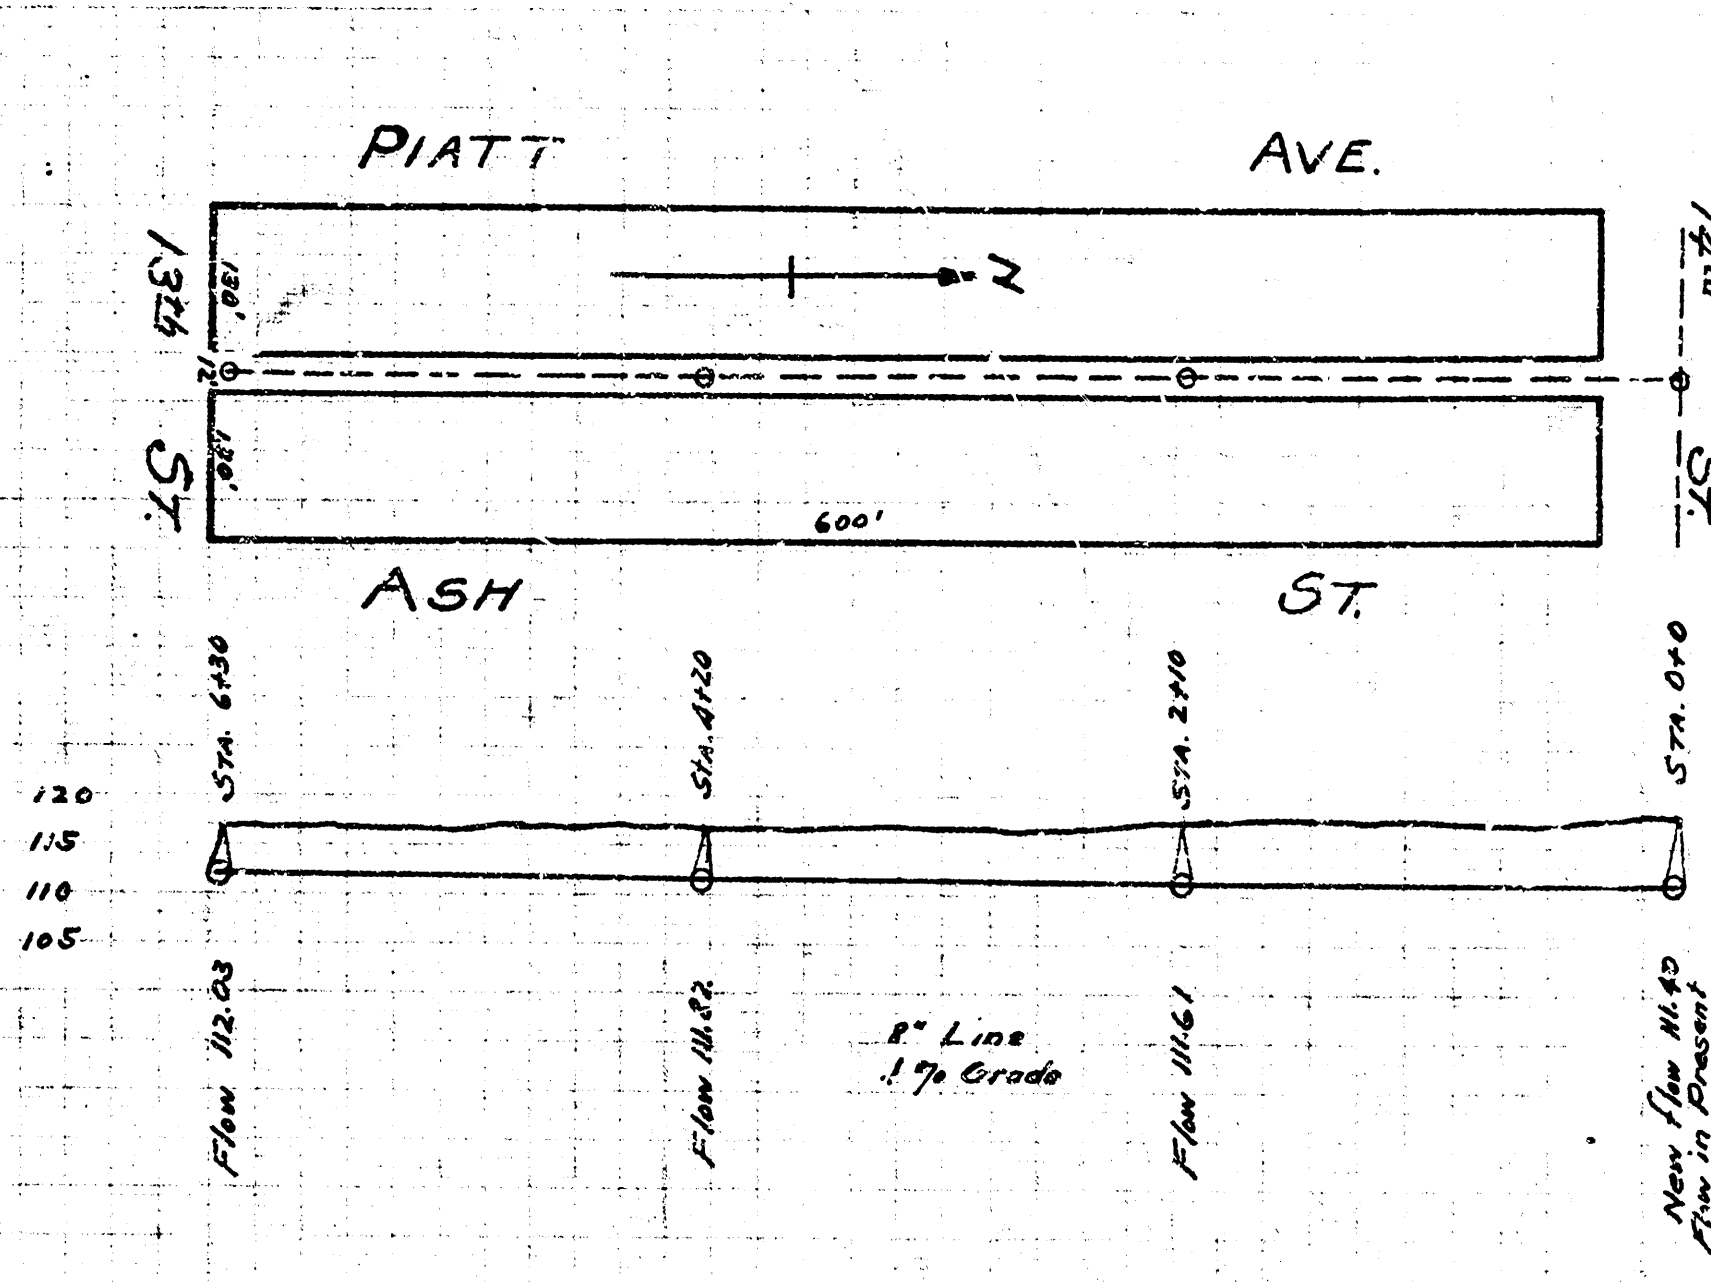

B.M. 116.55 X on curb return
SW corner Piatt & 12th

Lat. D - Dist. D.
S.S. No. 12.

B.M. 121.86 G in Hastings - cut m.k. south
SW cor. Estelle & Elm.

Lat. Q - Dist. D.
S.S. No. 12.