

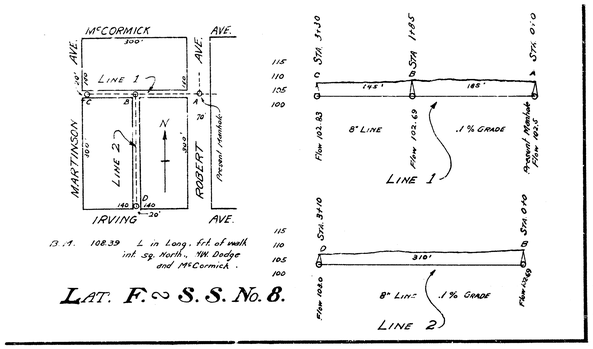


B.M. 108.39 L in Long. frt. of walk int. Sq. North, W. Dodge and McCormick.


LAT. F ~ S. S. No. 8.

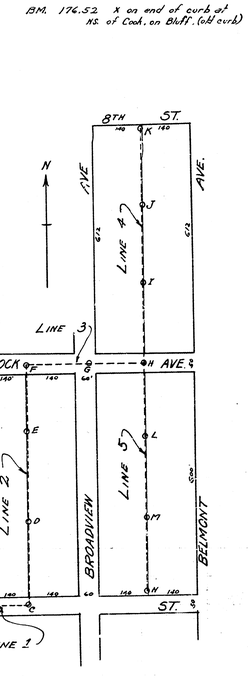


B.M. 174.52 X on end of curb at N.E. of Cook. on Bluff. (old curb)

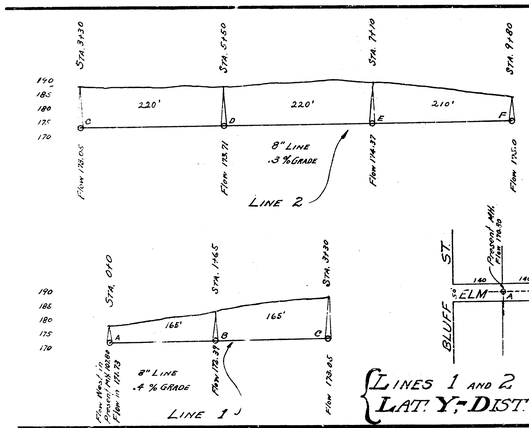

{LINES 1 AND 2 LAT. Y - DIST. D - S.S. No. 12

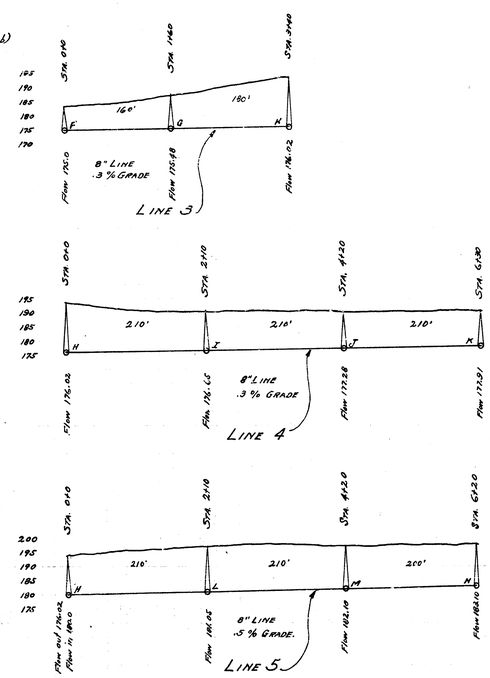


{LINES 3, 4 AND 5 LAT. 2 - DIST. D - S.S. No. 12

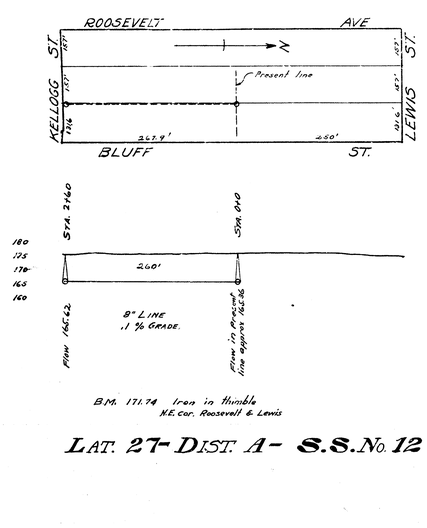


B.M. 171.74 Iron in thimble N.E. Cor. Roosevelt & Lewis

LAT. 27 - DIST. A - S.S. No. 12

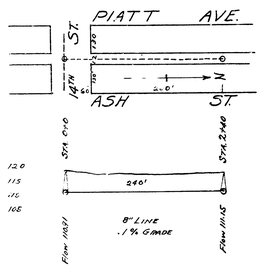

B.M. 118.06 D in Dixon, back of meth K. N.E. cor. Ash and 14th

LAT. K - DIST. O - S.S. No. 12.

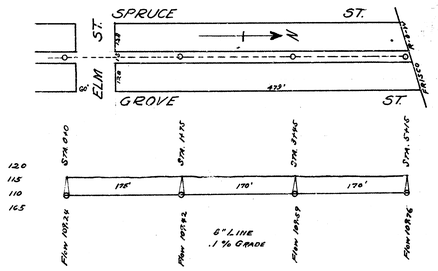

B.M. 116.20 H. in Hurst, c/l. of wk. south - sw. cor. Grove and Elm.

LAT. Z - DIST. D - S.S. No. 12