

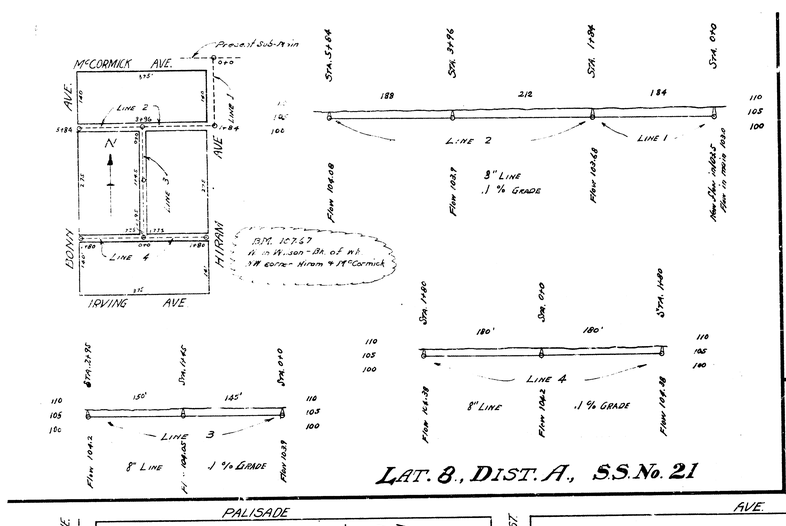



LAT. 8., DIST. A., S.S. No. 21

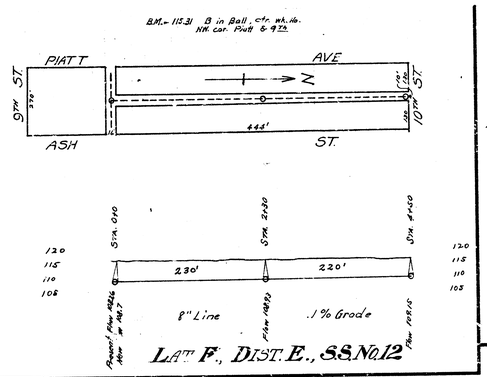


LAT. F., DIST. E., S.S. No. 12

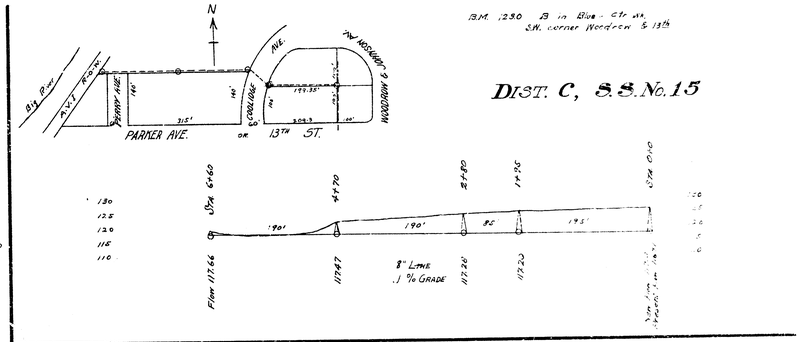


DIST. C, S.S. No. 15

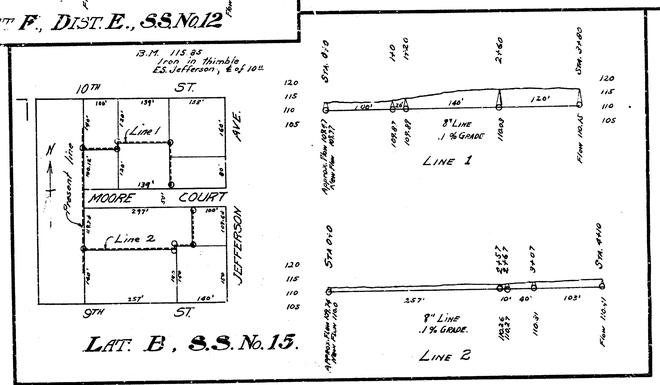

LAT. B, S.S. No. 15.

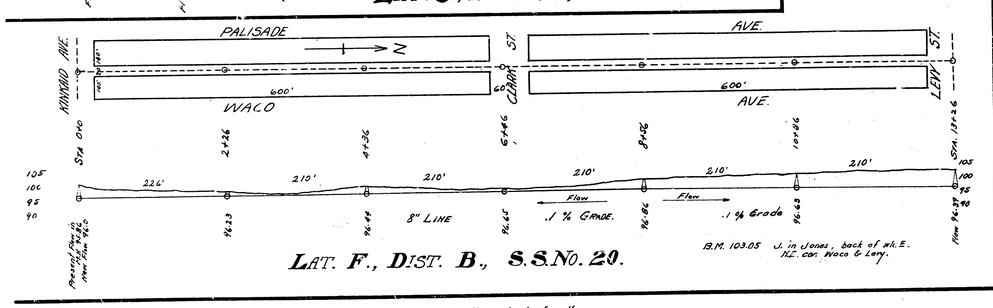

LAT. F., DIST. B., S.S. No. 20.

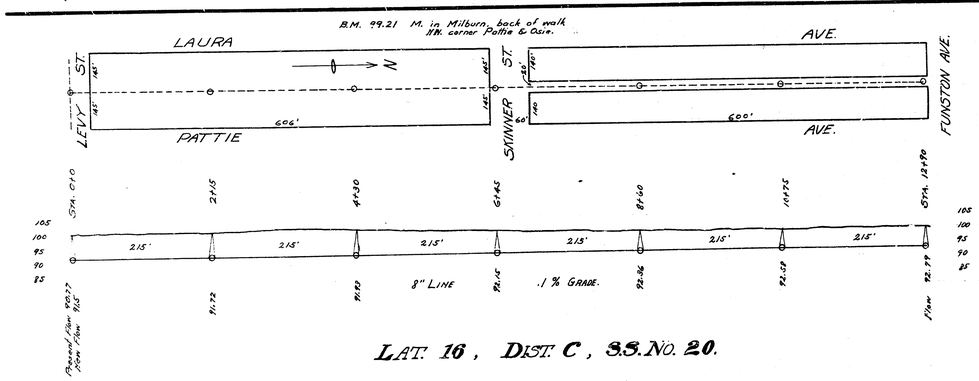

LAT. 16, DIST. C, S.S. No. 20.