


8" LINE .1% GRADE.


B.M. ELEV-120.61-+ on lug N.E. cor. GROVE & 9th

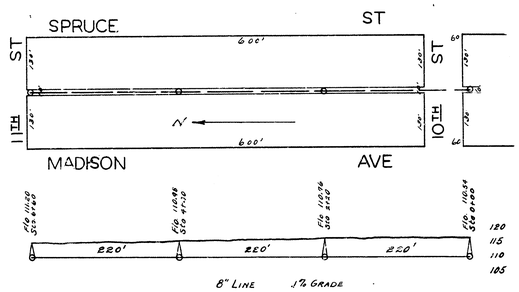

8" LINE .1% GRADE


B.M. ELEV-117.35-'J' in Jones bk. of W.L.S. S.E. Madison & 11th

LAT. M, DIST. O, S.S. 12.

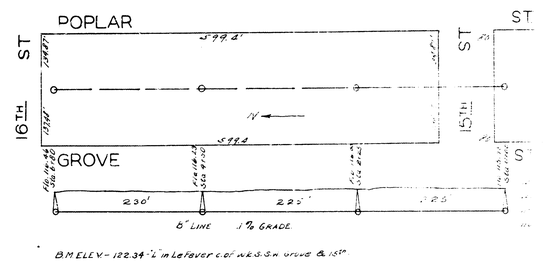


6" LINE .1% GRADE.

B.M. ELEV-122.34-'L' in Lefever c. of W.L.S.S.W. Grove & 15th

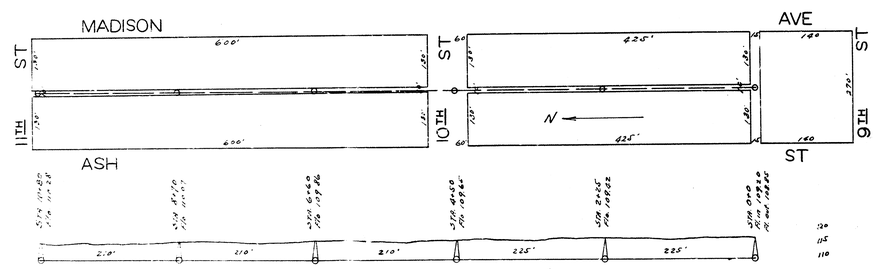


8" LINE .1% Grade.

B.M. Elev 116.10 W. [illegible] cent wk N.E. Madison & 9th

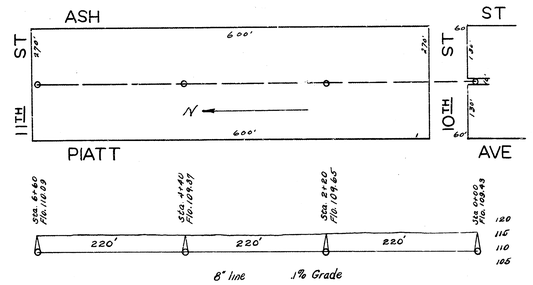

8" line .1% Grade

B.M. Elev- 116.02- 'J' in Jones on S.W. cor. int. Sq. Platt & 10th

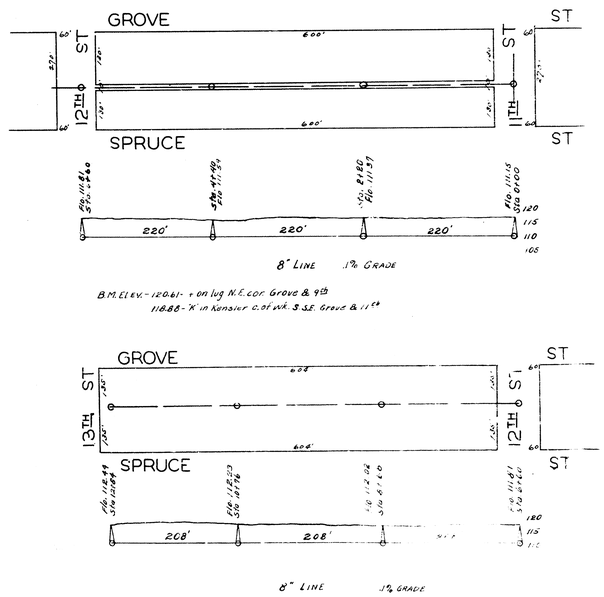

8" LINE .1% GRADE

B.M. Elev-120.61-+ on lug N.E. cor. Grove & 9th

11888-'K' in Kensler c. of wk. S.S.E. Grove & 11th

LAT. H, DIST. E, S.S. 12.

LAT. I, DIST. E, S.S. 12.