
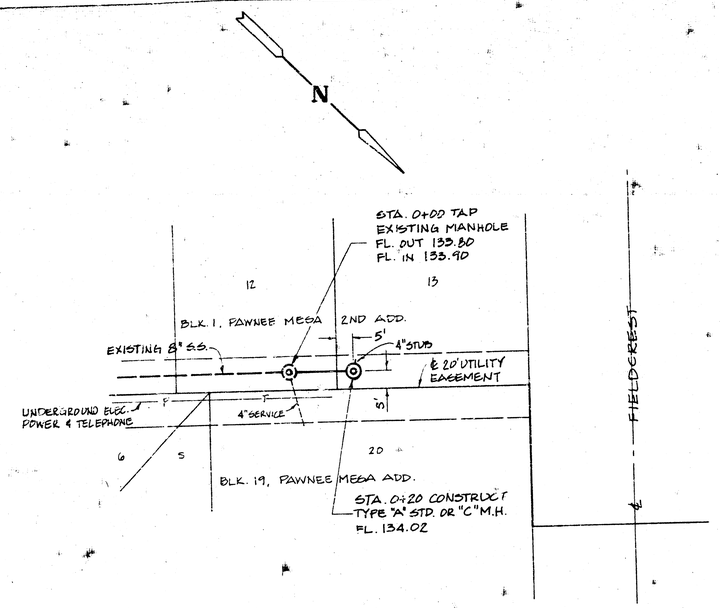


LINE 1

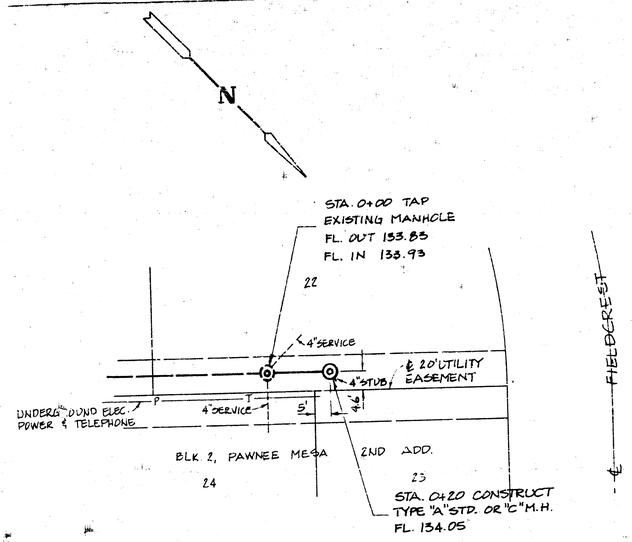

LINE 2

BENCH MARK:
SPIKE STEP IN N. FACE OF P.P.
S. SIDE PAWNEE @ E. LINE LARK LANE, ELEV. 142.71, CITY DATUM

THE CONTRACTOR SHALL BE RESPONSIBLE FOR PRESERVING PROPERTY MONUMENTS. CONTRACTOR SHALL BE LIABLE FOR ESTIMATED COST OF ANY ... ARE DISTURBED OR ... STRUCTURES OF ... BE REPLACED ... SURVEYOR OR ... ENGINEER IN ACCORDANCE WITH STATE LAWS.


APPROVED AS NOTED
By CITY ENGINEER OF WICHITA
Sanitary Sewers _____
Storm Sewers _____
Driveway Approaches _____

NOTE: CONTRACTOR SHALL NOTIFY THE FOLLOWING UTILITY COMPANIES BEFORE EXCAVATION, 48 HRS. IN ADVANCE

BELL TELEPHONE	268-3087
K.G. & E.	261-6248
CABLEVISION	266-6817

PLAN — NOTE BOOK — PLOTTED — CHECKED — BY — DATE

PROFILE — NOTE BOOK — PLOTTED — CHECKED — BY — DATE

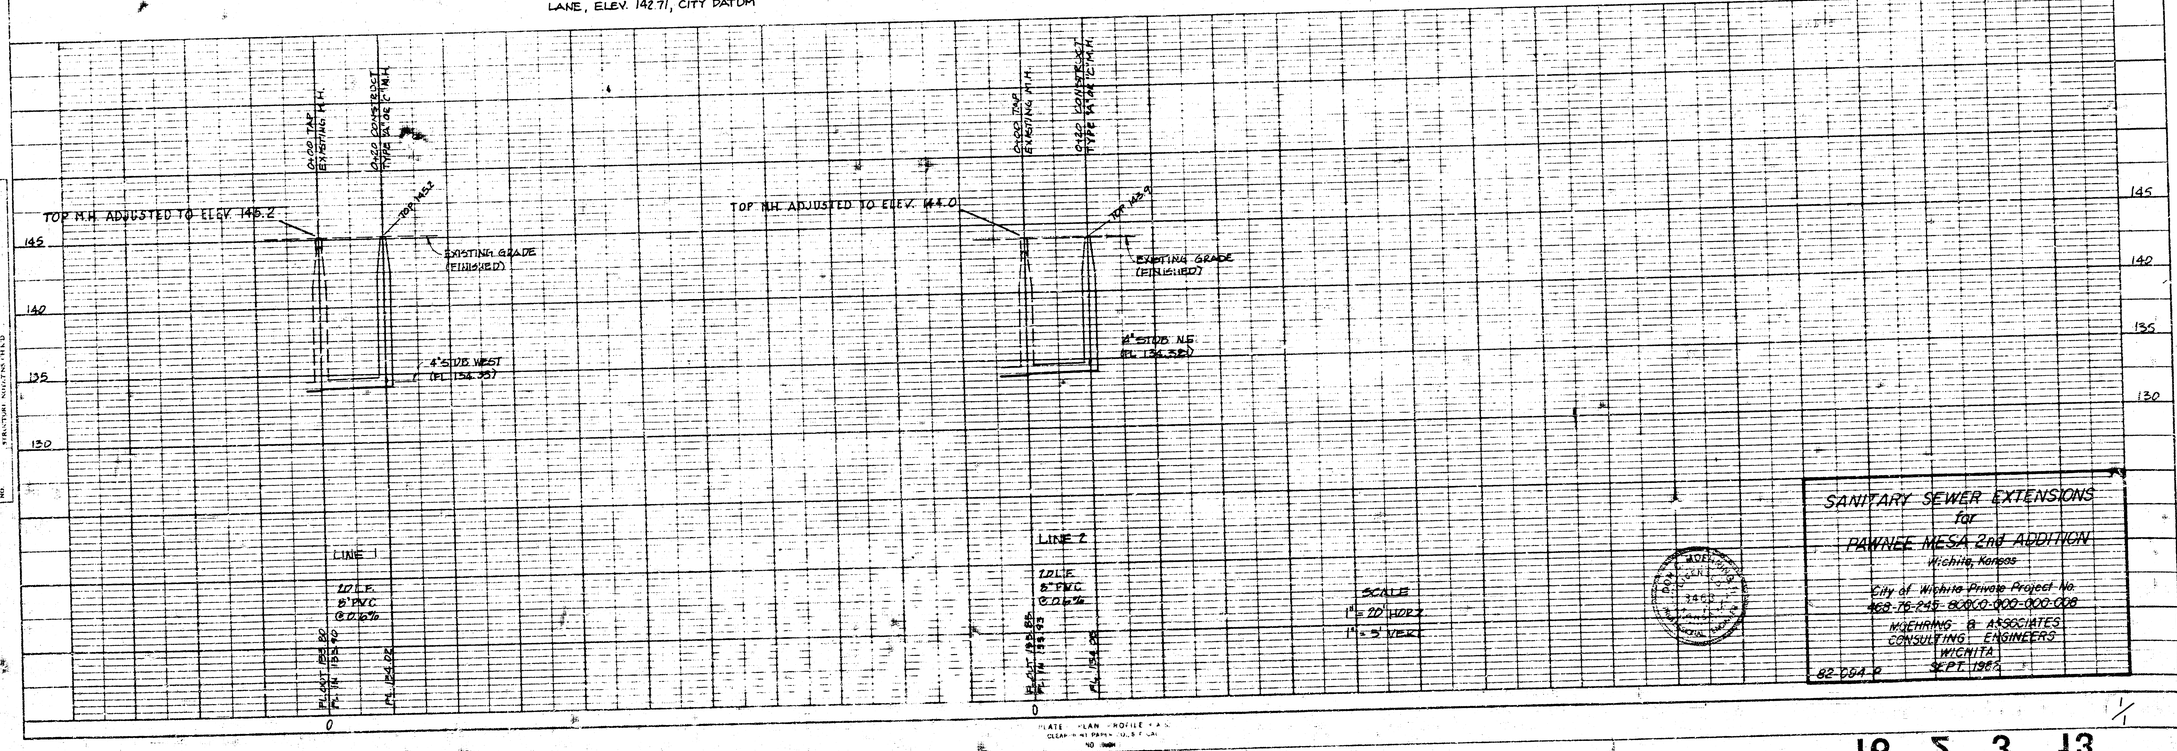

SCALE
1" = 20' HORZ.
1" = 5' VERT.

SANITARY SEWER EXTENSIONS
for
PAWNEE MESA 2nd ADDITION
Wichita, Kansas

City of Wichita Private Project No.
468-76-245-82000-000-000-008

WOEHRING & ASSOCIATES
CONSULTING ENGINEERS
WICHITA
SEPT 1982

82-004-P

1/1

PLATE - PLAN - PROFILE - 4 A.S.
CLEARANCE PAPER - 10.5 F. LAI
40 INCH

Je S 3 13