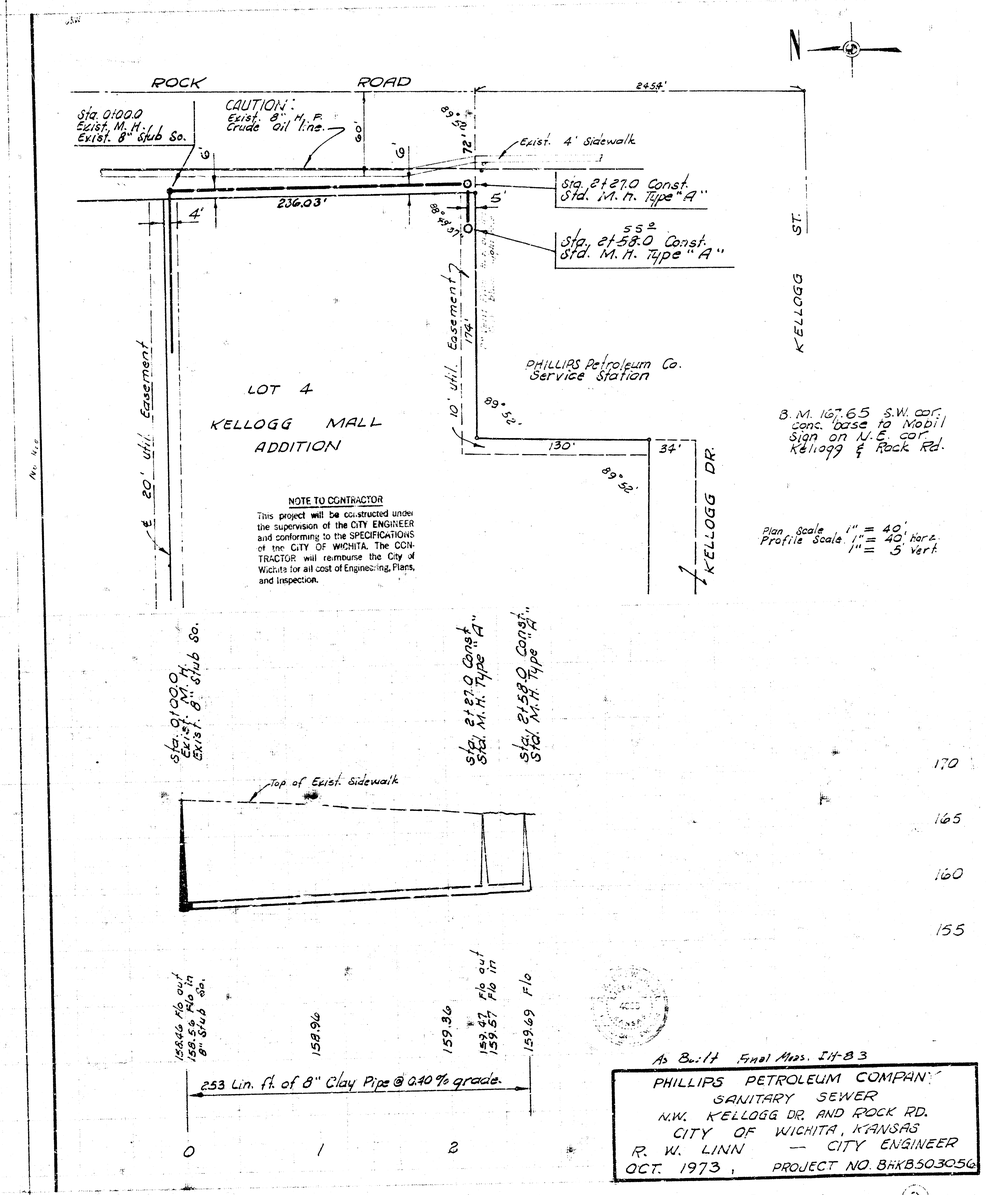


As Built Final Mods. 11-83

PHILLIPS PETROLEUM COMPANY
SANITARY SEWER
N.W. KELLOGG DR. AND ROCK RD.
CITY OF WICHITA, KANSAS
R. W. LINN — CITY ENGINEER
OCT. 1973, PROJECT NO. BHKB503056