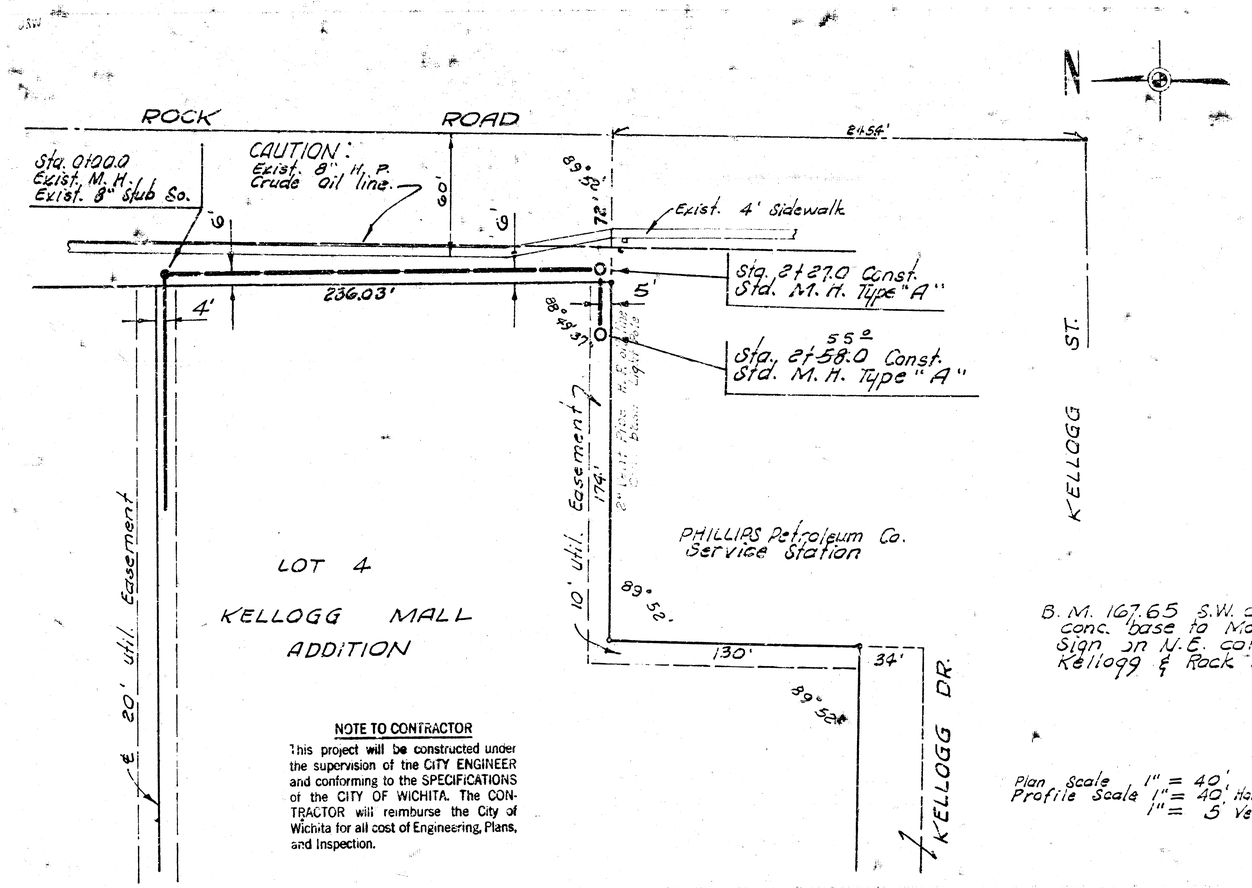

ROCK ROAD
Sta. 0+00.0
Exist. M.H.
Exist. 8" Stub So.
CAUTION:
Exist. 8" H.P.
Crude Oil line.
60'
89° 52'
Exist. 4' Sidewalk
2454'
Sta. 2+27.0 Const.
Std. M.H. Type "A"
5'
236.03'
4'
88° 48' 57"
55°
Sta. 2+58.0 Const.
Std. M.H. Type "A"
KELLOGG ST.
10' Util. Easement
174'
PHILLIPS Petroleum Co.
Service Station
LOT 4
KELLOGG MALL
ADDITION
89° 52'
130'
34'
89° 52'
KELLOGG DR.
20' Util. Easement
N
Plan Scale 1" = 40'
Profile Scale 1" = 40' Horz.
1" = 5' Vert
NOTE TO CONTRACTOR
This project will be constructed under the supervision of the CITY ENGINEER and conforming to the SPECIFICATIONS of the CITY OF WICHITA. The CONTRACTOR will reimburse the City of Wichita for all cost of Engineering, Plans, and Inspection.
Sta. 0+00.0
Exist. M.H.
Exist. 8" Stub So.
Sta. 2+27.0 Const.
Std. M.H. Type "A"
Sta. 2+58.0 Const.
Std. M.H. Type "A"
Top of Exist. Sidewalk
170
165
160
155
158.46 F/o out
158.56 F/o in
8" Stub So.
158.96
159.36
158.47 F/o out
158.57 F/o in
159.69 F/o
253 Lin. ft. of 8" Clay Pipe @ 0.40% grade.
0
1
2
As Built Final Meas. IH-83
PHILLIPS PETROLEUM COMPANY
SANITARY SEWER
N.W. KELLOGG DR. AND ROCK RD.
CITY OF WICHITA, KANSAS
R. W. LINN — CITY ENGINEER
OCT. 1973, PROJECT NO. BHKB503056