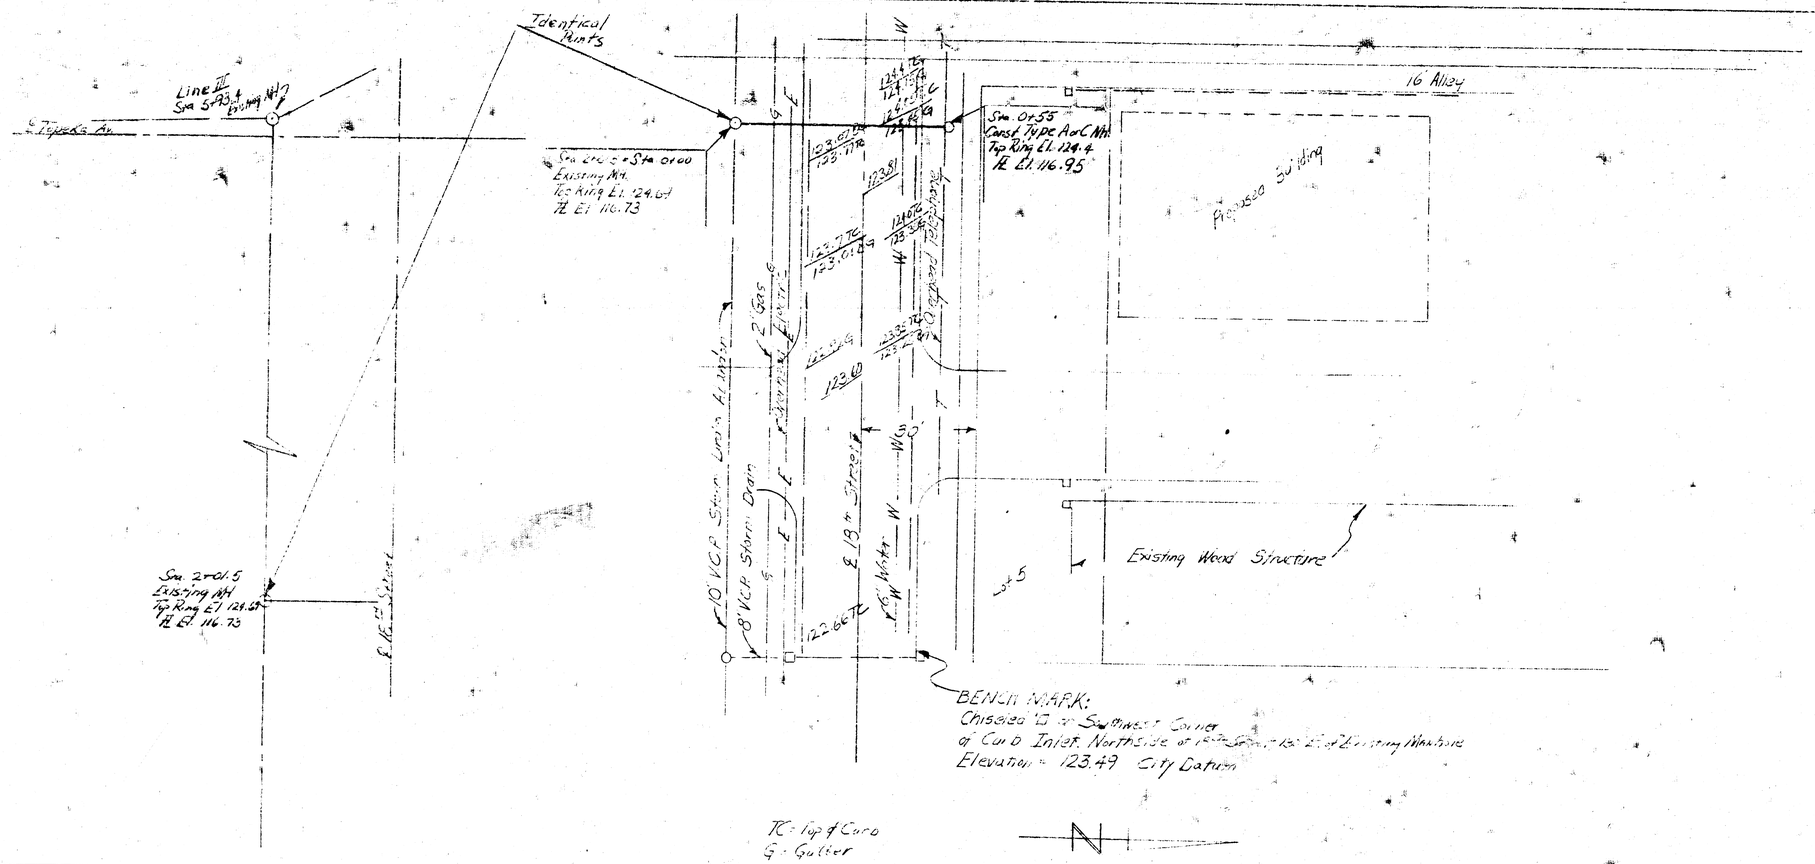

3-29-78

APPROVED AS NOTED
by CITY ENGINEER OF WICHITA
Sanitary Sewers
Storm Sewers
Drive Way Approaches

NOTE TO CONTRACTOR

This project will be constructed under the supervision of the City Engineer and subject to the approval of the City in accordance with the Standard Specifications of the City of Wichita.

CITY PROJECT NO.
468-76-245-80518-000-000-0

SANITARY SEWER EXTENSION
FOR
RALSTON PURINA, INC.
BY
UTILITY Contractors Inc.
U-1263 March, 1978