SANITARY SEWER EXTENSION

SERVING

Lots 11 & 12, Block 2, SOUTHWEST INDUSTRIAL ADDITION

PRIVATE PROJECT NUMBER

468-76-245-80001-000-000-064

APRIL 1986

APPROVED AS NOTED
By CITY ENGINEER OF WICHITA
Sanitary Sewers DB 4/15/86
Storm Sewers _____
Driveway Approaches _____
Water Mains _____
Paving _____


INDEX OF SHEETS

SHEET NO.	DESCRIPTION
1	TITLE SHEET
2	PLAN & PROFILE
3-6	STANDARDS

NOTIFY THE FOLLOWING COMPANIES PRIOR TO ANY TRENCHING.

ARKA GAS CO.	942-8350
BELL TELEPHONE	268-3087
CABLEVISION	266-6817
KPL GAS SERVICE	263-7511
KANSAS GAS & ELEC.	261-6248

THE CONTRACTOR SHALL BE RESPONSIBLE FOR PRESERVING PROPERTY IRONS. THE CONTRACTOR SHALL BE REQUIRED TO RE-ESTABLISH ANY PROPERTY IRONS WHICH ARE DAMAGED OR DESTROYED BY HIS CONSTRUCTION OPERATIONS. SUCH IRONS SHALL BE RE-ESTABLISHED BY A LICENSED LAND SURVEYOR OR A LICENSED PROFESSIONAL ENGINEER IN ACCORDANCE WITH STATE LAWS.

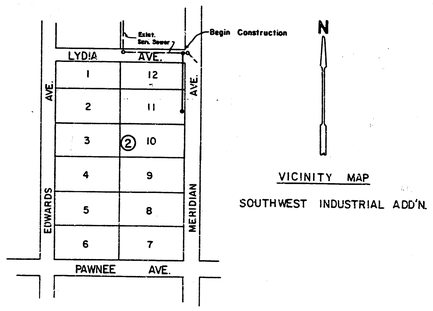

VICINITY MAP

SOUTHWEST INDUSTRIAL ADD'N.

NOTE TO CONTRACTOR

This project will be constructed under the supervision of the CITY ENGINEER and conforming to the SPECIFICATIONS of the CITY OF WICHITA. The CONTRACTOR will pay the City of Wichita for all costs of plan review, inspection and booking per contract.

MOEHRING & ASSOCIATES
CONSULTING ENGINEERS
WICHITA

DON C. MOEHRING II
LICENSED
3463
KANSAS
PROFESSIONAL ENGINEER

N

1" = 20' Horiz.
1" = 5' Vert.

℄ MERIDIAN AVE. — AVE. LYDIA (Unimproved)

BENCHMARK - Top of S. Rim Manhole Elev. 103.63 City Datum

Flow

STA. 0+00 - CONSTR. TYPE "A" OR "C" MANHOLE OVER EXISTING 8" V.C.P SEWER. FL. In (S)= 97.00. FL. Out (E)= 95.21.
BEGIN PROJECT

STA. 3+43.6 - CONSTR. STD. SHALLOW TYPE "A" MANHOLE. FL. 6" STUB (W)= 98.47 FL. Out (N)= 98.37
END PROJECT

50' 5' 5' 50'

10' Sewer Easement (By Separate Instrument)

282'

160' 200'

8' Exist. 8" San. Sewer

80'

BLOCK 12 — INDUSTRIAL ADDITION — SOUTHWEST

N. Edge Asphalt Parking Lot

Lot 11

Building Under Construction

PLAN
SURVEYED
PLOTTED
NOTE BOOK
NO.
DATE
BY

PROFILE
SURVEYED
PLOTTED
NOTE BOOK
NO.
DATE
BY

105
100
95
90

Top Rim= 103.7

Existing Ground Profile

Top Rim= 104.9

6" Stub W

343.6 LF 8" P.V.C. @ 0.40%

Sta. 0 +00 FL. (E) 95.21 — +50 — 1 — +50 — 2 — +50 — 3 — +43.6 FL. Out (N) 96.54 FL. 6" Stub (W) 98.47

AS BUILT
REC'D
5-2-06

MOEHRING & ASSOCIATES
CONSULTING ENGINEERS
WICHITA

MOEHRING
LICENSED
3463
KANSAS
PROFESSIONAL ENGINEER

Private Project No. 468-76-245-80001-000-000-064

PLATE 1 - PLAN - PROFILE - F. A. S.
CLEARPRINT PAPER CO., S. F. CAL.
NO. 1000-1

44 3 2/6 2/2