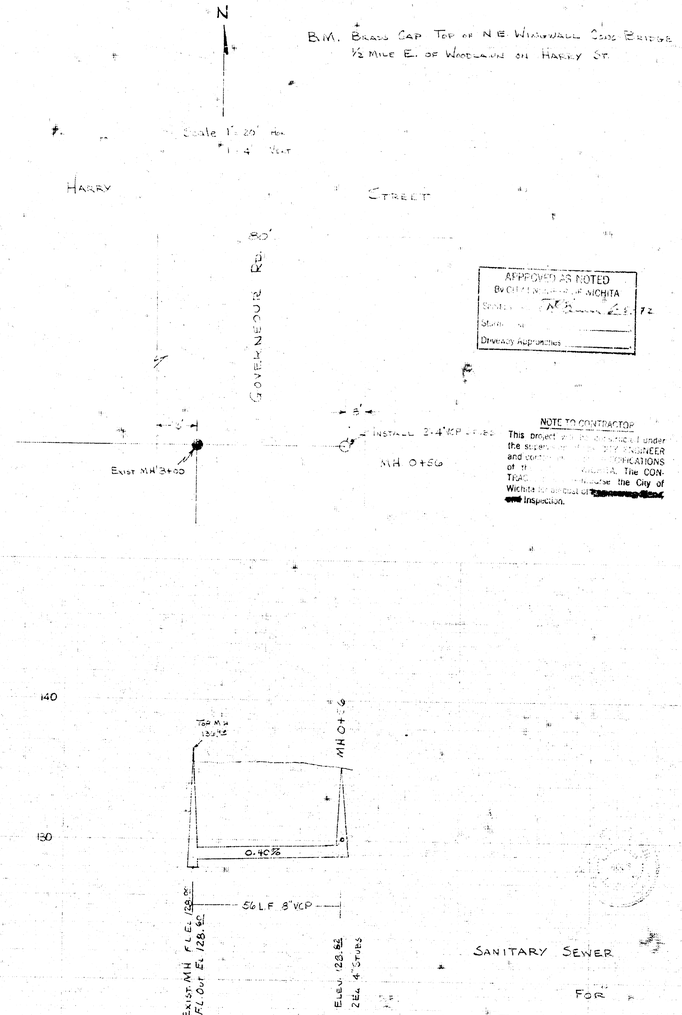


SANITARY SEWER

FOR

TRAIL-N-SAIL, INC.

7215 E. HARRY ST.

WICHITA, KANSAS

MID STATES COAST CO. INC.

JUNE-1972 AALBSC2016

Sht 1 of 1 (7)