B.M. Brass Cap Top of N.E. Wingwall Conc Bridge
½ Mile E. of Woodlawn on Harry St.

Scale 1" = 20' Hor
1" = 4' Vert

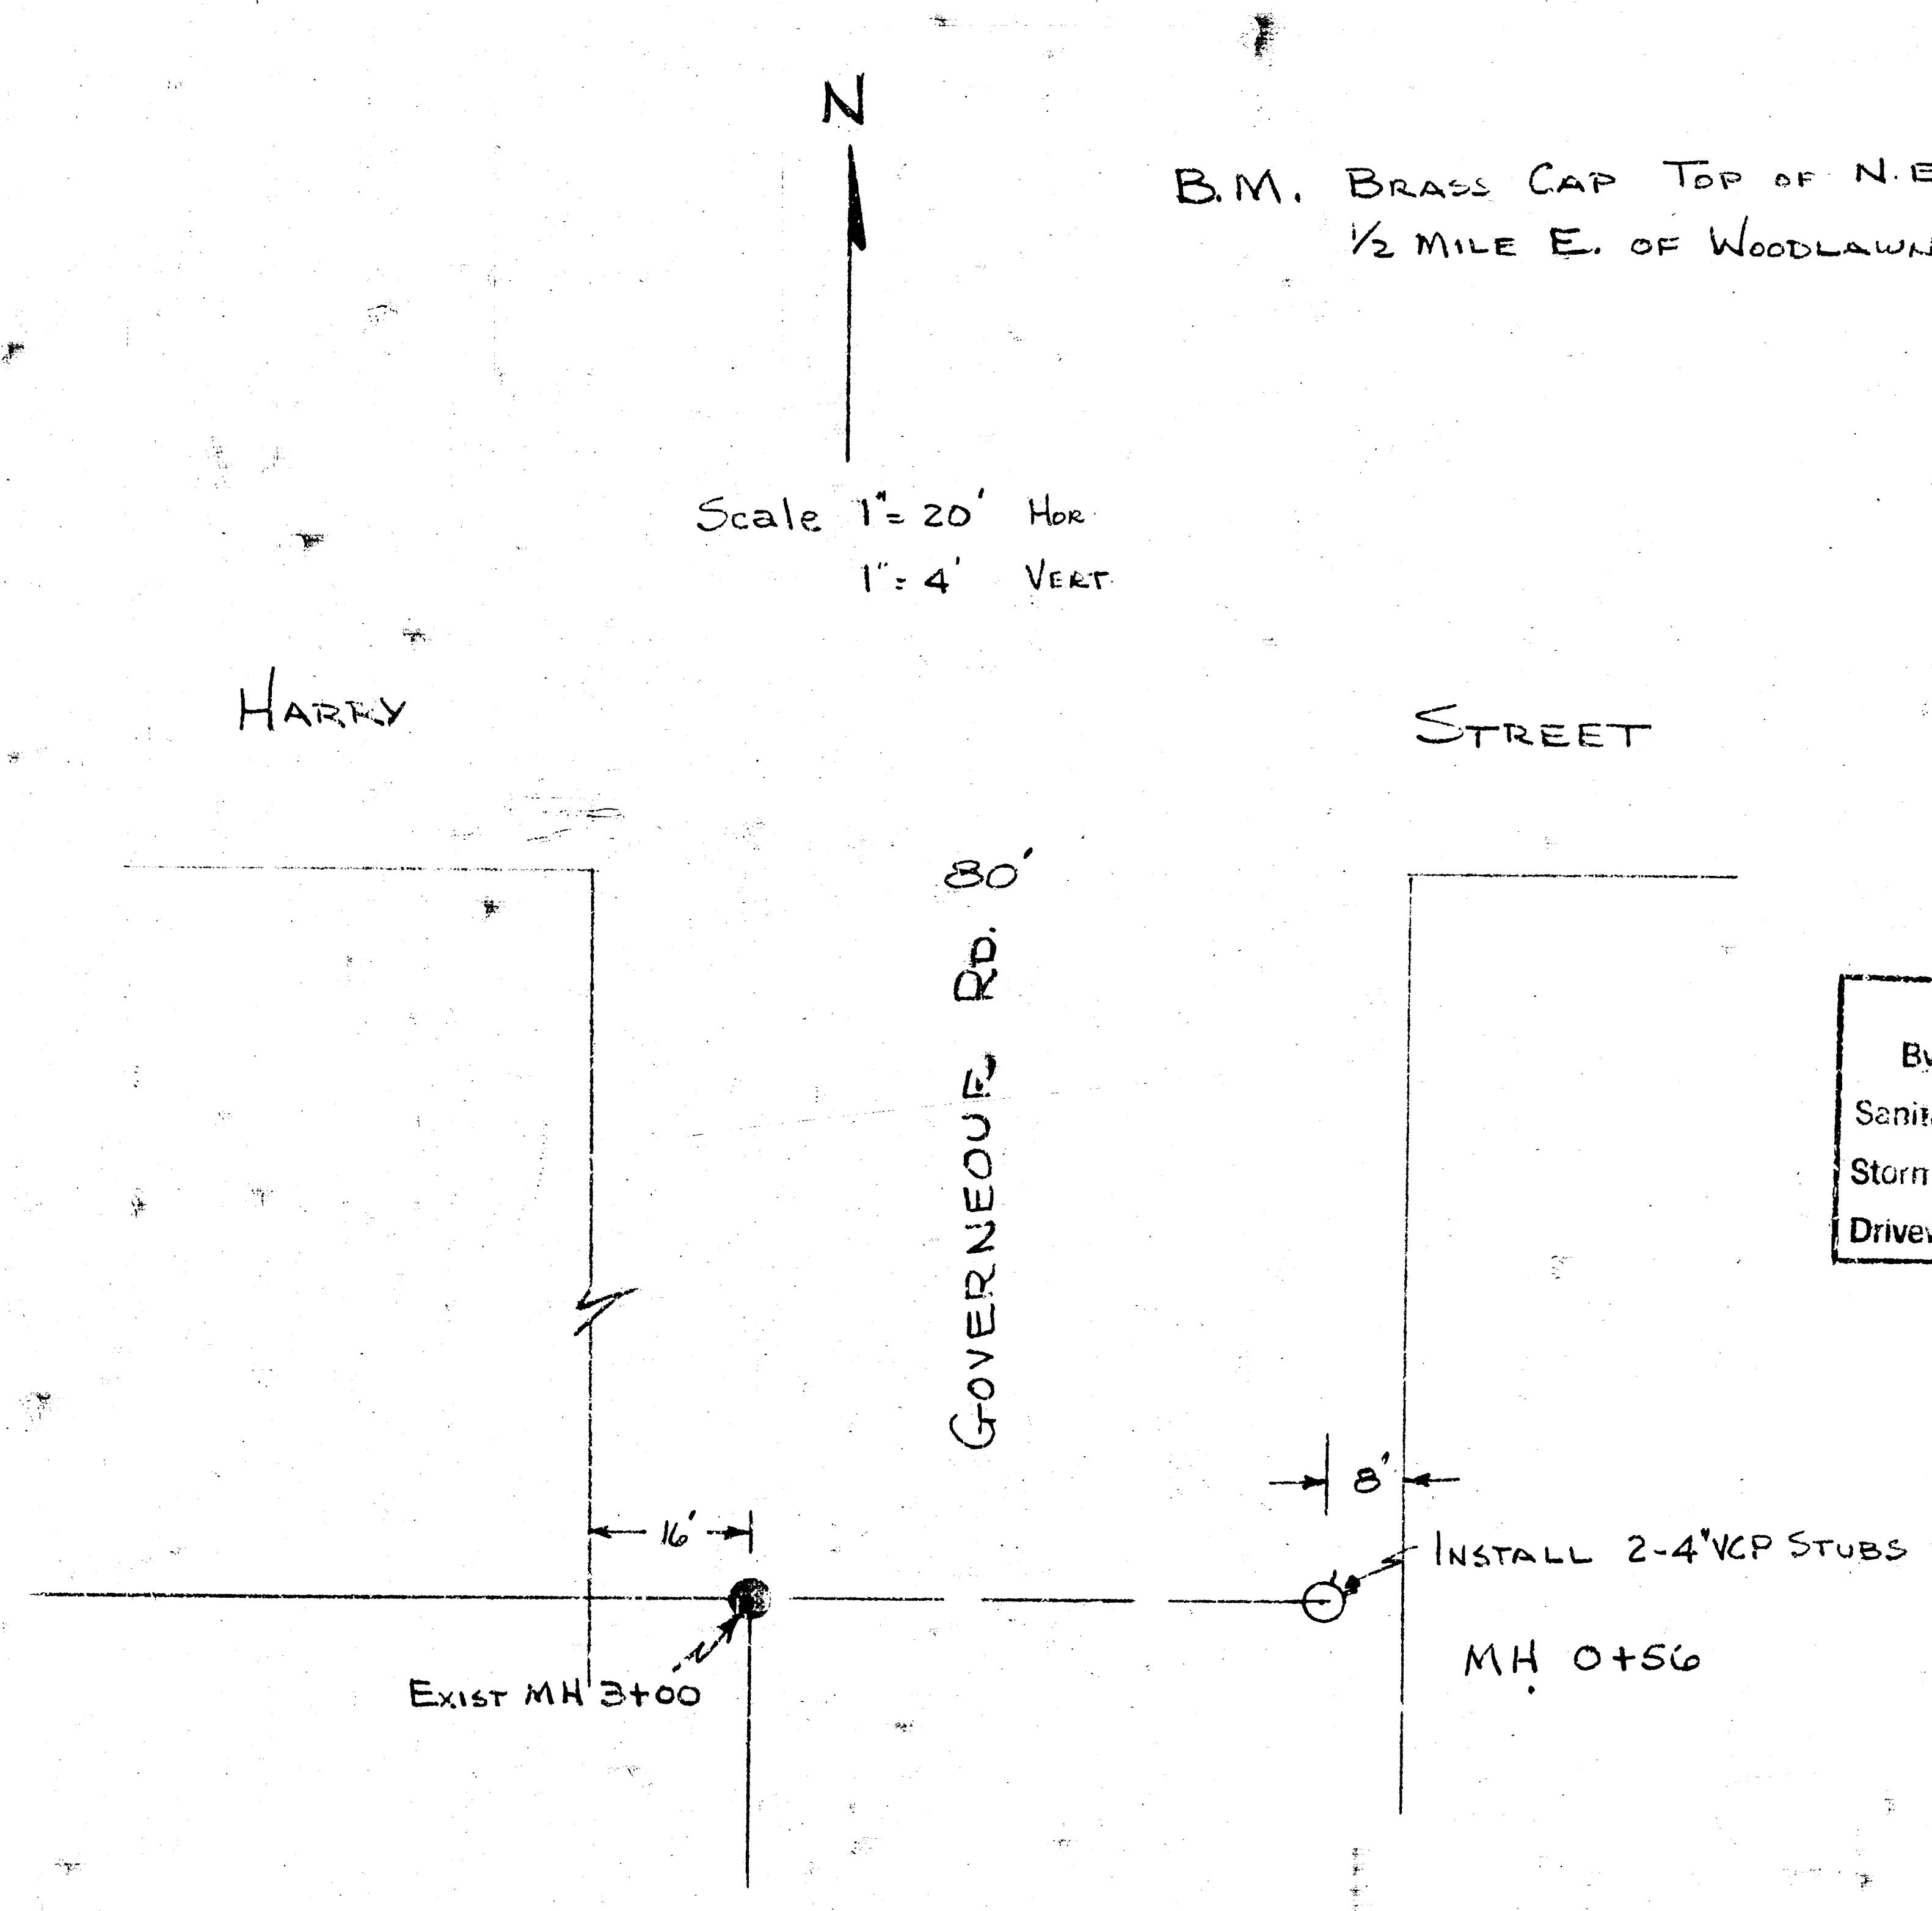
N
Harry
Street
80'
Governeour Rd.
16'
8'
Install 2-4" VCP Stubs
Exist MH 3+00
MH 0+56

APPROVED AS NOTED
By CITY ENGINEER OF WICHITA
Sanitary Sewers 6-5-72
Storm Sewers ______
Driveway Approaches ______

NOTE TO CONTRACTOR

This project will be constructed under the supervision of the CITY ENGINEER and conforming to the SPECIFICATIONS of the CITY OF WICHITA. The CONTRACTOR will reimburse the City of Wichita for all cost of [redacted] Inspection.

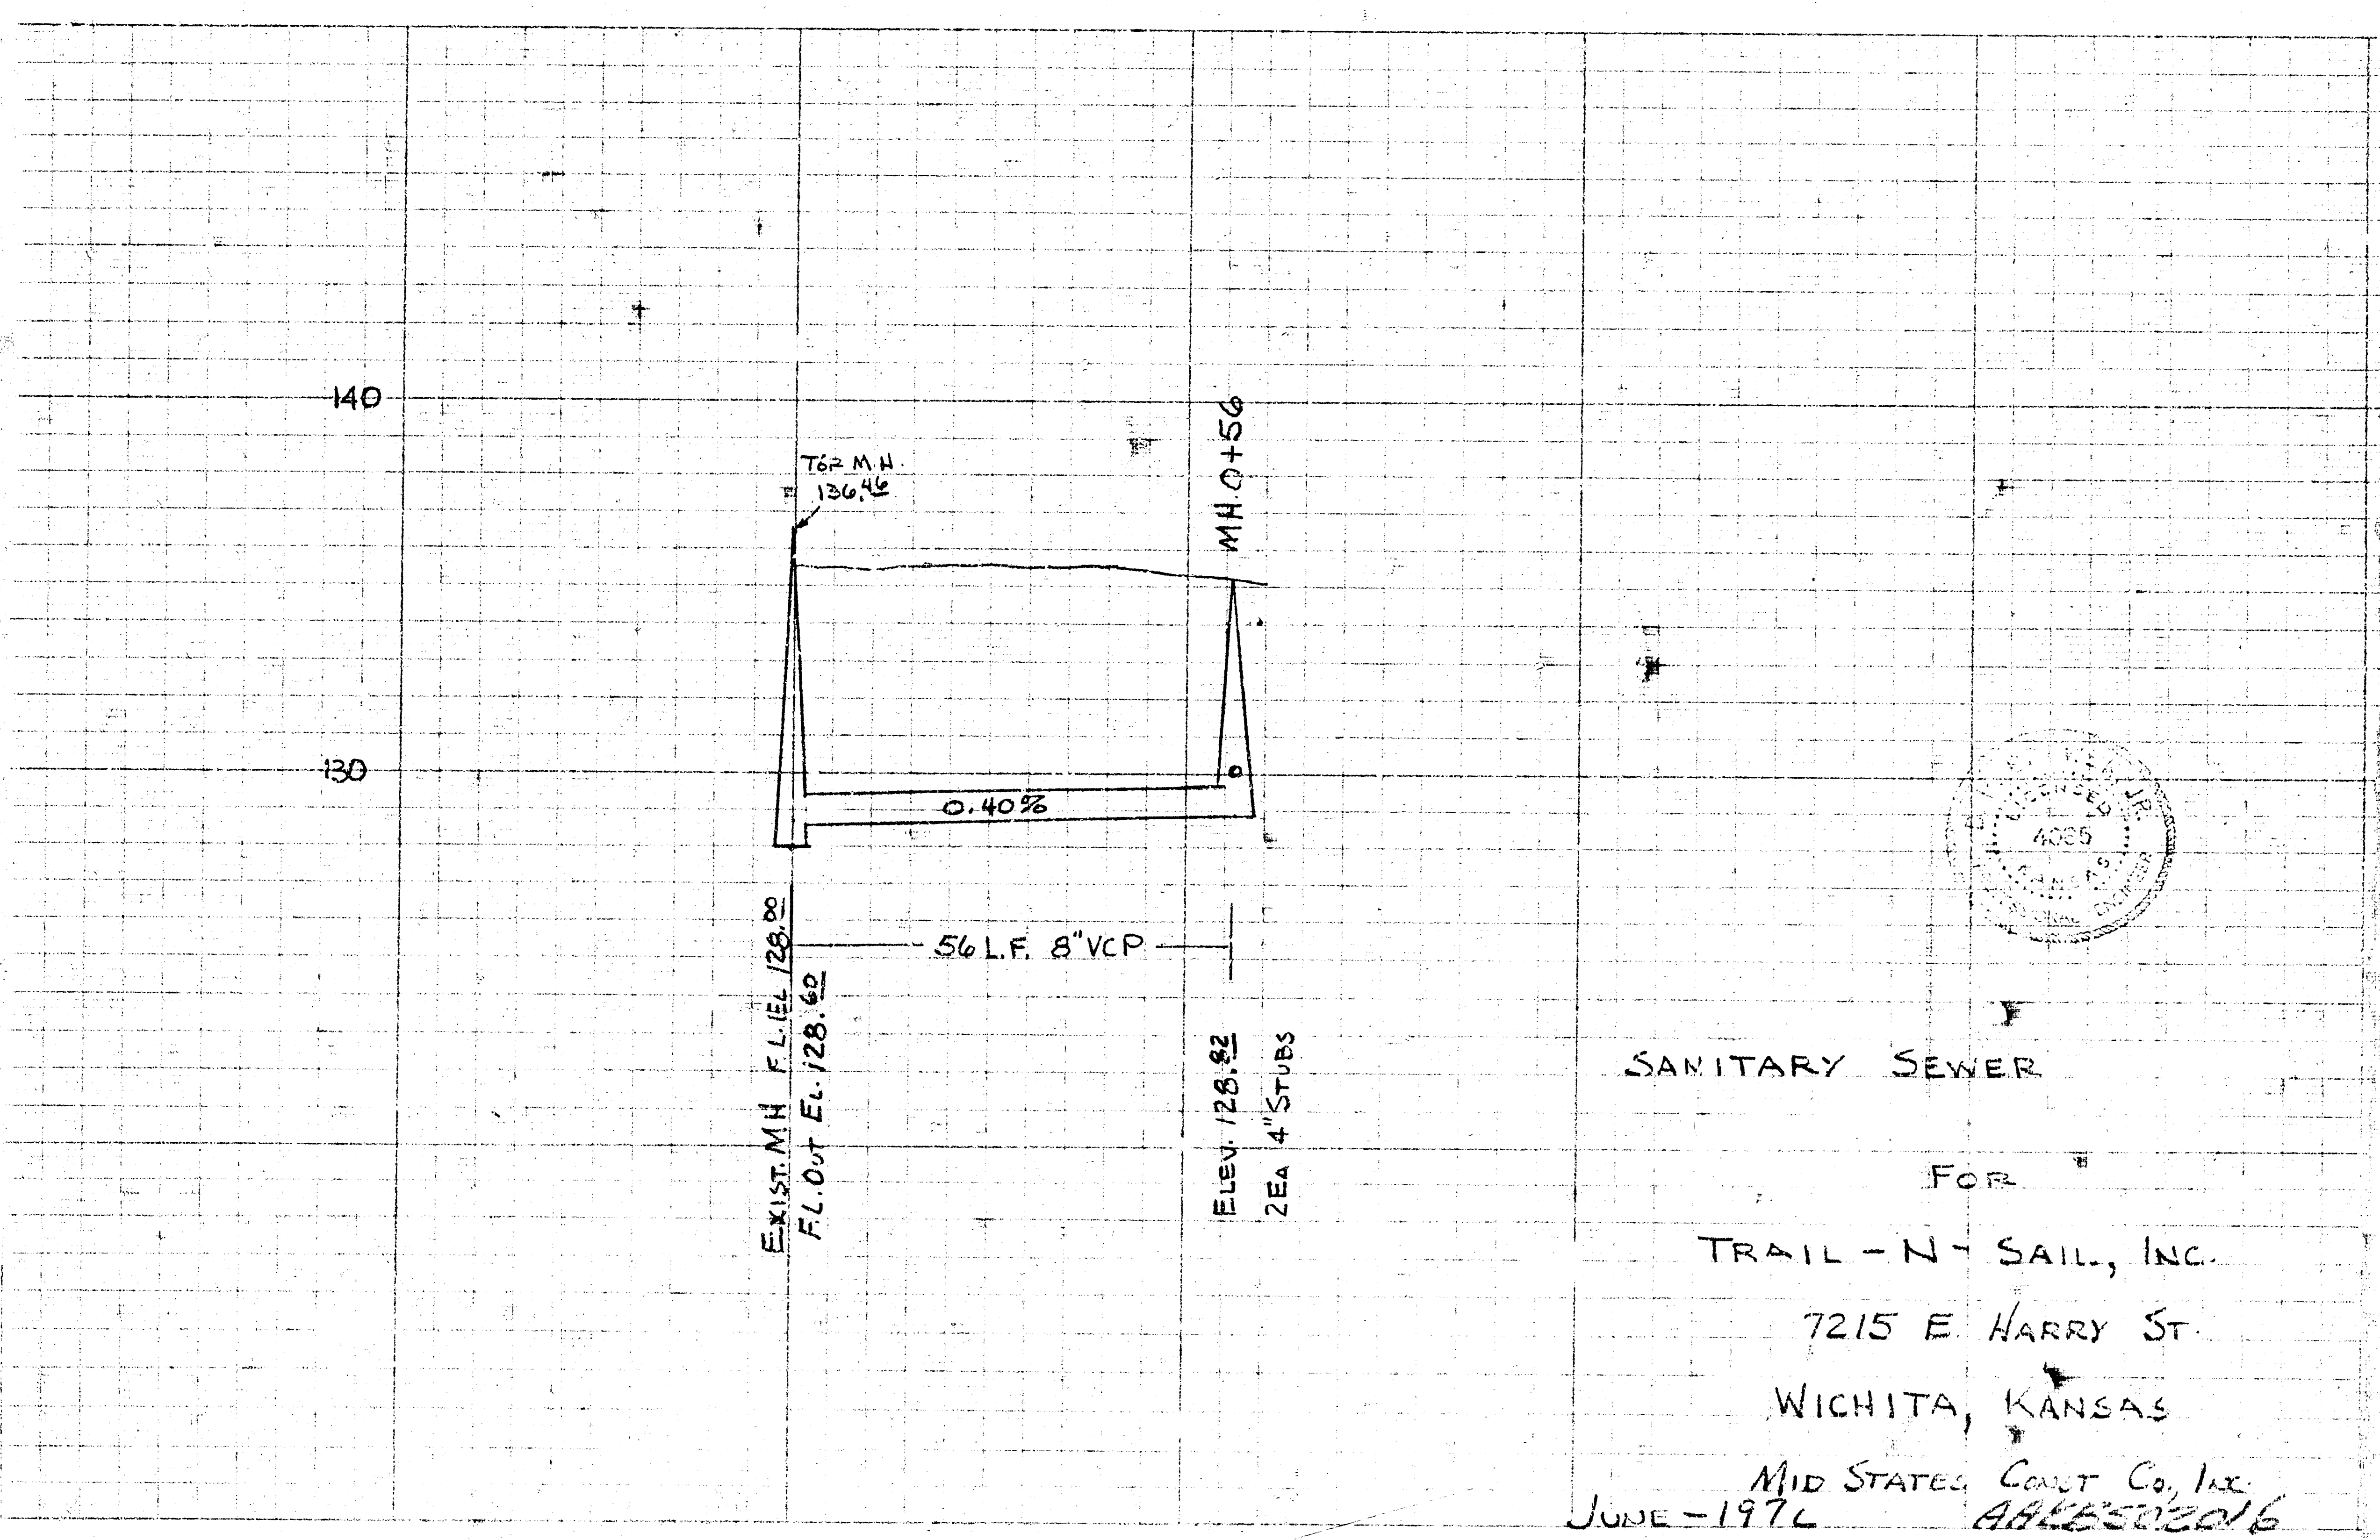
140
130
Top M.H. 136.46
MH 0+56
0.40%
56 L.F. 8" VCP
Exist. MH F.L. El. 128.81
F.L. Out El. 128.60
Elev. 128.82
2 Ea 4" Stubs
4035

SANITARY SEWER

FOR

TRAIL-N-SAIL, INC.
7215 E. HARRY ST.
WICHITA, KANSAS

MID STATES CONST CO, INC.

JUNE - 1972