
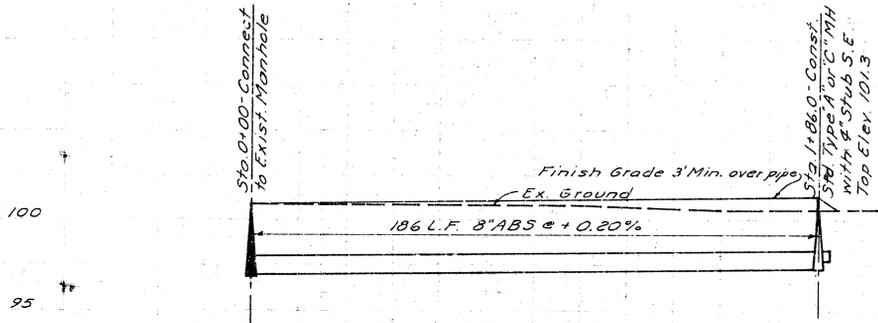


SENECA AVE.

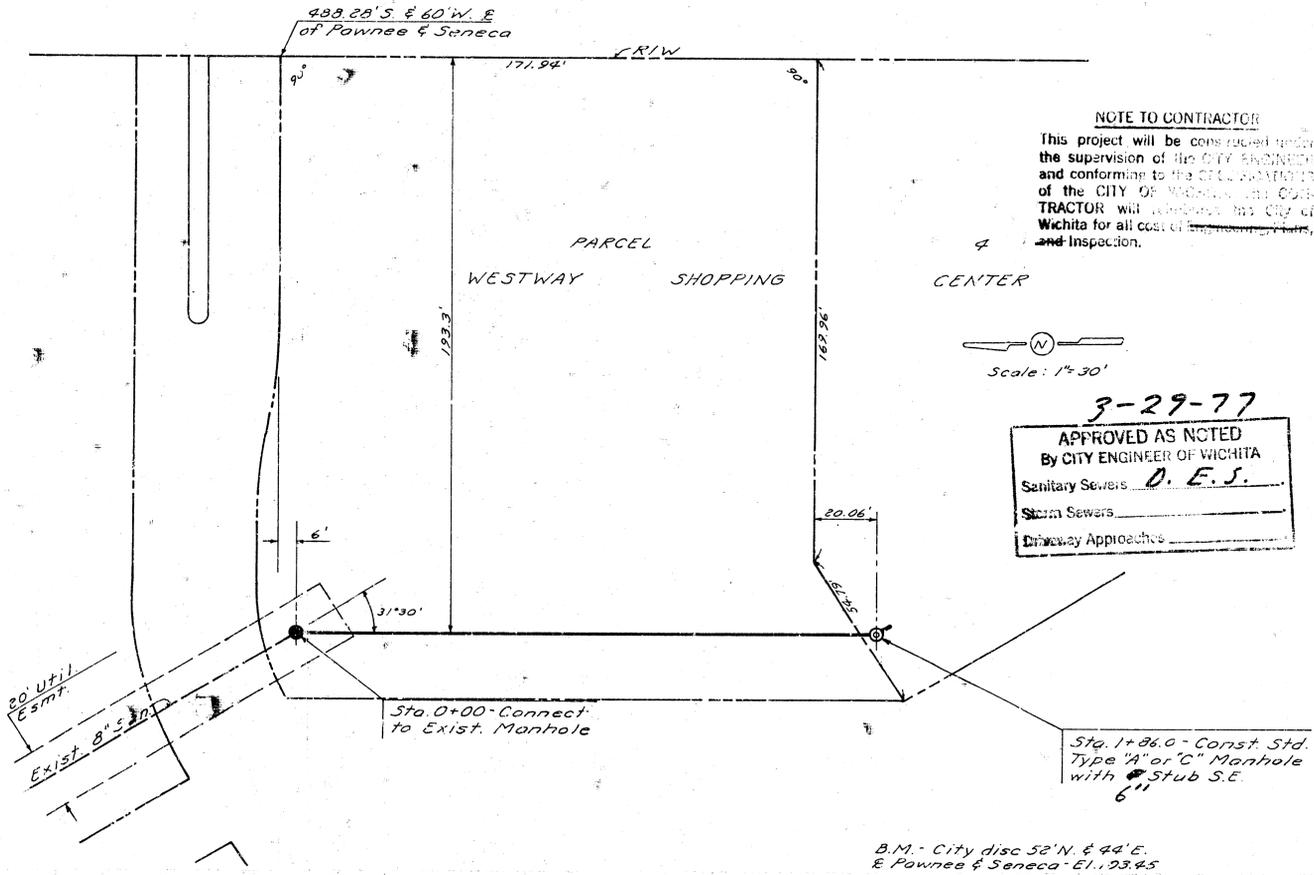

0' E. out 96.90
E. in 97.00

1' E. 97.20

E. out 97.37
E. in 97.70

CITY PROJ. NO. DBKW 707018
SANITARY SEWER TO SERVE
SOUTH PART OF PARCEL 4
WESTWAY SHOPPING CENTER

Revised 3-29-77

14 10 2 18