
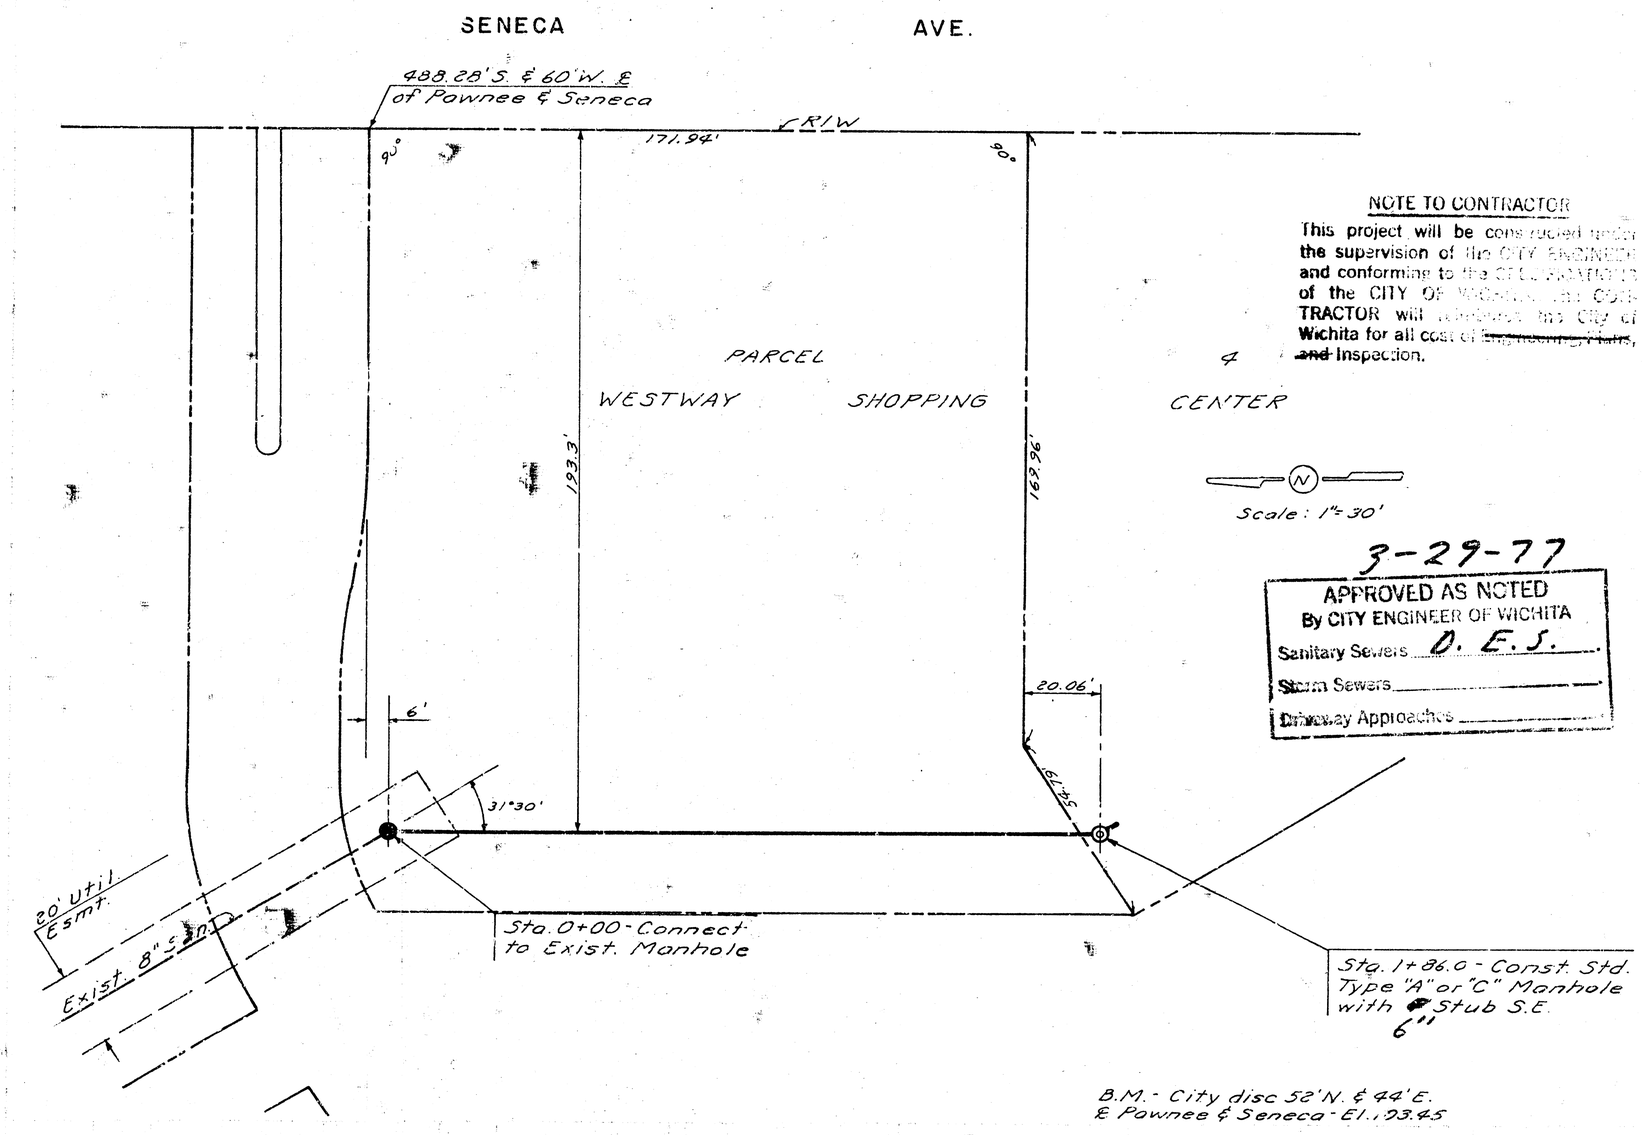


NOTE TO CONTRACTOR

This project will be constructed under the supervision of the CITY ENGINEER and conforming to the SPECIFICATIONS of the CITY OF WICHITA. The CONTRACTOR will reimburse the City of Wichita for all cost of Engineering, Plans, and Inspection.

3-29-77

APPROVED AS NOTED
By CITY ENGINEER OF WICHITA
Sanitary Sewers O. E. S.
Storm Sewers
Driveway Approaches

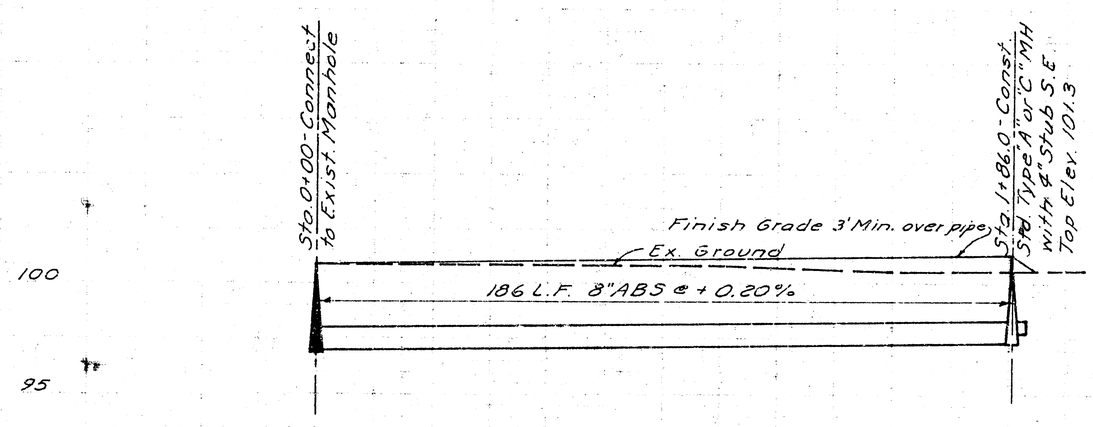

CITY PROJ. NO. DBKW 707018
SANITARY SEWER TO SERVE
SOUTH PART OF PARCEL 4
WESTWAY SHOPPING CENTER

Revised 4-1-77

℄ out 96.90
℄ in 97.00

℄ out 97.37
℄ in 97.70

℄ 97.20

2

12 10 8 18