


BM 123.42 RR Spike 55. RR
bet. Parkwood & Old Manor 40'
No. of N. Kinkaid

Date 2-19-52
Drawn by L. McCl.
Checked by []
Book No. 72

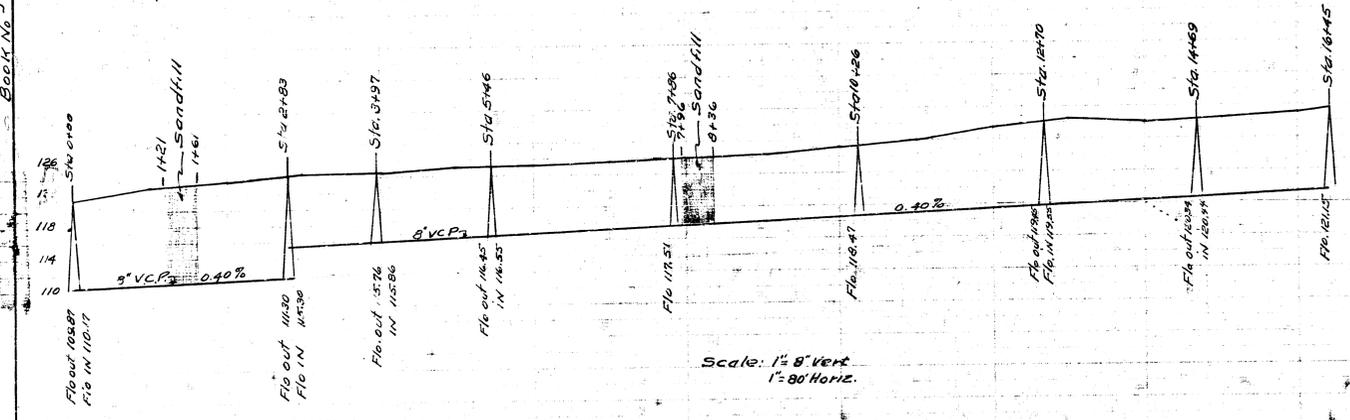

L.A.T. 12 SUB. 1 WIS.
CITY OF WICHITA KANSAS
L. WHITE CITY ENGINEER
Proj. No. C22-11