

EDGEWOOD ADD.
BLOCKS 6 & 9

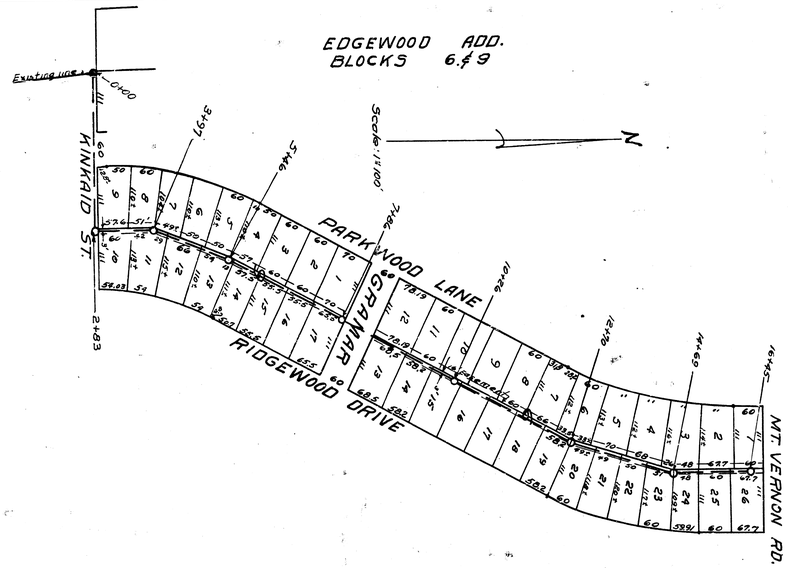

BM 123.42 RR Spike 55 P.P
bet. Parkwood & Old Manor 40'
No. of N.L. Kinkaid

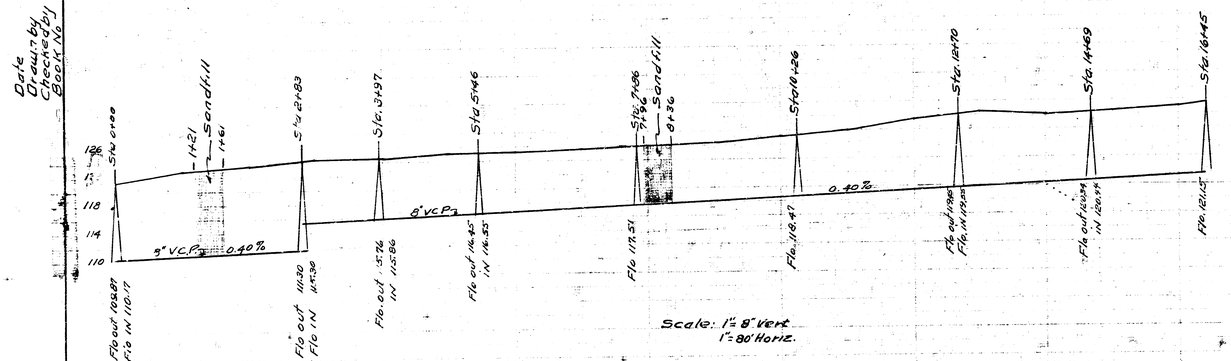

Scale: 1" = 8' Vert.
1" = 80' Horiz.

Date 2-19-52
Drawn by L. Nacl.
Checked by
Book No. 12

LOT 12 SUB. 1 WIS.
CITY OF WICHITA KANSAS
L.M. WHITE CITY ENGINEER
Proj No. C22-11

L. M. WHITE
LICENSED
55
KANSAS