


B. M. 169.413 Douglas Ave. and Rock P.C. 47 South and 53.5' West of Center line of both streets.



Sta. 0100.0 Const. 8" Rein. Conc. Encasement of 12" Clay pipe.

NOTE: Profiles indicate natural ground and proposed elevation. It is probable that the ground elevations will be graded to the proposed elevation at the time that this project is to be constructed.


Plan Scale 1" = 40'
Profile Scale 1" = 10' Vert.

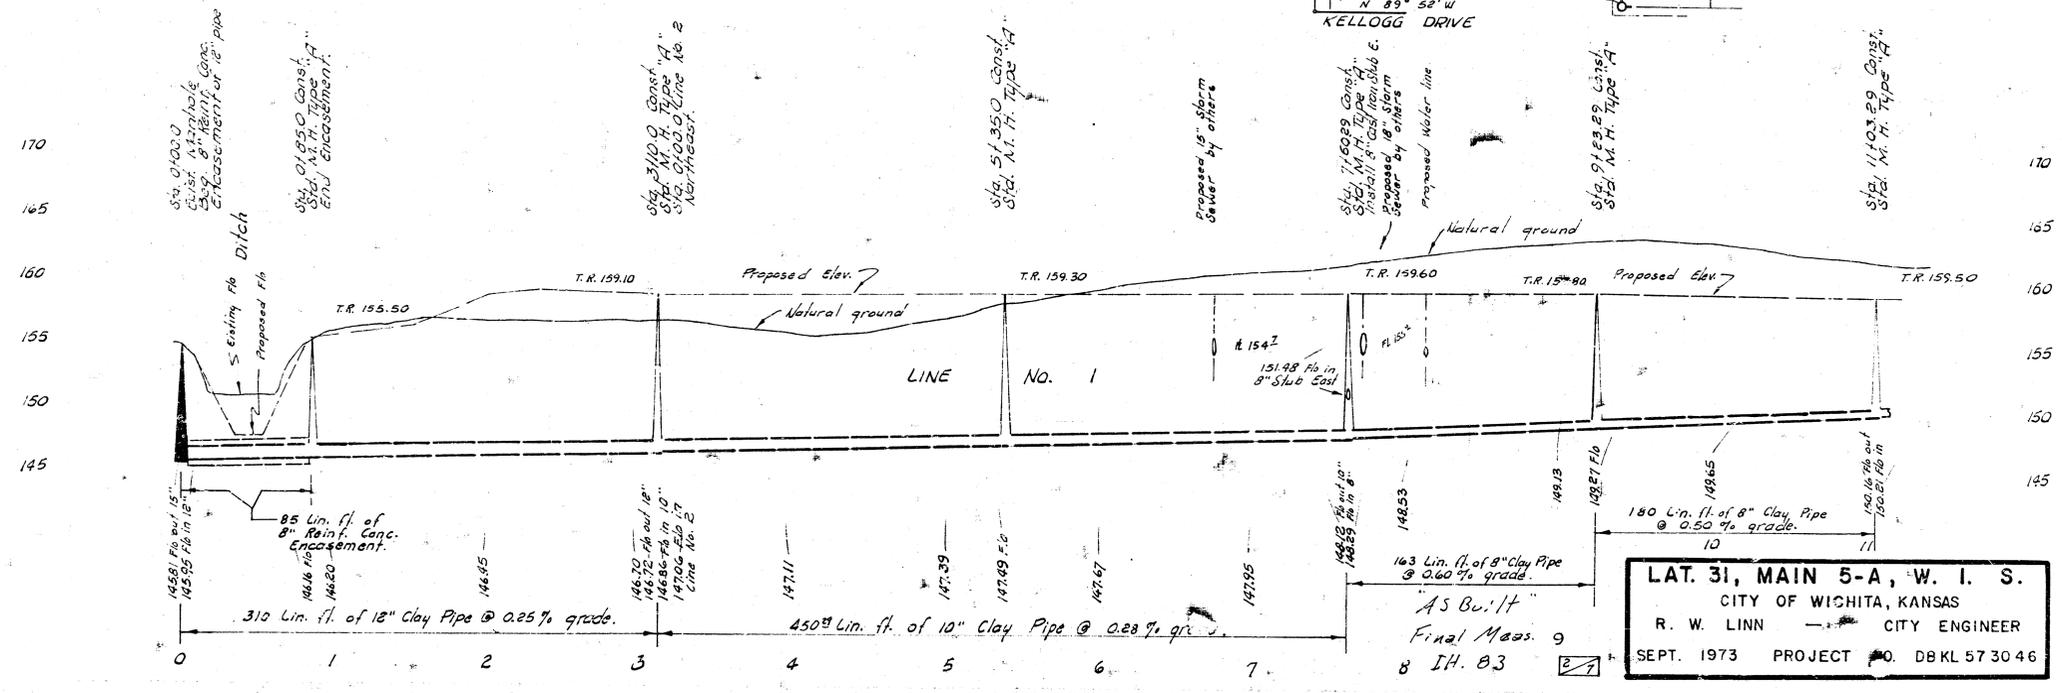


LAT. 31, MAIN 5-A, W. I. S.
CITY OF WICHITA, KANSAS
R. W. LINN — CITY ENGINEER
SEPT. 1973 PROJECT NO. DBKL 573046

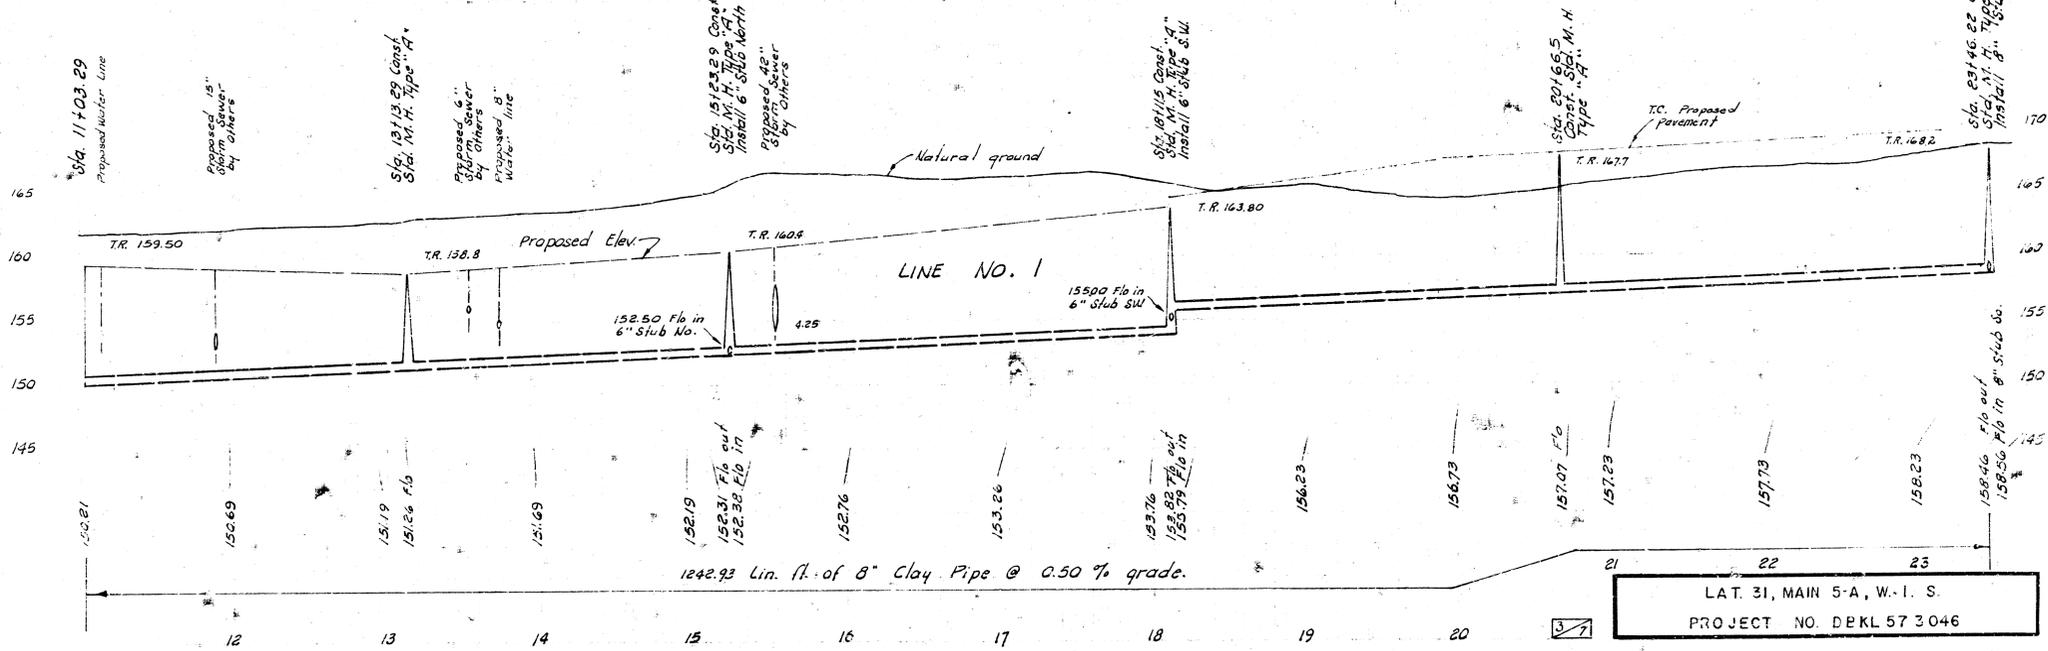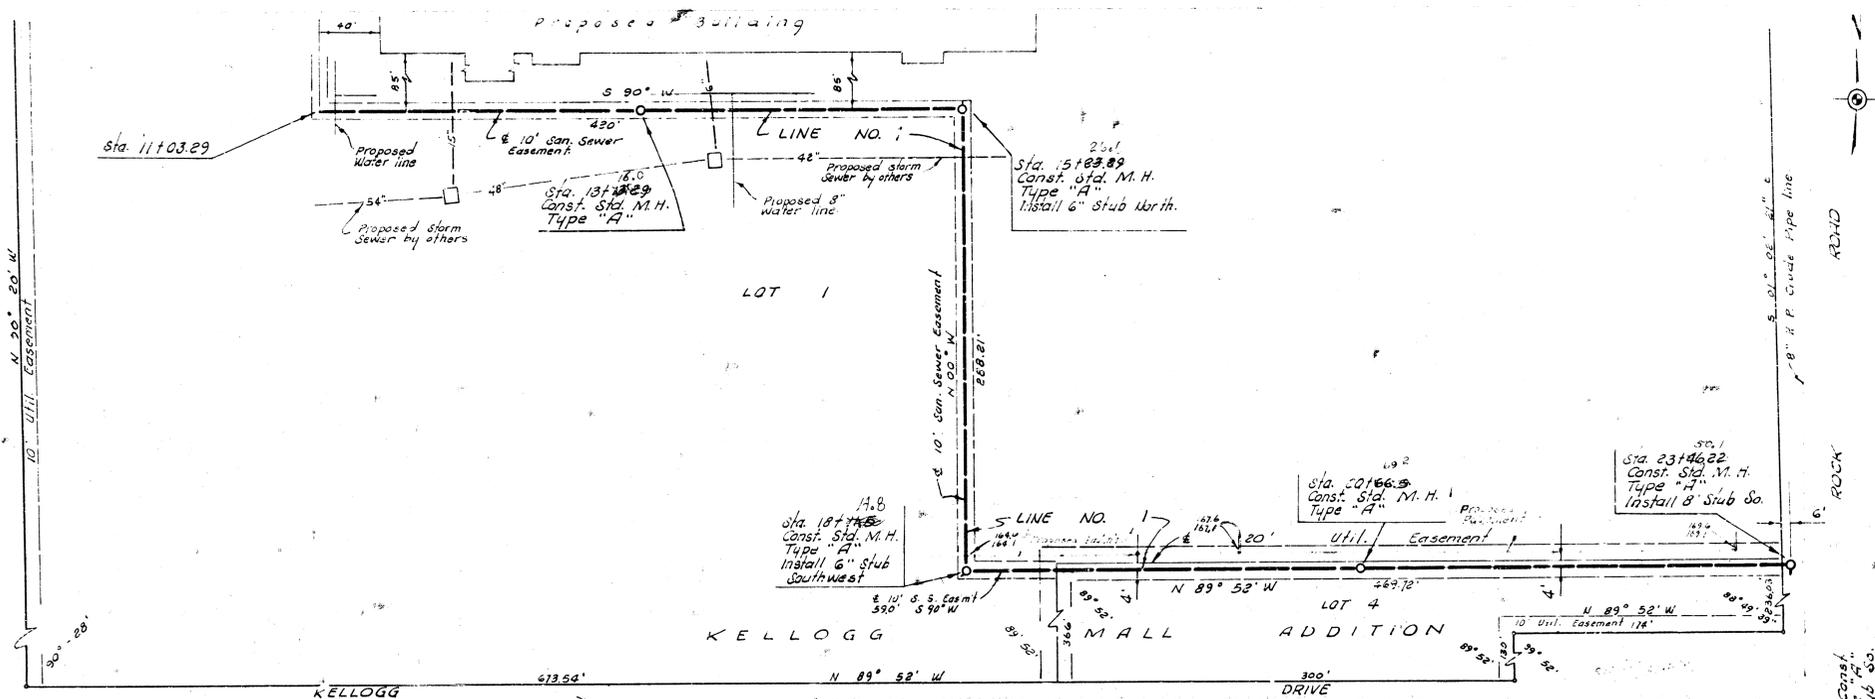


LAT. 31, MAIN 5-A, W-1. S.
PROJECT NO. DPKL 57 3046

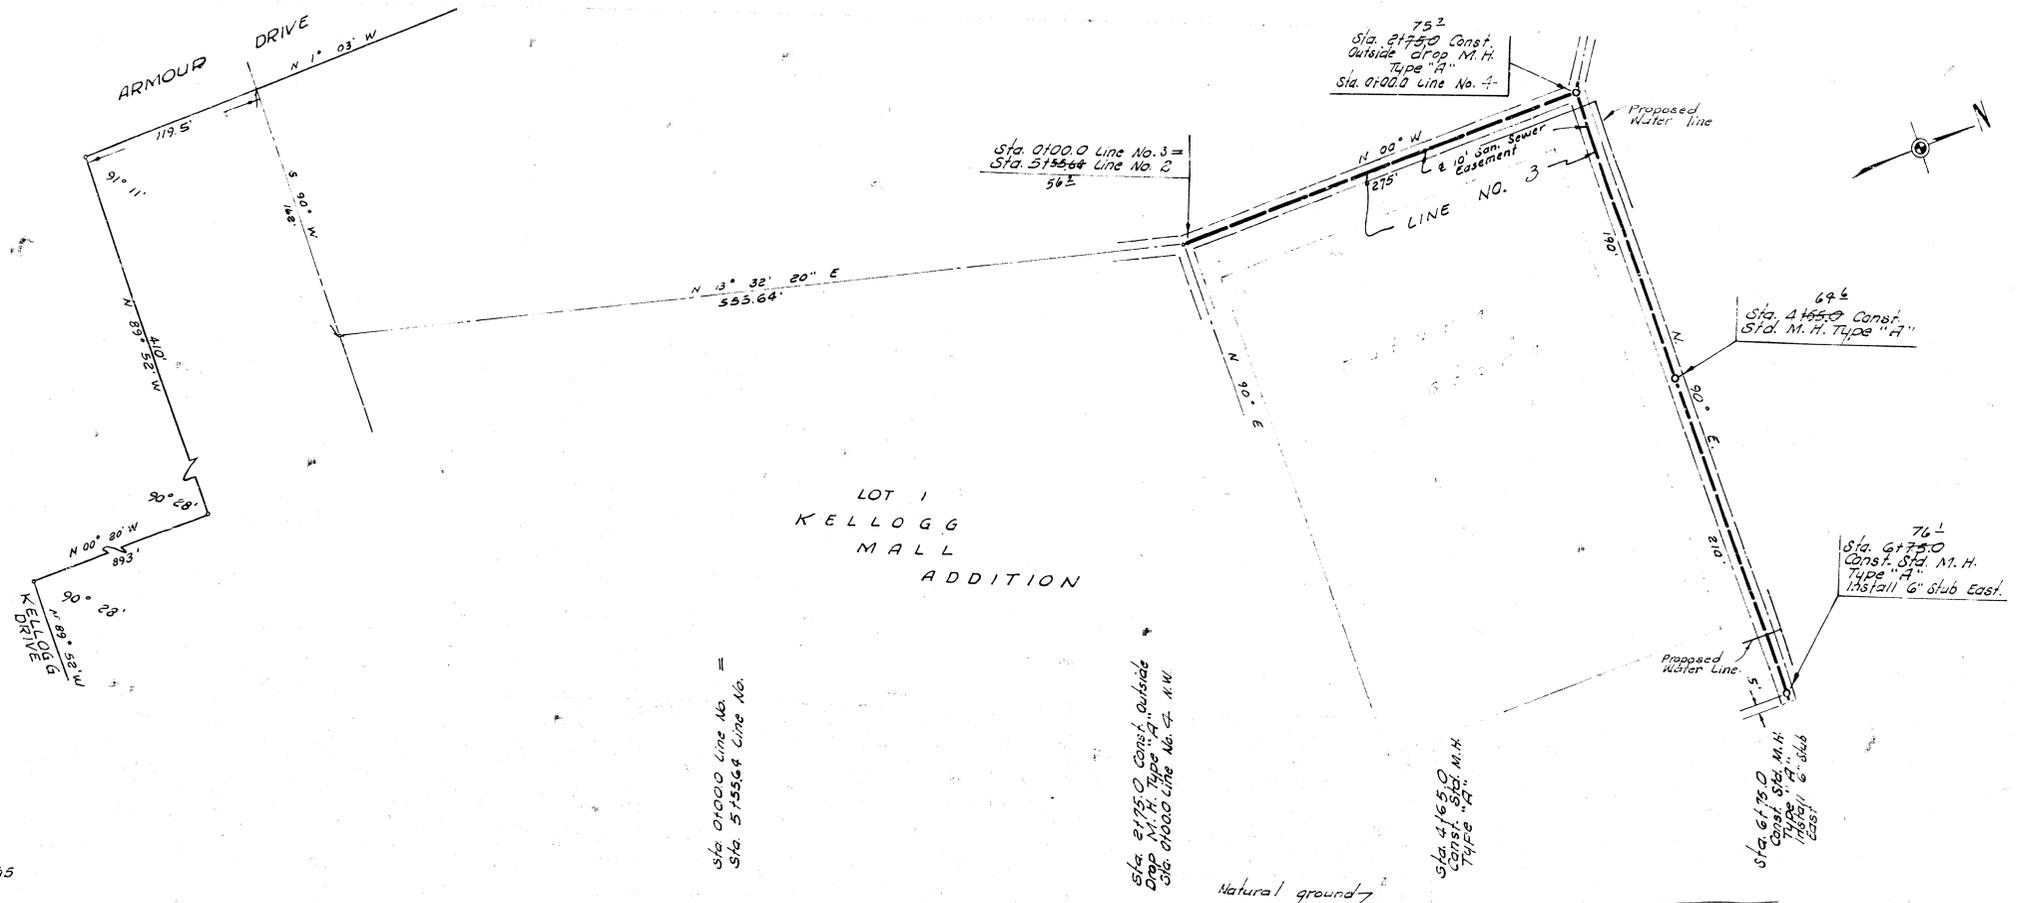



165
160
155
150
145

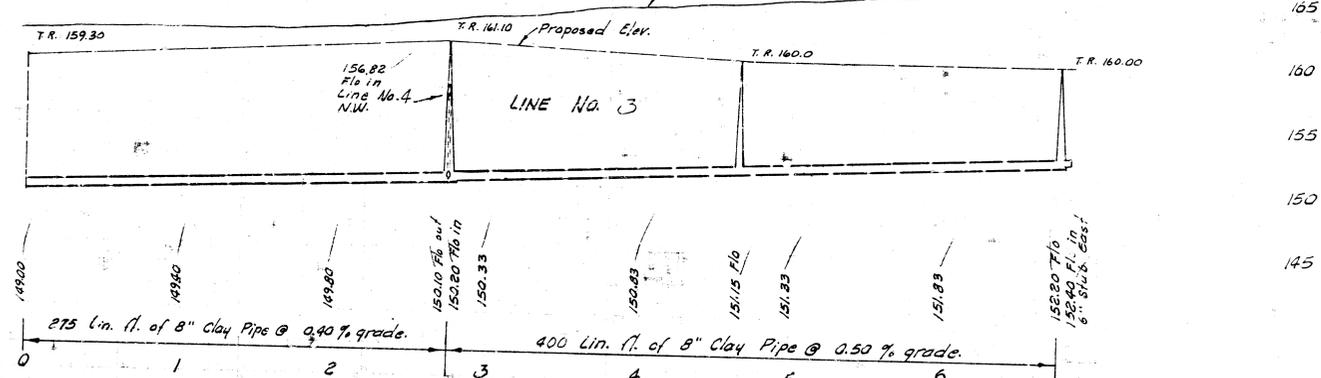

LAT. 31, MAIN 5-A, W. I. S.
PROJECT NO. DBKL 573046

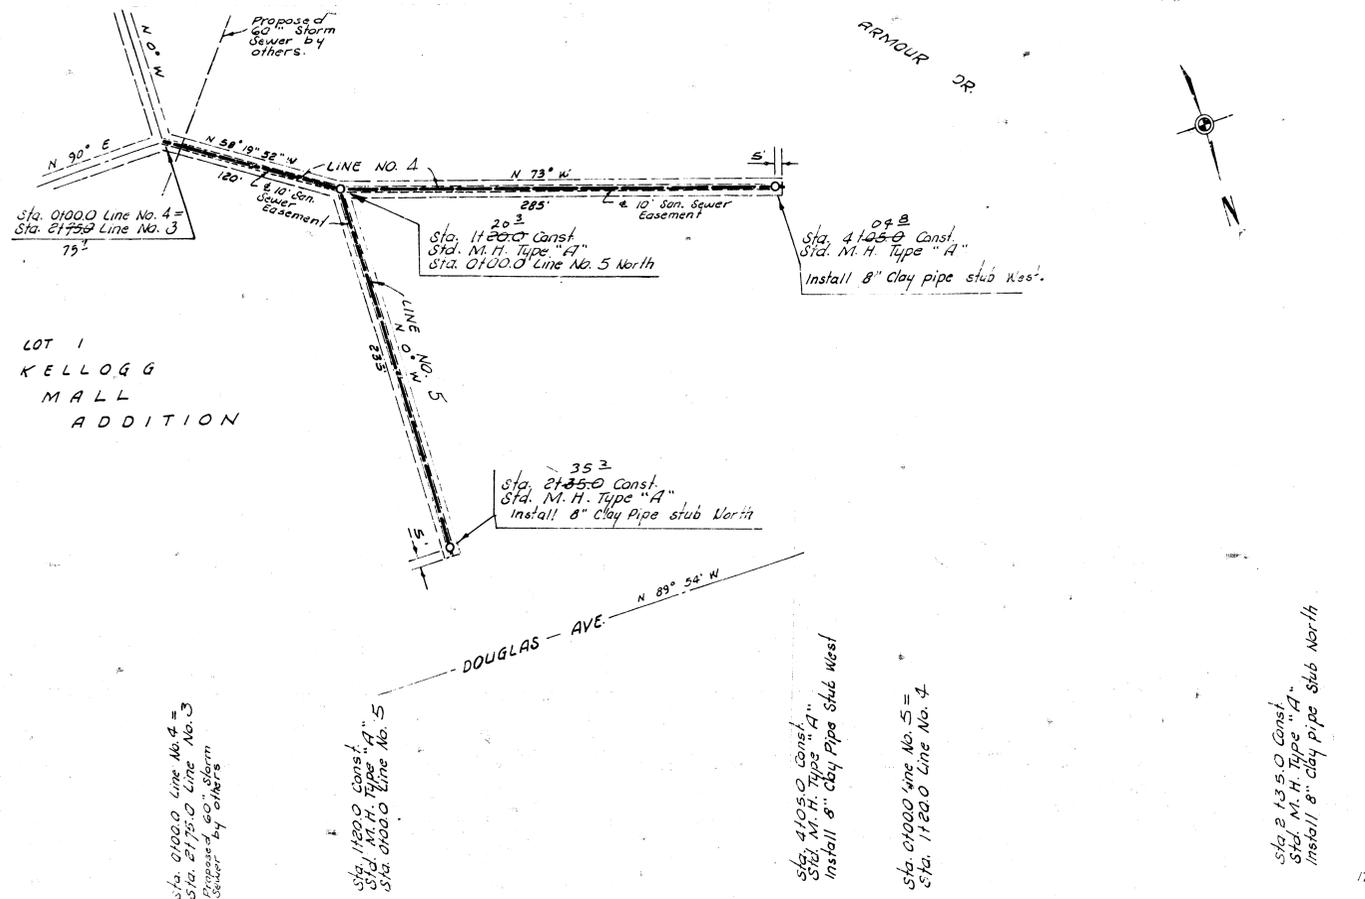

170
165
160
155

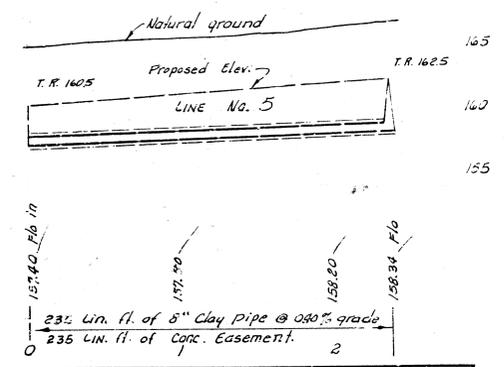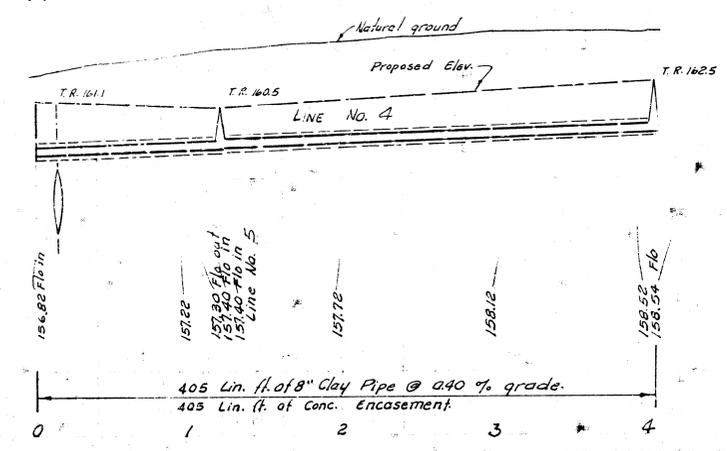

LAT. 31, MAIN 5-A, W. I. S.
PROJECT NO. DBK 573046
sheet No. 6 Revised 9-11-73

