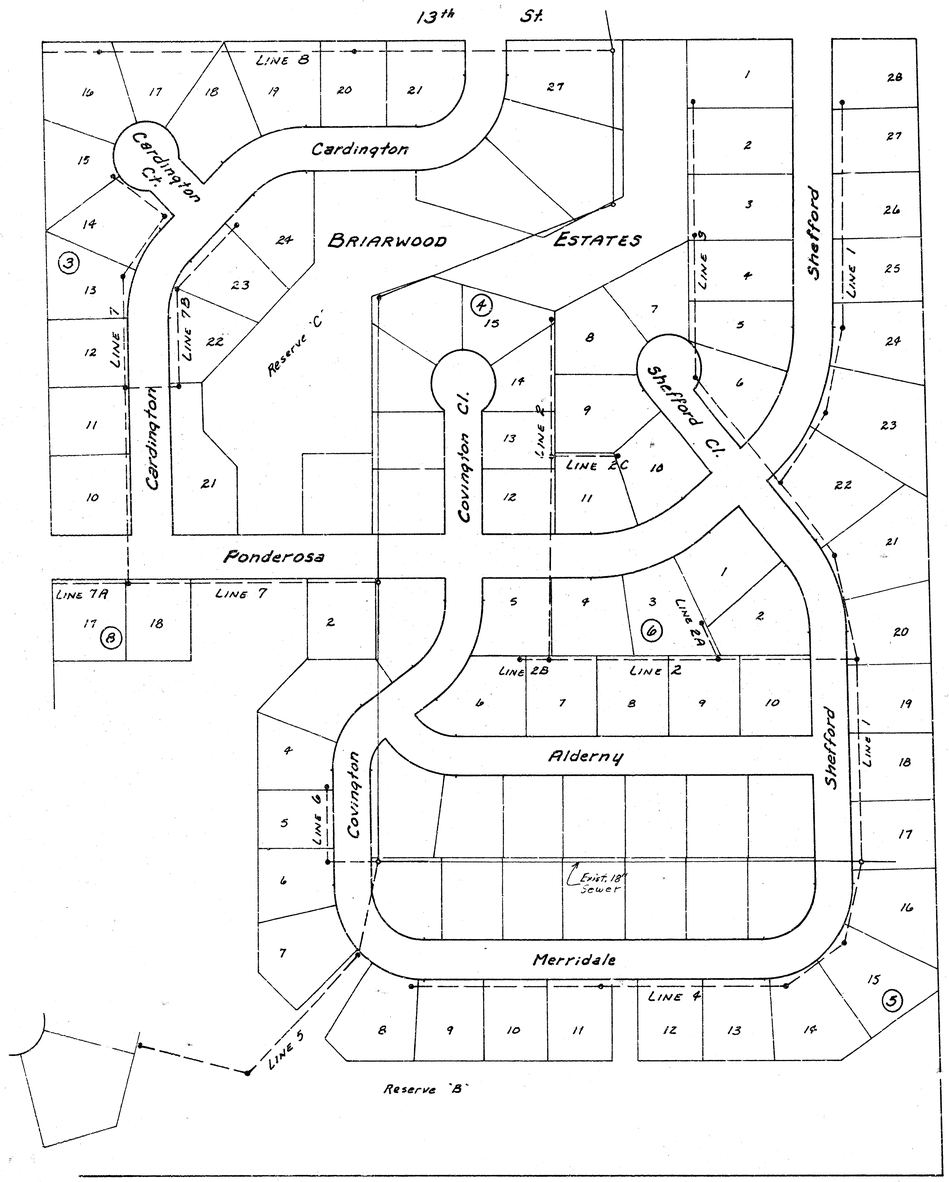


LAT 4, MAIN 12, SW. INTERCEPTOR

CITY OF WICHITA

RAY BRUGGEMAN – CITY ENGINEER

PROJ. NO. 468-76-245-80954-000-000-001

Line # 1	Sheet # 2
Line # 2	Sheets # 3-4
Line # 2A	Sheet # 3
Line # 2B	Sheet # 3
Line # 2C	Sheet # 4
Line # 3	Sheet # 4
Line # 4	Sheet # 5
Line # 5	Sheet # 6
Line # 6	Sheet # 6
Line # 7	Sheet # 7-8
Line # 7A	Sheet # 7
Line # 7B	Sheet # 8
Line # 8	Sheet # 9

As Built 6/81

DONALD E. SCHNEIDER LICENSED 8311 KANSAS PROFESSIONAL ENGINEER

B.M. 157.93 City Std. 27.5' N and 25' E of ¼ sec. corner ½ mile W. of Maize Rd. on 13th St.

B.M. 153.12 Bridge spike S-face HLP N-side 13th St. approx 20' E of EL Cardington south.

B.M. 156.52 R.R. spike S-face HLP N-side 13th St. 1900' E of 119th St. W or approx. 100' E of ¼ corner (hedge row south).

B.M. 146.47 R.R. spike E-face Osage Orange Hedge tree in hedge row N-S @ NL Ponderosa ½ Block W of Cardington

B.M. 162.25 R.R. spike SW-face Osage Orange Hedge tree in hedge row N-S ½ mile W. of Maize Road near NE corner lot 21, Blk 5. Briarwood Estates.

Scale Plan 1" = 40'
Profile 1" = 40' Horz.
1" = 5' Vert.

N

Sta 0+00 Line "1
Sta 0+00 Line "4
Exist. Manhole
Exist 8" stubs N+S

Sta 2+97.1 Line "1
Sta 0+00 Line "2
Const. Std. M.H.
Type "A" or "C"

Sta 4+62 Const. Std.
M.H. Type "A" or "C"

Sta 5+90.8 Line "1
Sta 0+00 Line "3
Const. Std. M.H.
Type "A" or "C"
4" Stub E

Sta 6+58.8 Const. Std.
M.H. Type "A" or "C"
4" Stub N.E.

Sta 8+74 Const. Std.
M.H. Type "A" or "C"
4" Stub E

Sta 11+75 Const. Std.
M.H. Type "A" or C
Install 4" stub NE.

Shefford

Proposed 8" Water Main

20' Utility Easement

30' Utility Easement

LINE "1

BRIARWOOD ESTATES

13th St.

17 18 19 20 21 22 23 24 25 26 27 28

Sta 0+00 Line "1
Sta 0+00 Line "4
Exist. Manhole
Exist 8" stubs N+S

Sta 2+93.7 Line "1
Sta 0+00 Line "2
Const. Std. M.H.
Type "A" or "C"

Sta 4+60 Const. Std.
M.H. Type "A" or "C"

Sta 5+91 Line "1
Sta 0+00 Line "3
Const. Std. M.H.
Type "A" or "C"

Sta 7+00 Const. Std.
M.H. Type "A" or "C"

Sta 8+75 Const. Std.
M.H. Type "A" or "C"

Sta 11+75 Const. Std.
M.H. Type "A" or C
Install 4" stub NE.

Proposed E Top Cb Shefford

LINE "1

160 155 150 145 140 135

135.35 135.75 140.45 141.45 142.18 143.18 144.41 145.21 145.45


295.7 L.F. of 8" Clay Pipe @ 0.40 % Grade
Alternates 8" A.B.S. Composite or P.V.C. Pipe


879.3 L.F. of 8" Clay Pipe @ 0.60 % Grade
Alternates 8" A.B.S. Composite Pipe or P.V.C. Pipe

0 1 2 3 4 5 6 7 8 9 10 11 12 (3/9)


Lot 4. Main 12 SW1
468-76-245-80954-000-000-001


Scale Plan 1" = 40'
Profile 1" = 40' Horz.
1" = 5' Vert.

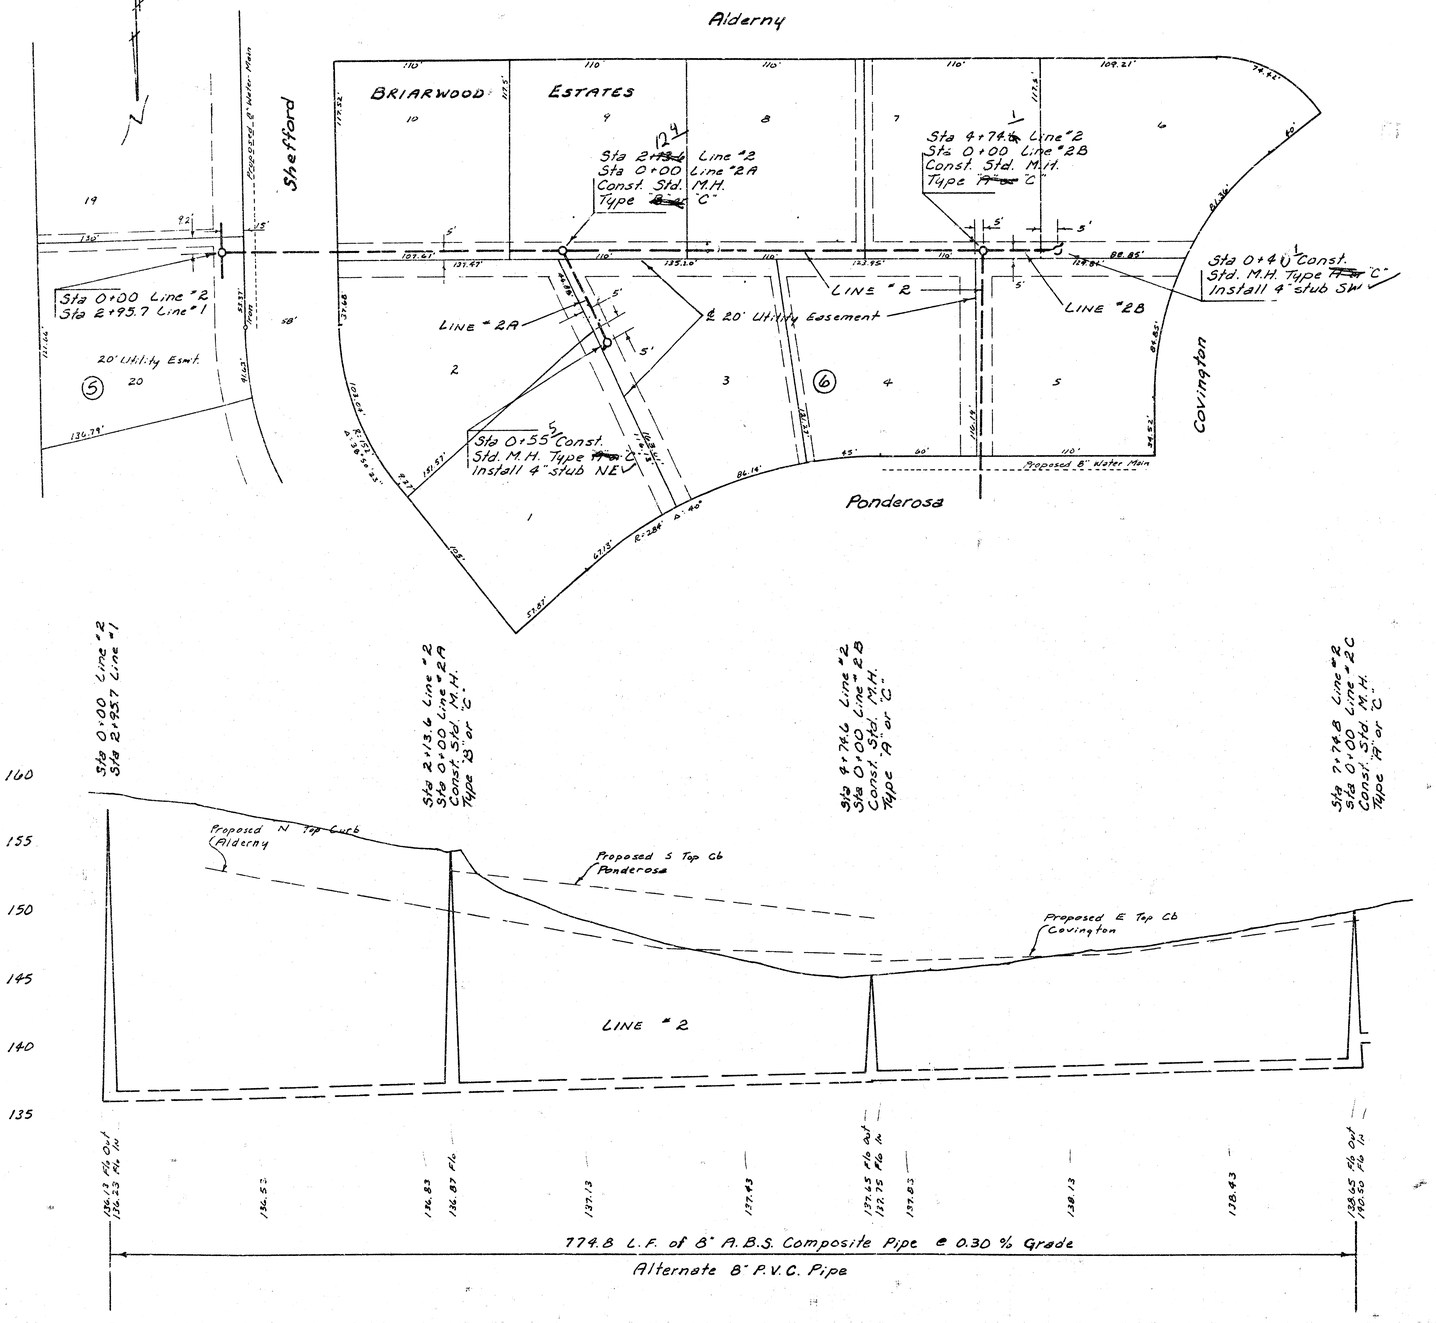


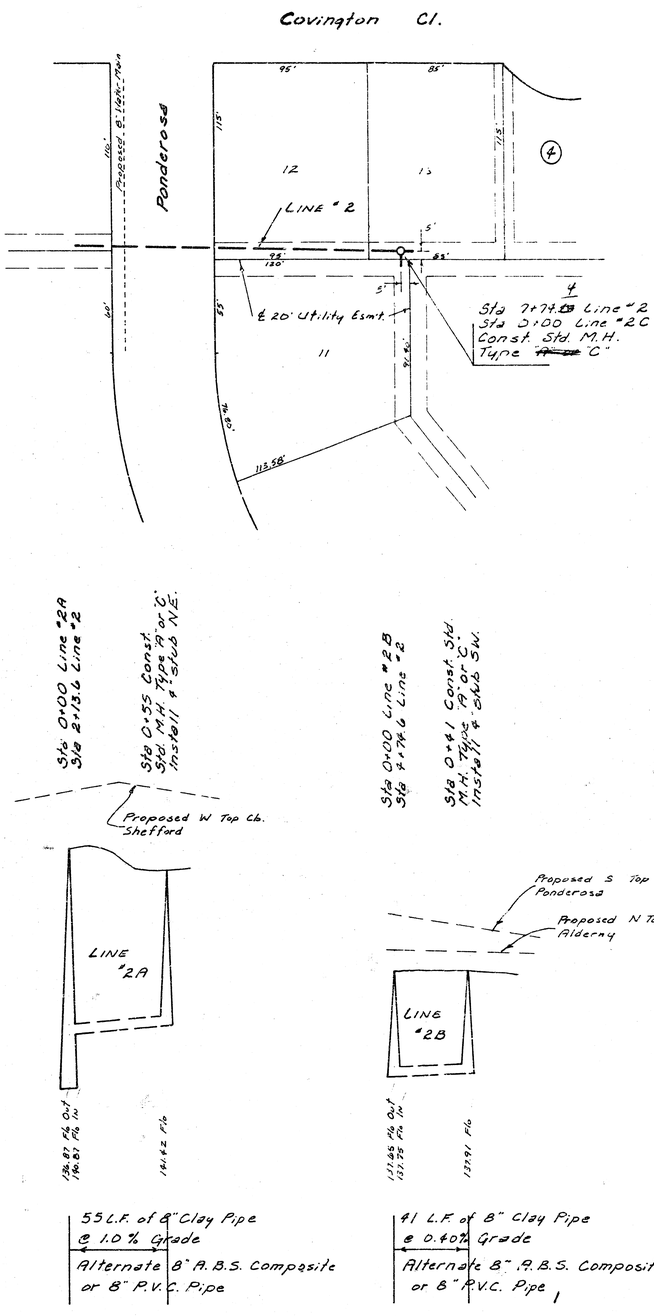



Lot 4, Main 12, SWI
468-76-295-80954-000-000-001

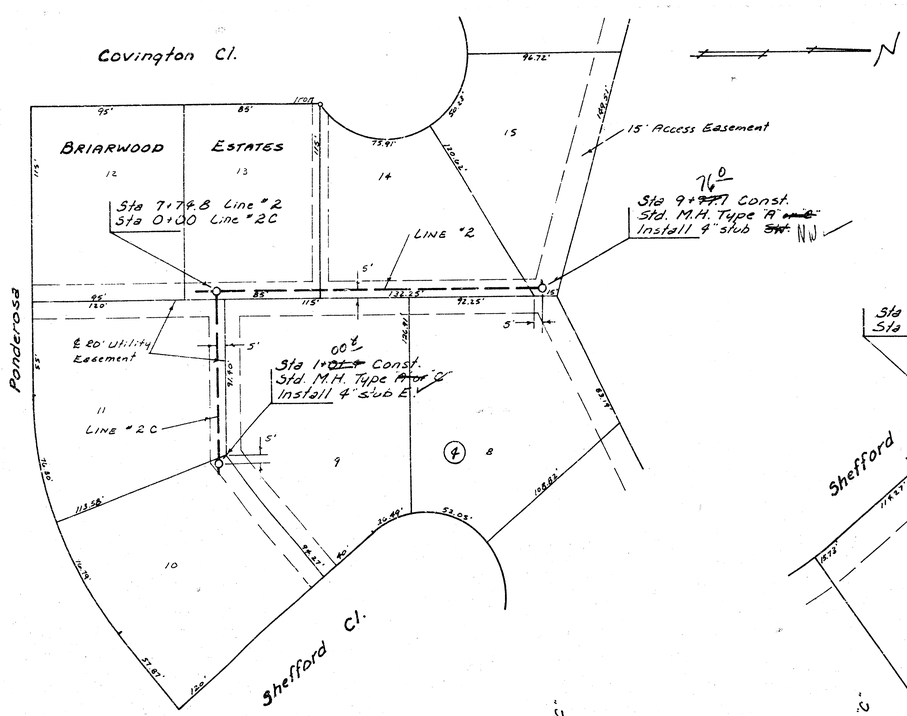

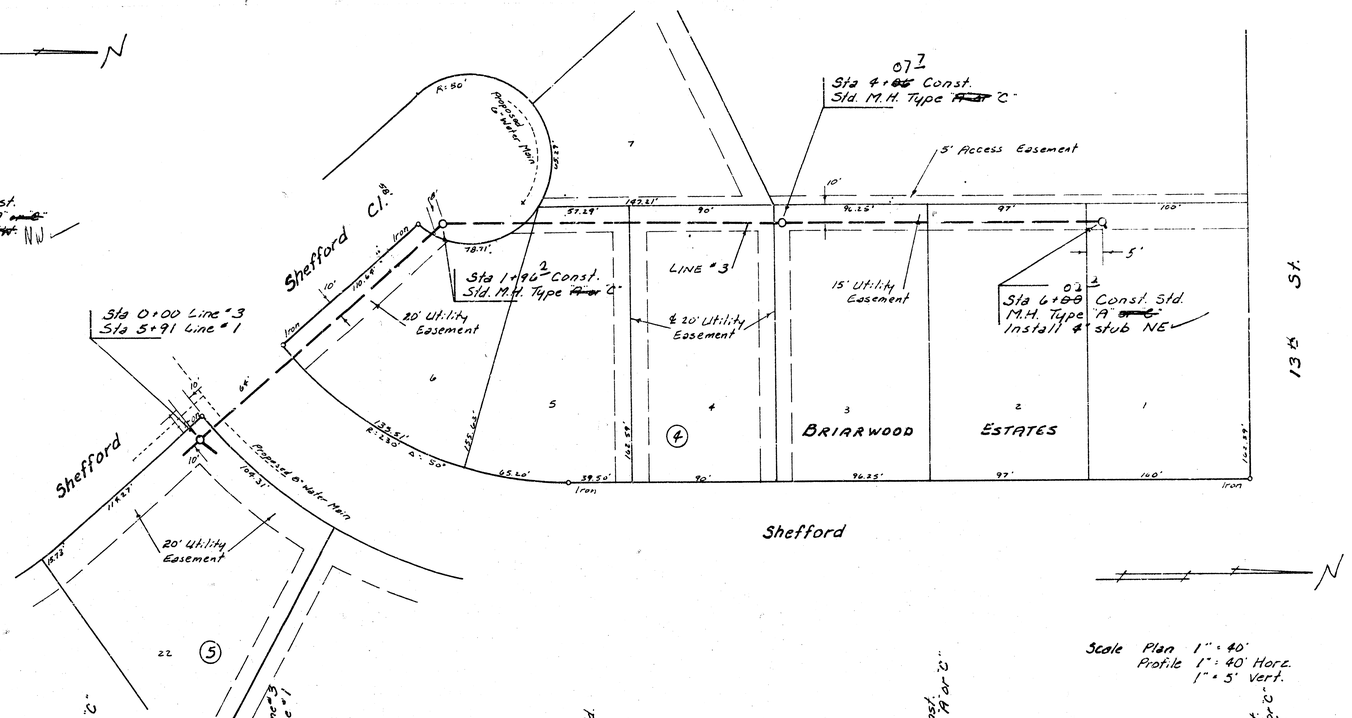

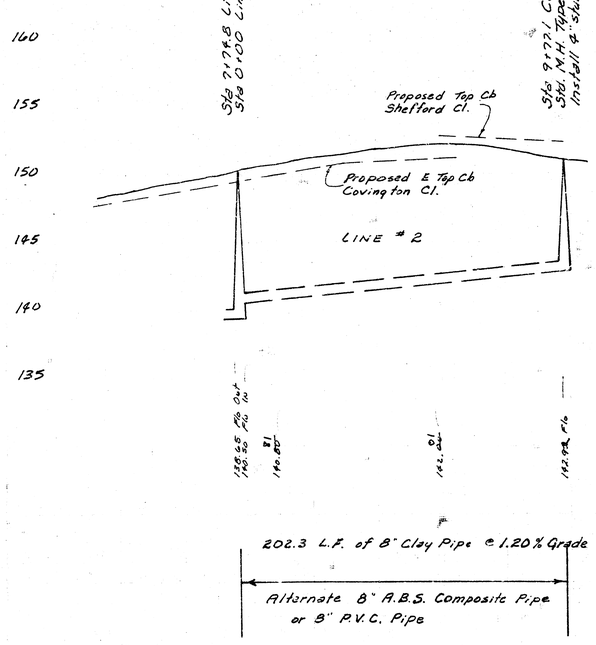

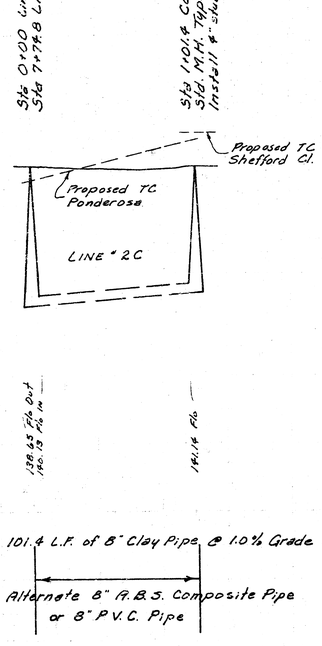


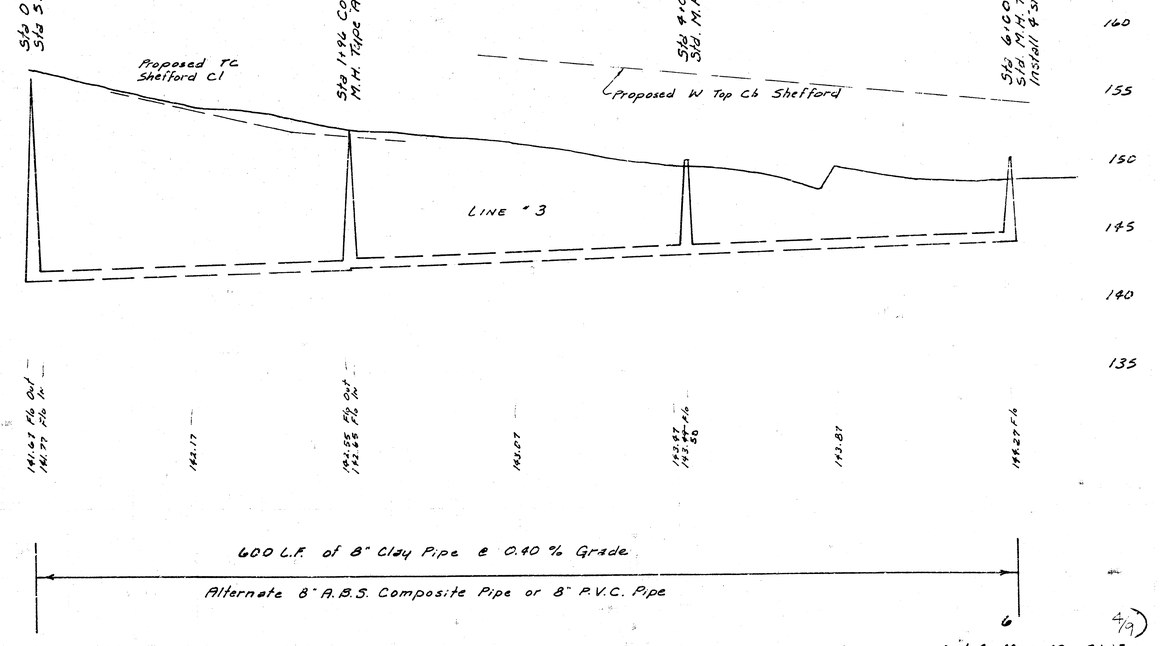

Scale Plan 1" = 40'
Profile 1" = 40' Horz.
1" = 5' Vert.

4/9


Lot 4, Main 12, SWI
468-76-265-80954-000-000-001

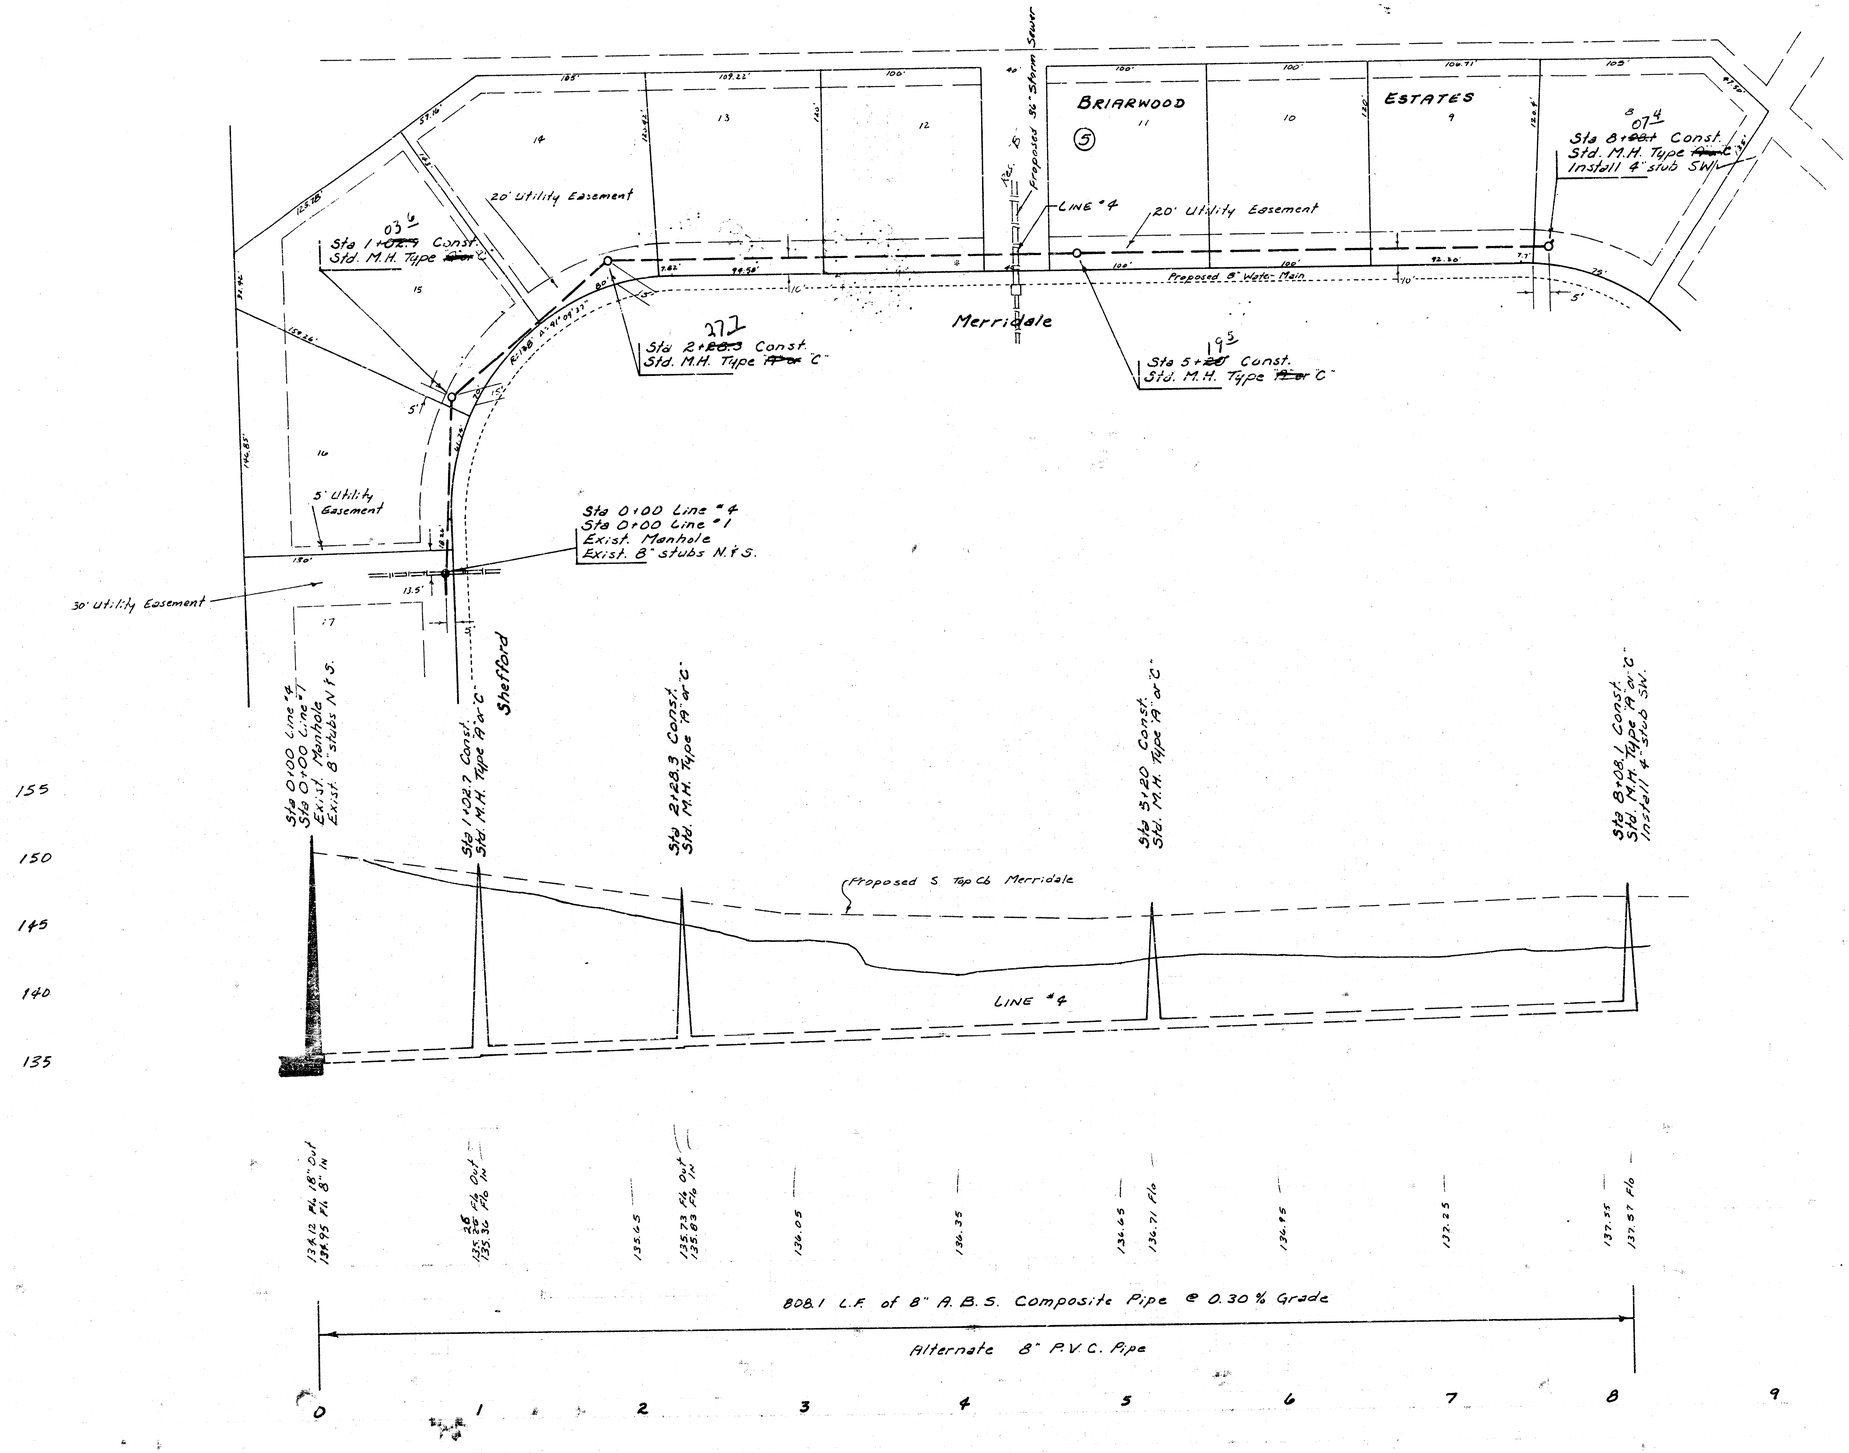


Scale Plan 1"=40'
Profile 1"=40' Horz.
1"=5' Vert.

Lot 4, Main 12, SWJ
418-76-245-80954-000-000-001

FILMED FROM THE BEST

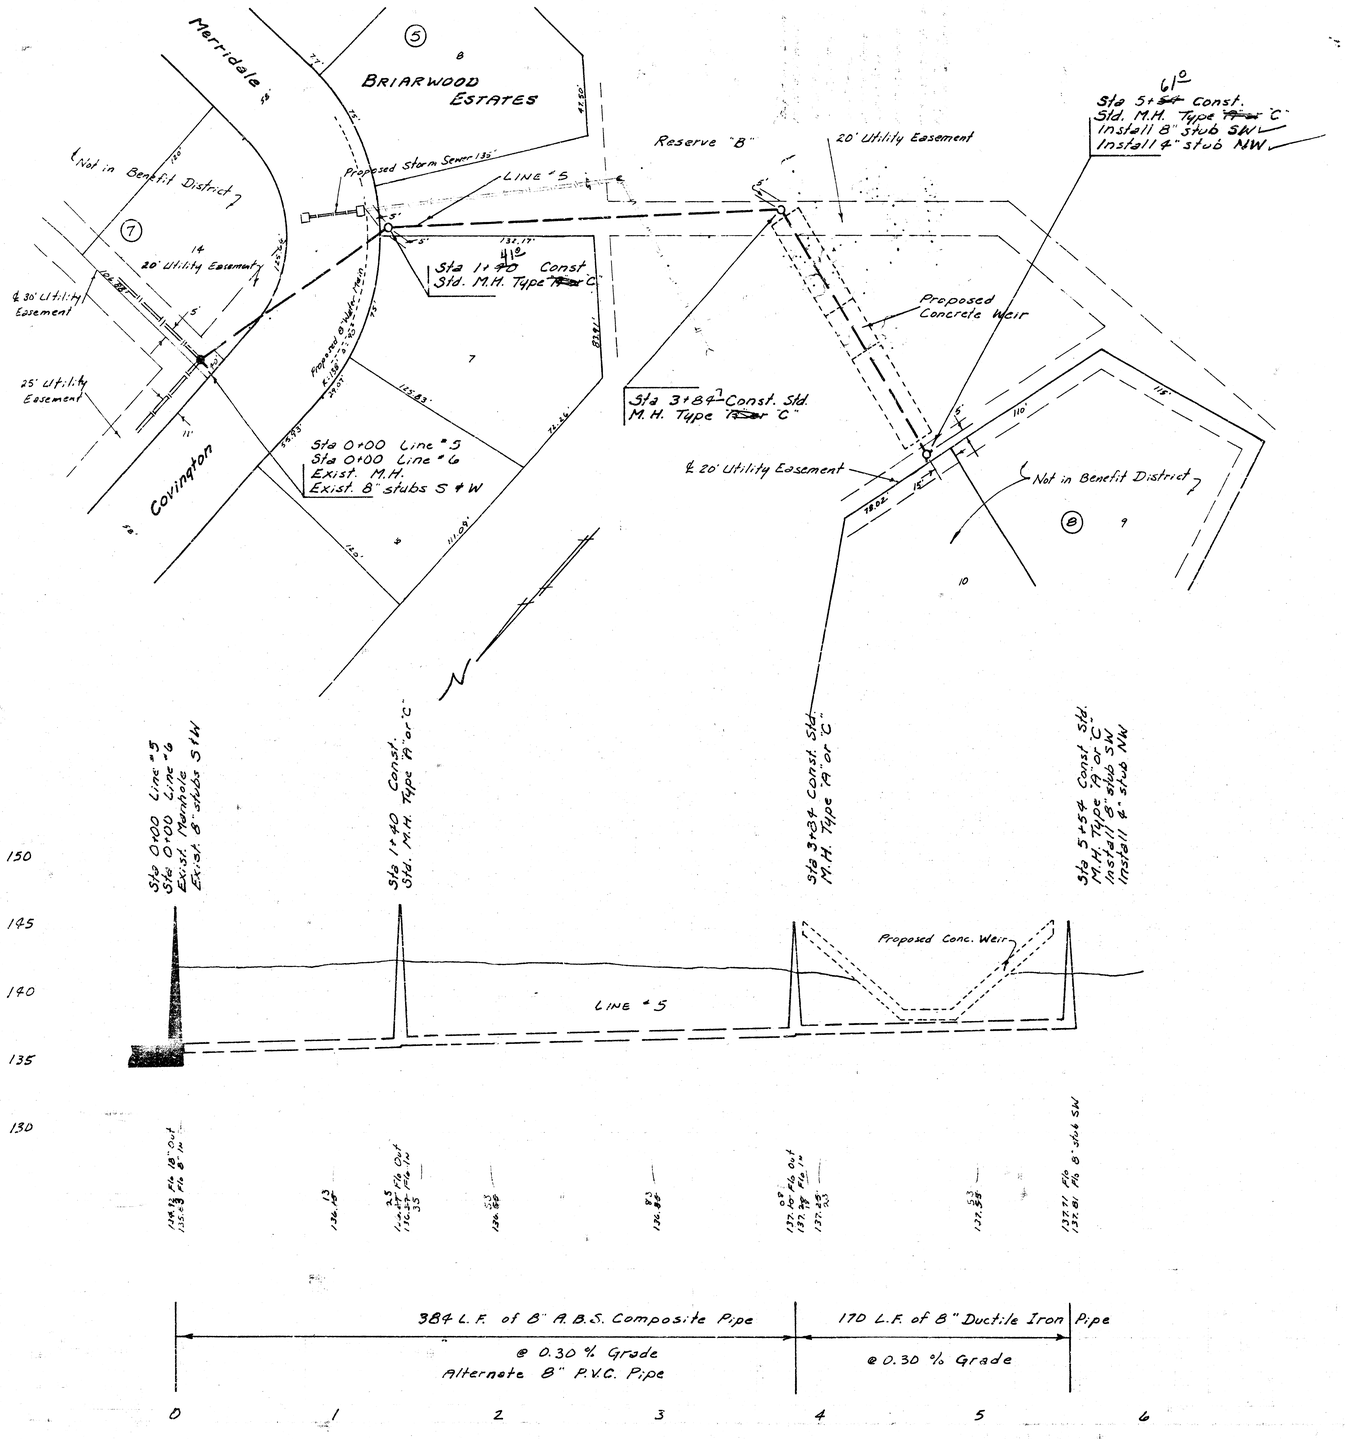


Scale Plan 1" = 40'
Profile 1" = 40' Horz.
1" = 5' Vert.

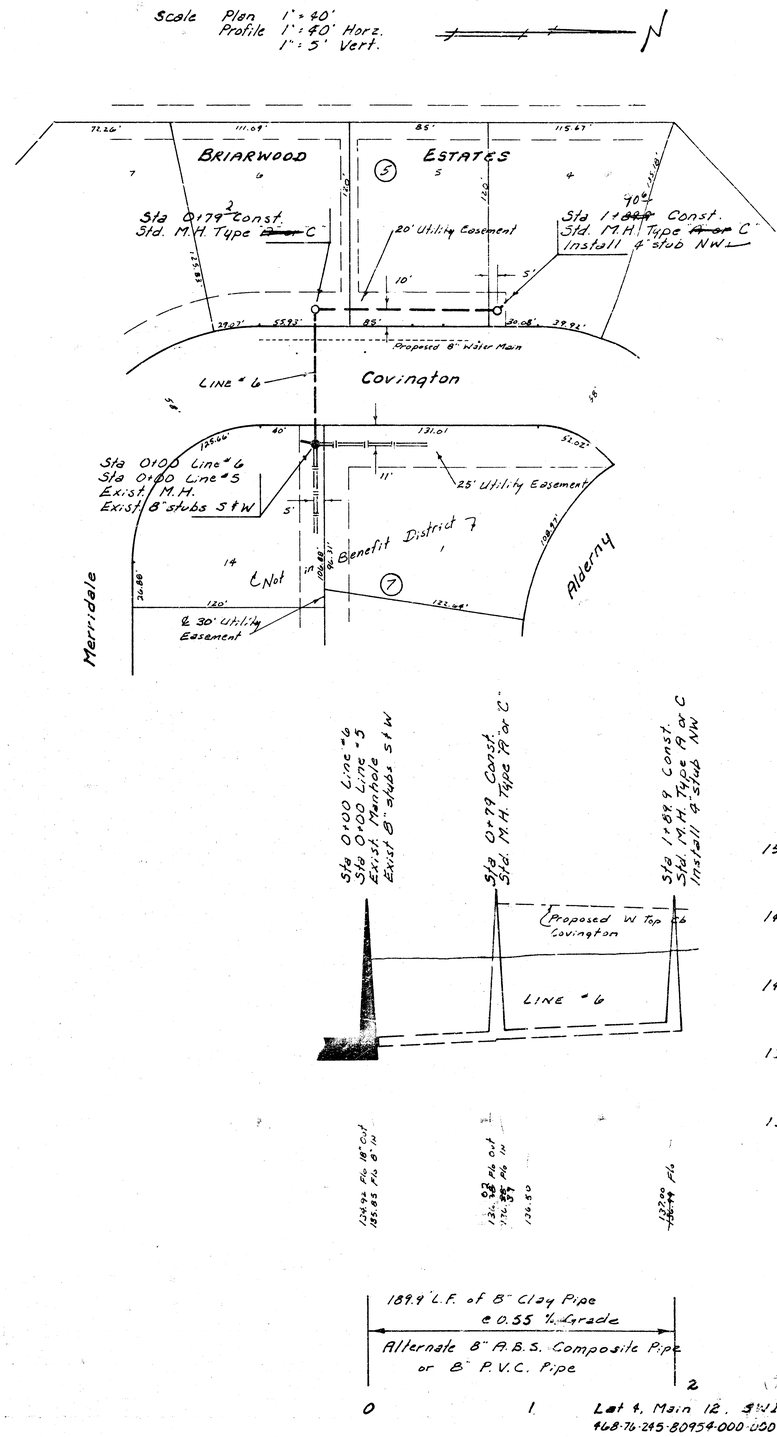

Lot 4, Main 12, 3N1
468-76-245-80954-000-000-001

FILMED FROM THE BEST AVAILABLE COPY


Scale Plan 1" = 40'
Profile 1" = 40' Horz.
1" = 5' Vert.

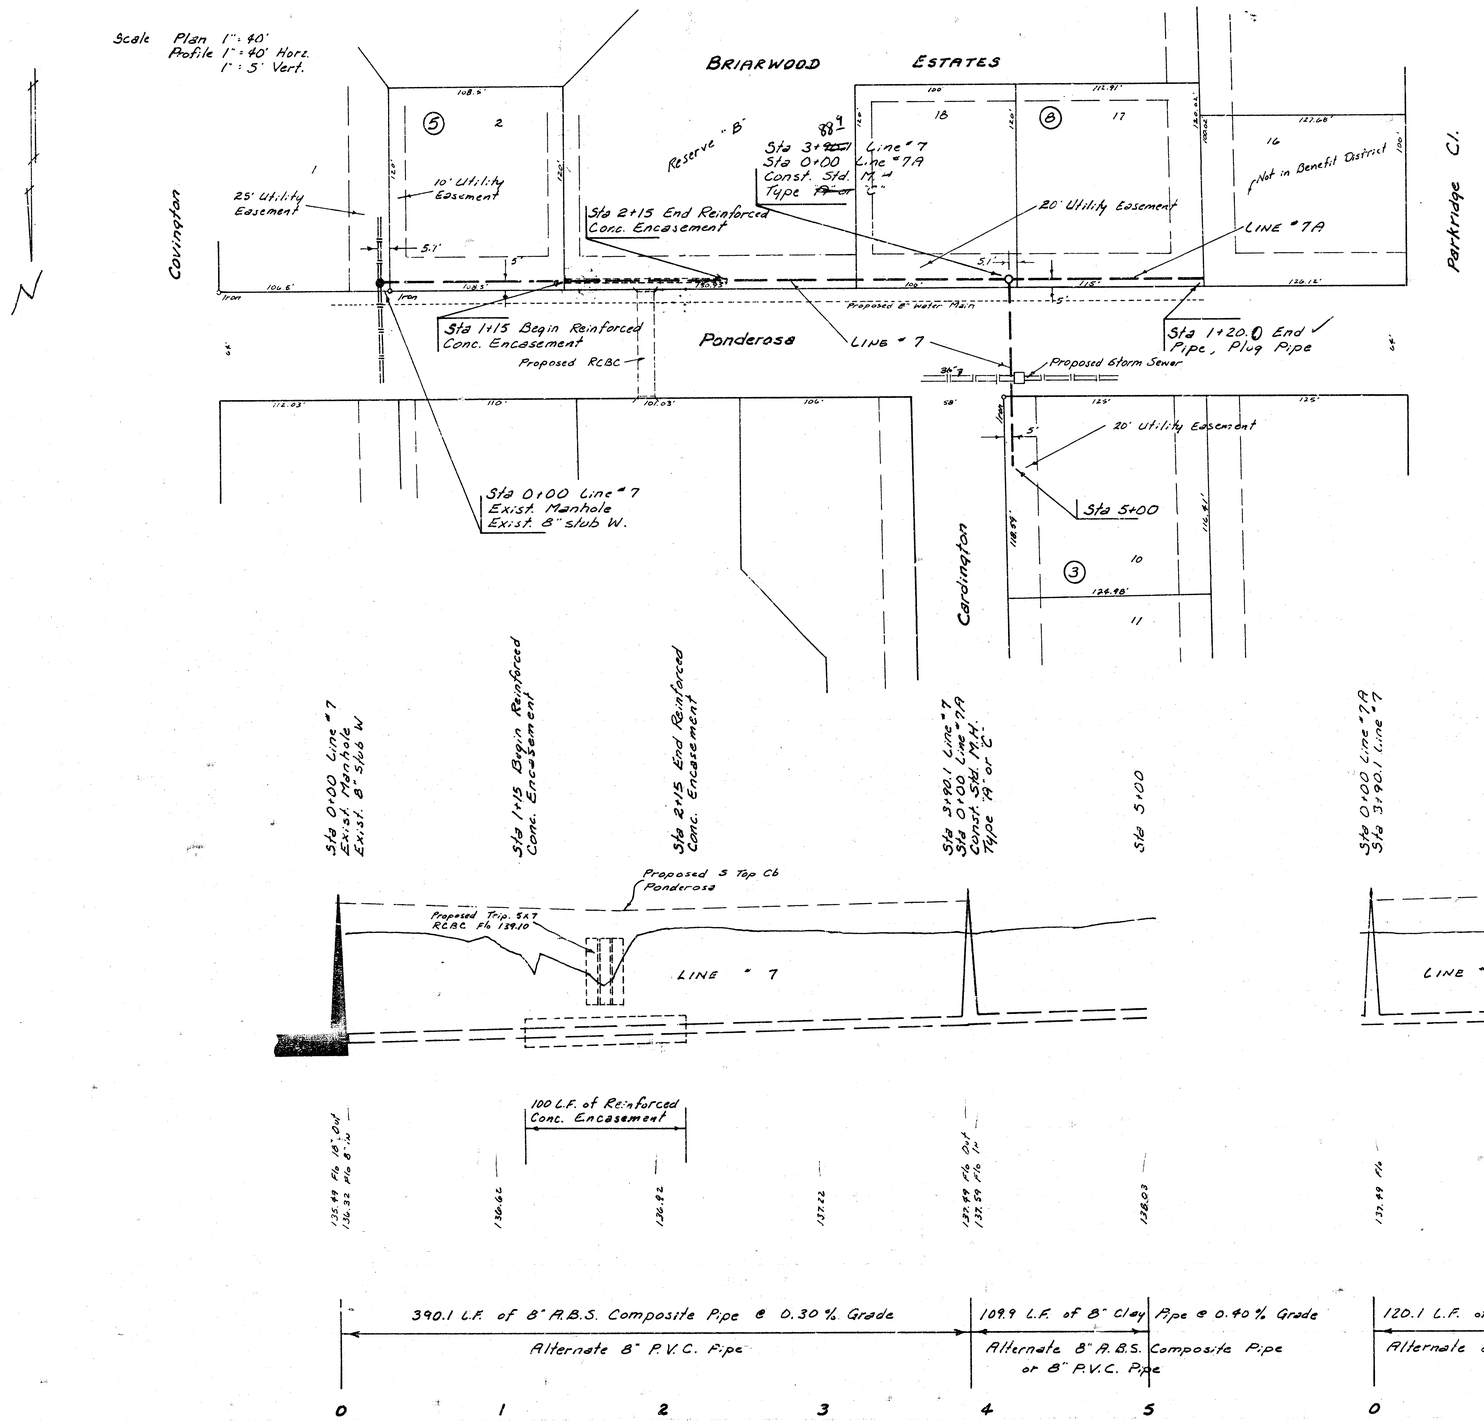



Lot 9, Main 12, SWI
468-76-245-80954-000-000-001


FILMED FROM THE BEST

Scale Plan 1" = 40'
Profile 1" = 40' Horz.
1" = 5' Vert.

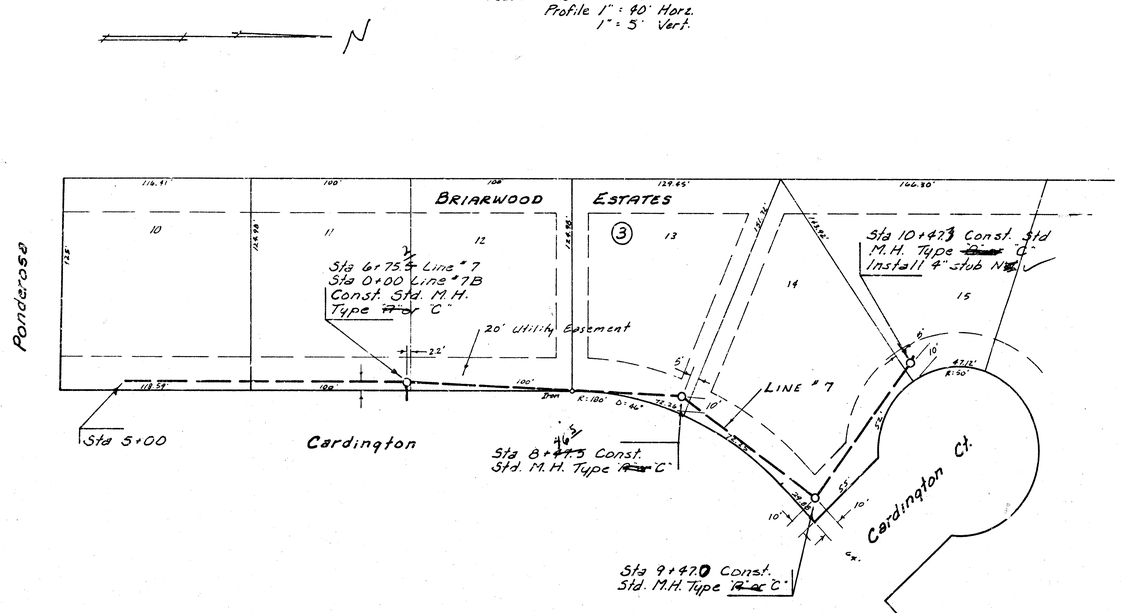

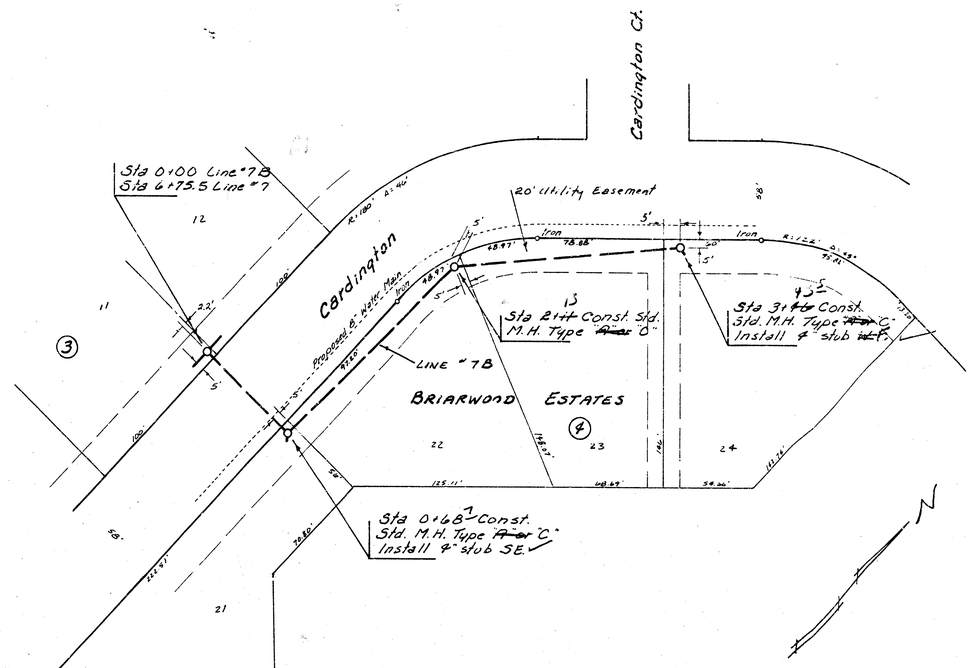


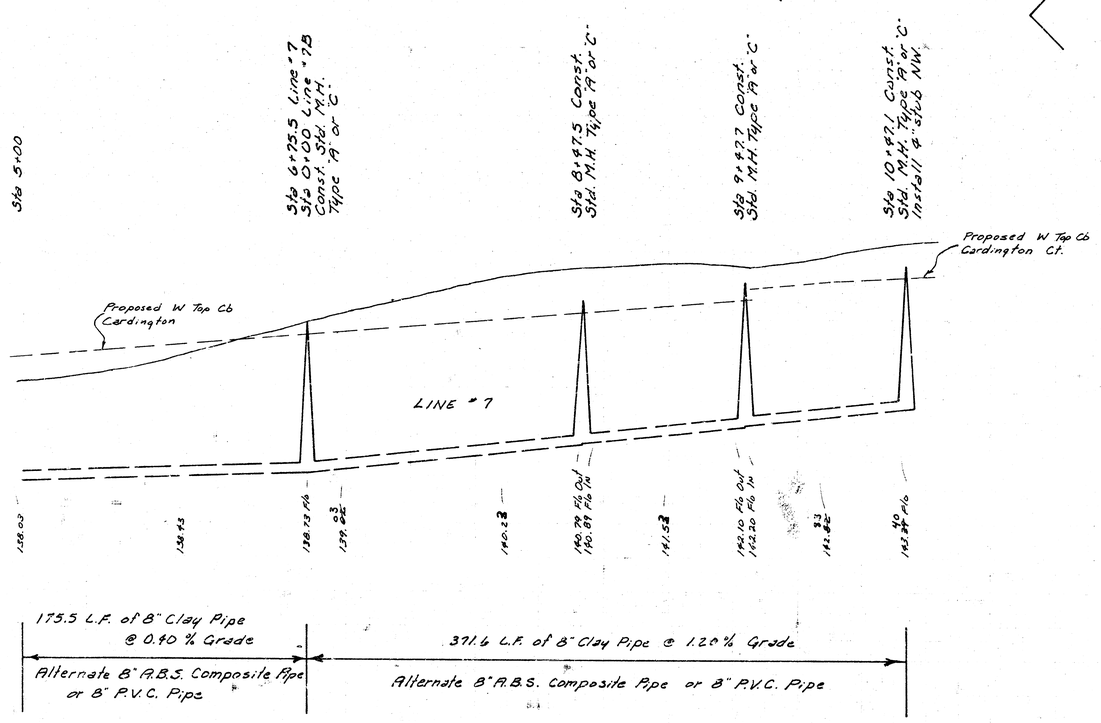

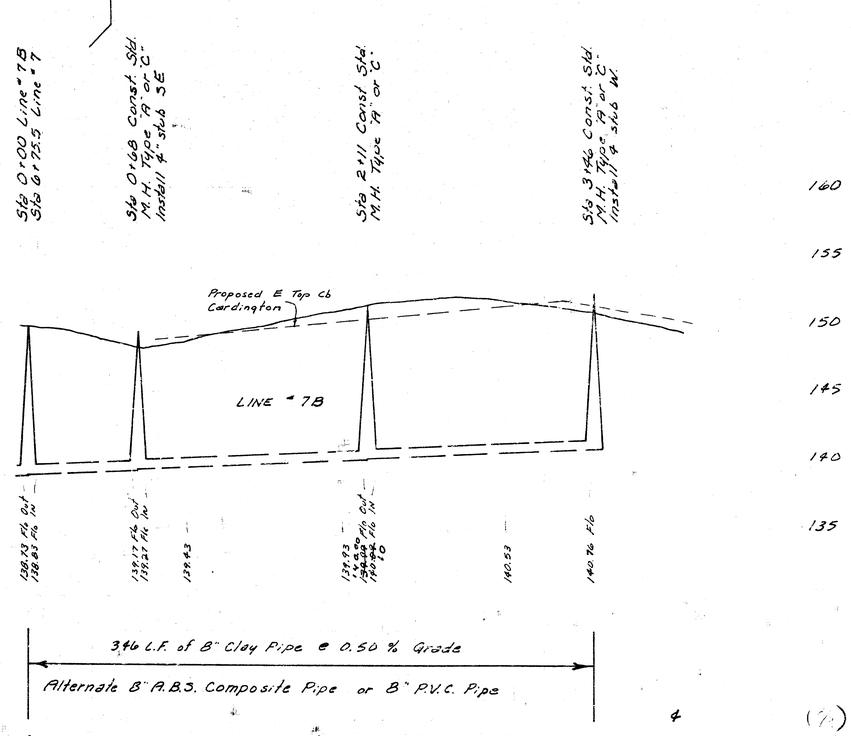

(7)

Lot 4, Main 12, SW1
468-76-245-80954-000-000-001

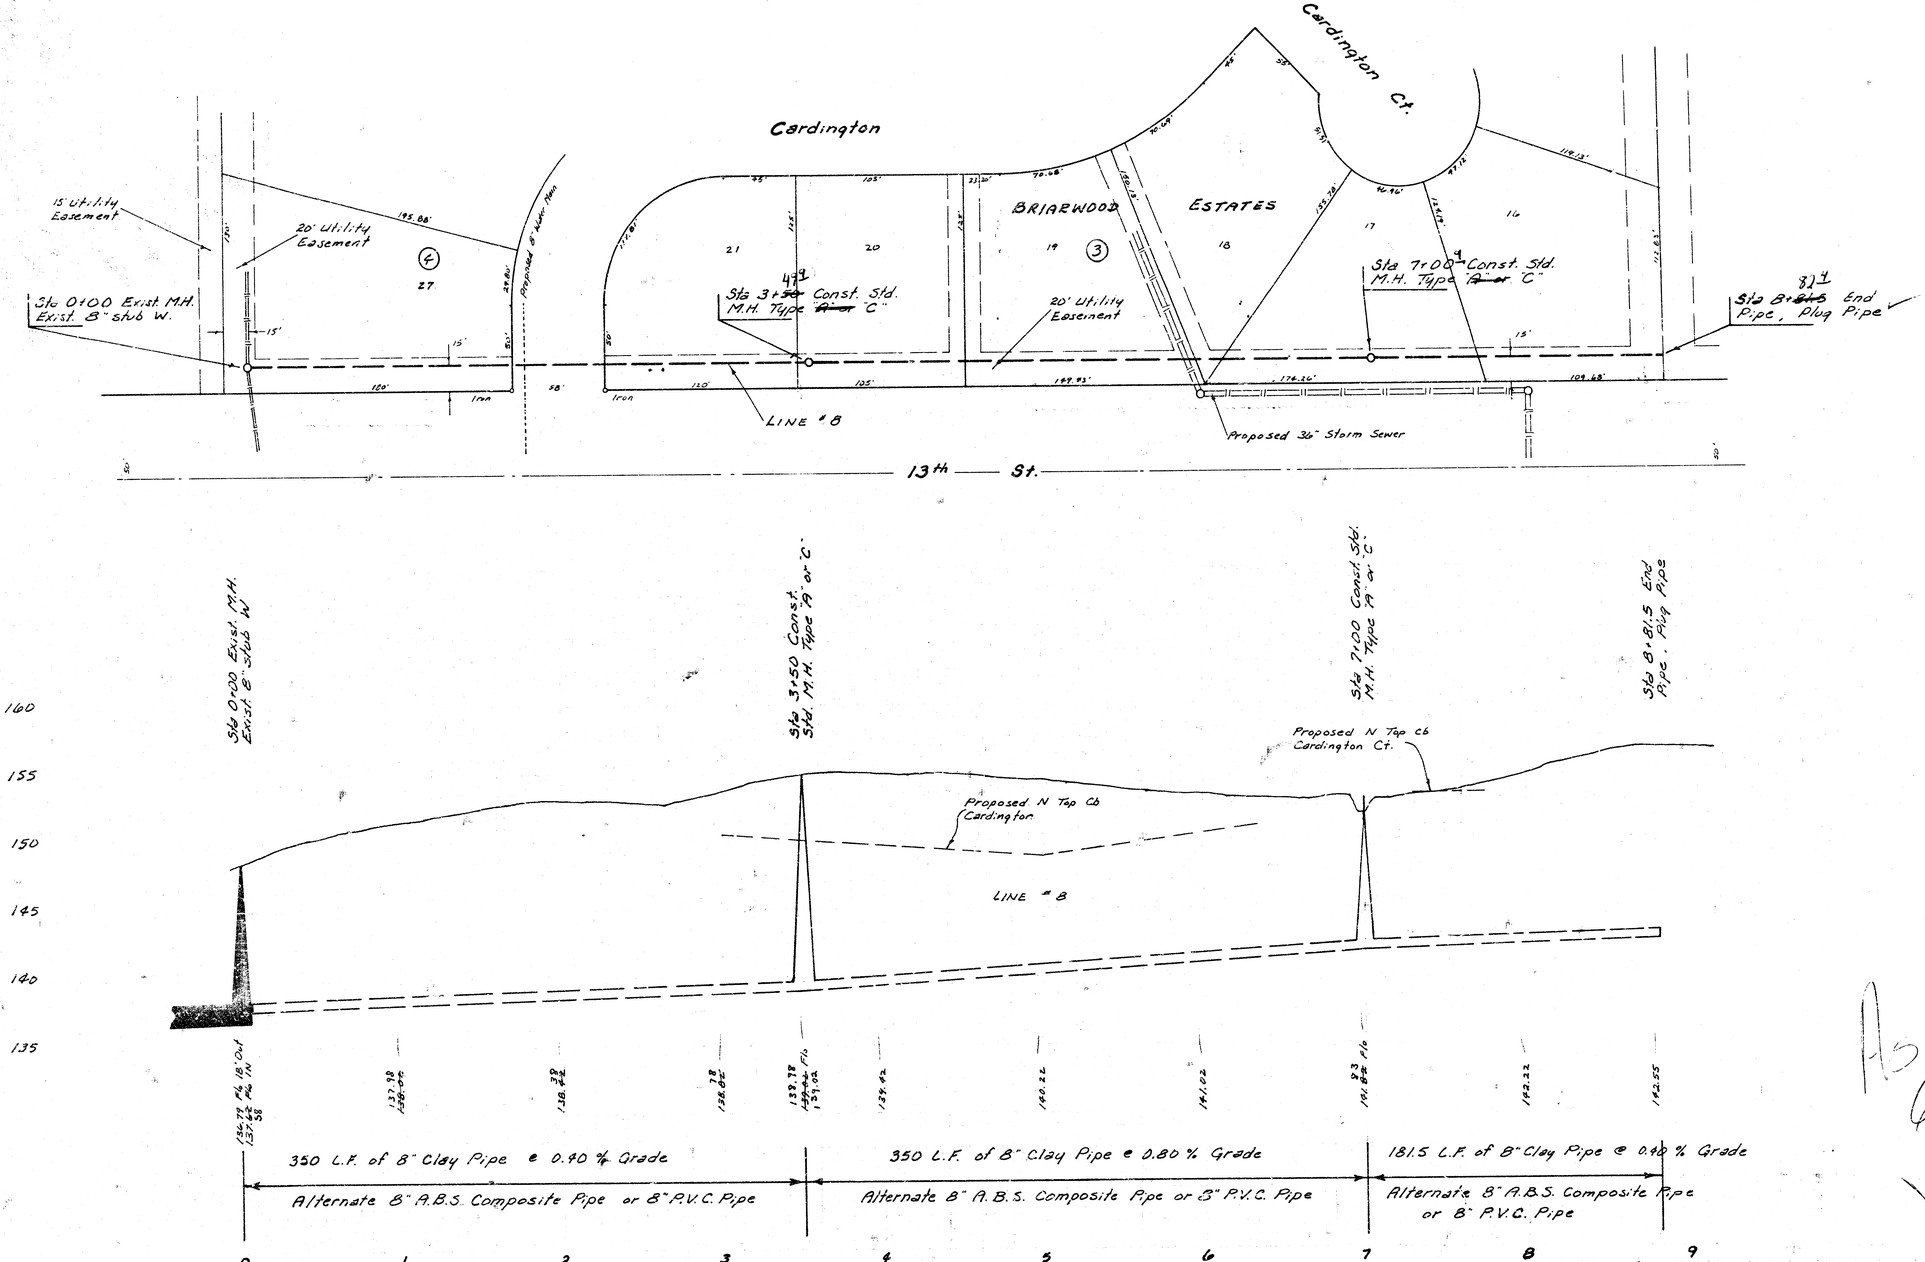

Scale Plan 1" = 40'
Profile 1" = 40' Horz.
1" = 5' Vert.

As Built
6/6/

Lot 4, Main 12, SWI
468-16-245-80954-000-000-001