

CONFORMED TO CONSTRUCTION RECORDS

PLANS FOR

SEWERAGE IMPROVEMENTS

WICHITA, KANSAS


SOUTHWEST INTERCEPTOR


CONTRACT NO. 1


PROJECT NO. 2844


BLACK & VEATCH
CONSULTING ENGINEERS
KANSAS CITY, MISSOURI


1968

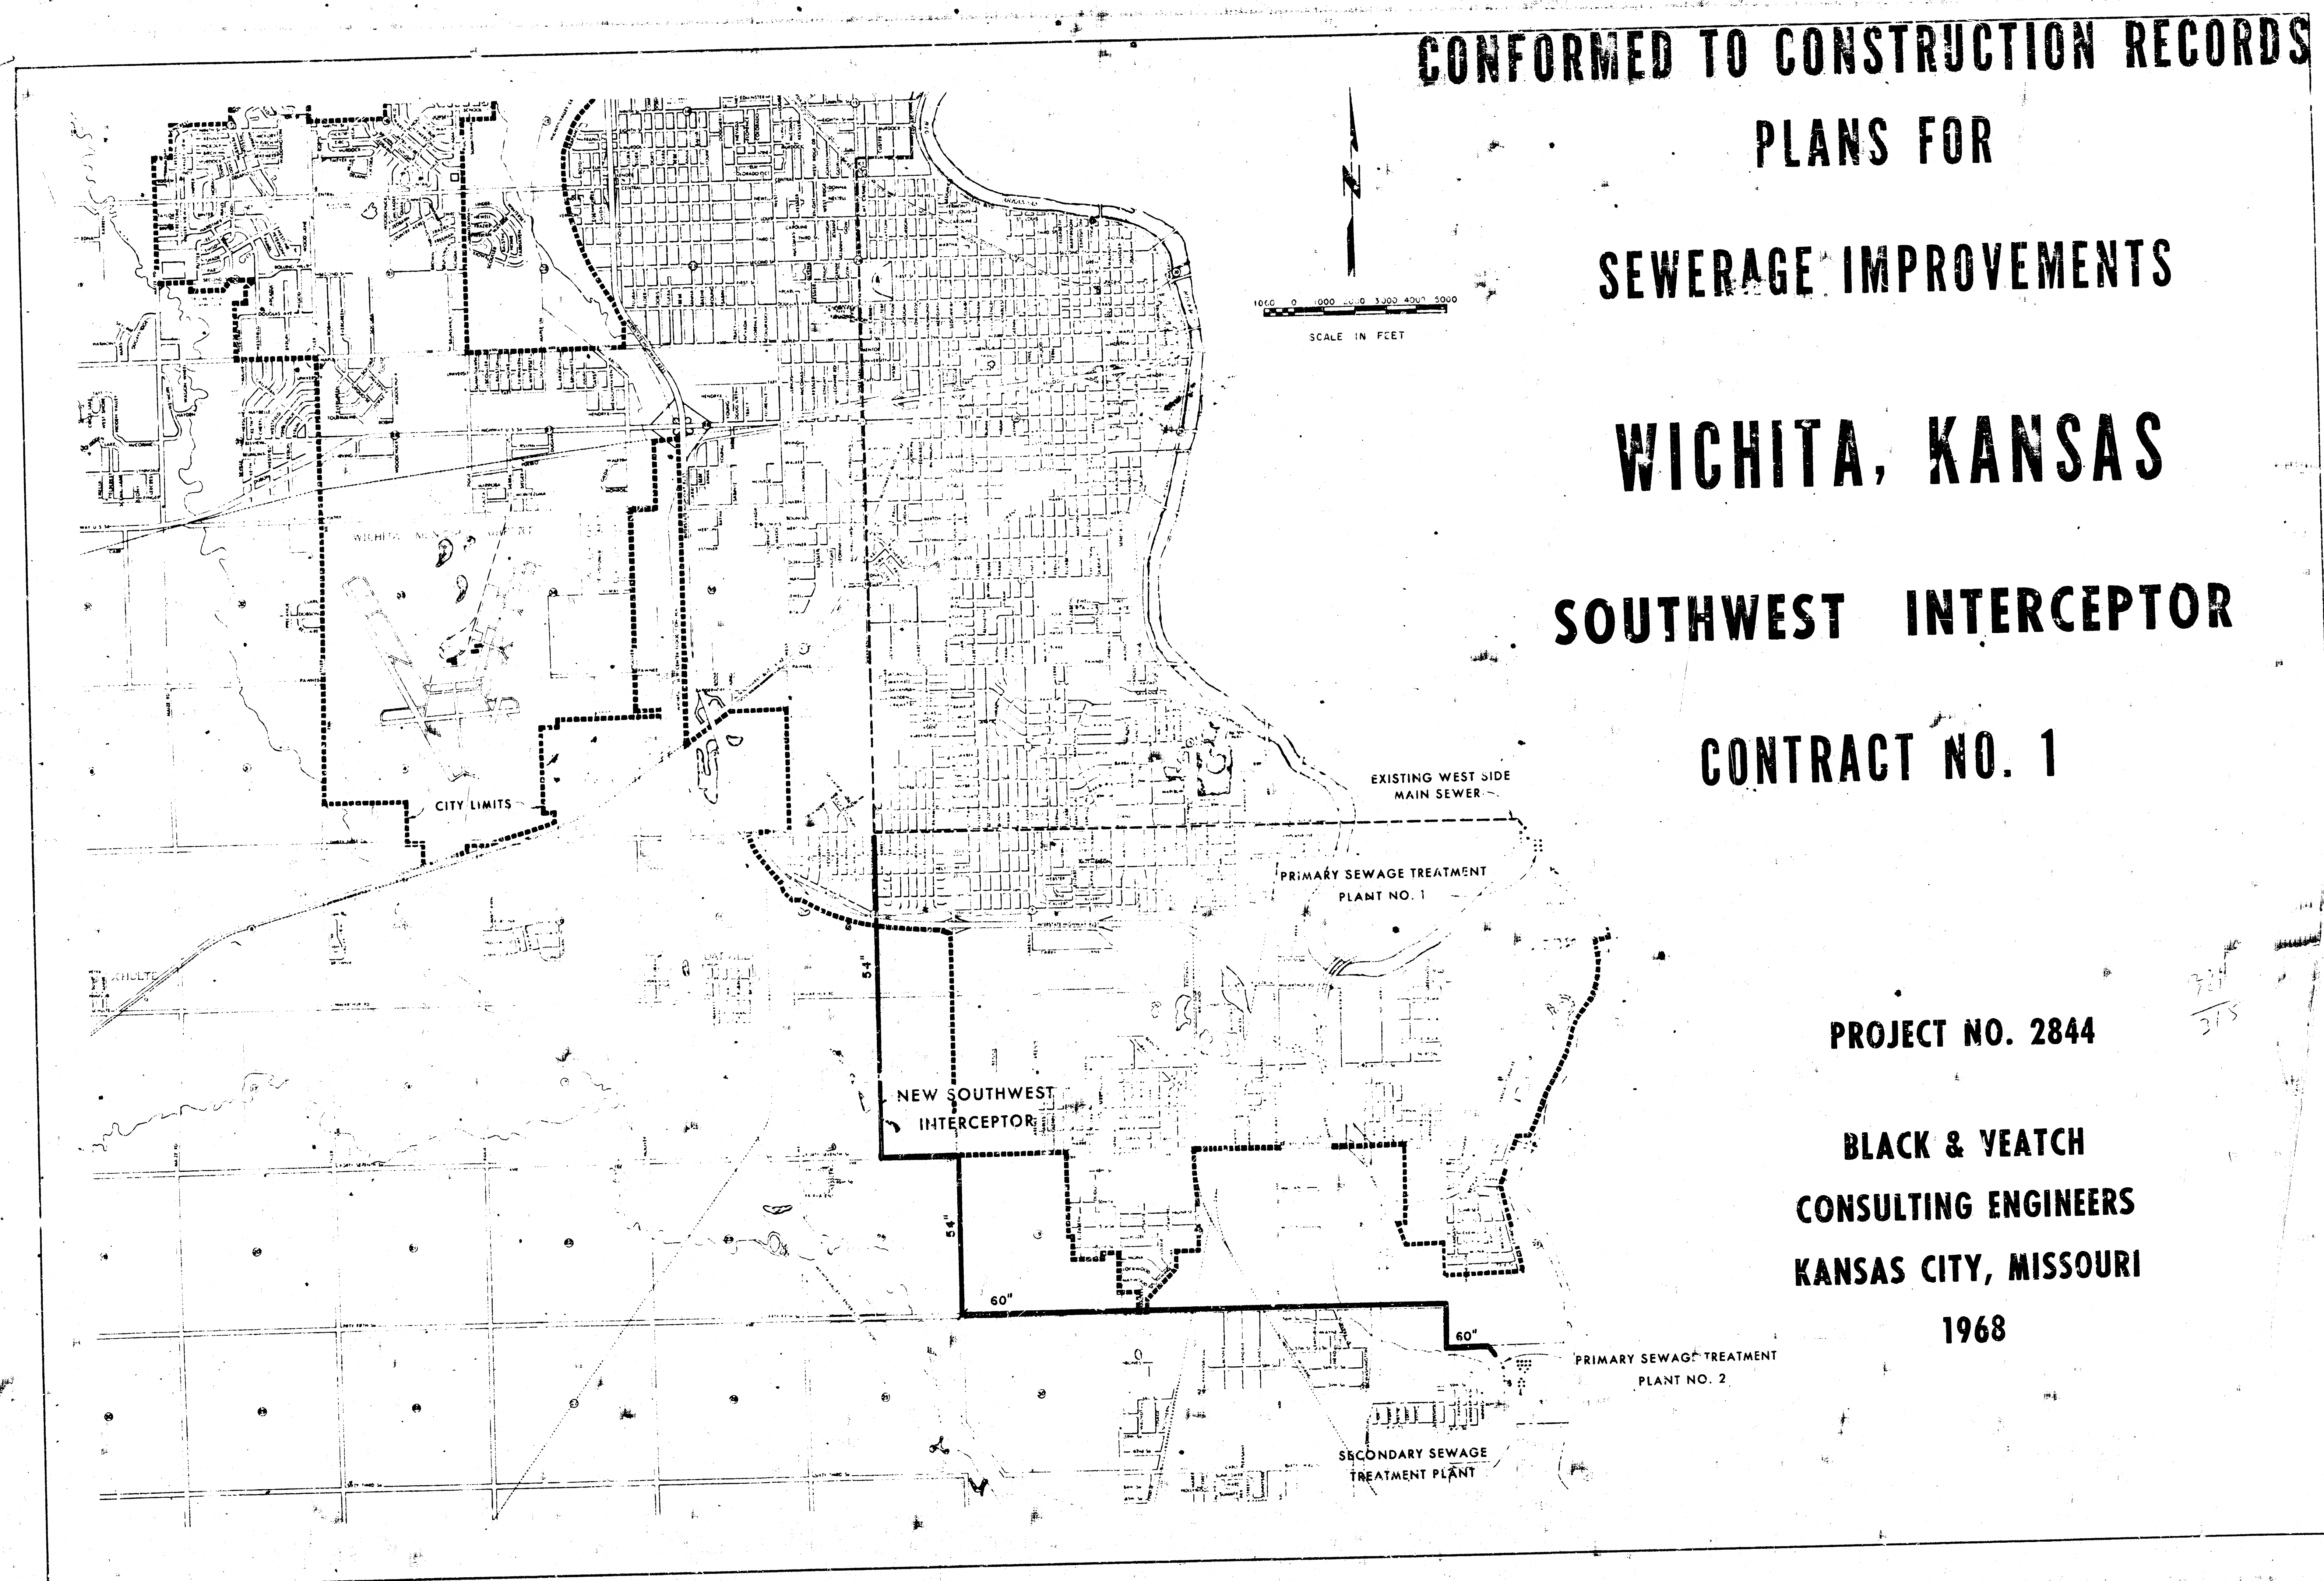


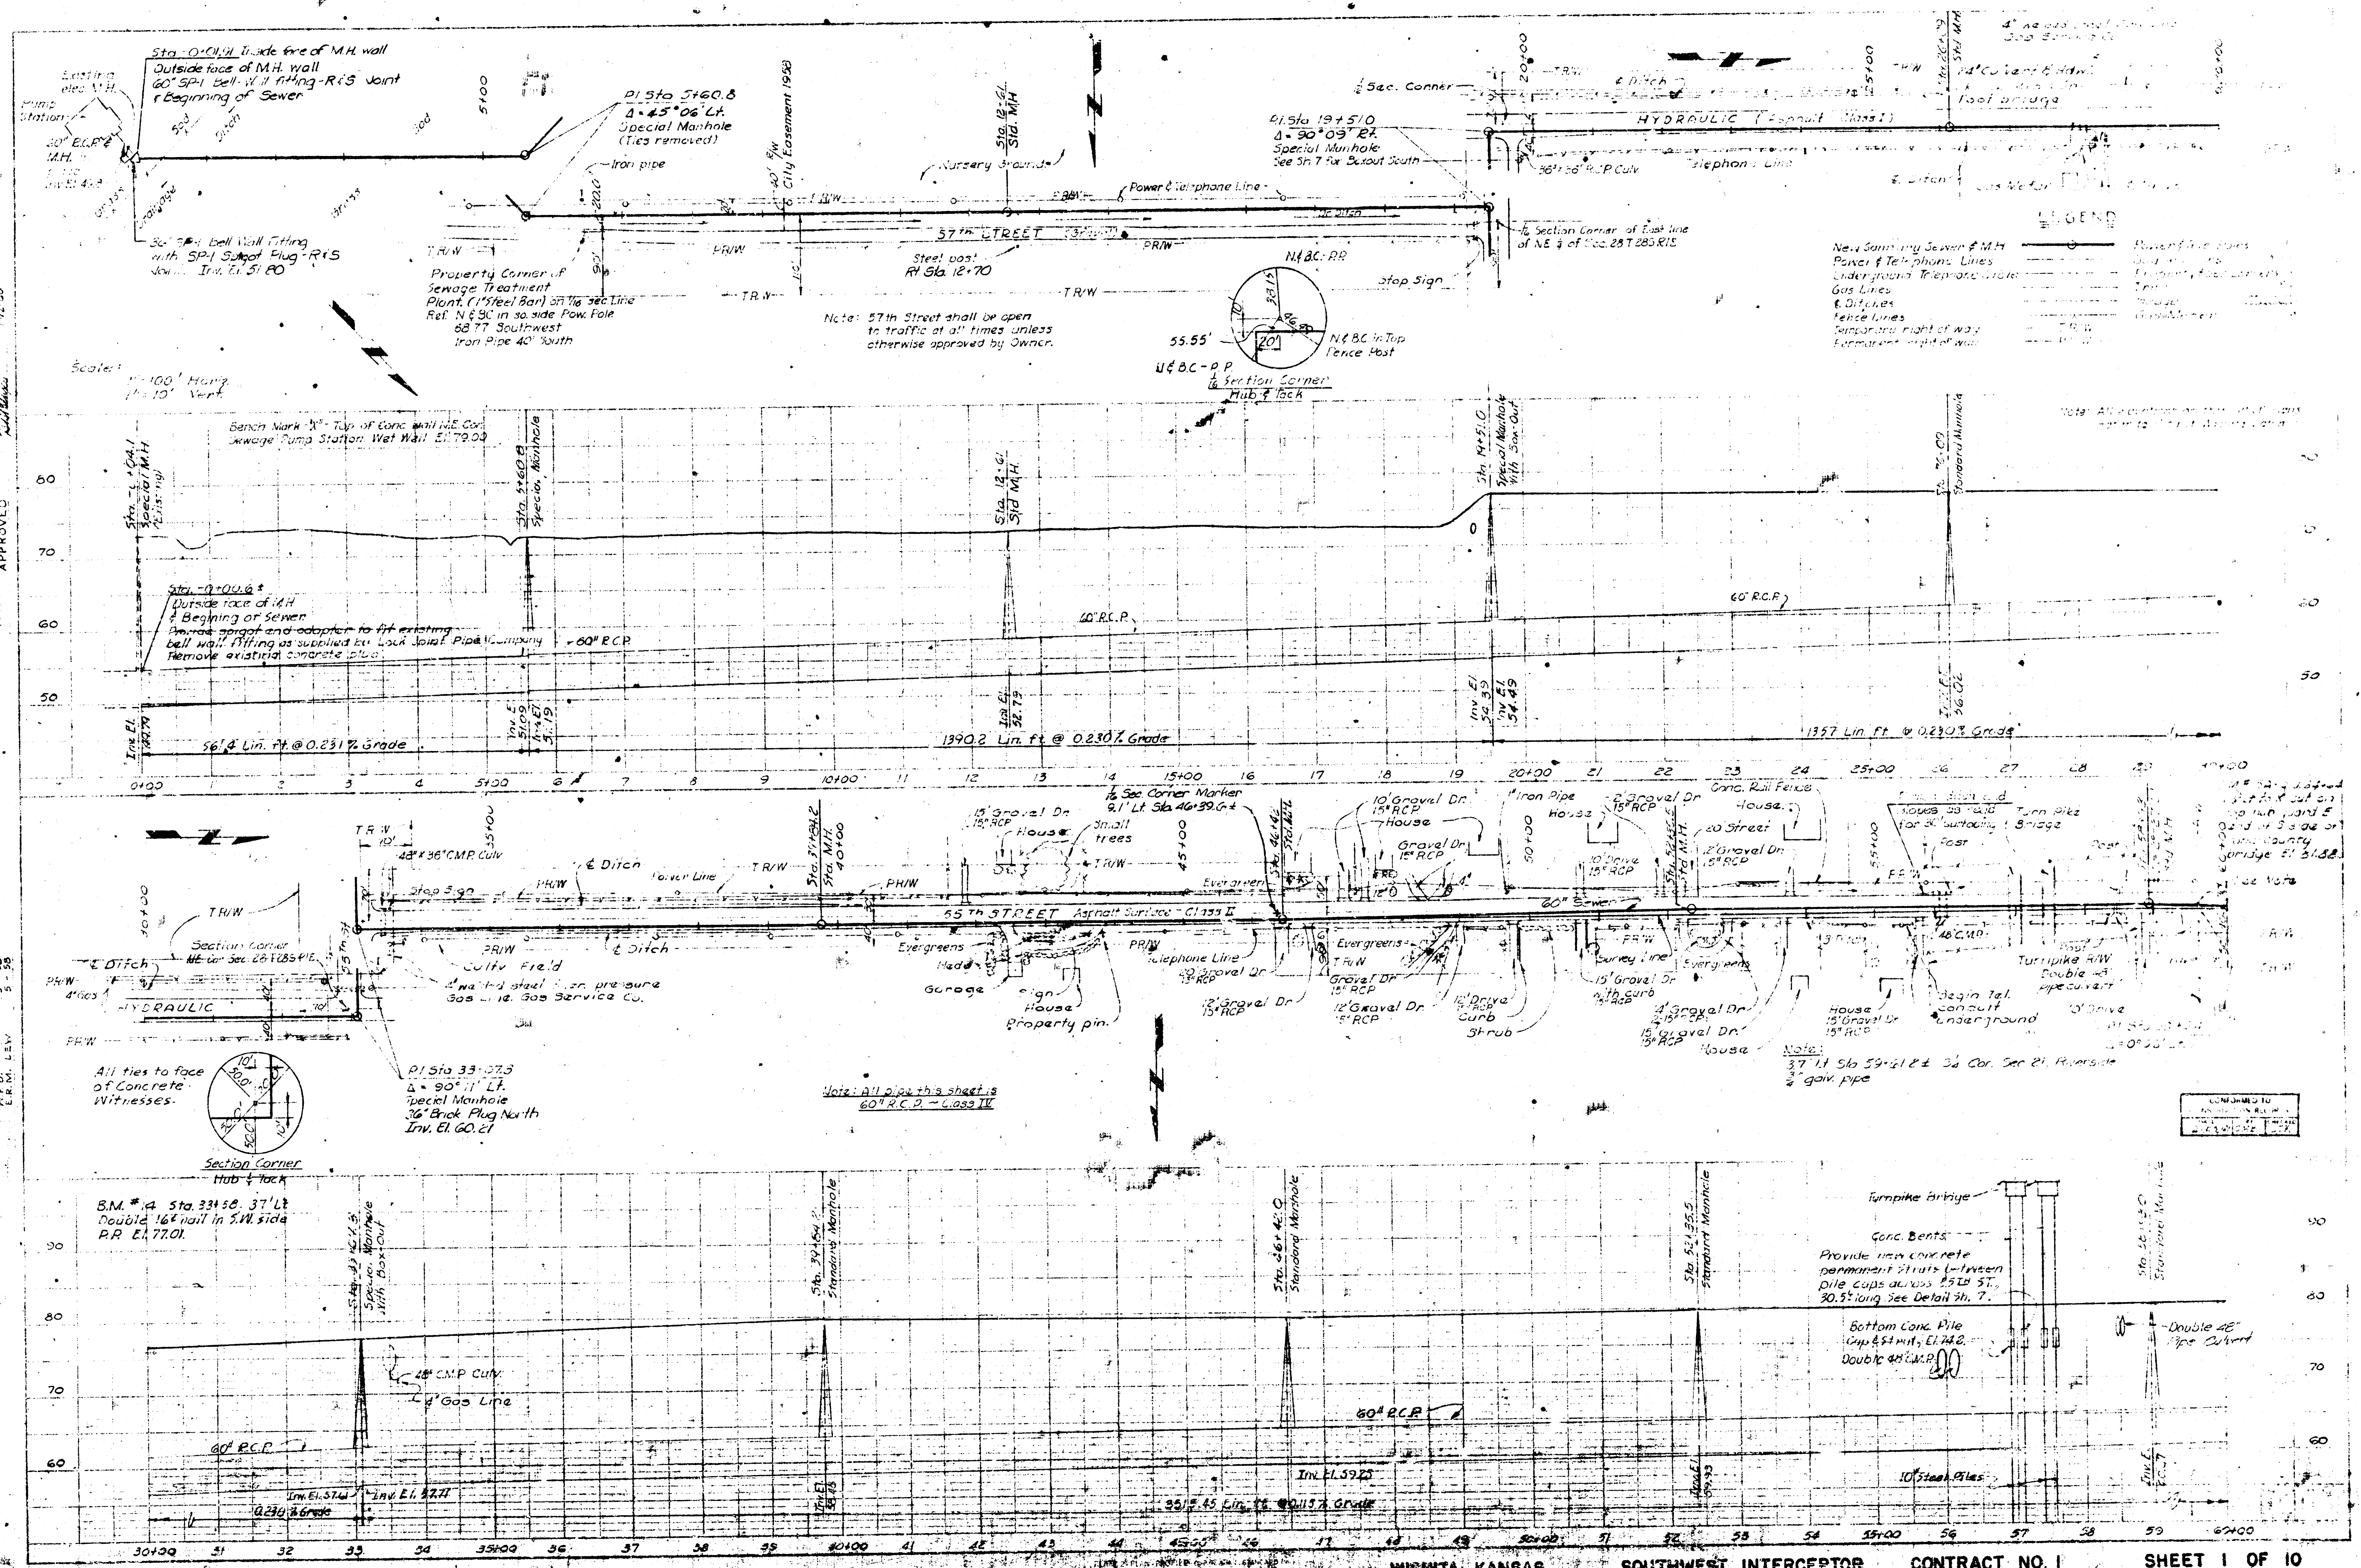

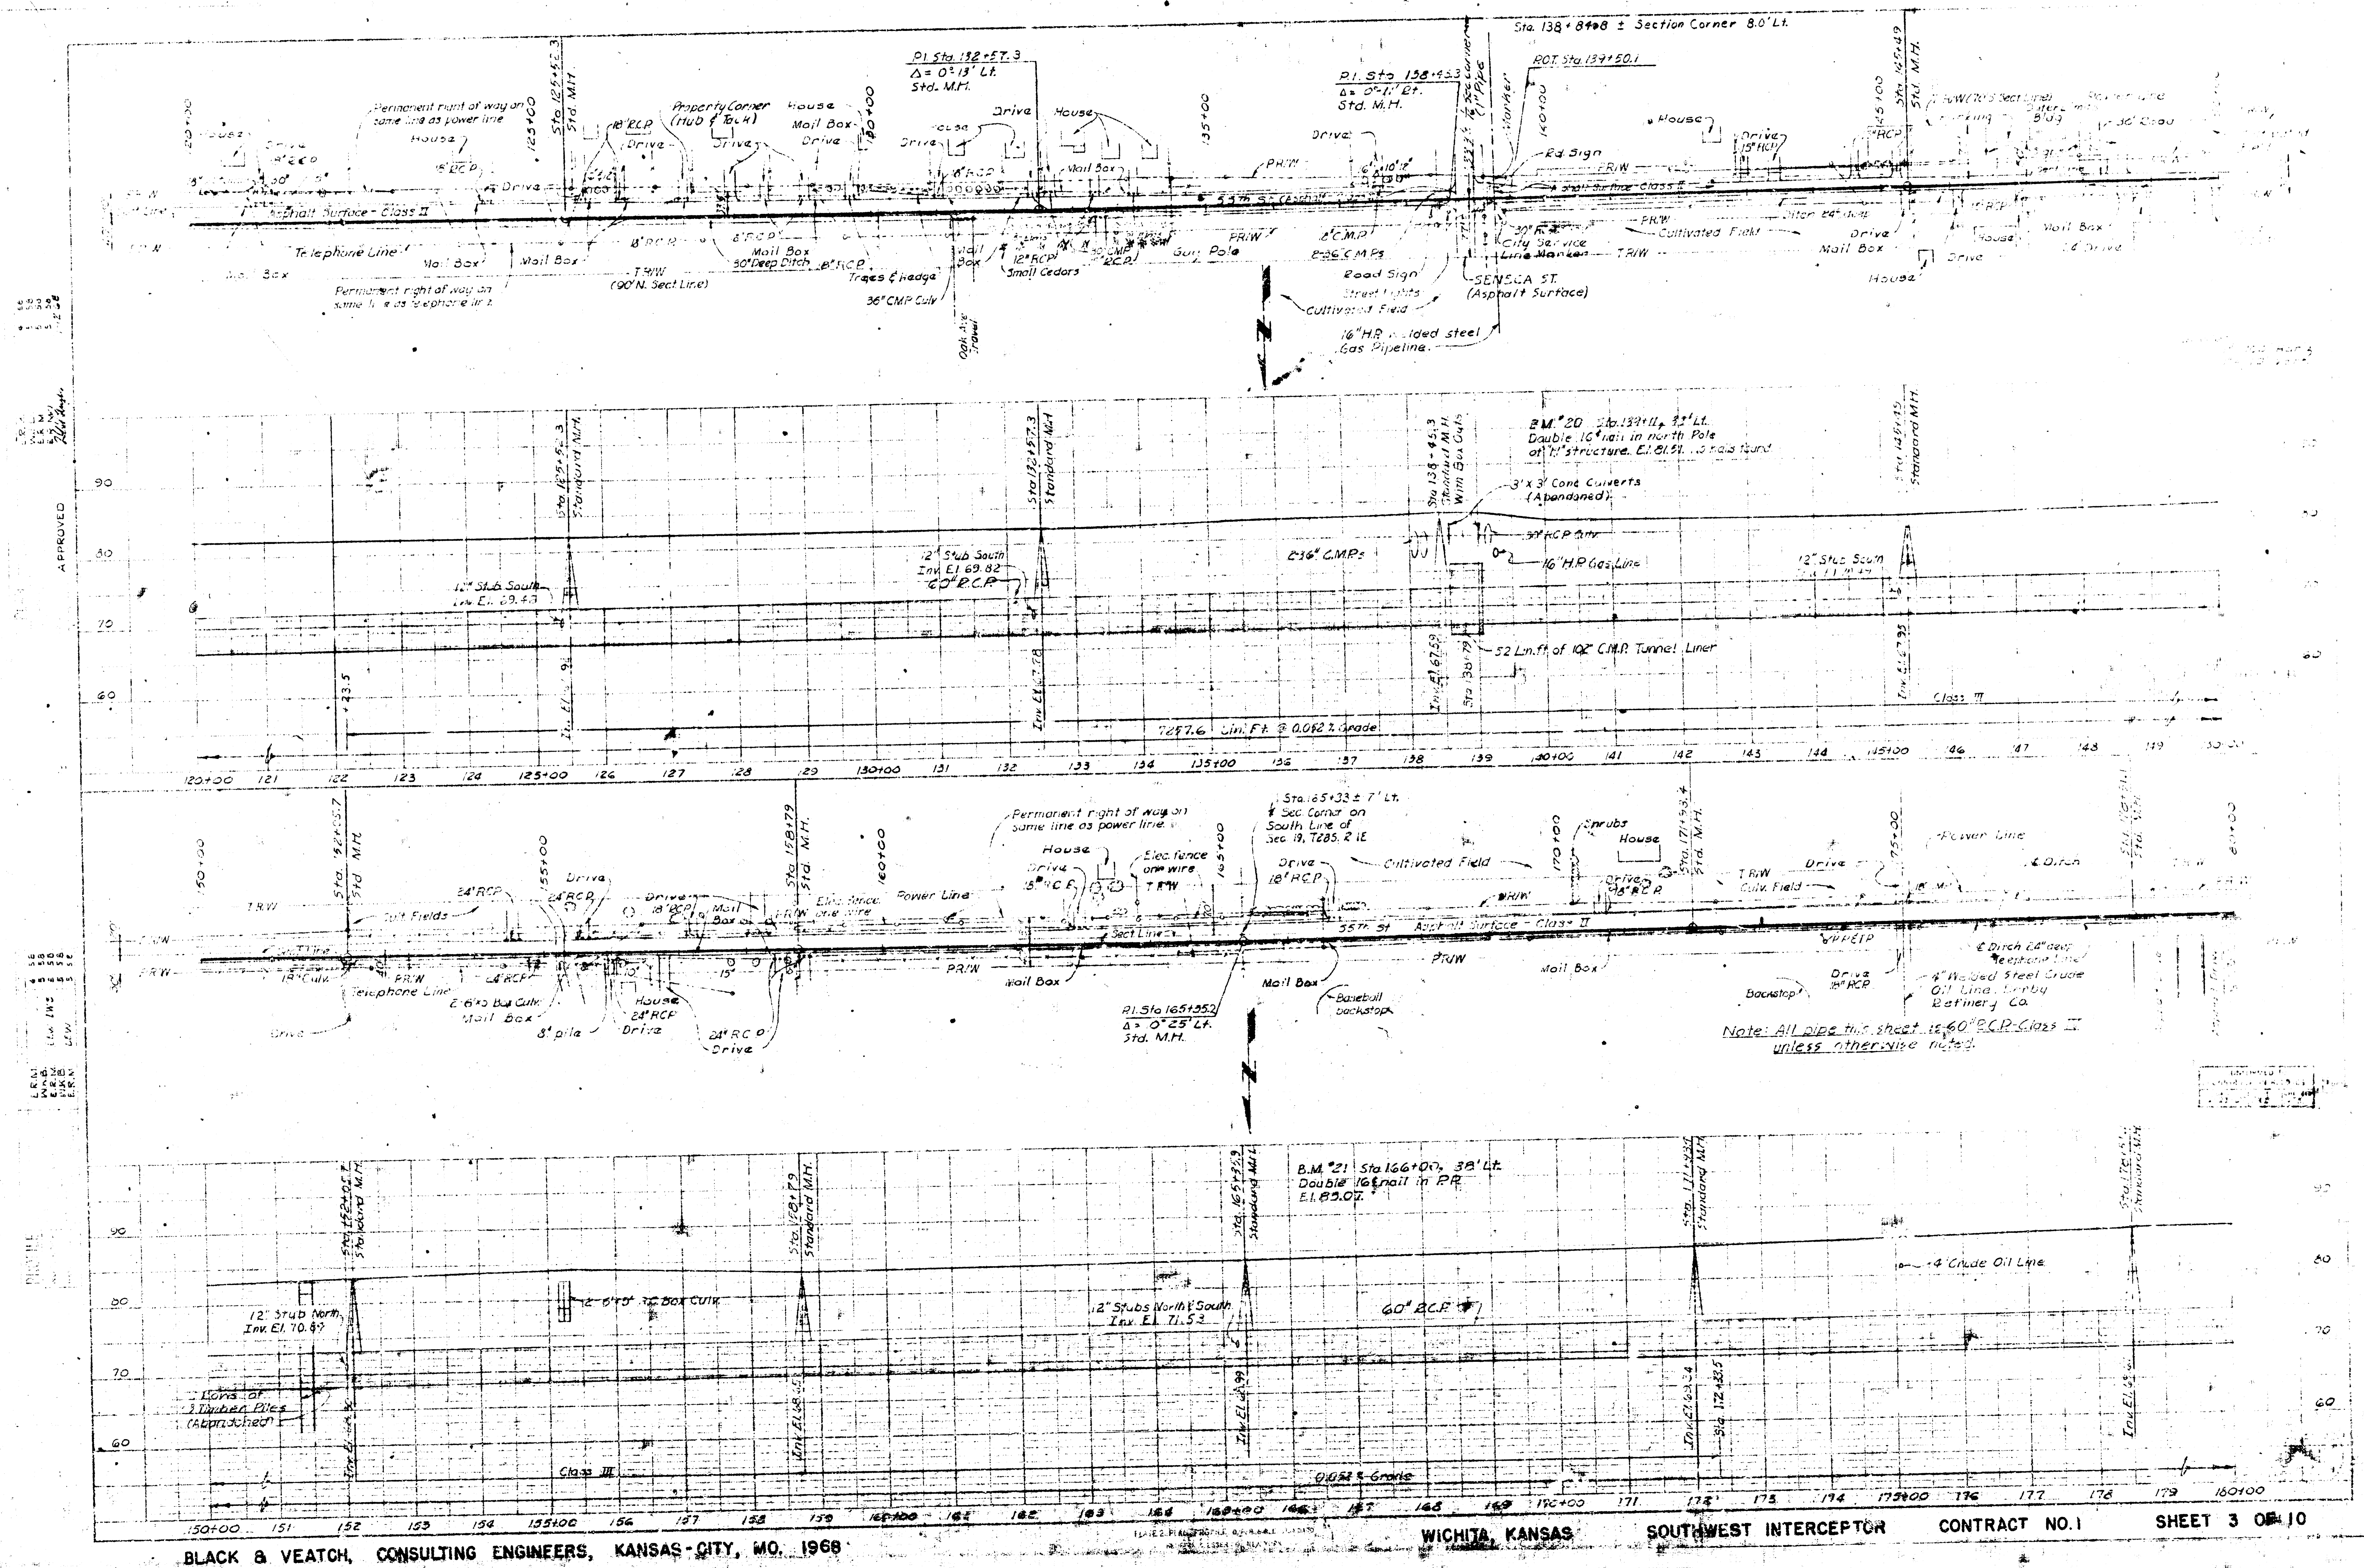

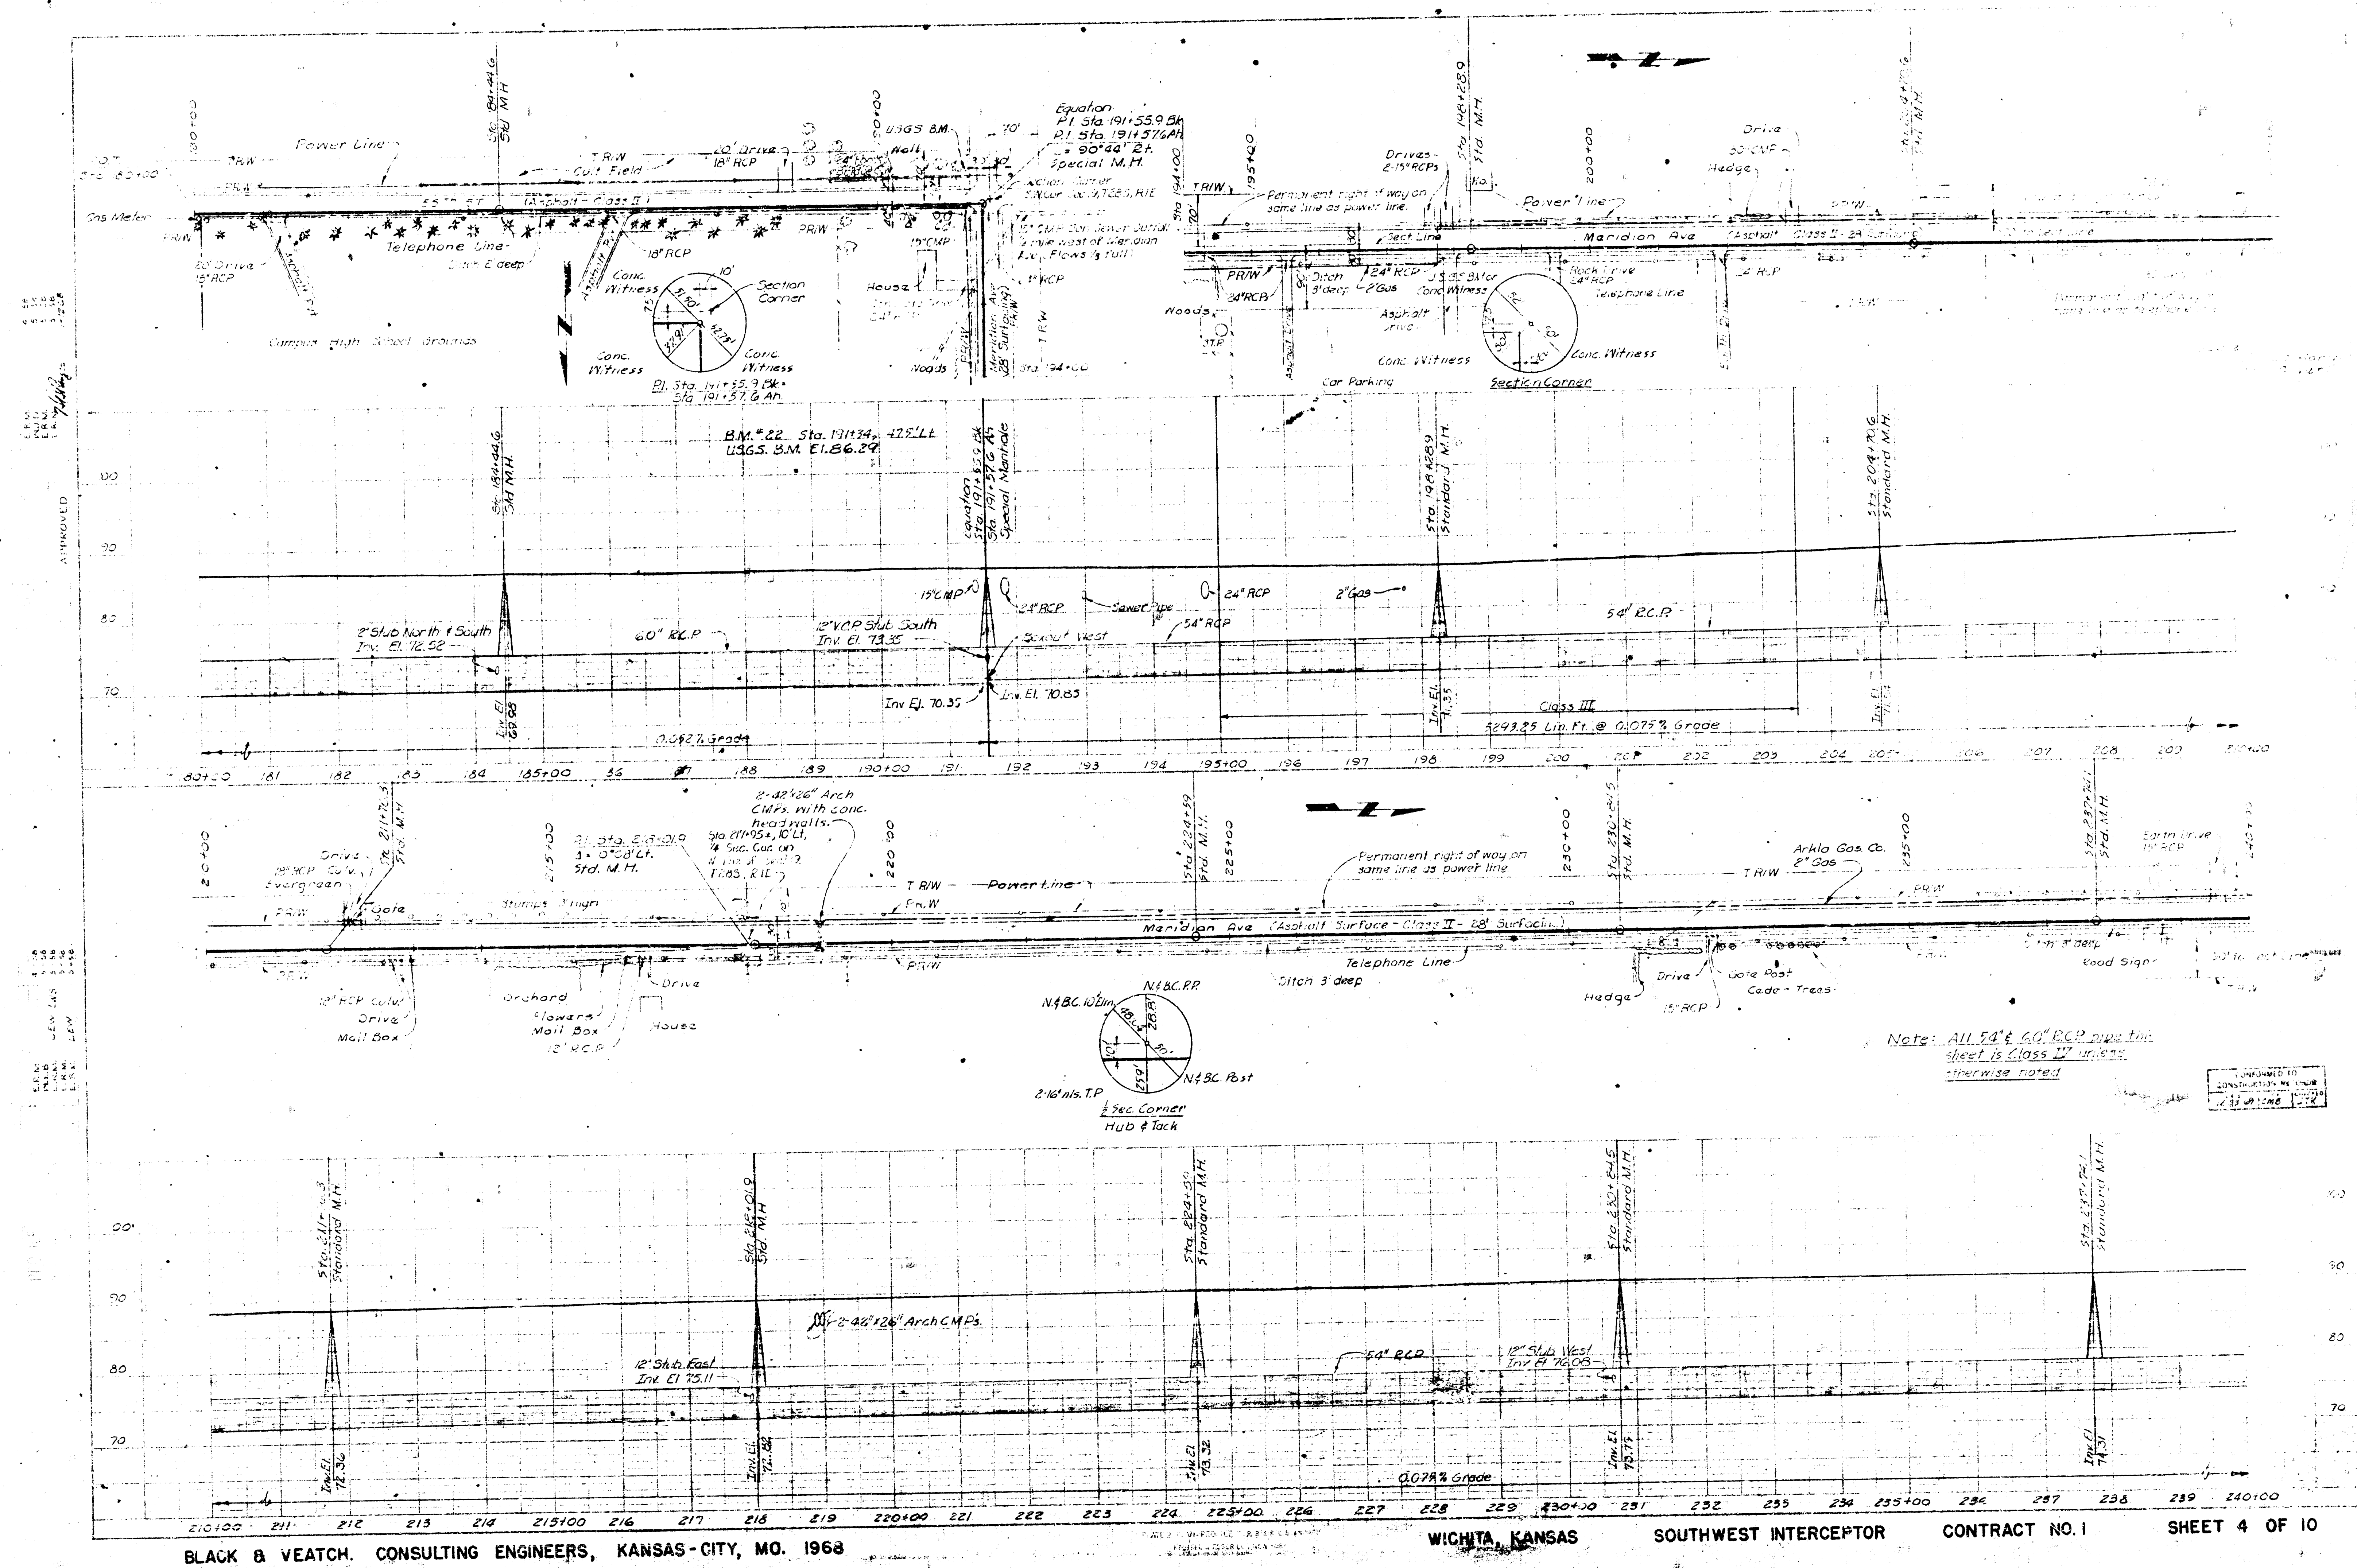


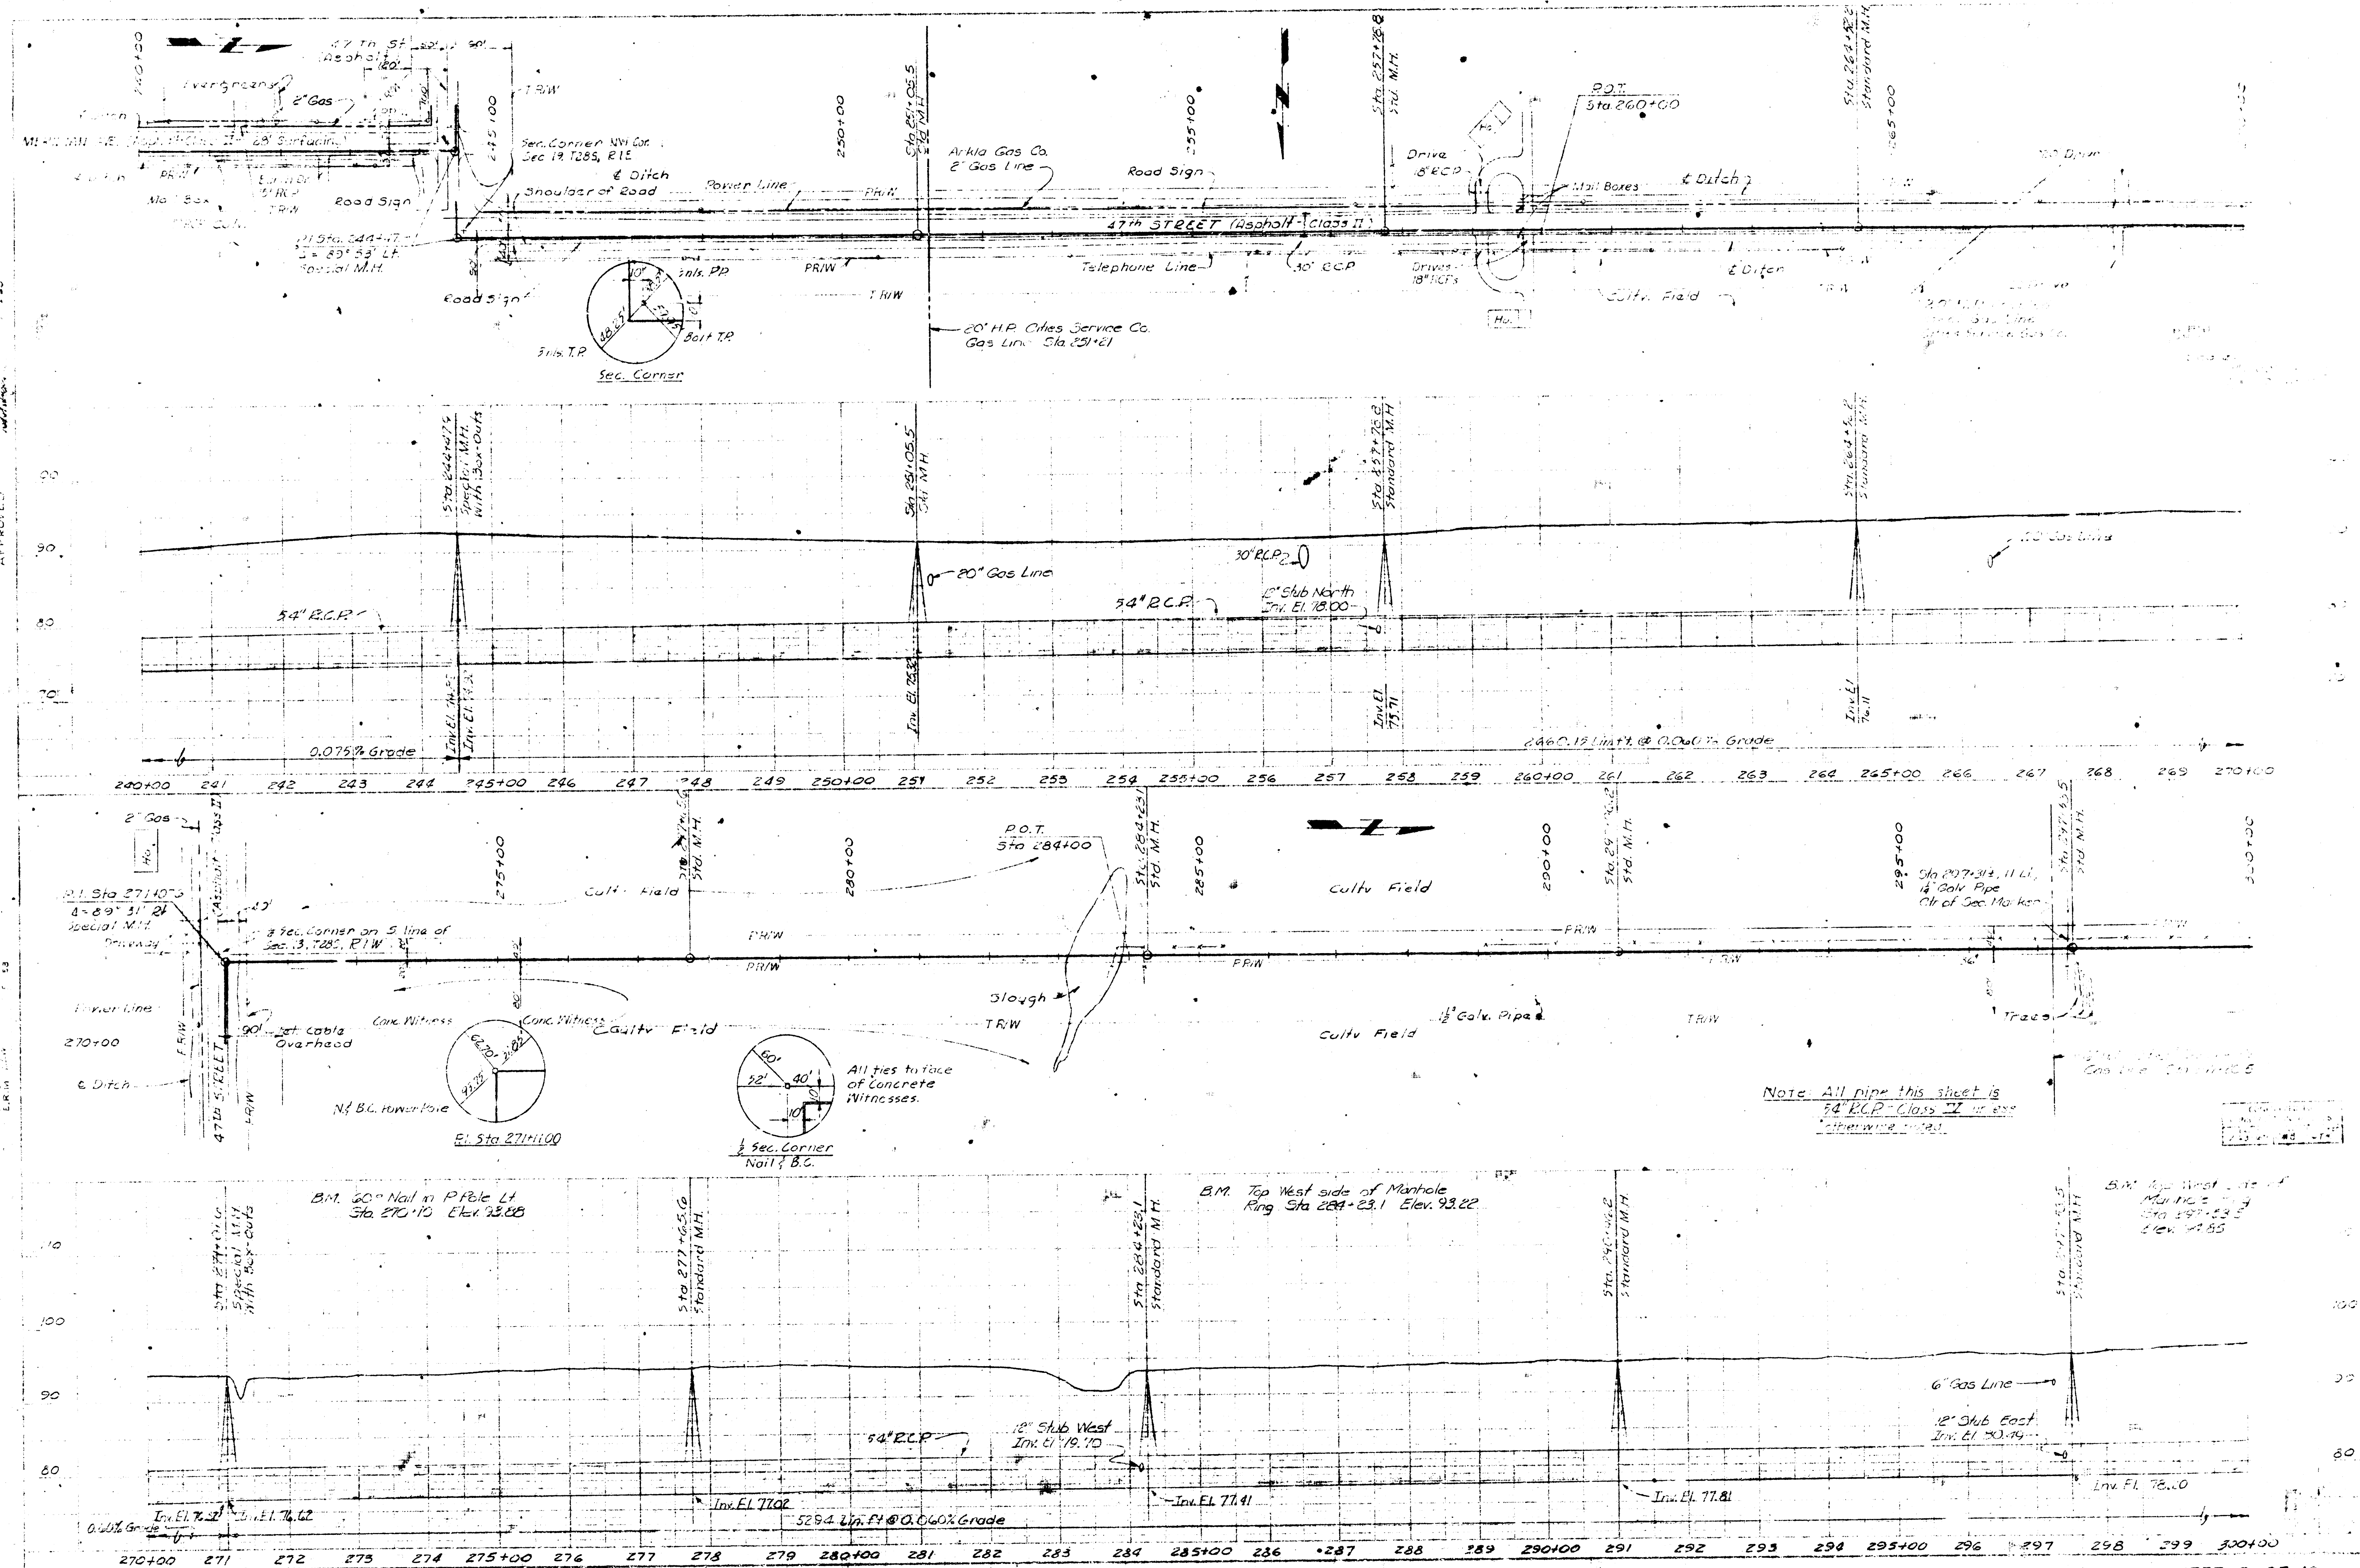


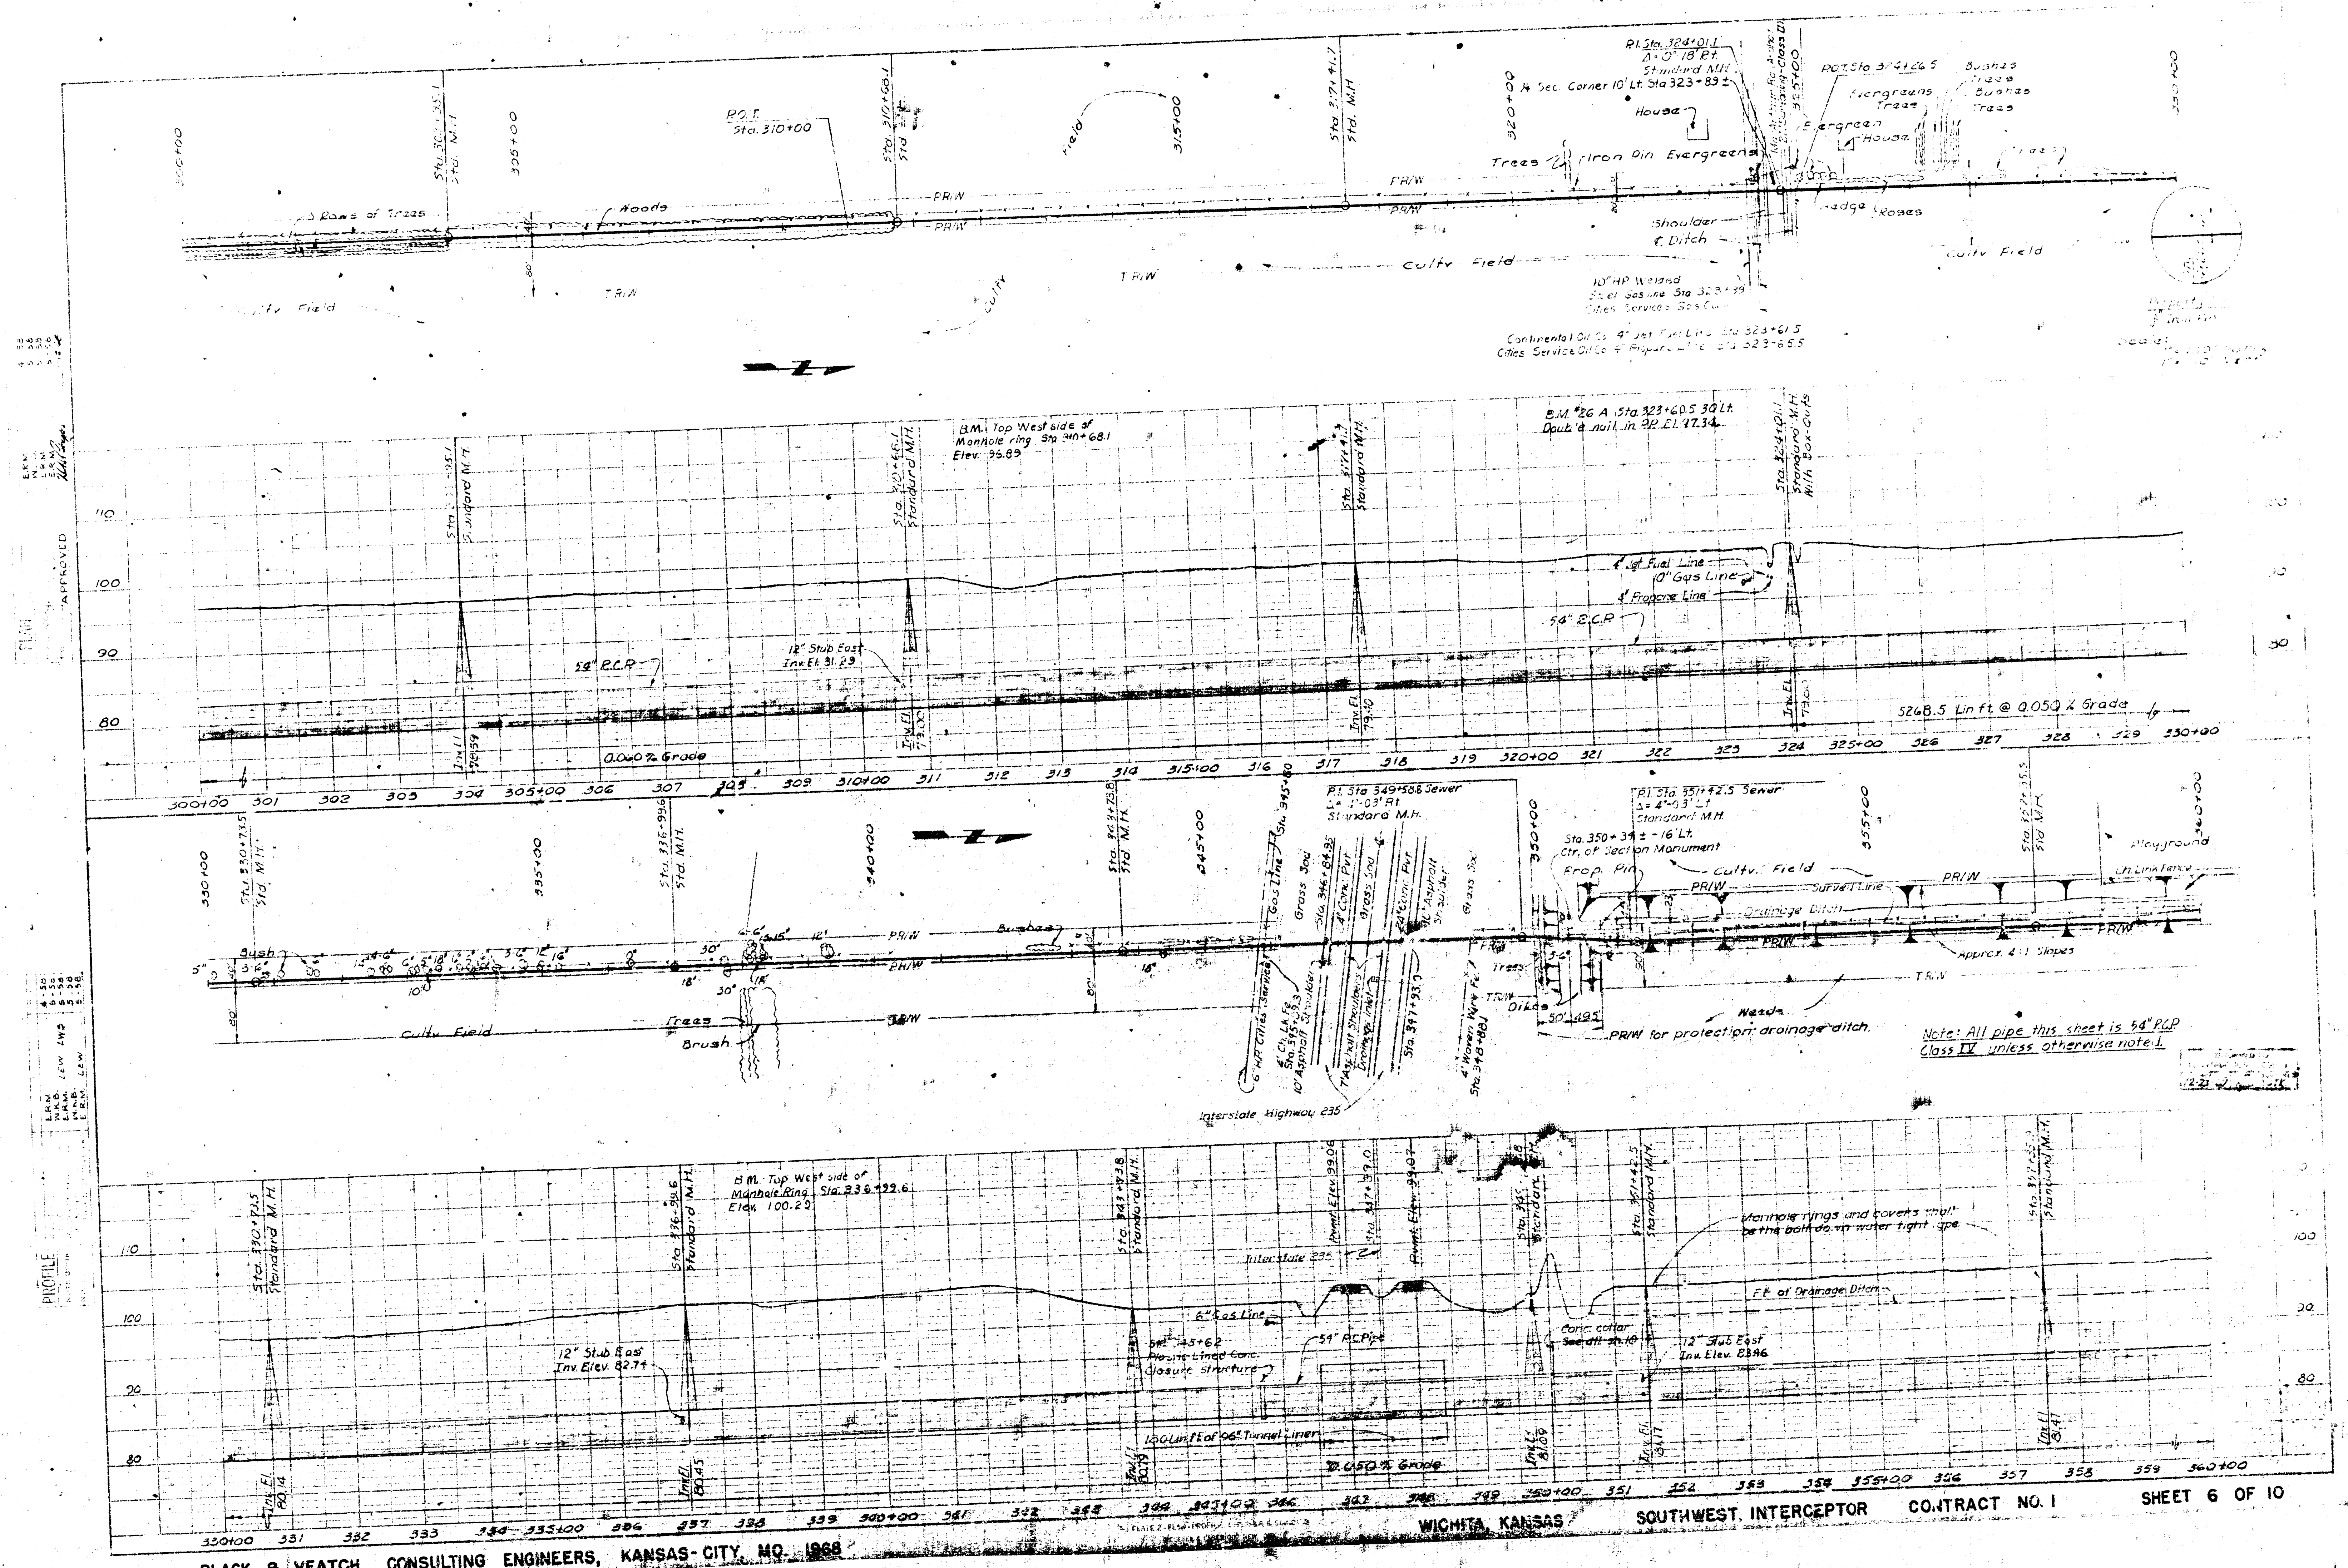

BLACK & VEATCH, CONSULTING ENGINEERS, KANSAS-CITY, MO. 1968

SOUTHWEST INTERCEPTOR CONTRACT NO. 1
WICHITA, KANSAS
SHEET 6 OF 10

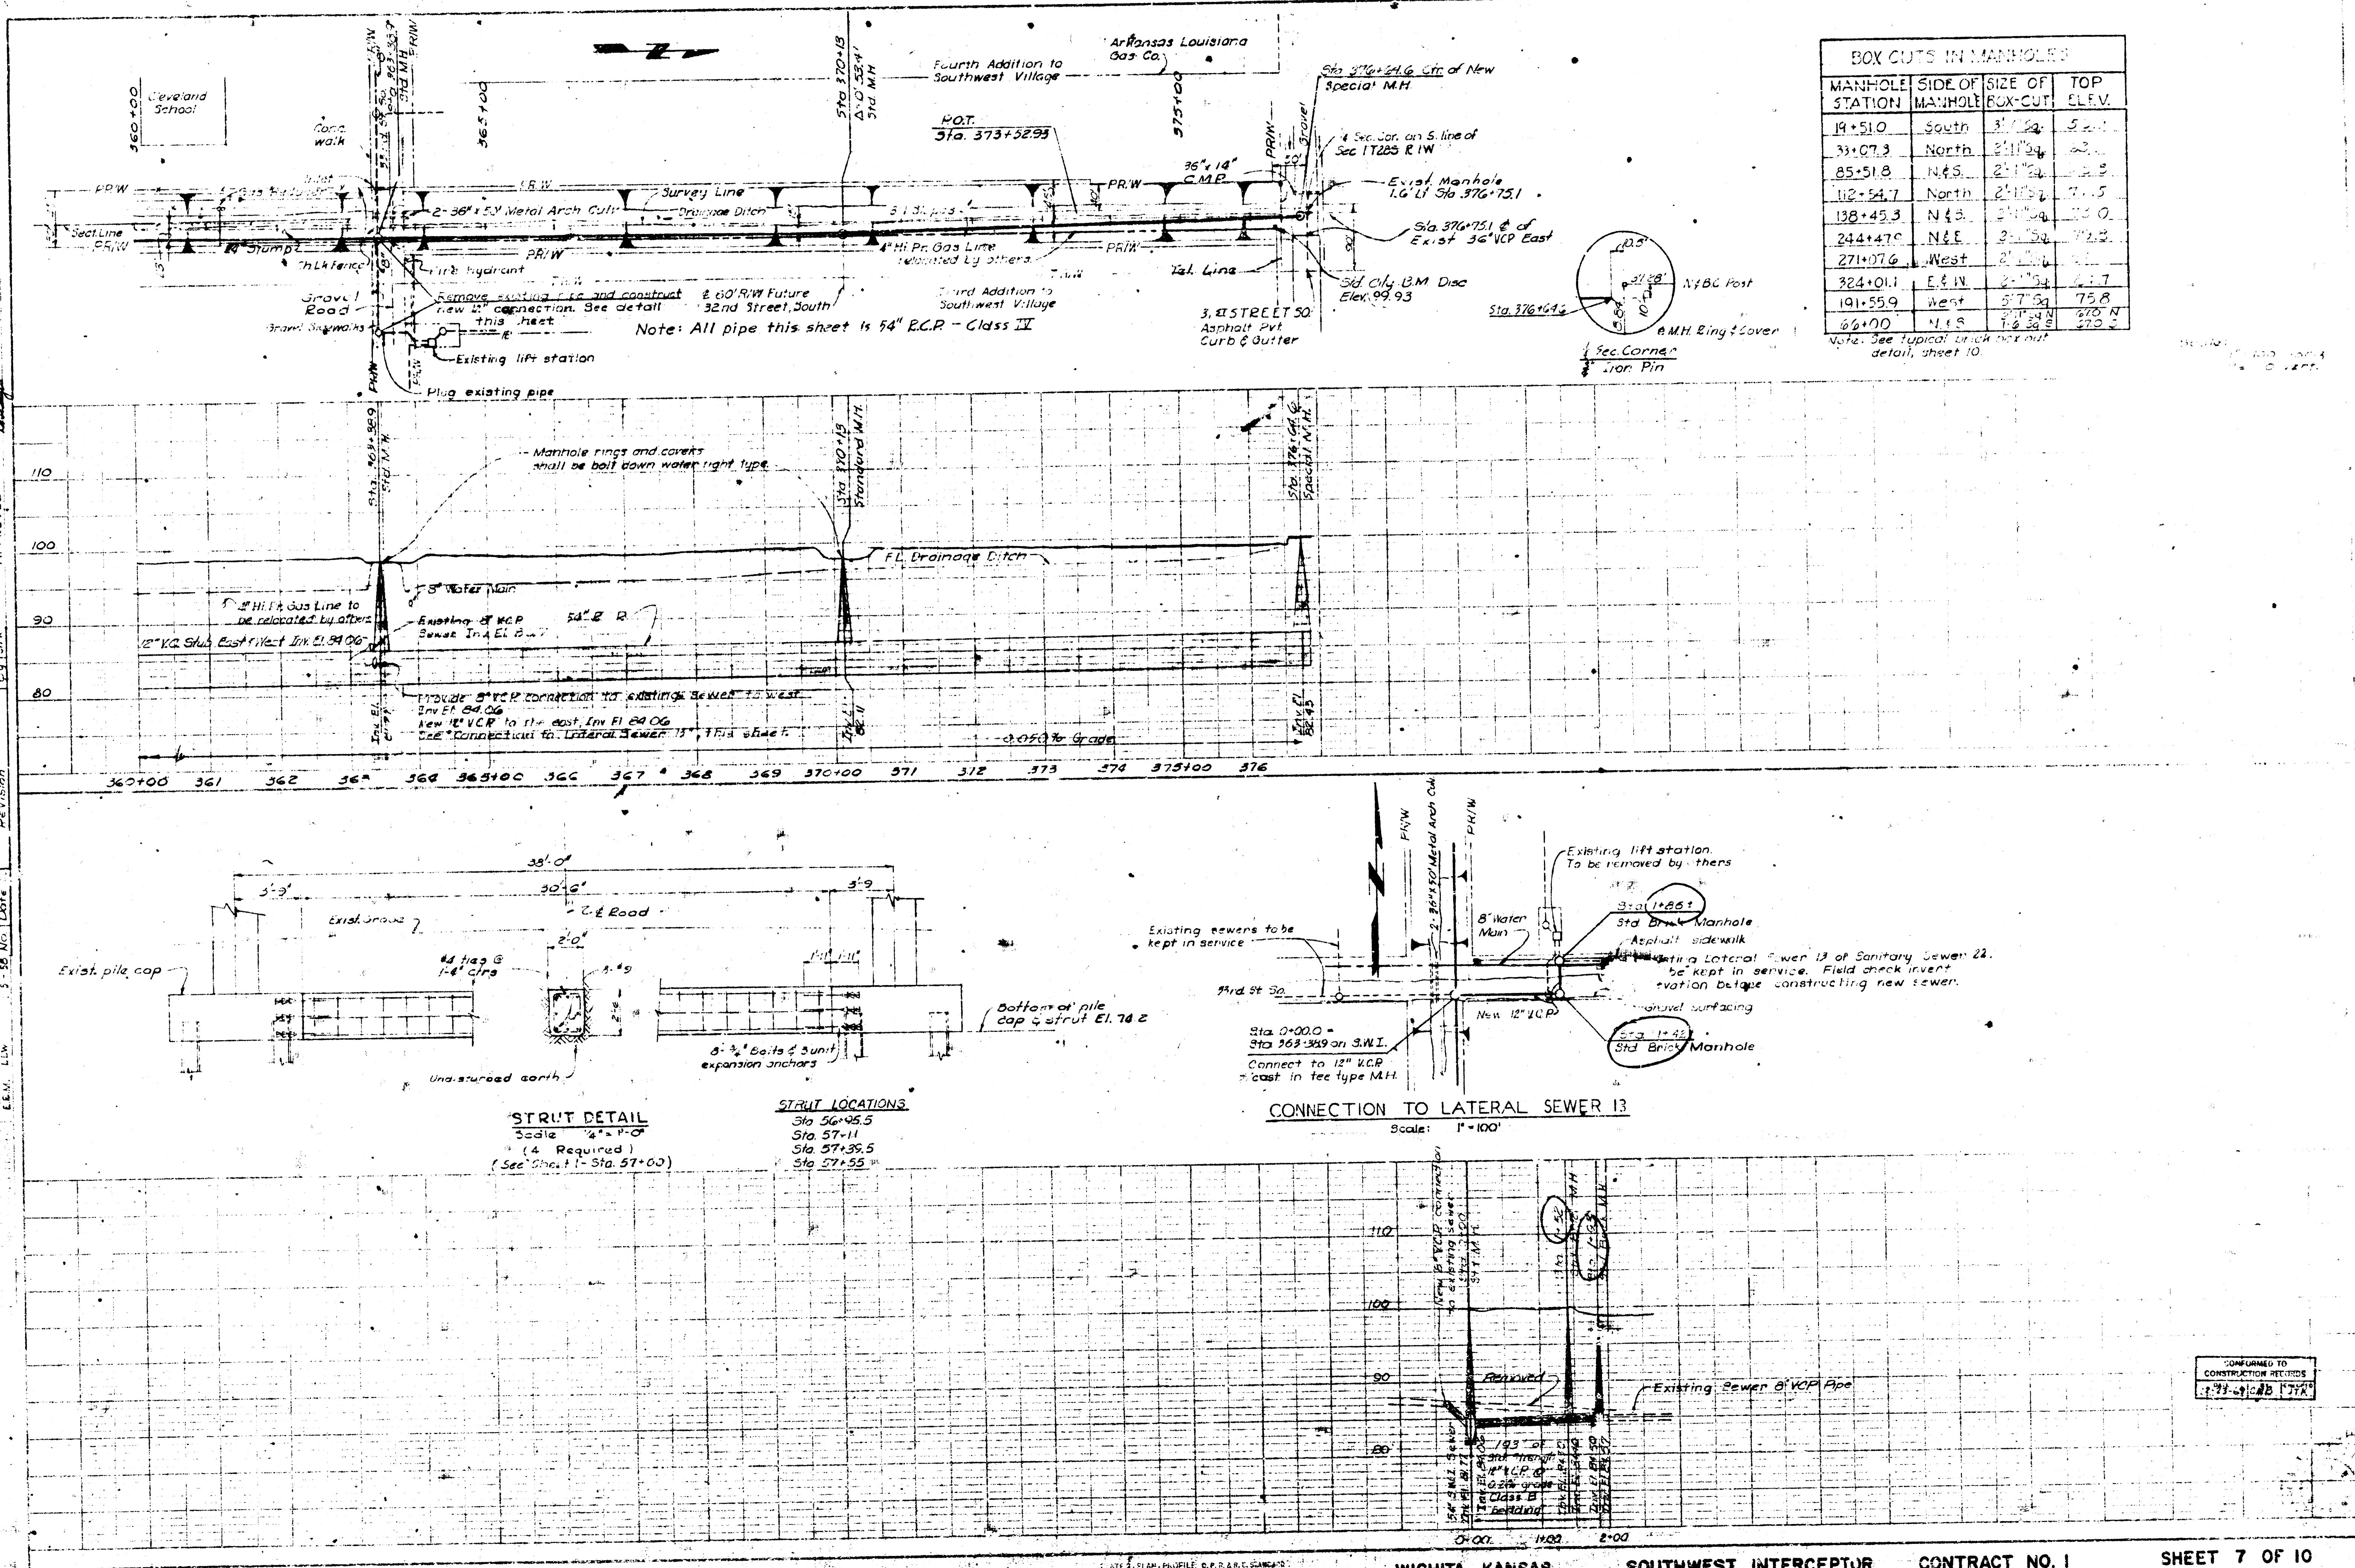

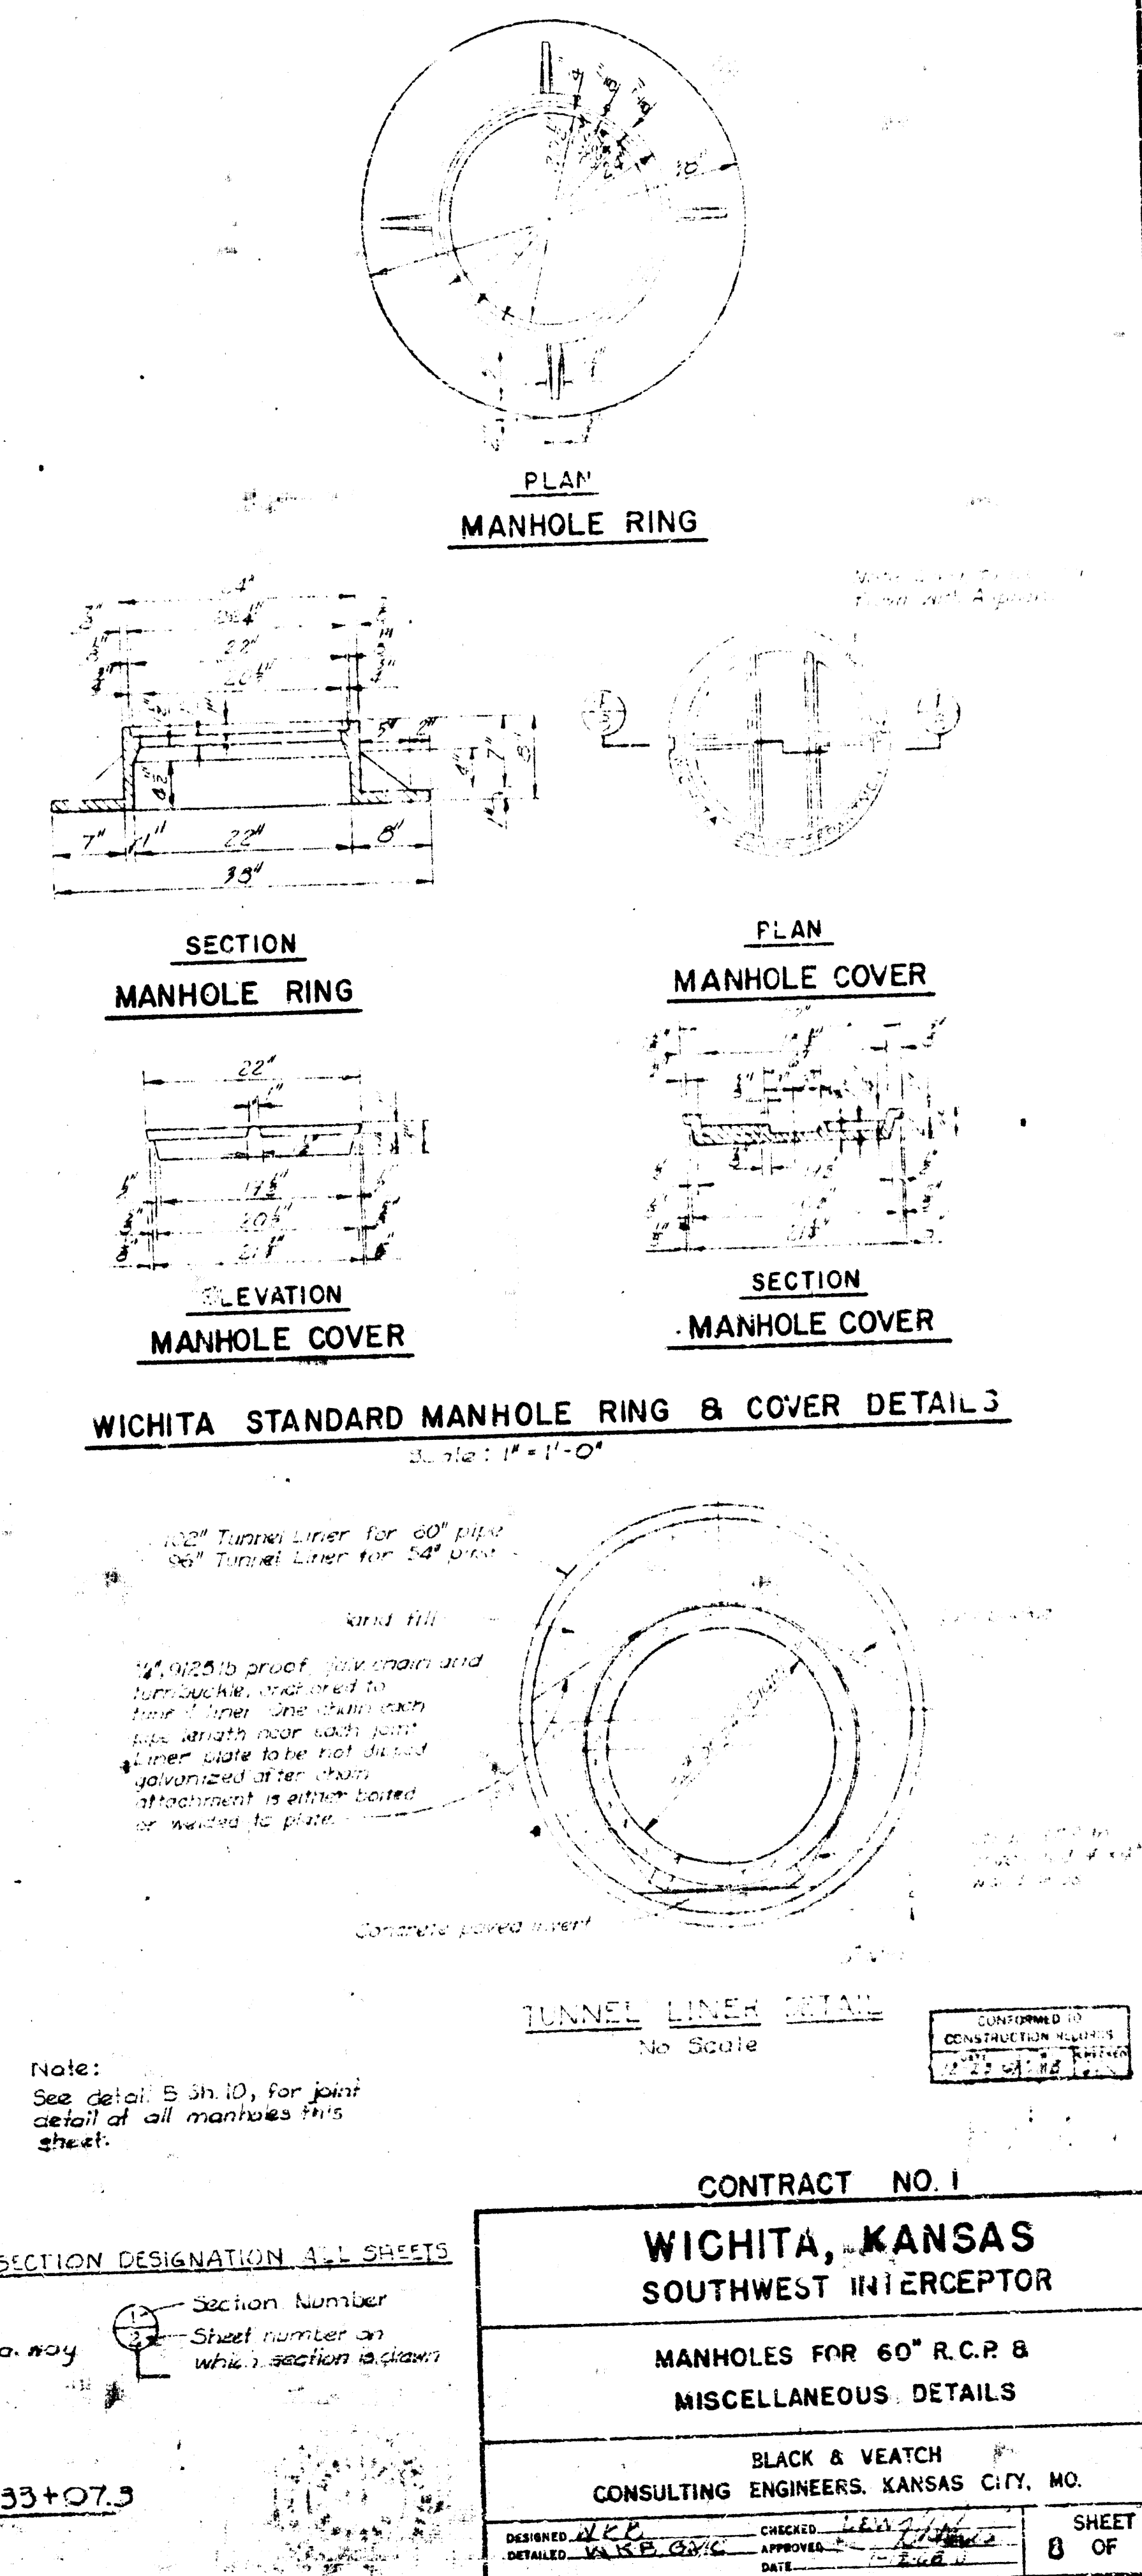

CONTRACT NO. 1


WICHITA, KANSAS
SOUTHWEST INTERCEPTOR

MANHOLES FOR 60" R.C.P. &
MISCELLANEOUS DETAILS












BLACK & VEATCH
CONSULTING ENGINEERS, KANSAS CITY, MO.

DESIGNED WKB CHECKED LEN
 DETAILED WKB APPROVED LEN
 DATE 1-2-68

SHEET
 8 OF 10

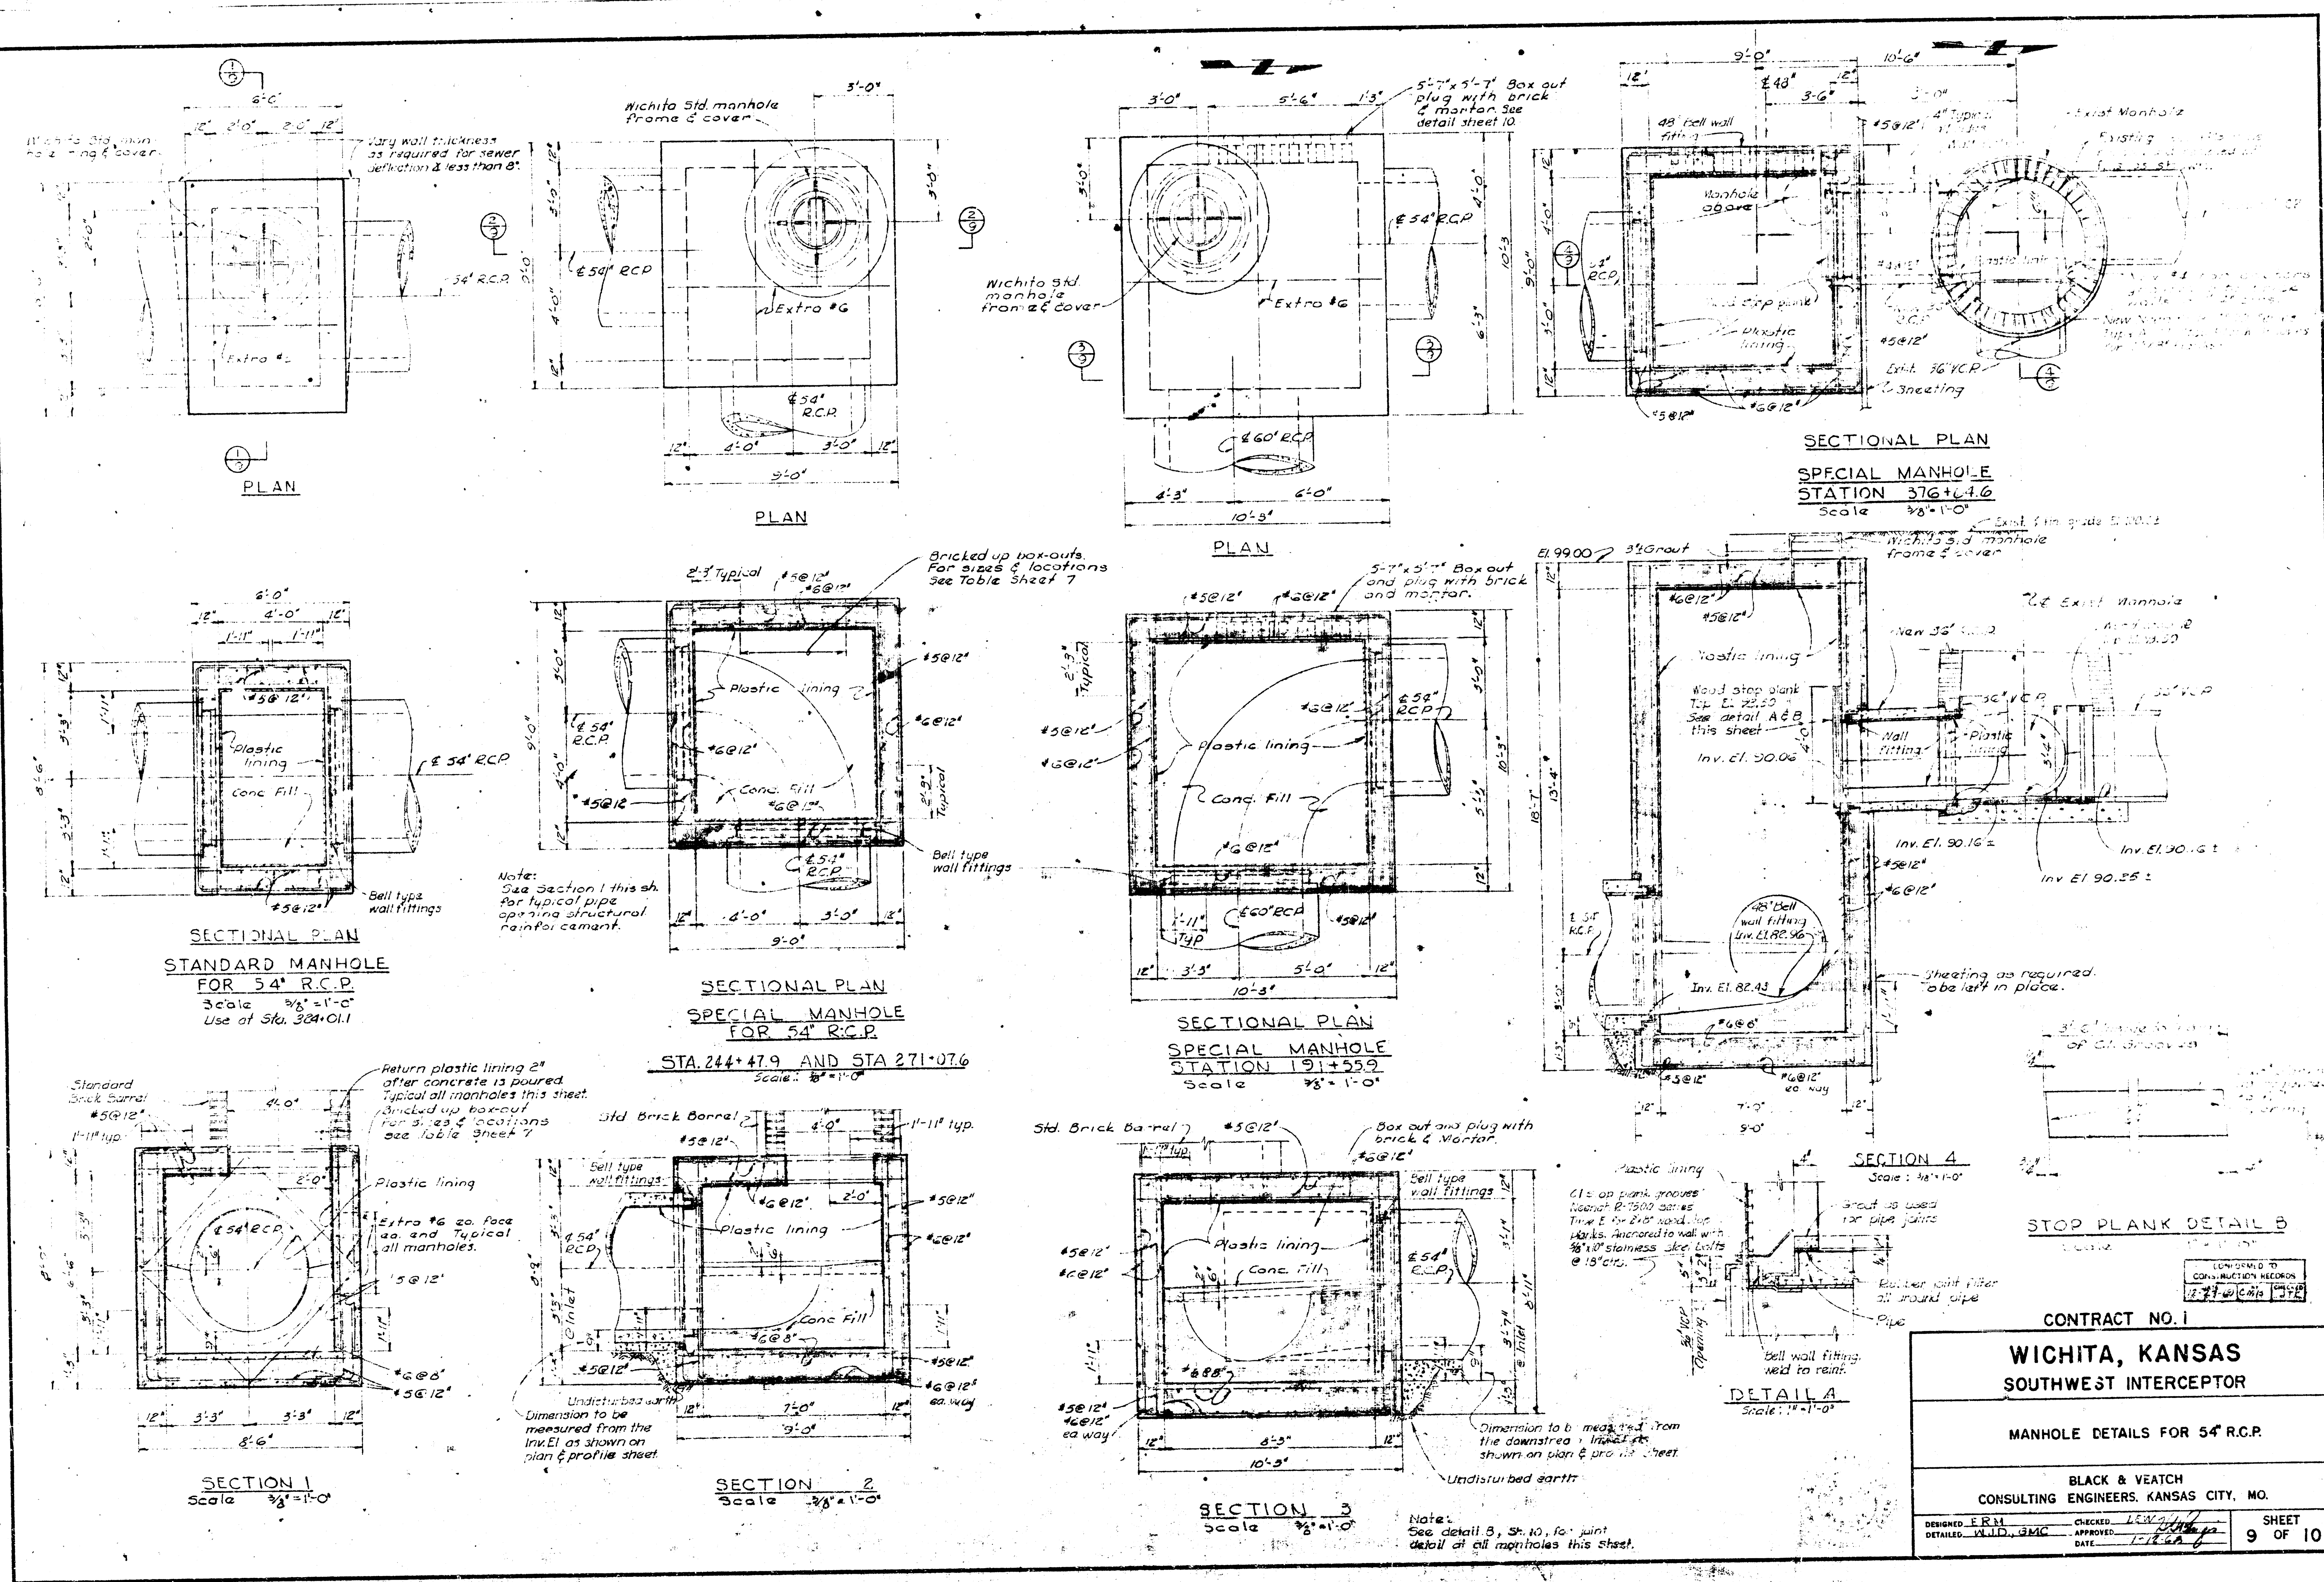

CONTRACT NO. 1	
WICHITA, KANSAS	
SOUTHWEST INTERCEPTOR	
BLACK & VEATCH	
CONSULTING ENGINEERS, KANSAS CITY, MO.	

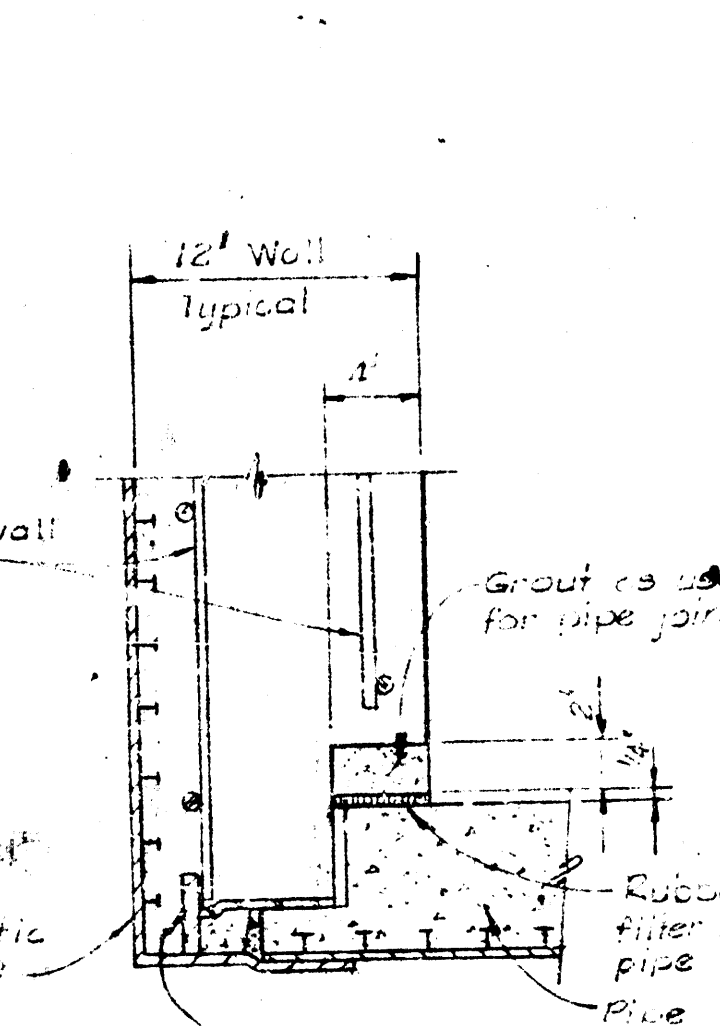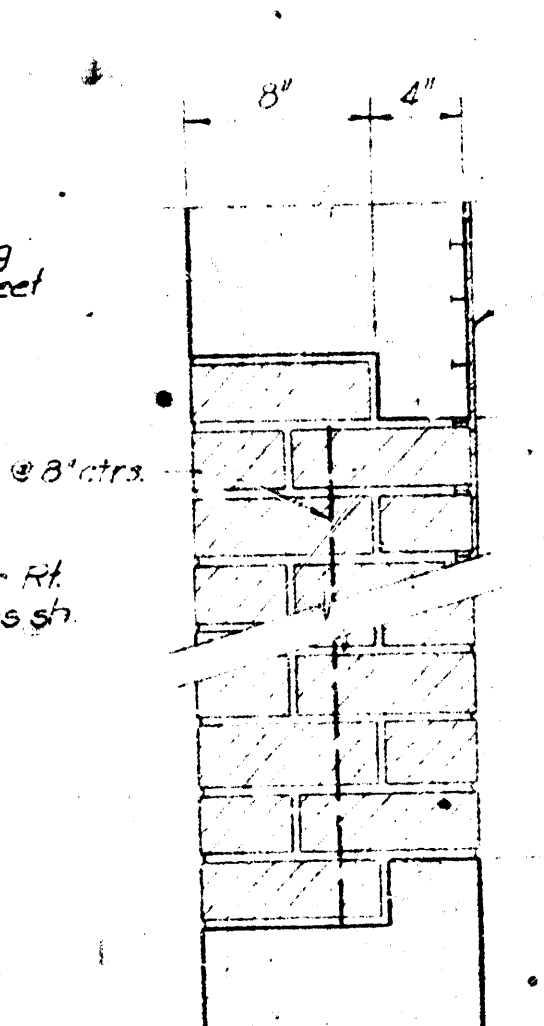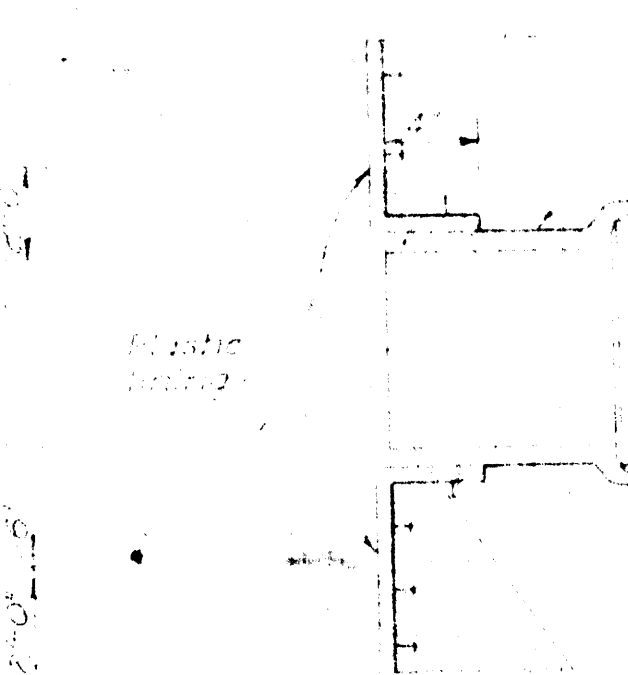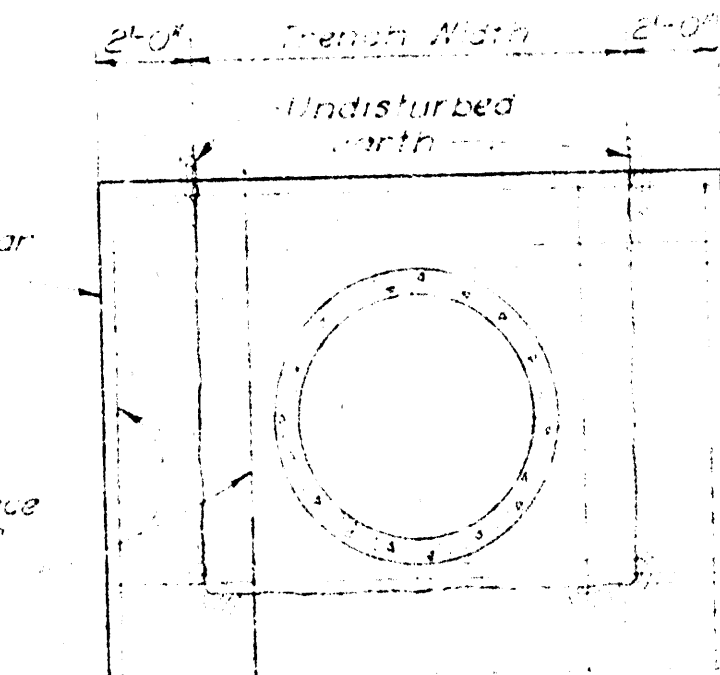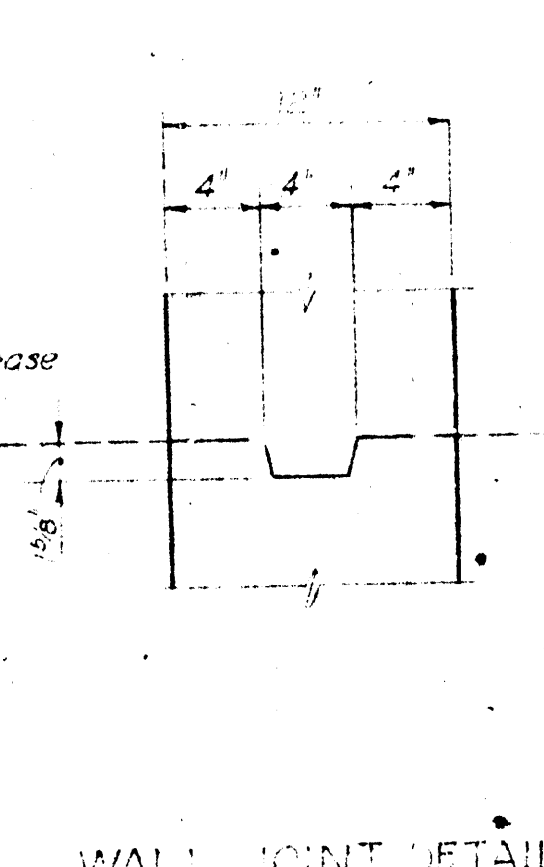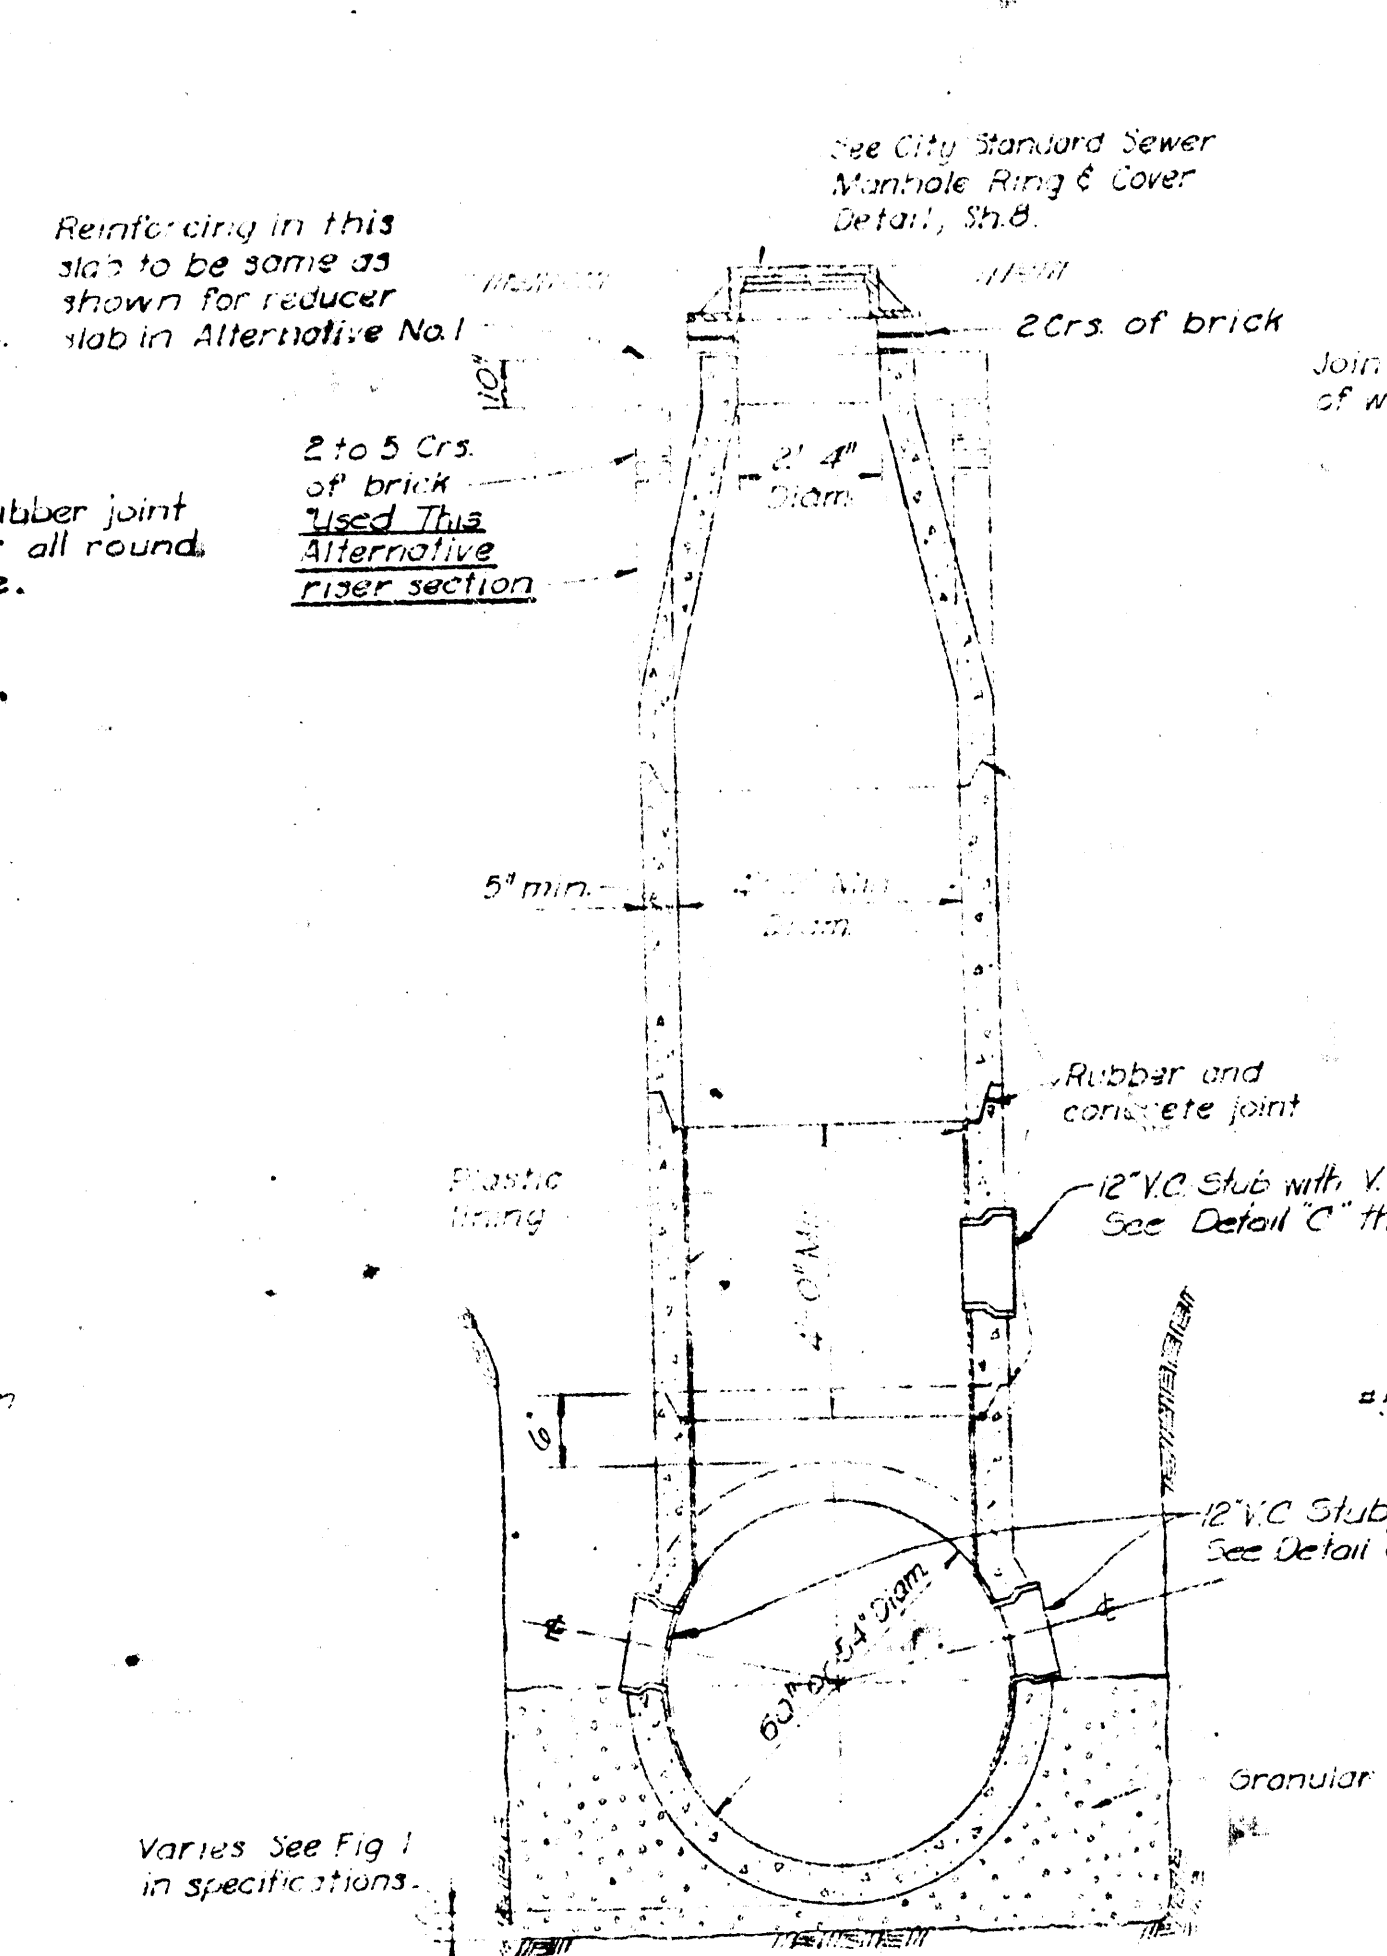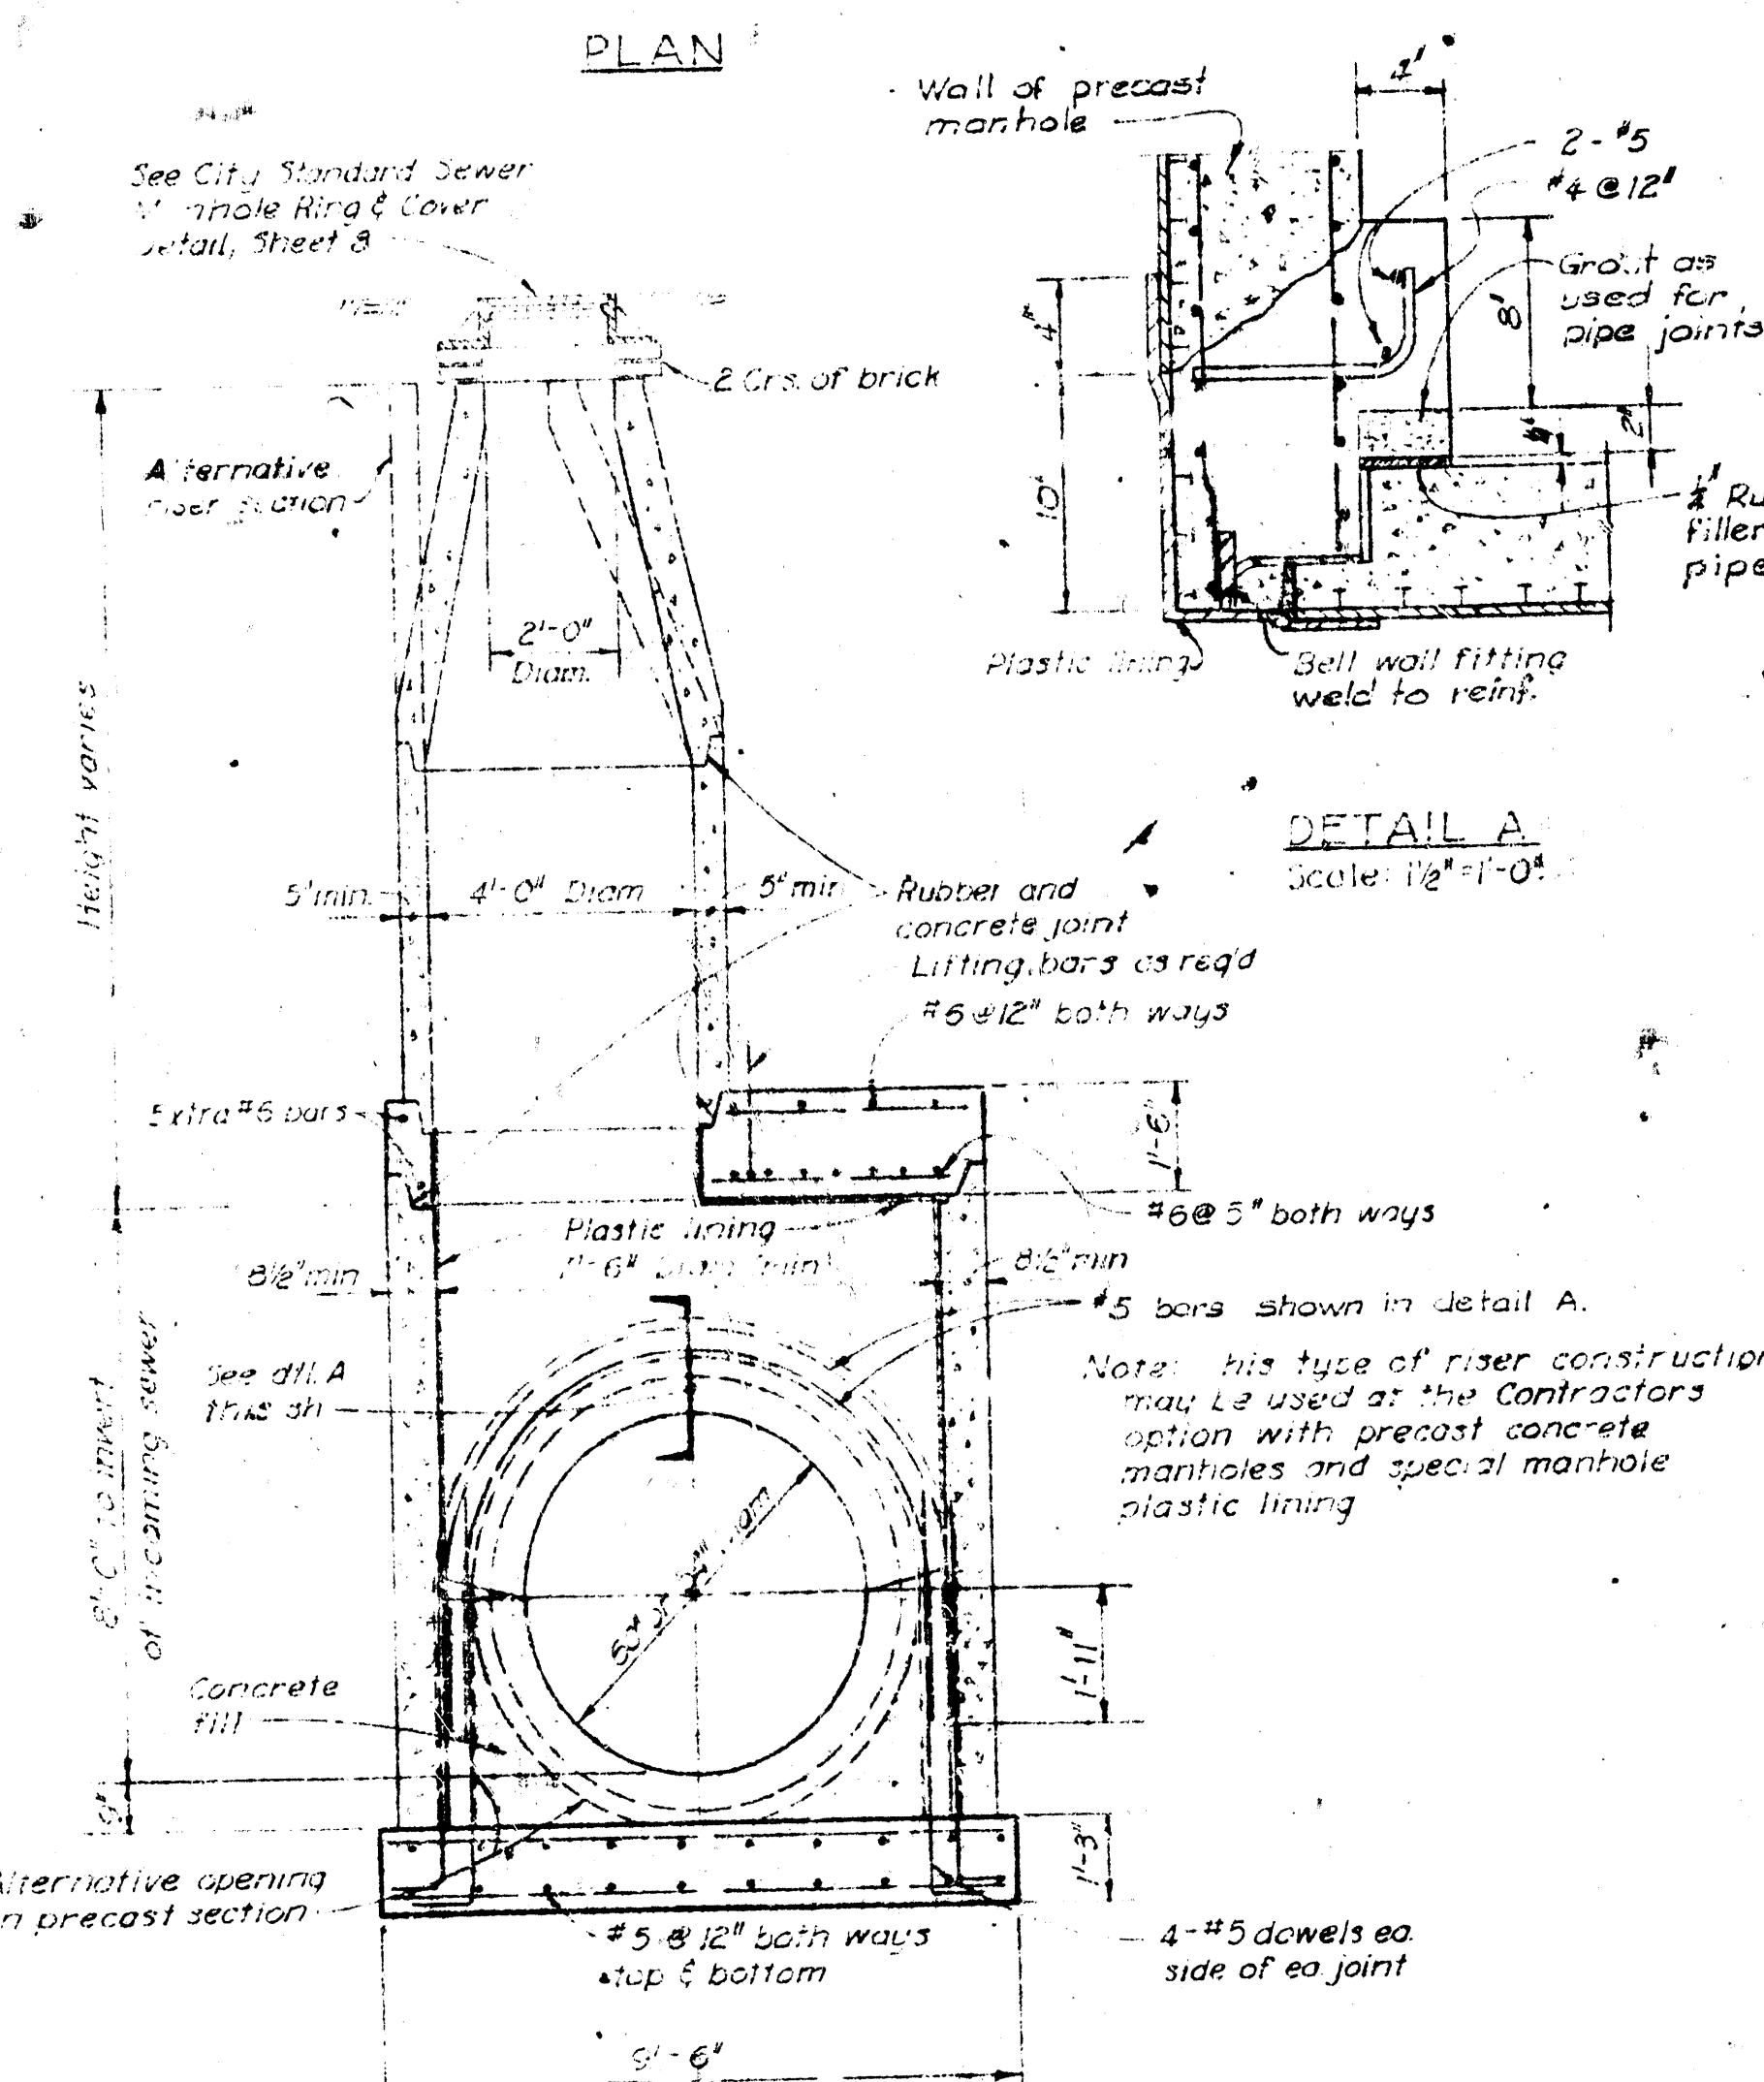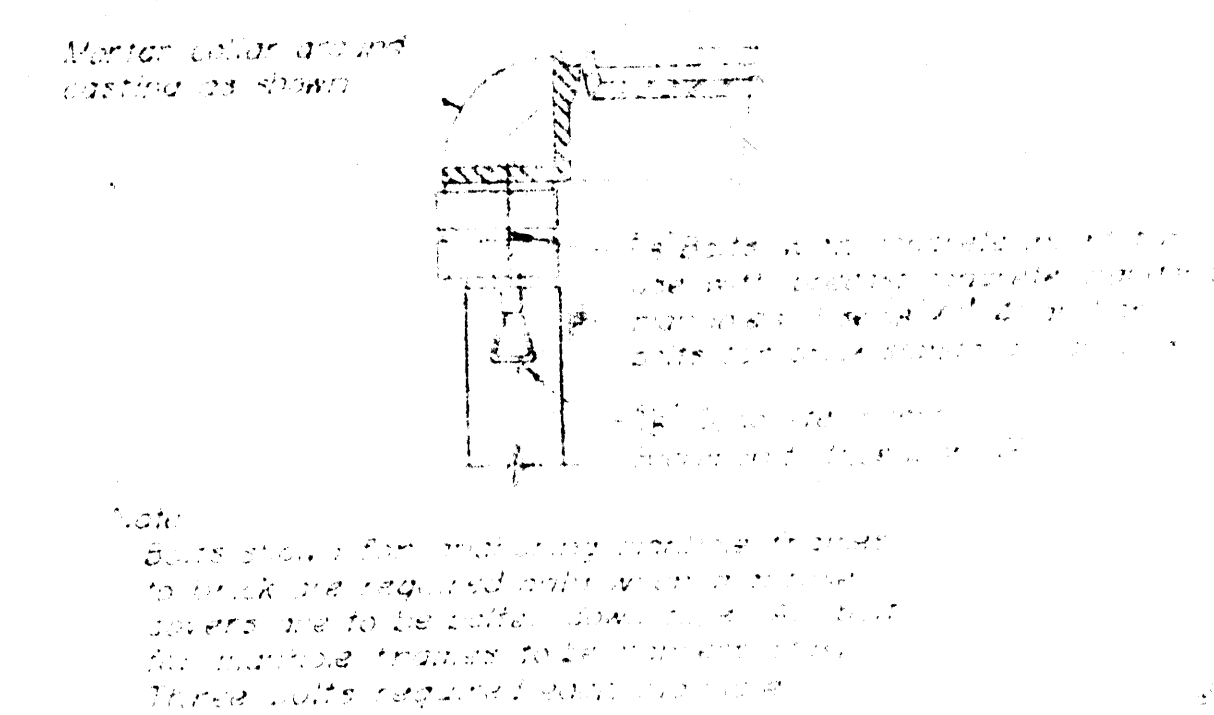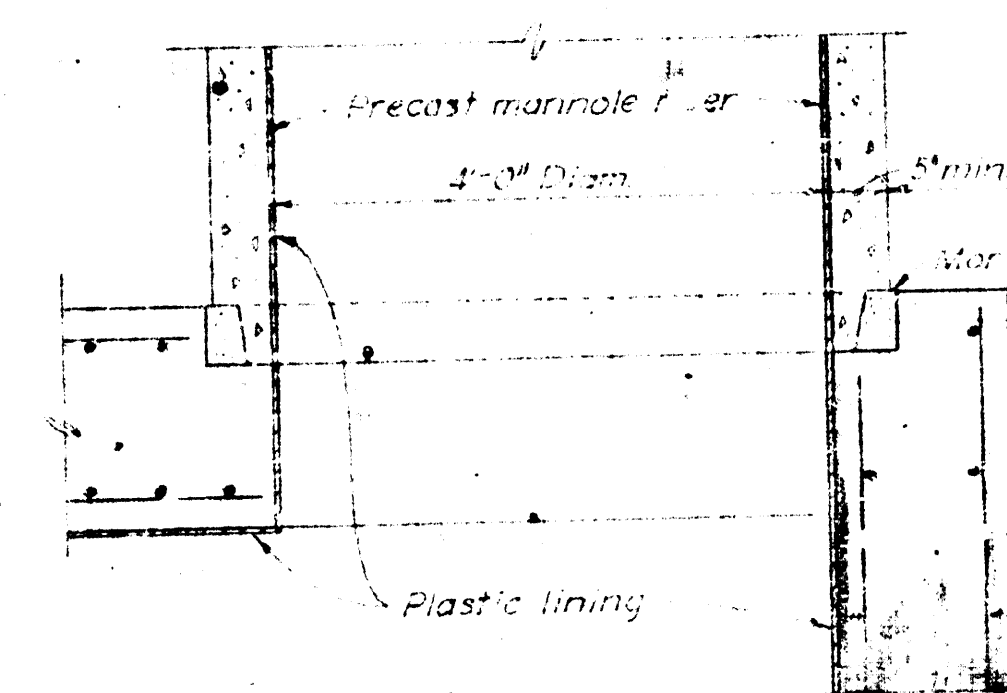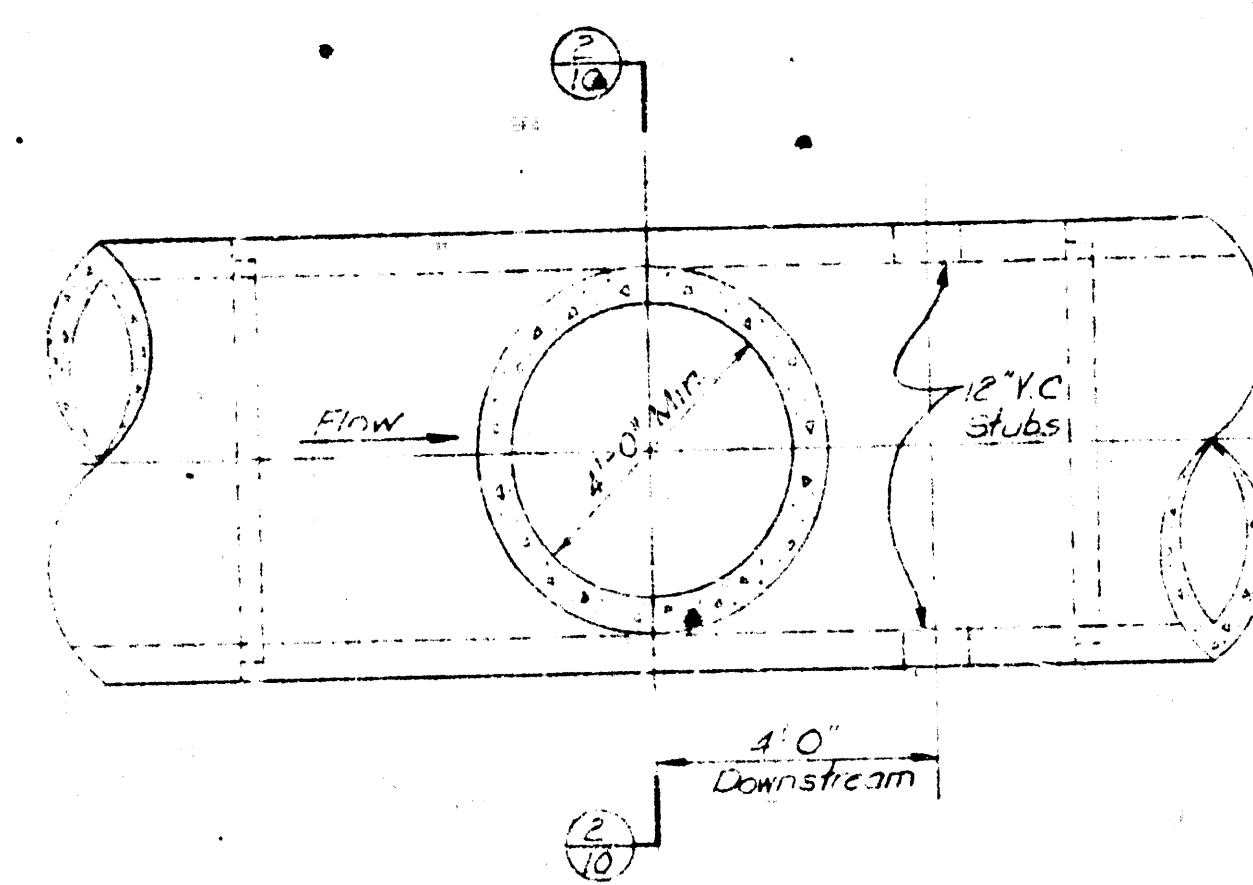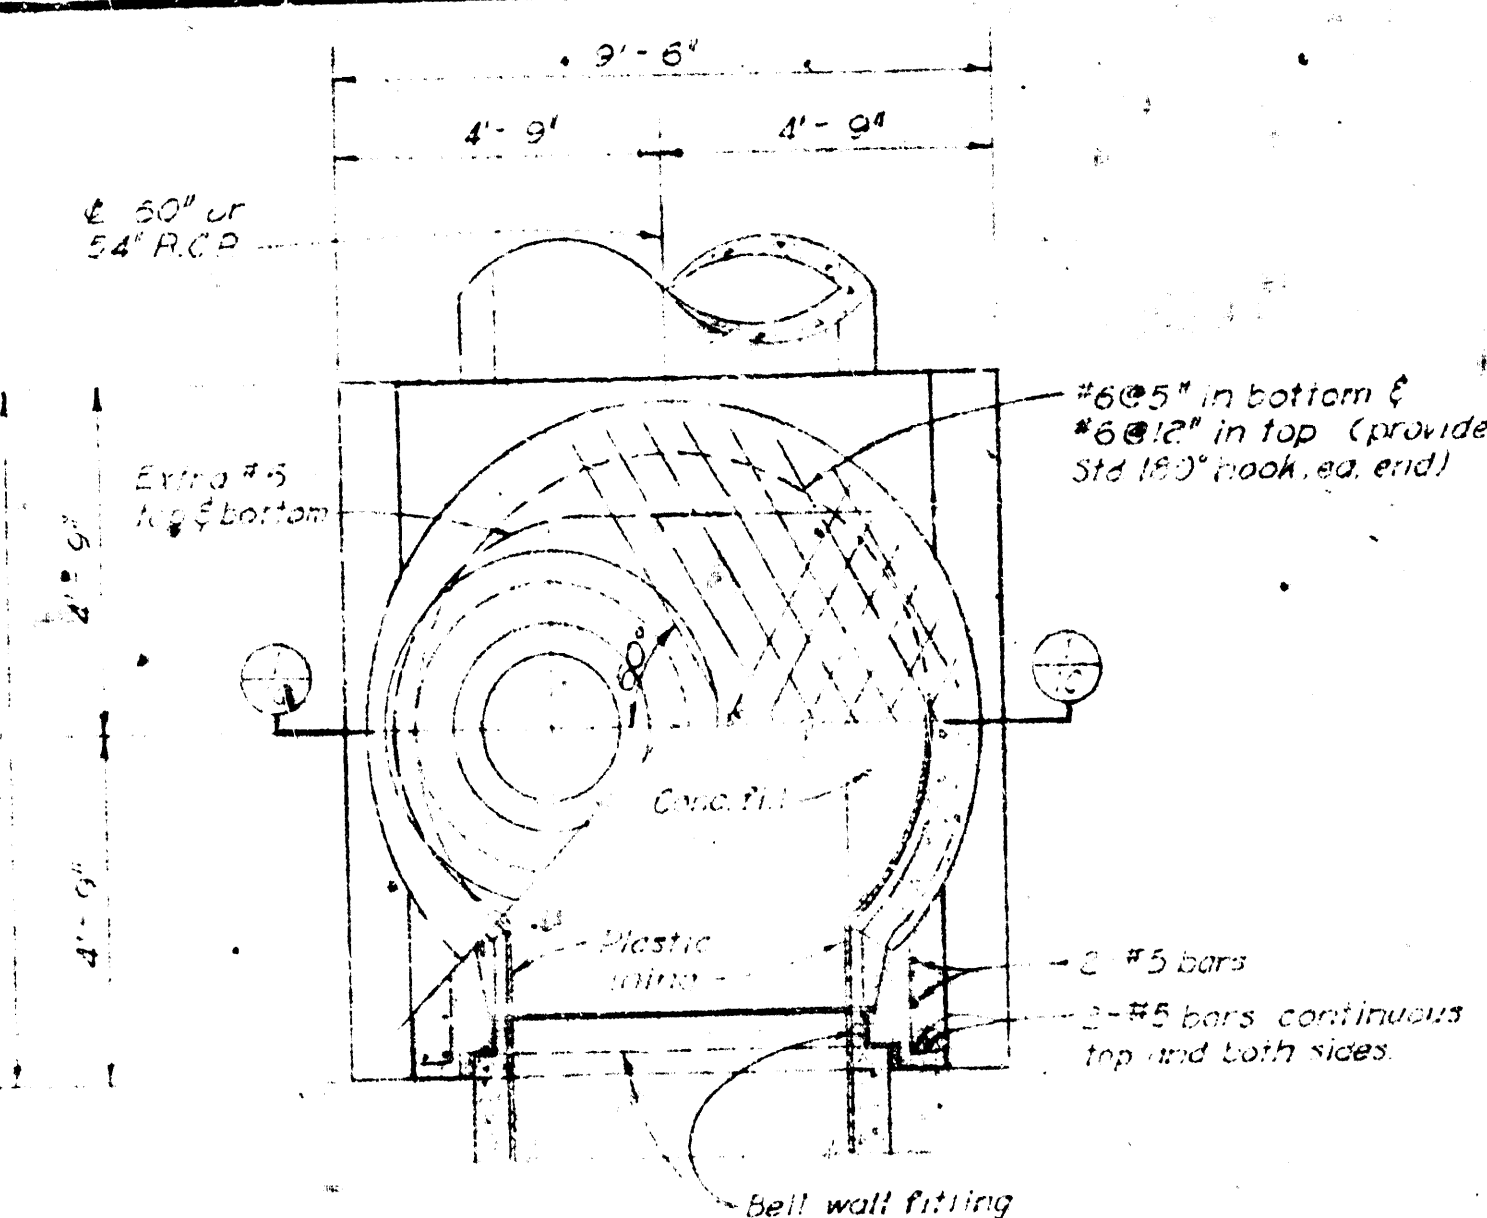






CONTRACT NO. 1	
WICHITA, KANSAS	
SOUTHWEST INTERCEPTOR	
MANHOLE ALTERNATIVES & MISCELLANEOUS DETAILS	
BLACK & VEATCH CONSULTING ENGINEERS, KANSAS CITY, MO.	
DESIGNED BY _____	CHECKED BY _____
DETAILED BY <u>GMC JLR</u>	APPROVED BY <u>[Signature]</u>
	DATE <u>12-1-61</u>
	10