

NOTE: CONTRACTOR SHALL EXCAVATE EXISTING 6" LINE TO BE CONNECTED TO MANHOLE AT STATION 2+75 PRIOR TO INSTALLING ANY SEWER PIPE SO FIELD ENGINEER CAN VERIFY RELATIONSHIP OF THE FLOW LINES OF THE 6" LINE AND THE PROPOSED NEW 8" SEWER. CONTRACTOR SHALL TAKE PRECAUTIONS AS NECESSARY TO PREVENT DAMAGE TO SIDEWALK AND STREET PAVEMENT DUE TO THE CONSTRUCTION OPERATIONS. ANY DAMAGE TO SIDEWALK OR STREET PAVEMENT DUE TO CONTRACTOR'S OPERATIONS SHALL BE REPAIRED BY THE CONTRACTOR AT HIS EXPENSE.

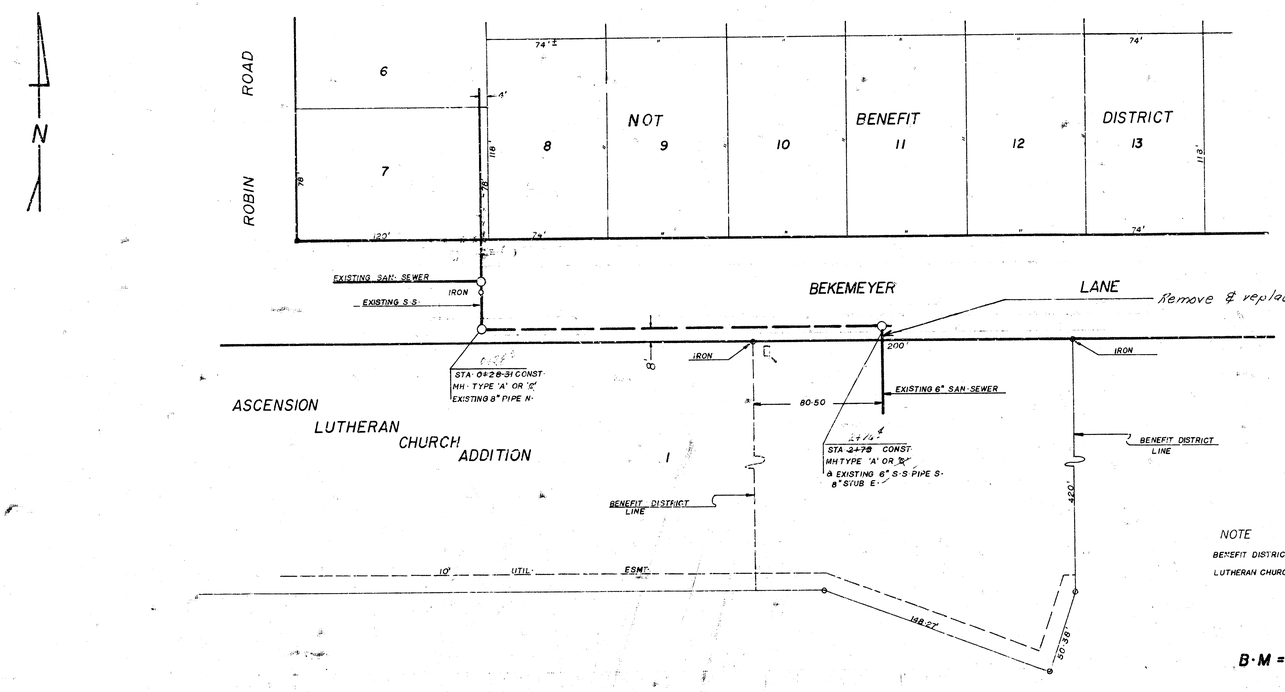

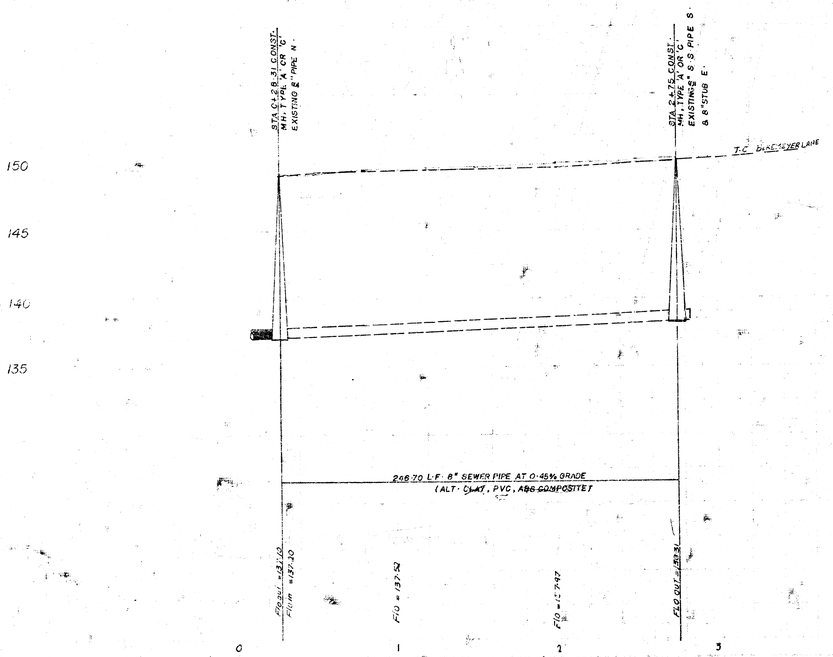

N

NOTES

1- FIELD ENGINEER TO TAKE TIES ALL IRONS THAT MAYBE DISTURBED DURING CONSTRUCTION AND REPLACE ANY THAT ARE DESTROYED.

2- CONTRACTOR CONTACT UTILITY COMPANIES FOR LOCATION OF ANY UNDERGROUD LINES.

3- FIELD ENGINEER TO SET TOP OF MANHOLES TO FINISH GRADE AS DETERMINED BY DEVELOPER.

4- CONTACT BUILDING CONTRACTOR FOR ADJUST EXISTING 6" SAN. SEWER PIPE AND HOOK TO M.H AT STA. 2+75 AND CONTRACTOR TO OBTAIN PERMIT FOR CONNECTION.

NOTE

BENEFIT DISTRICT IS E. 200' OF LOT 1, ASCENSION LUTHERAN CHURCH ADD. (E. TYLER & BEKEMEYER)

B.M = 153.22 S.E. Conc. Porch House # 8514 Bekemeyer

Scale

PLAN	1" = 40'
Profile Hort	1" = 40'
Vert	1" = 5'

LAT 126 SW1

468-76-245-8055G-000-000-001

City of Wichita, Kansas

Dept of Public Works — Engineering Div.

Dean Sellers Acting City Engineer

DATE