
LAT. 182, SOUTHWEST INTERCEPTOR
SANITARY SEWER EXTENSION
FOR
BLOCK 2, WESTERN ADDITION

468-76-245-81304-000-000-001

CITY OF WICHITA, KANSAS


MIKE LINDEBAK, CITY ENGINEER

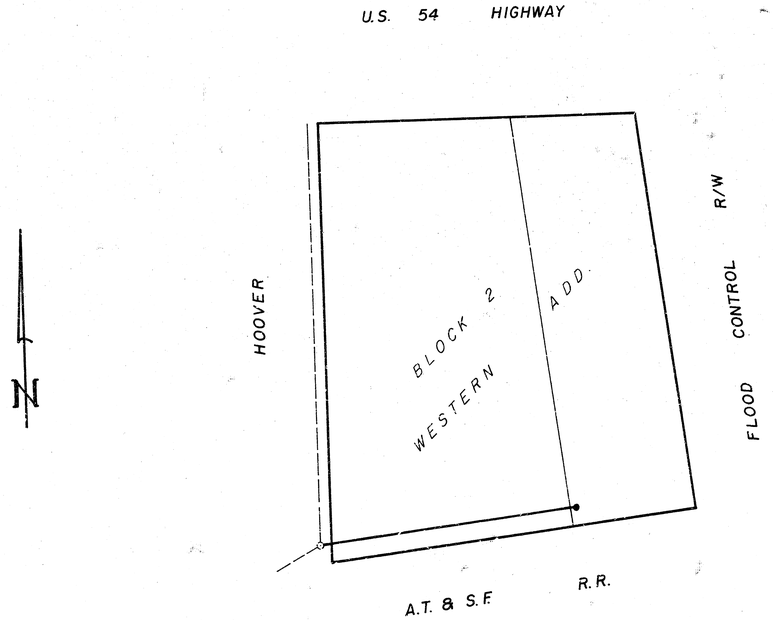


As Built
SLL
10-83

H. BRENT WOOTEN
LICENSED
8470
KANSAS

BAUGHMAN COMPANY, P.A.
SURVEYING & ENGINEEERING
316/269-7271 • 33[illegible]RA • WICHITA, KANSAS 67211

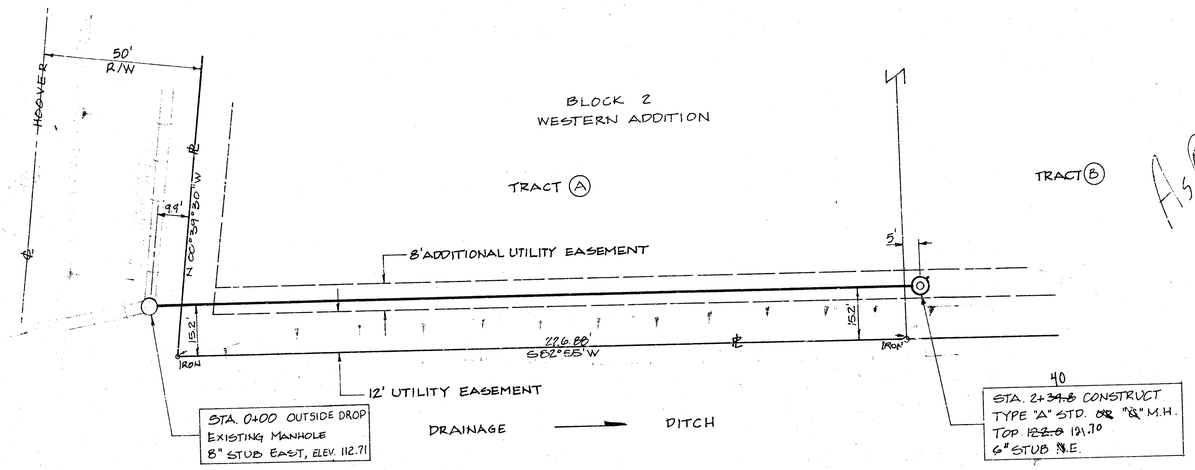

PLAN: 1" = 20'
PROFILE:
1" = 20' HORZ.
1" = 5' VERT.

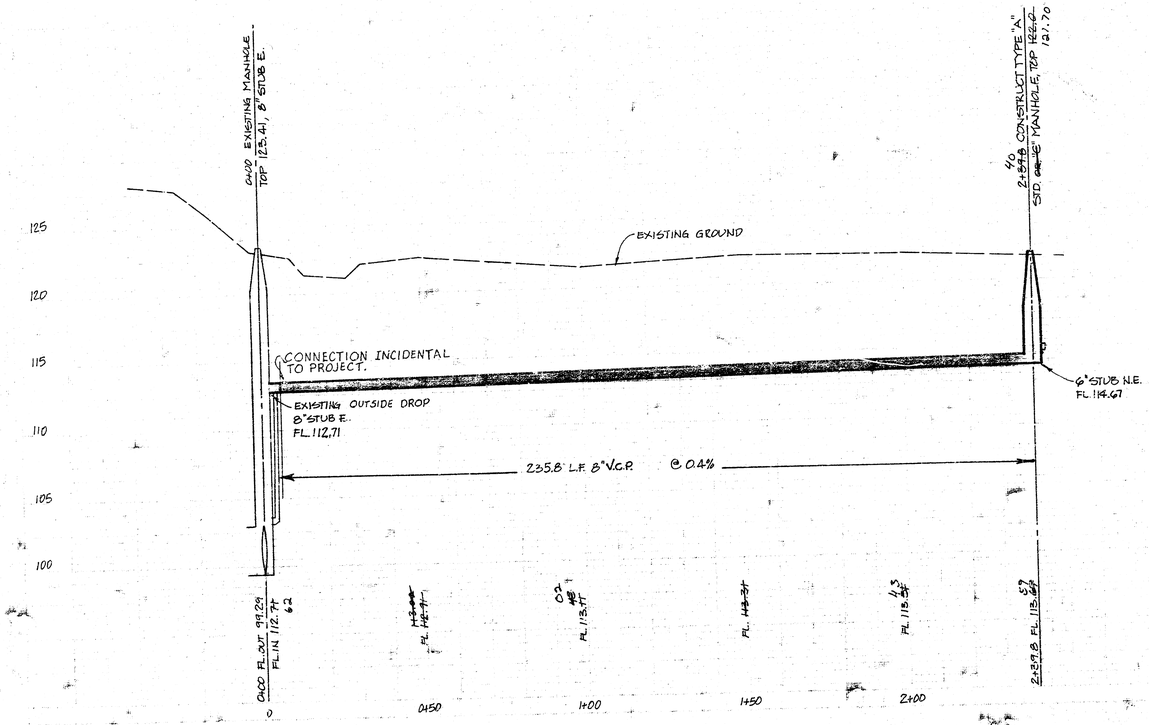

BENCH MARK:
"D" CUT IN CONCRETE @ N.E. COR. OF BLDG.
5601 W. KELLOGG, ELEV. 122.17

Note - The contractor shall be responsible for preserving property irons. The contractor shall be required to re-establish any property irons which are destroyed or damaged by his construction. Such irons shall be re-established by a licensed land surveyor or professional engineer in accordance w. state laws. The existing 8" V.C.P. stub at the existing manhole is to be utilized in the pipe construction & extension.

NORBERT WOOTEN
LICENSED
8470
KANSAS
PROFESSIONAL ENGINEER

L.AT. 182, SOUTHWEST INTERCEPTOR
Block 2, Western Addition
City of Wichita, Kansas
468-76-245-81304-000-000-001

BAUGHMAN COMPANY, P.A.
SURVEYING & ENGINEERING
316/262-7271 • 330 LAURA • WICHITA, KANSAS 67211

2/2