
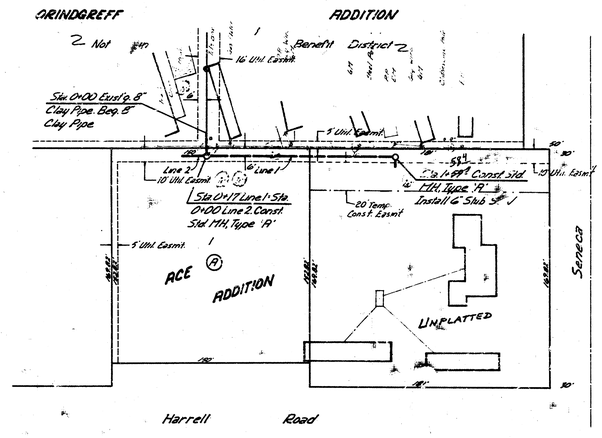


THE CONTRACTOR SHALL BE RESPONSIBLE FOR PRESERVING PROPERTY IRONS. THE CONTRACTOR SHALL BE REQUIRED TO RE-ESTABLISH ANY PROPERTY IRONS WHICH ARE DAMAGED OR DESTROYED BY HIS CONSTRUCTION OPERATIONS. SUCH IRONS SHALL BE RE-ESTABLISHED BY A LICENSED LAND SURVEYOR OR A LICENSED PROFESSIONAL ENGINEER IN ACCORDANCE WITH STATE LAWS.


SCALE
Horz 1"=40'
Vert 1"=5'


B.M. 8734 City Std. 76' N & 44' E. of E's Seneca & 47th St. So.

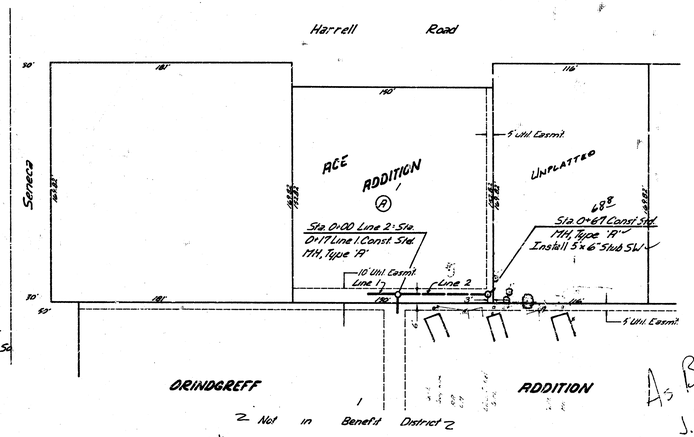

NOTE: CONTRACT SHALL GIVE ALL PROPERTY OWNERS AND/OR TENANTS OF DEVELOPED PROPERTY A MINIMUM ALWAYS NOTICE OF FORTY-EIGHT (48) HOURS PRIOR TO STARTING CONSTRUCTION.

As Built
J.H.
10/82

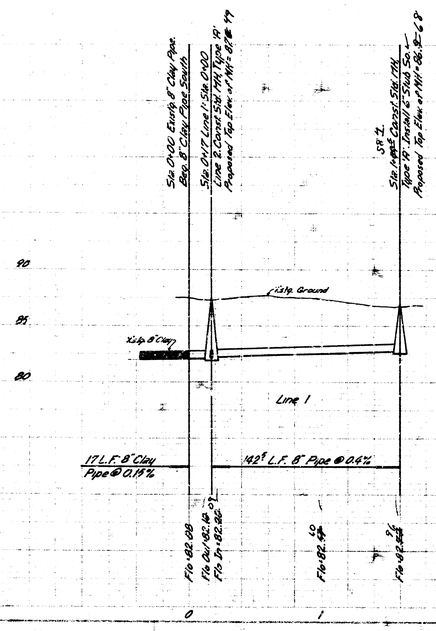

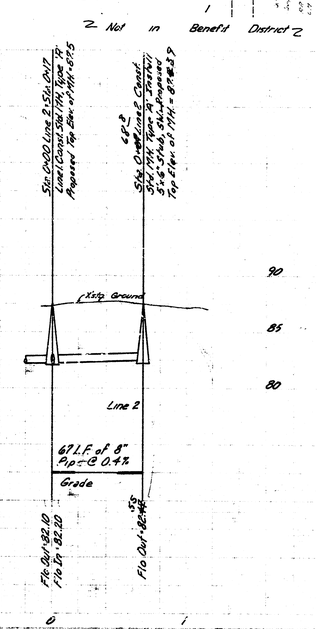



Lat. 33, Main 3, SWI
468-76-245-80923-000-000-001
City of Wichita, Kansas
Dept of Engineering - R.W. Bruggeman
Director of Engineering/City Engineer