
1 of 1

NOTE: PAVEMENT REWORK, IF ANY SHALL BE CONSIDERED INCIDENTAL TO THE PROJECT.


SCALE PLAN 1" = 40'
PROFILE 1" = 40' HORZ.
1" = 5' VERT.

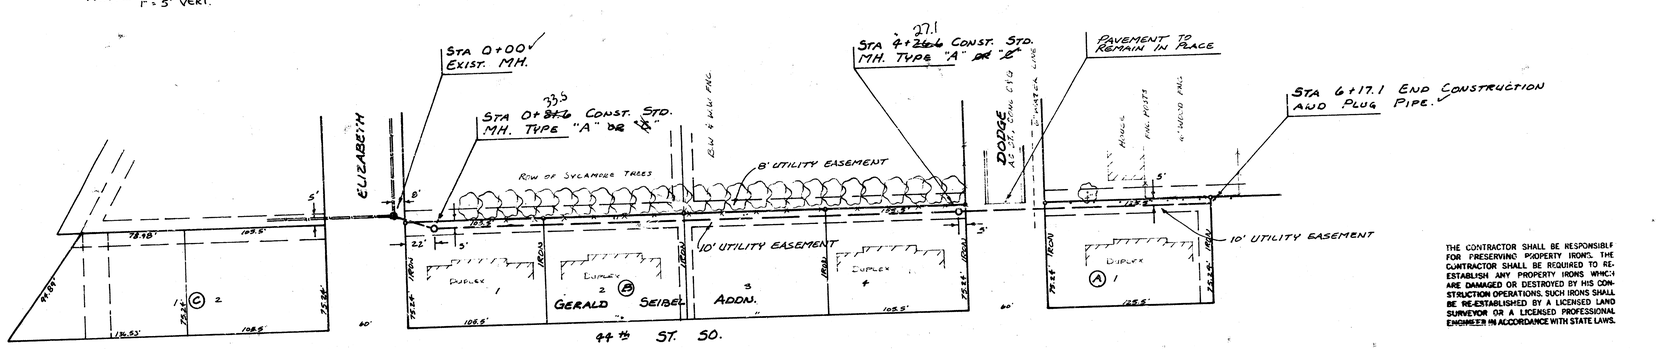

B.M. 88.008 CITY STD. DI-- 48' E. AND 92.8' S. OF E. SENECA AND 43.5' ST. SO. (E)

B.M. 86.43 "D" IN TOP CURB AT S. END OF CURB SECTION TO DOUBLE INLET E. SIDE ELIZABETH 215 N. OF NL. 44½ ST. S.

As Built J.L. 1-83

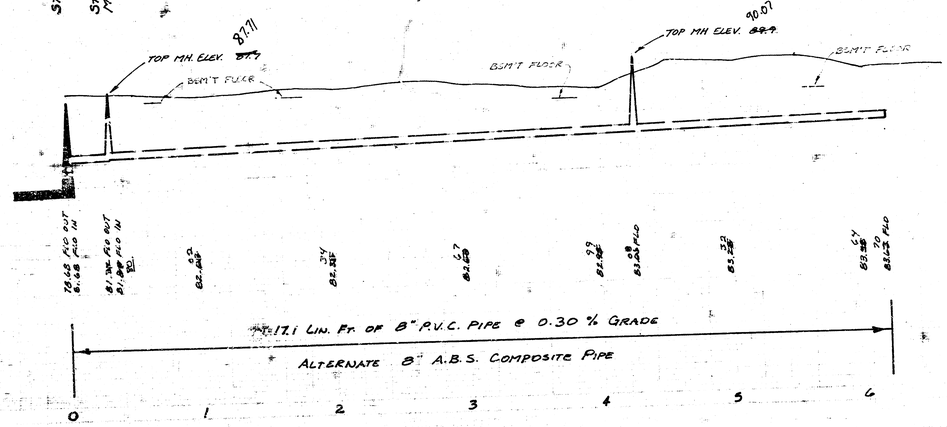

DONALD E. SCHICK LICENSED 6311 KANSAS PROFESSIONAL ENGINEER

PROJECT DESCRIPTION	
LAT. 35, MAIN 3, SW. INTERCEPTOR	
PROJECT NUMBER 468-76-245-81284-000-000-901	
W.O.K. NO. DCD-255	APPROVED BY-- DATE
DRAWN BY LOOMIS	REVISED
CITY OF WICHITA DEPARTMENT OF ENGINEERING	
M.E. LINDEBAK -CITY ENGINEER	SCALE 1" = 40'

THE CONTRACTOR SHALL BE RESPONSIBLE FOR PRESERVING PROPERTY IRONS. THE CONTRACTOR SHALL BE REQUIRED TO RE-ESTABLISH ANY PROPERTY IRONS WHICH ARE DAMAGED OR DESTROYED BY HIS CONSTRUCTION OPERATIONS. SUCH IRONS SHALL BE RE-ESTABLISHED BY A LICENSED LAND SURVEYOR OR A LICENSED PROFESSIONAL ENGINEER IN ACCORDANCE WITH STATE LAWS.

FILMED FROM THE BEST AVAILABLE COPY....