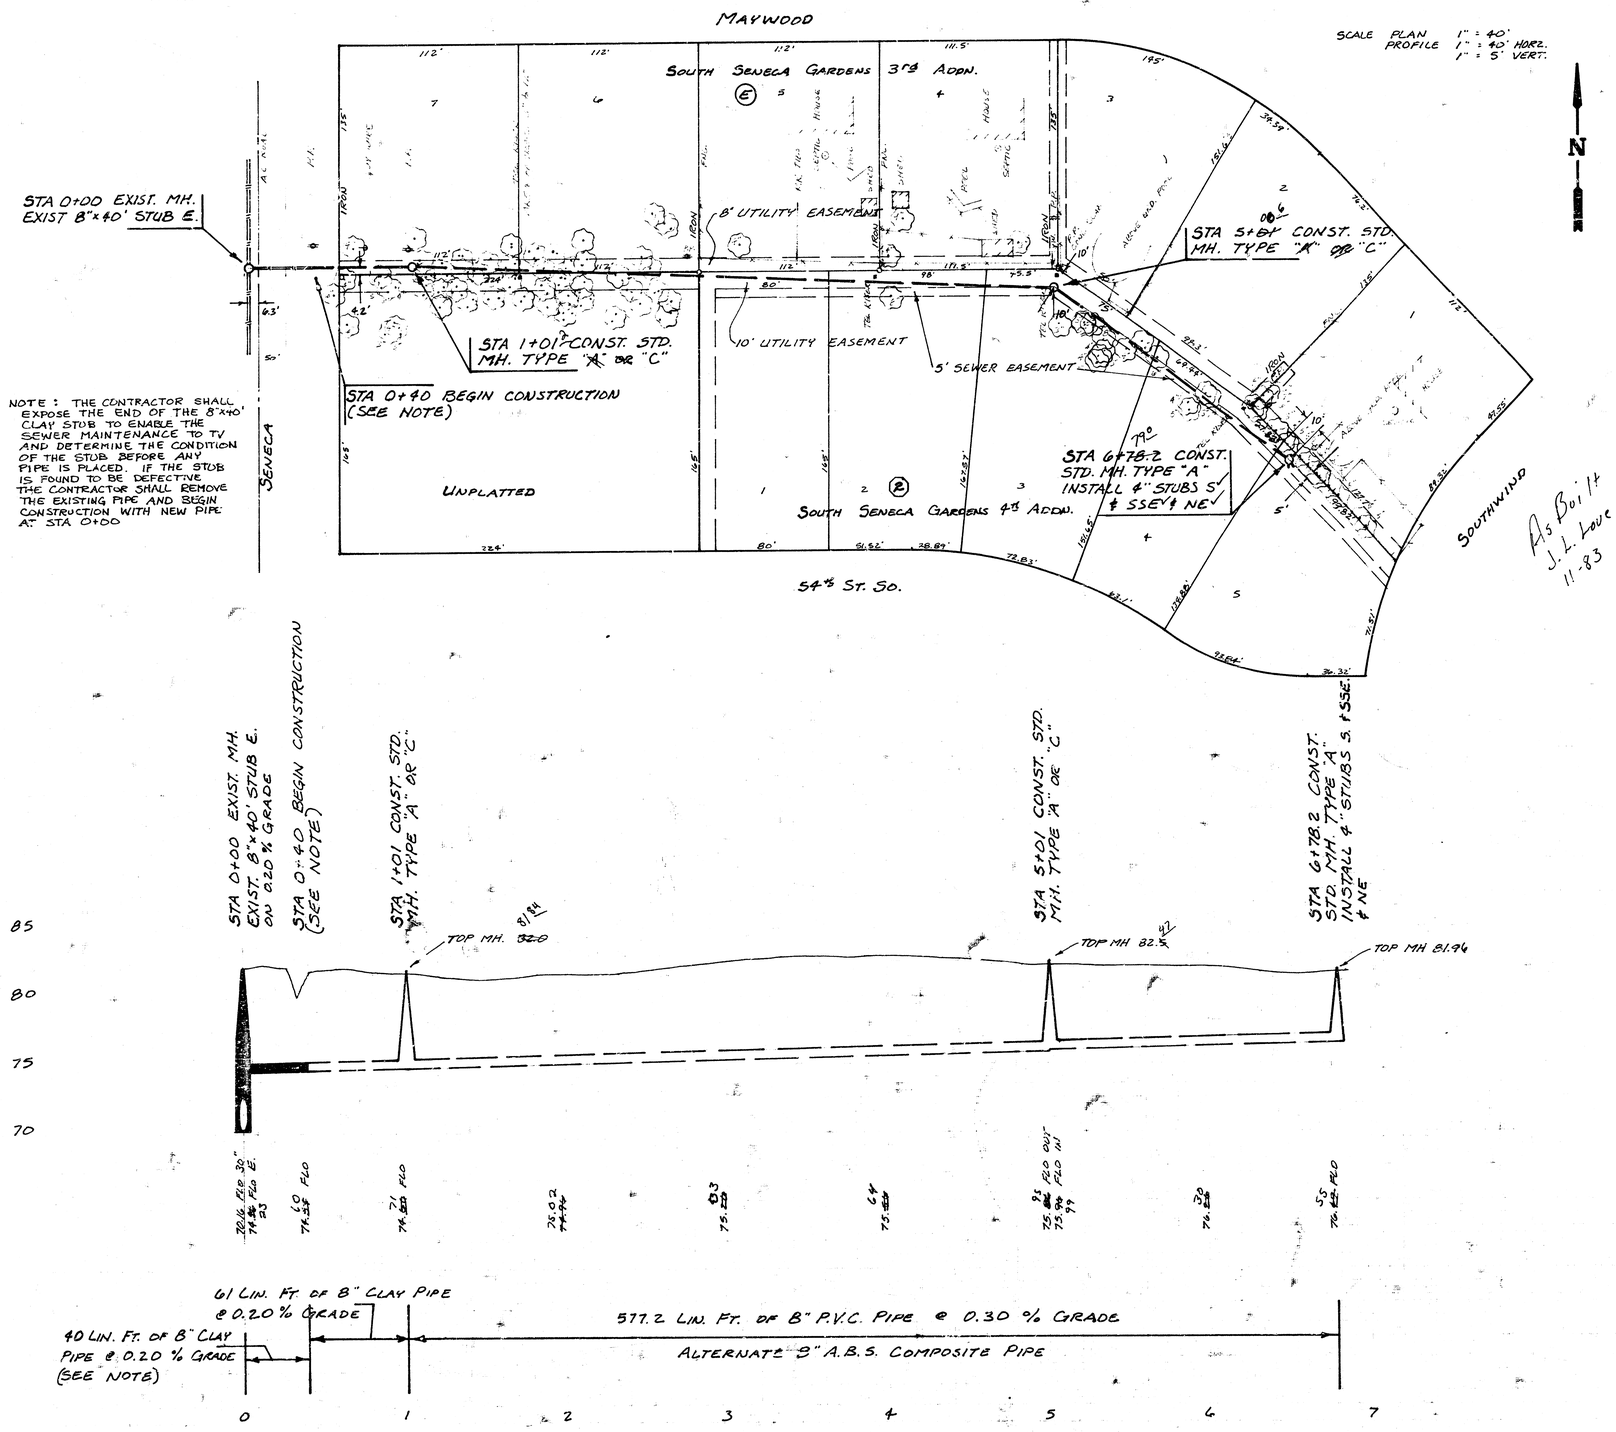


SCALE PLAN 1" = 40'
PROFILE 1" = 40' HORZ.
1" = 5' VERT.

CAUTION
UNDERGROUND UTILITIES
Please check with K G & E or Southwestern Bell Telephone Co. for Location

THE CONTRACTOR SHALL BE RESPONSIBLE FOR PRESERVING PROPERTY IRONS. THE CONTRACTOR SHALL BE REQUIRED TO RE-ESTABLISH ANY PROPERTY IRONS WHICH ARE DAMAGED OR DESTROYED BY HIS CONSTRUCTION OPERATIONS. SUCH IRONS SHALL BE RE-ESTABLISHED BY A LICENSED LAND SURVEYOR OR A LICENSED PROFESSIONAL ENGINEER IN ACCORDANCE WITH STATE LAWS.

As Built
J.L. Love
11-83

B.M. 80.72 CITY STD. DISC. 30' S. & 45' E. OF ℄ BOTH SENECA AND 55th ST. SO.

B.M. 81.22 NUT EAST FACE P.P. ON THE WEST SIDE SENECA BETWEEN MAYWOOD AND 54th ST. SO.

B.M. 83.87 S.W. CORNER PORCH HOUSE @ 5510 SOUTHWIND

DONALD E. SCHNEIDER LICENSED 6311 KANSAS PROFESSIONAL ENGINEER

PROJECT DESCRIPTION
LAT. 37, MAIN 3, SW. INTERCEPTOR

PROJECT NUMBER
468-76-245-80853-000-000-001

BOOK NO. MG-39	APPROVED BY	DATE 9-83
DRAWN BY LOOMIS		REVISED

CITY OF WICHITA
DEPARTMENT OF ENGINEERING

DIRECTOR OF ENG./CITY ENGINEER	SCALE
R. W. BRUGGEMAN	1" = 40'