
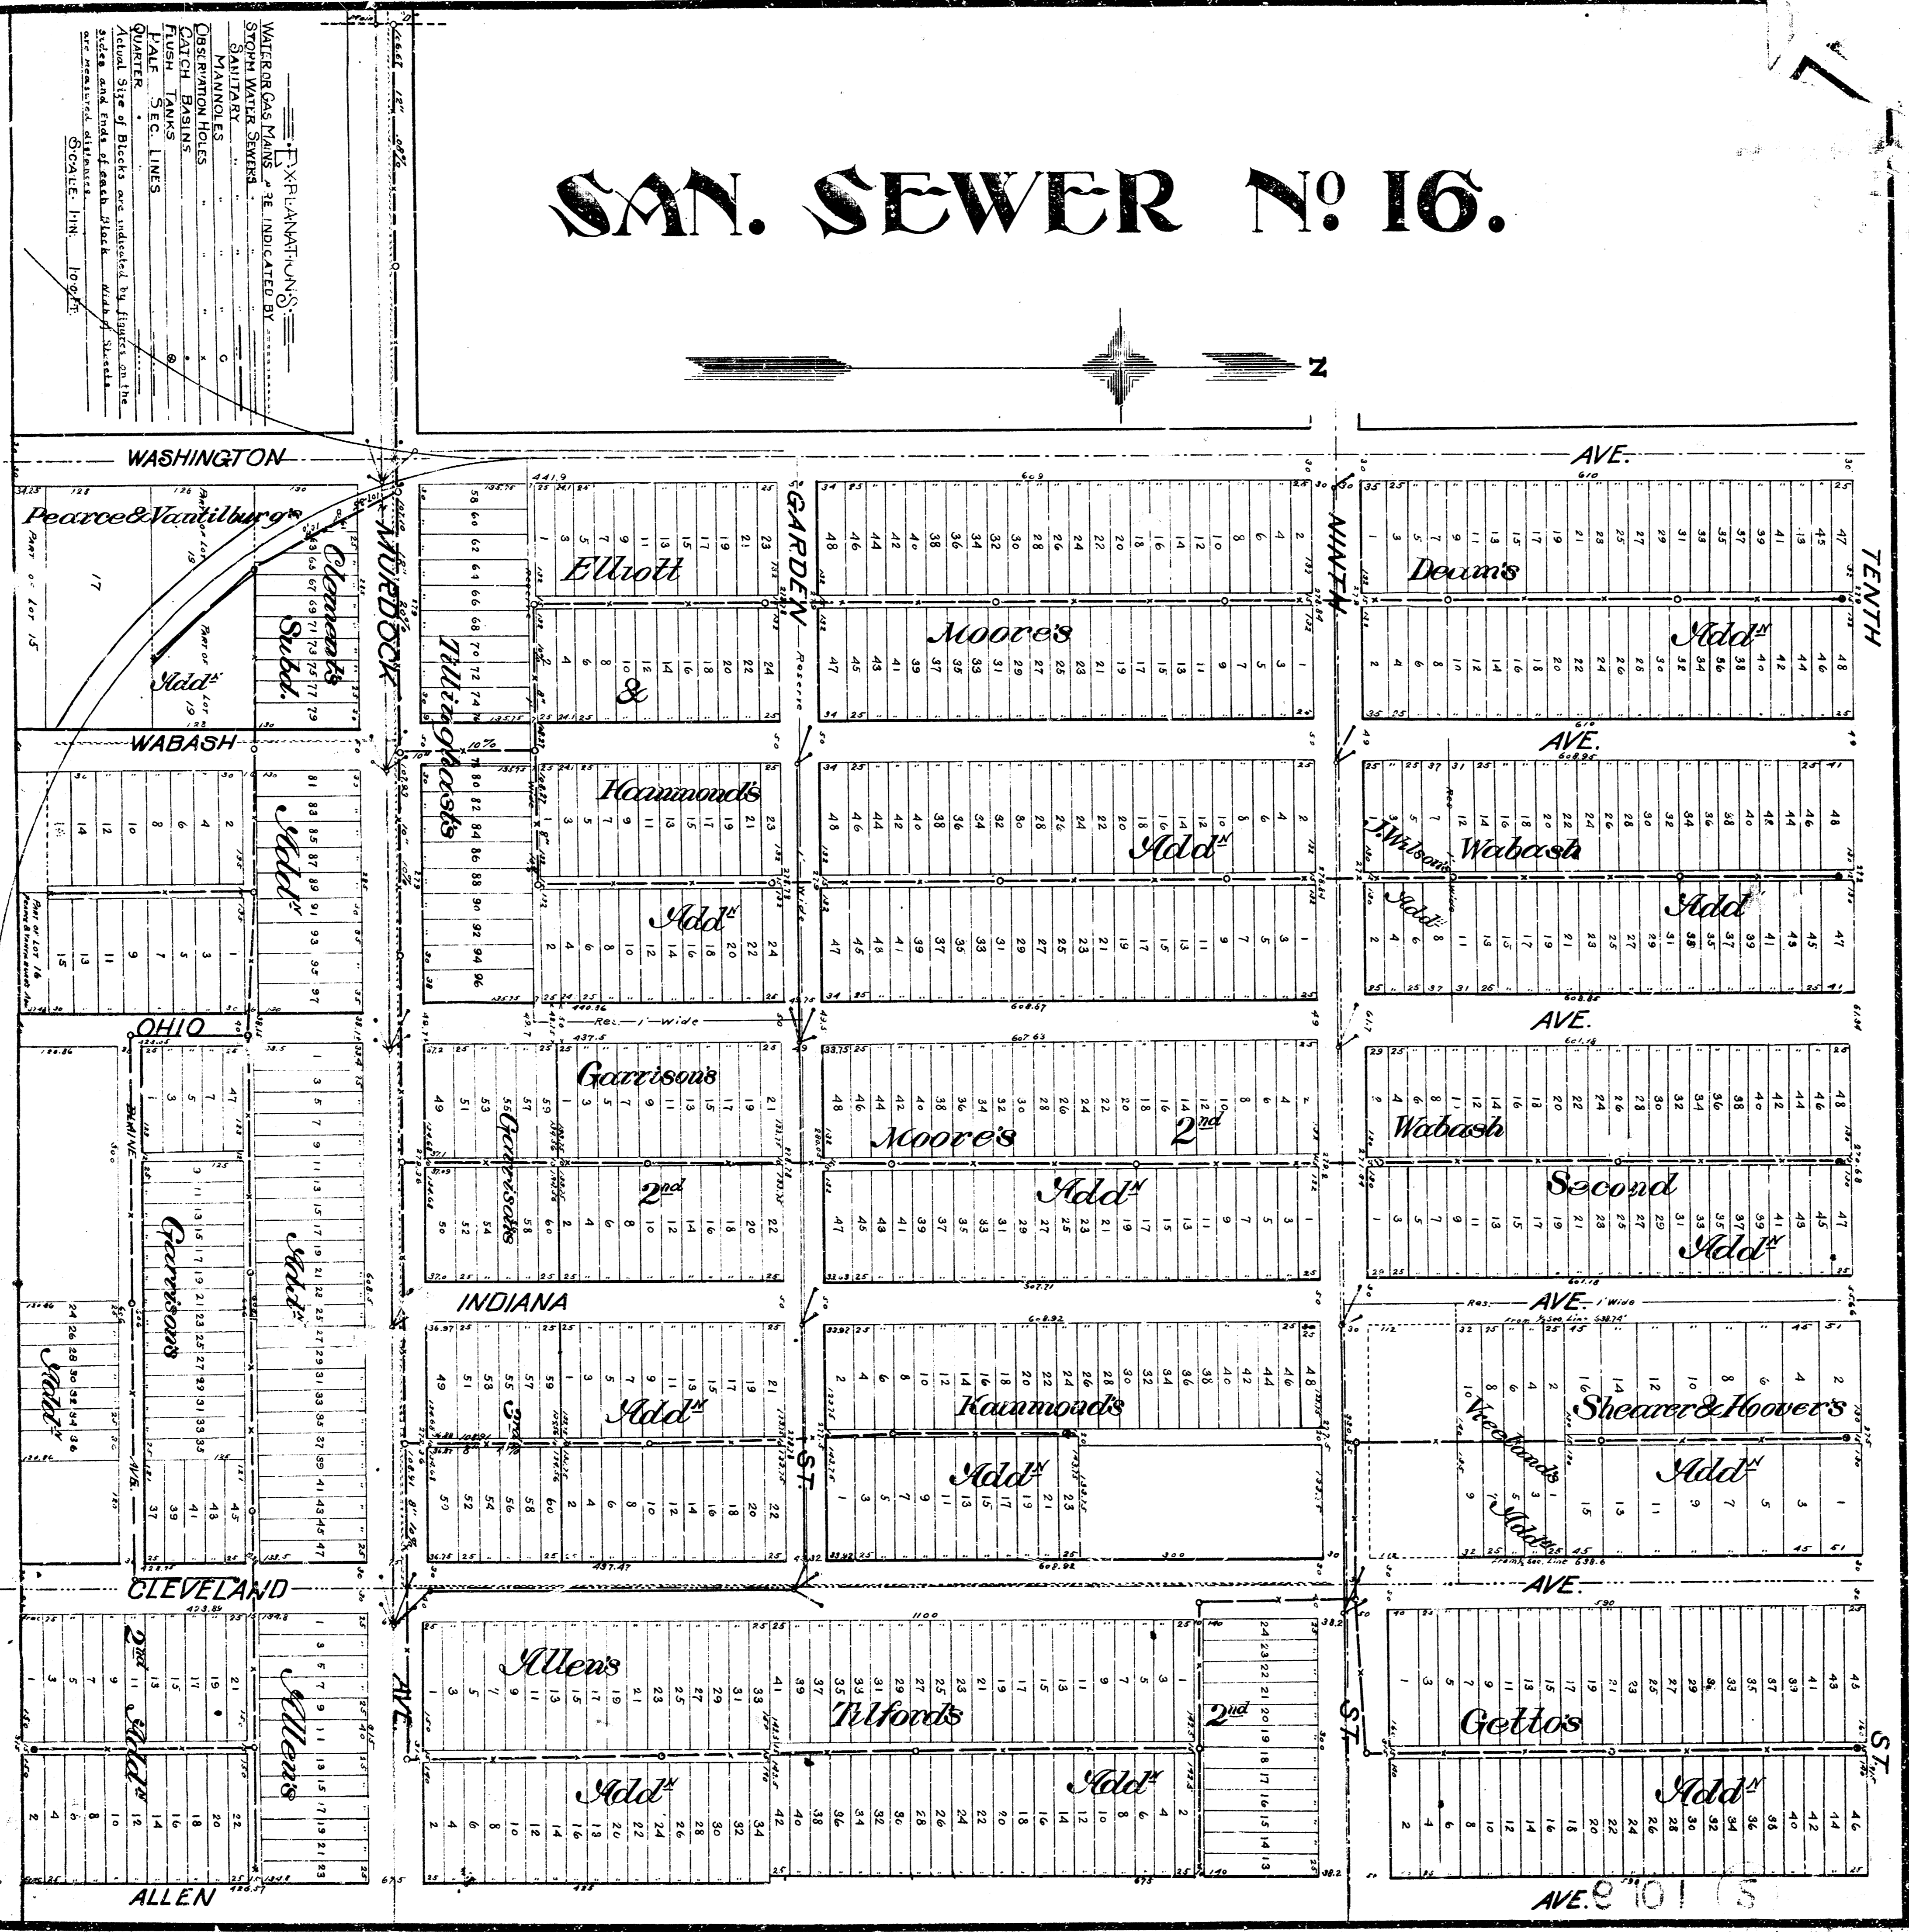


SAN. SEWER N^o 16.

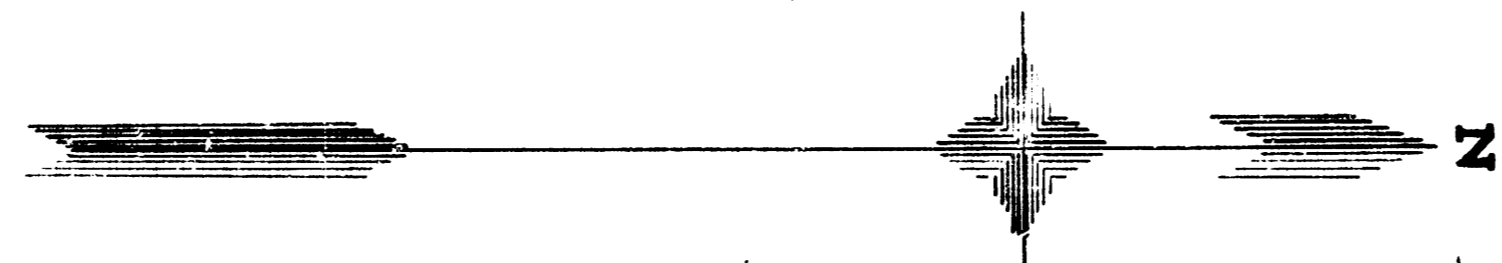

EXPLANATIONS

WATER GAS PIPES & CABLES ARE INDICATED BY DOTTED LINES







SCALE: 1 IN = 10 FT

RAILROAD

RAILROAD

RAILROAD

RAILROAD