


LAT. L. DIST. 6 S.S. 12

LAT. 14 S.S. 20

B.M. Elev. 118.03 N.S. of M.H. rim on 15th St @ alt. 54' between Washington & Wabash.

B.M. Elev. 109.26 Iron in
Humble ckr Smythe Ave
& S.S. of Maple St.

LAT G
S.S. 21

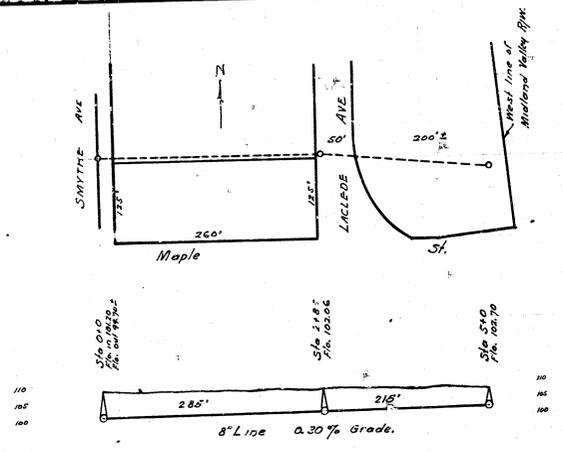

LAT 18 DIST A S.S. 21

B.M. Elev. 117.76 "K" in Kessler c. n.w. S.W. Edwards & 2nd
B.M. Elev. 116.99 Rim of M.H. E. of Edwards & Riv.
B.M. Elev. 119.52 On Tracks 1st Joint W. of Edwards

