



Date 5-13-54
 Drawn by McGinn
 Checked by [unclear]
 No. [unclear]

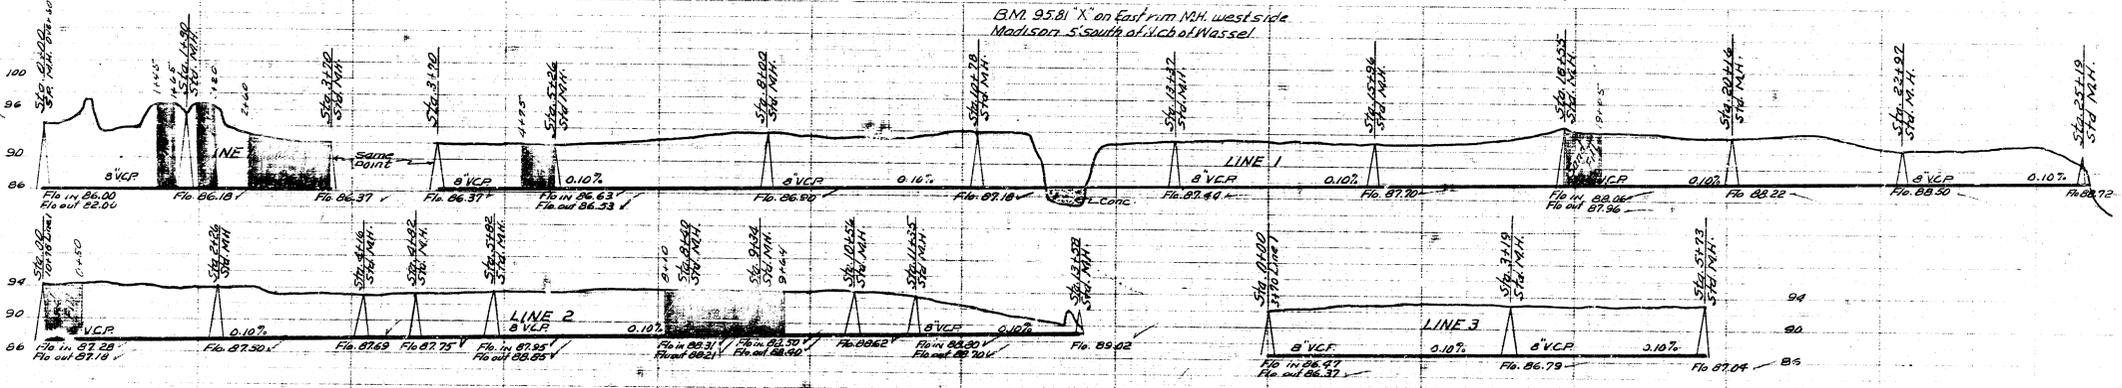

Note: All 6 stubs to be laid on 2.20% Gr.

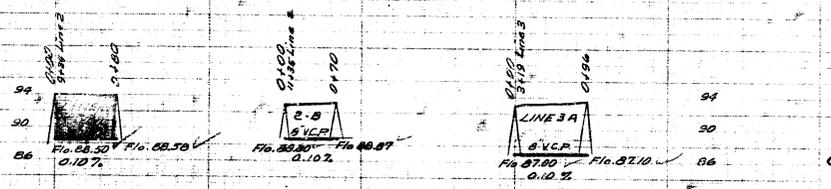

LAT 39 S.520
 CITY OF WICHITA KANSAS
 B.E. SMITH, CITY ENGINEER
 Proj. No. C-23-64