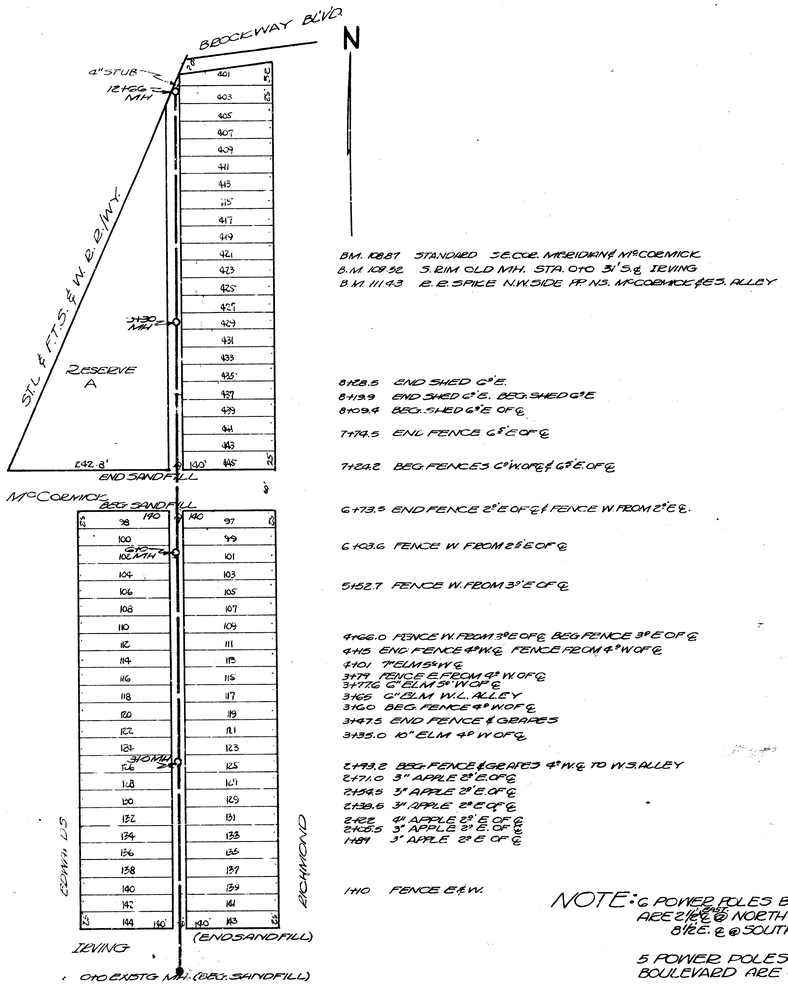


B.M. R887 STANDARD S.E.COR. MERIDIAN & McCORMICK.
B.M. 109.52 S. RIM OLD MH. STA. 010 31'S.& IRVING
B.M. 111.43 R.R. SPIKE N.W. SIDE PP N.S. McCORMICK & E.S. ALLEY


8+28.5 END SHED 6° E.
8+13.9 END SHED 0° E. BEG. SHED 6° E
8+09.4 BEG. SHED 6° E OF ℄
7+79.5 ENC. FENCE 6° E OF ℄
7+62.2 BEG. FENCE E.S 0° W OF ℄ & 6° E OF ℄
6+73.3 END FENCE 2° E OF ℄ & FENCE W. FROM 2° E ℄.
6+03.6 FENCE W. FROM 2° E OF ℄
5+52.7 FENCE W. FROM 3° E OF ℄
4+66.0 FENCE W. FROM 3° E OF ℄ BEG. FENCE 3° E OF ℄
4+15 ENC. FENCE 4° W ℄ FENCE FROM 4° W OF ℄
4+01 7" ELM 5+4 W ℄
3+79 FENCE E FROM 9° W OF ℄
3+77.6 6" ELM 5° W OF ℄
3+65 6" ELM W.L. ALLEY
3+60 BEG. FENCE 4° W OF ℄
3+47.5 END FENCE & GEARES
3+35.0 10" ELM 4° W OF ℄
2+93.2 BEG. FENCE & GEARES 4° W ℄ TO W.S. ALLEY
2+77.0 3" APPLE 2° E. OF ℄
2+54.5 3" APPLE 2° E. OF ℄
2+38.6 3" APPLE 2° E OF ℄
2+12.2 4" APPLE 2° E OF ℄
2+05.5 3" APPLE 3° E. OF ℄
1+89.1 3" APPLE 2° E OF ℄

1+10 FENCE E & W.

1. O10 EXISTG MH. (BEG. SANDFILL)

NOTE: 6 POWER POLES BET. IRVING & McCORMICK
AEE 2½'E. @ NORTH END
8½'E. @ SOUTH END

5 POWER POLES BET. McCORMICK & BROOKWAY BOULEVARD AEE 6° East OF ℄.

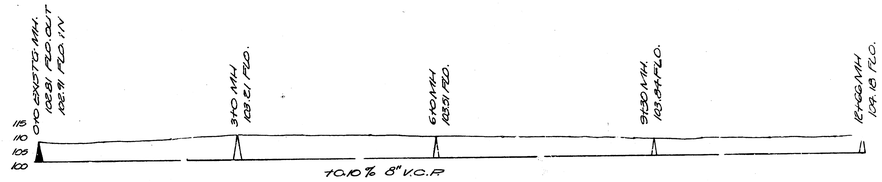

10.10 % 8" V.C.P.

LATERAL 5, DISTRICT B, 55th & 21

CITY OF WICHITA, KANSAS
L.C. White ···· City Engineer
DATE: 7-29-50 Proj. No. C20-44