

SURVEY BY ANGUS
DRAWN BY JOHN V
TRACED BY
CHKD BY

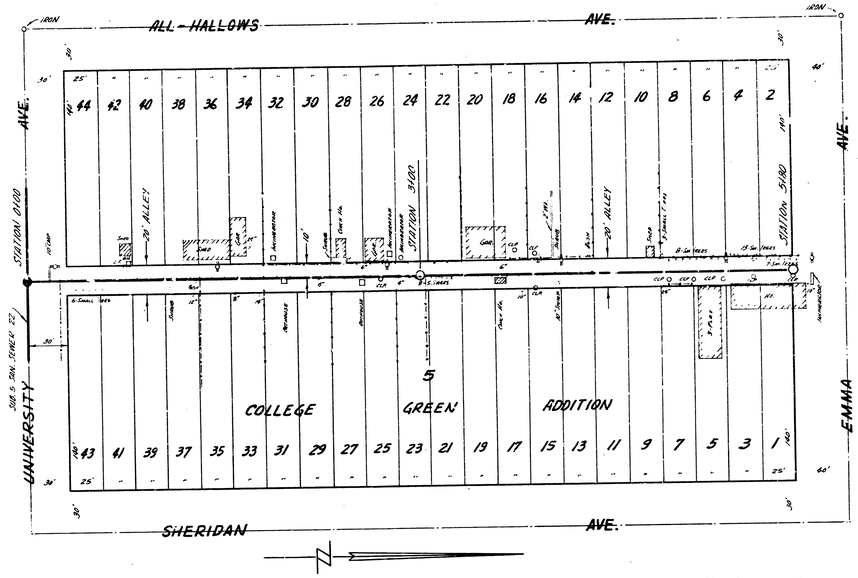

B.M. 113.29 RR SPIKE ES PP NS. UNIV. WL. ALLEY SO.
B.M. 114.64 RR SPIKE ES PP SS EMMA WL. ALLEY SO.
B.M. 115.41 N.W. COR. CONC. PO HO 402 SHERIDAN

PLAN SCALE 1"=40' HOR.
PROFILE SCALE 1"=40' HOR, 1"=4' VERTICAL

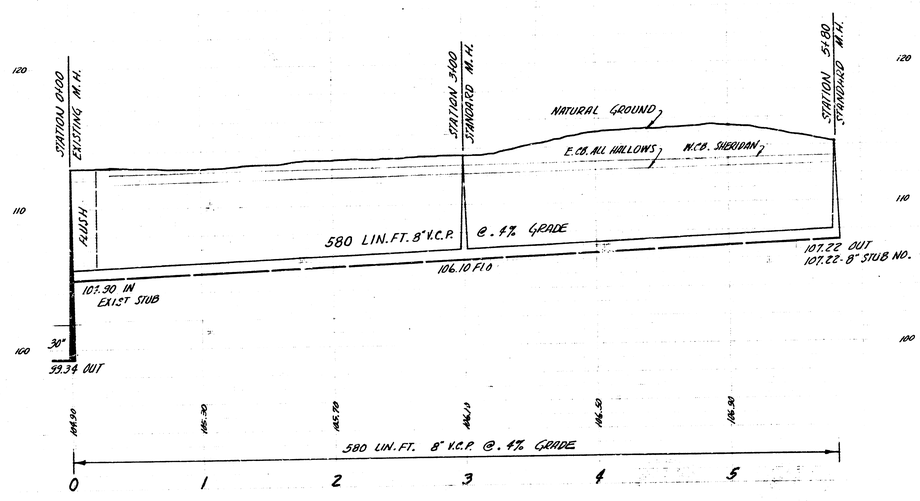

LAT. 5 SUB. 5 SAN. SEWER 22
CITY OF WICHITA, KANSAS
B.E. SMITH CITY ENGINEER
PROJ. NO. C25-110 DATE- JAN. '63