
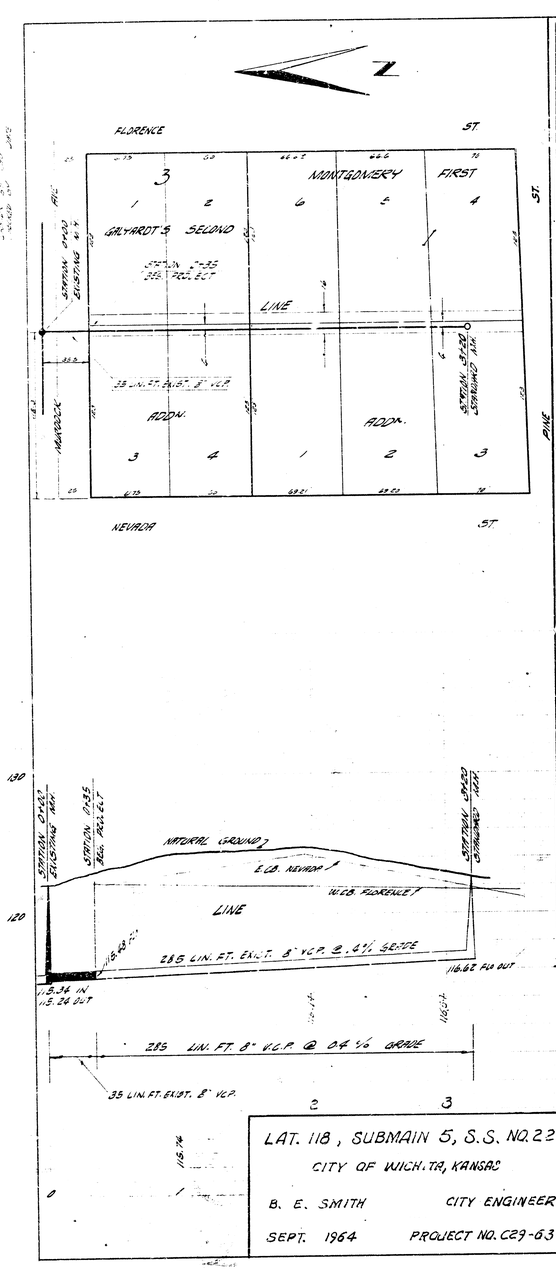



LAT. 118, SUBMAIN 5, S.S. NO. 22
CITY OF WICHITA, KANSAS
B. E. SMITH CITY ENGINEER
SEPT. 1964 PROJECT NO. C29-63

PLAN SCALE 1"=40'
PROFILE SCALE 1"=40' HOR, 1"=4' VERT.

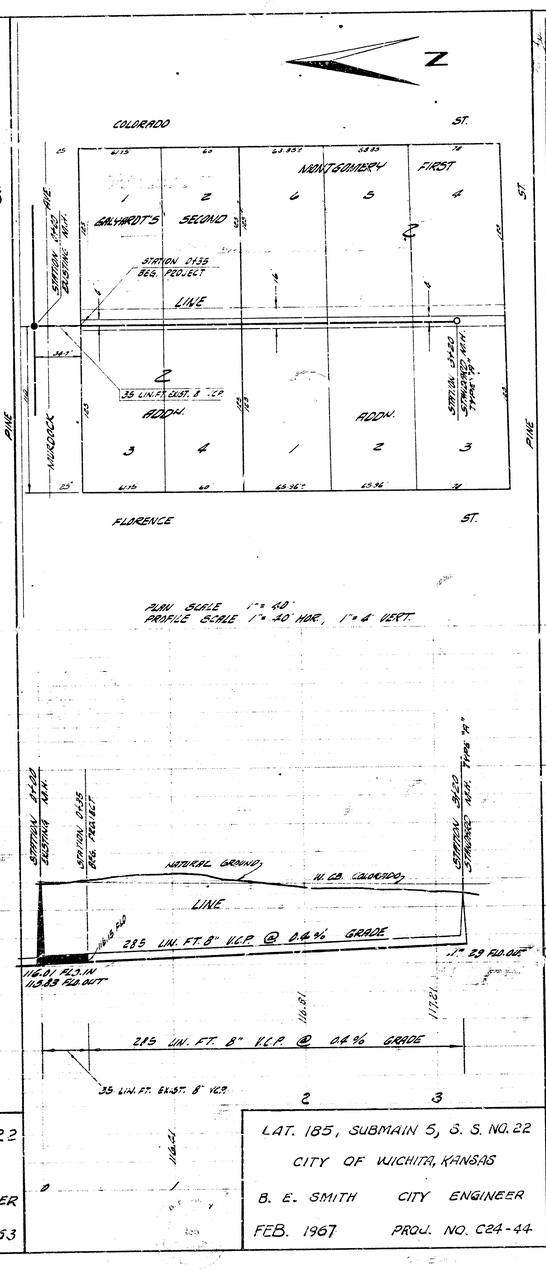

LAT. 185, SUBMAIN 5, S. S. NO. 22
CITY OF WICHITA, KANSAS
B. E. SMITH CITY ENGINEER
FEB. 1967 PROJ. NO. C24-44

B.M. 123.49 S.E. CAR. CONC. PORCH NO. # 221 N. COLORADO
Plan Scale 1"=40'
Profile Scale Horz. 1"=40' Vert. 1"=4'

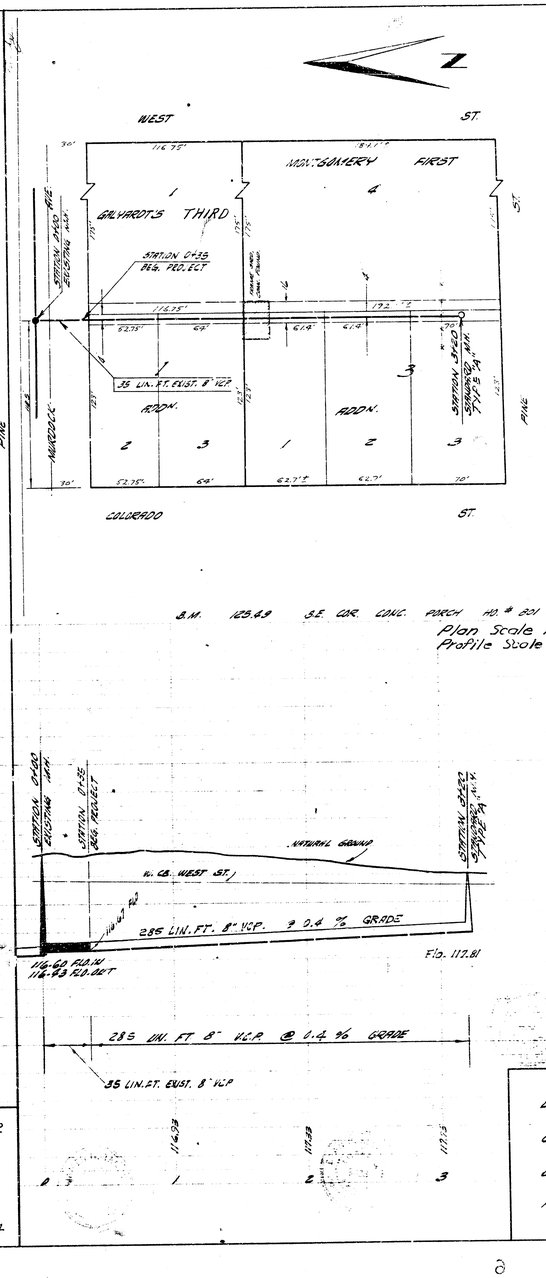

LATERAL 186 SUB. 5 S.S. 22
CITY OF WICHITA, KANSAS
B.E. SMITH, CITY ENGINEER
PROJ. NO. C24-45 DATE JULY 1968