
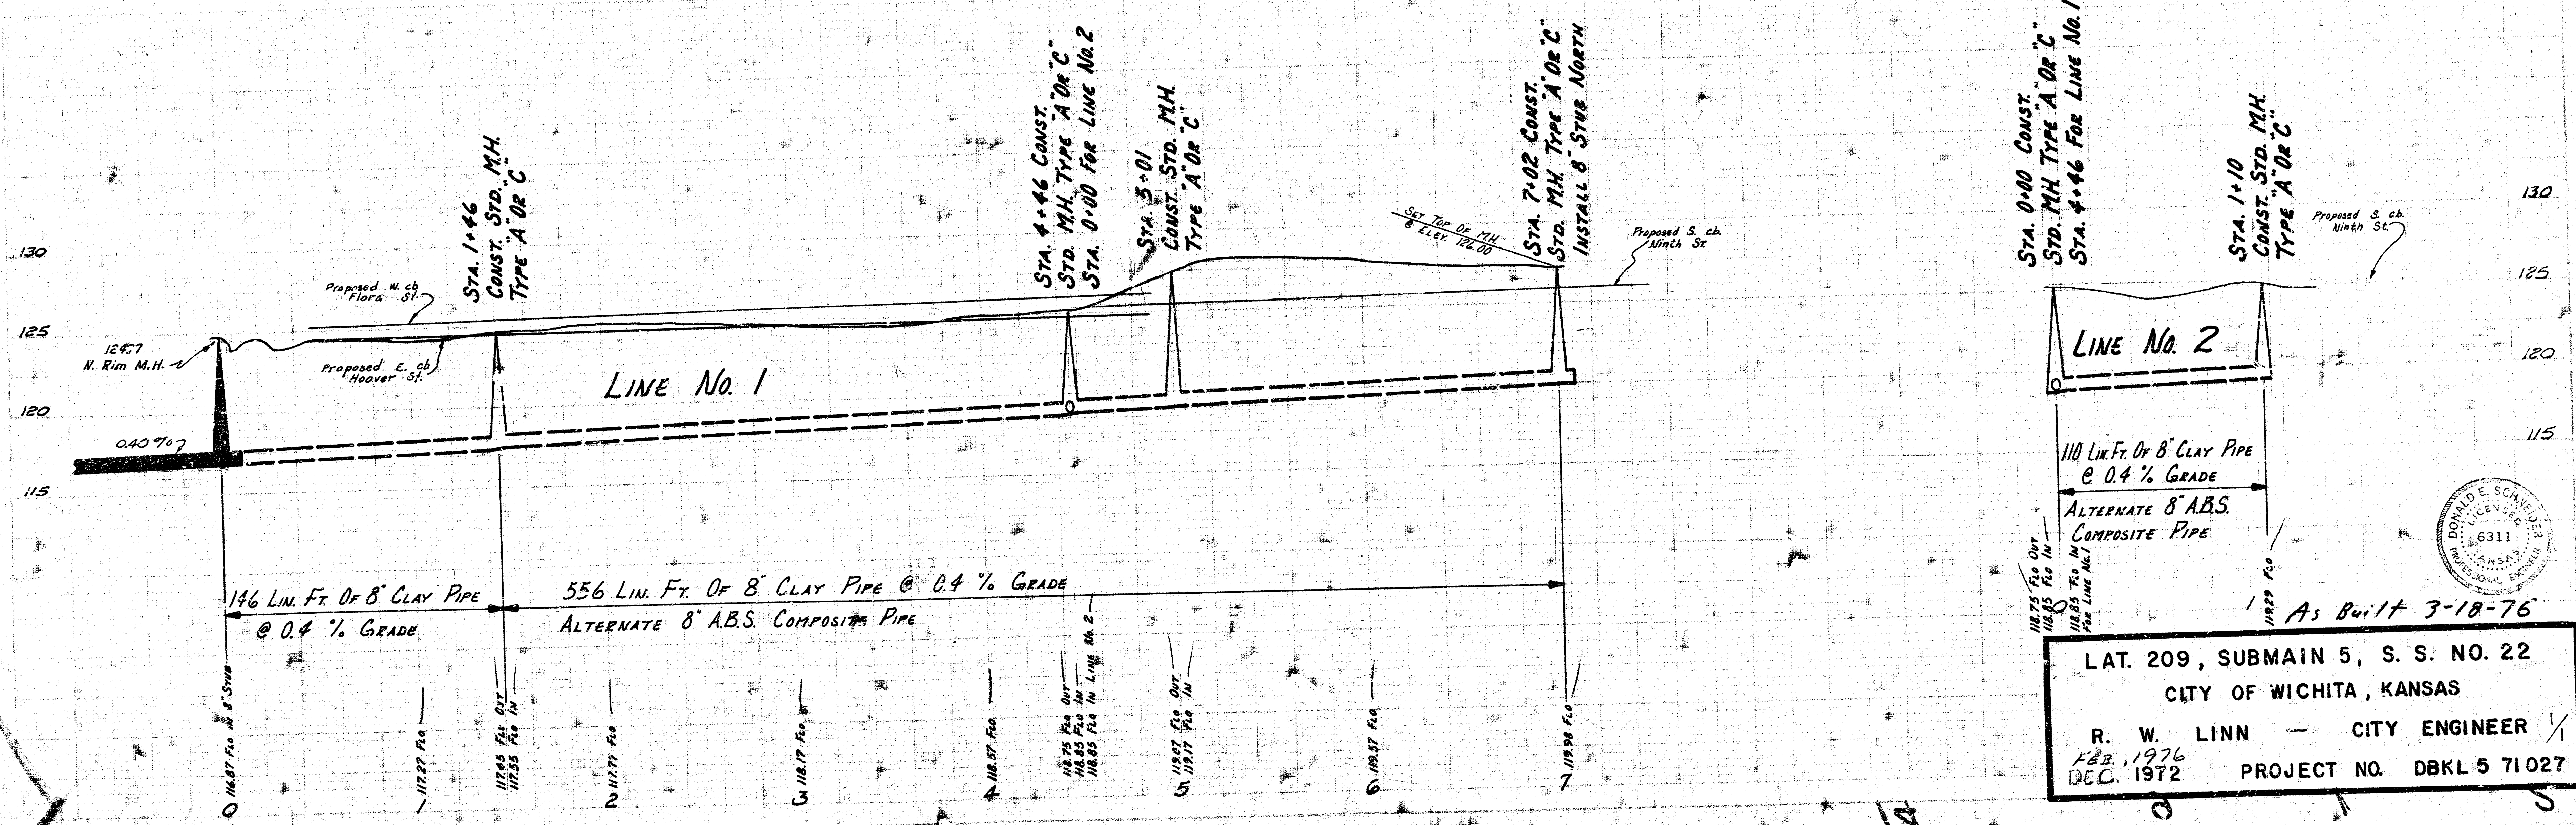


B. M. 124.52 S.W. cor. conc. slab
 @ S. door of house @ N.E.
 cor. Murdock & Hoover.
 B. M. 126.76 "M" in Mueller, Fire
 Hyd. S. E. cor. 8th & Hoover.

Plan Scale 1" = 40' Horiz.
 Profile Scale 1" = 5' Vert.

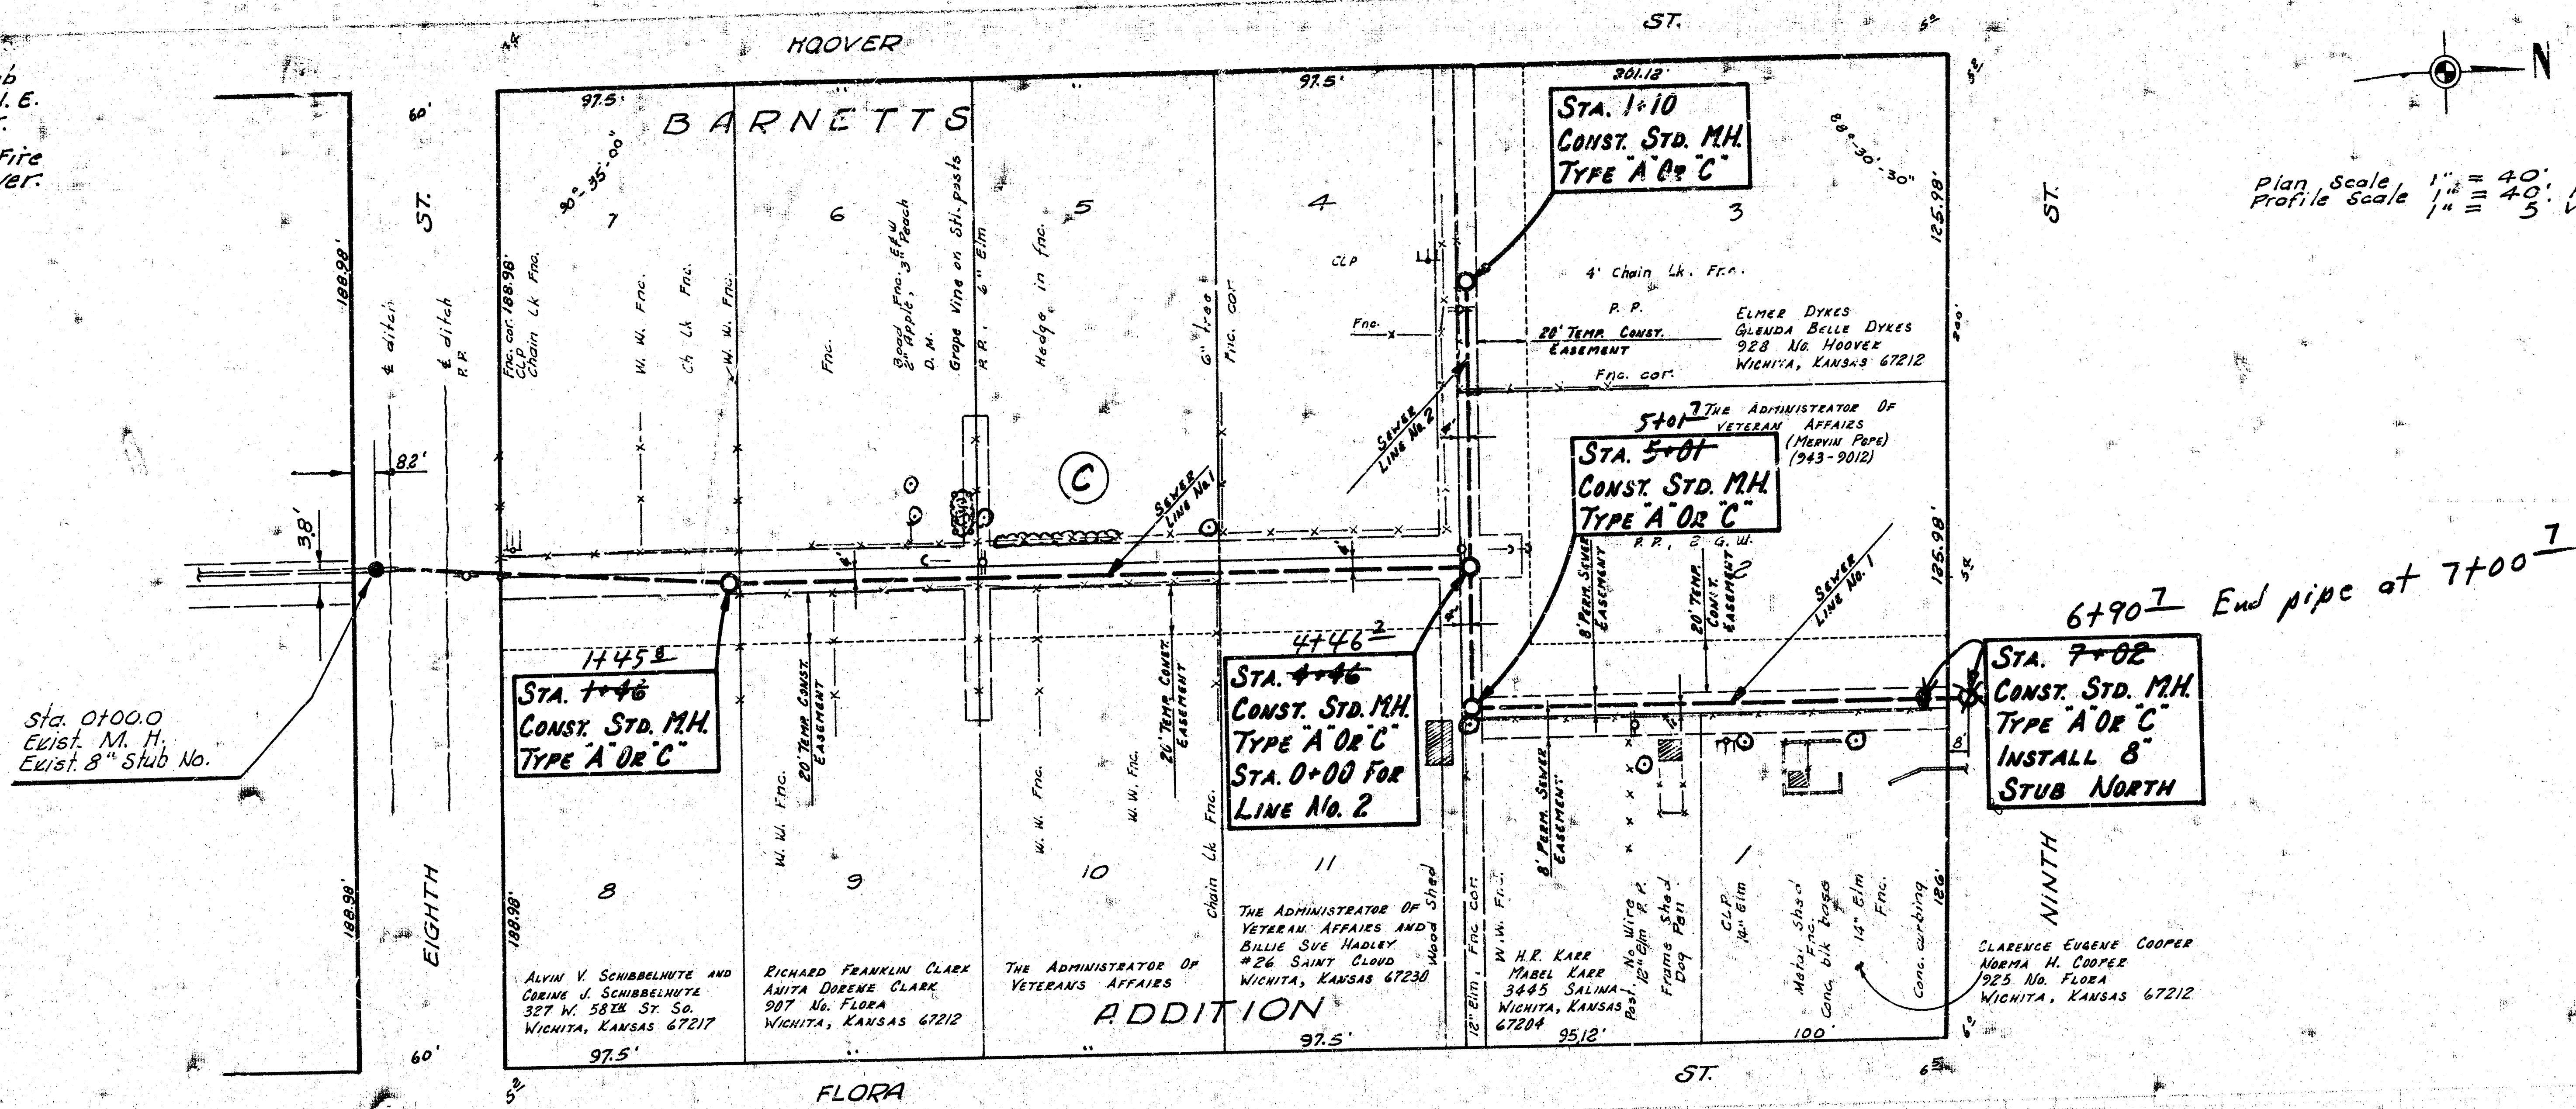

LAT. 209, SUBMAIN 5, S. S. NO. 22
 CITY OF WICHITA, KANSAS
 R. W. LINN — CITY ENGINEER
 FEB. 1976
 DEC. 1972 PROJECT NO. DBKL 5 71027