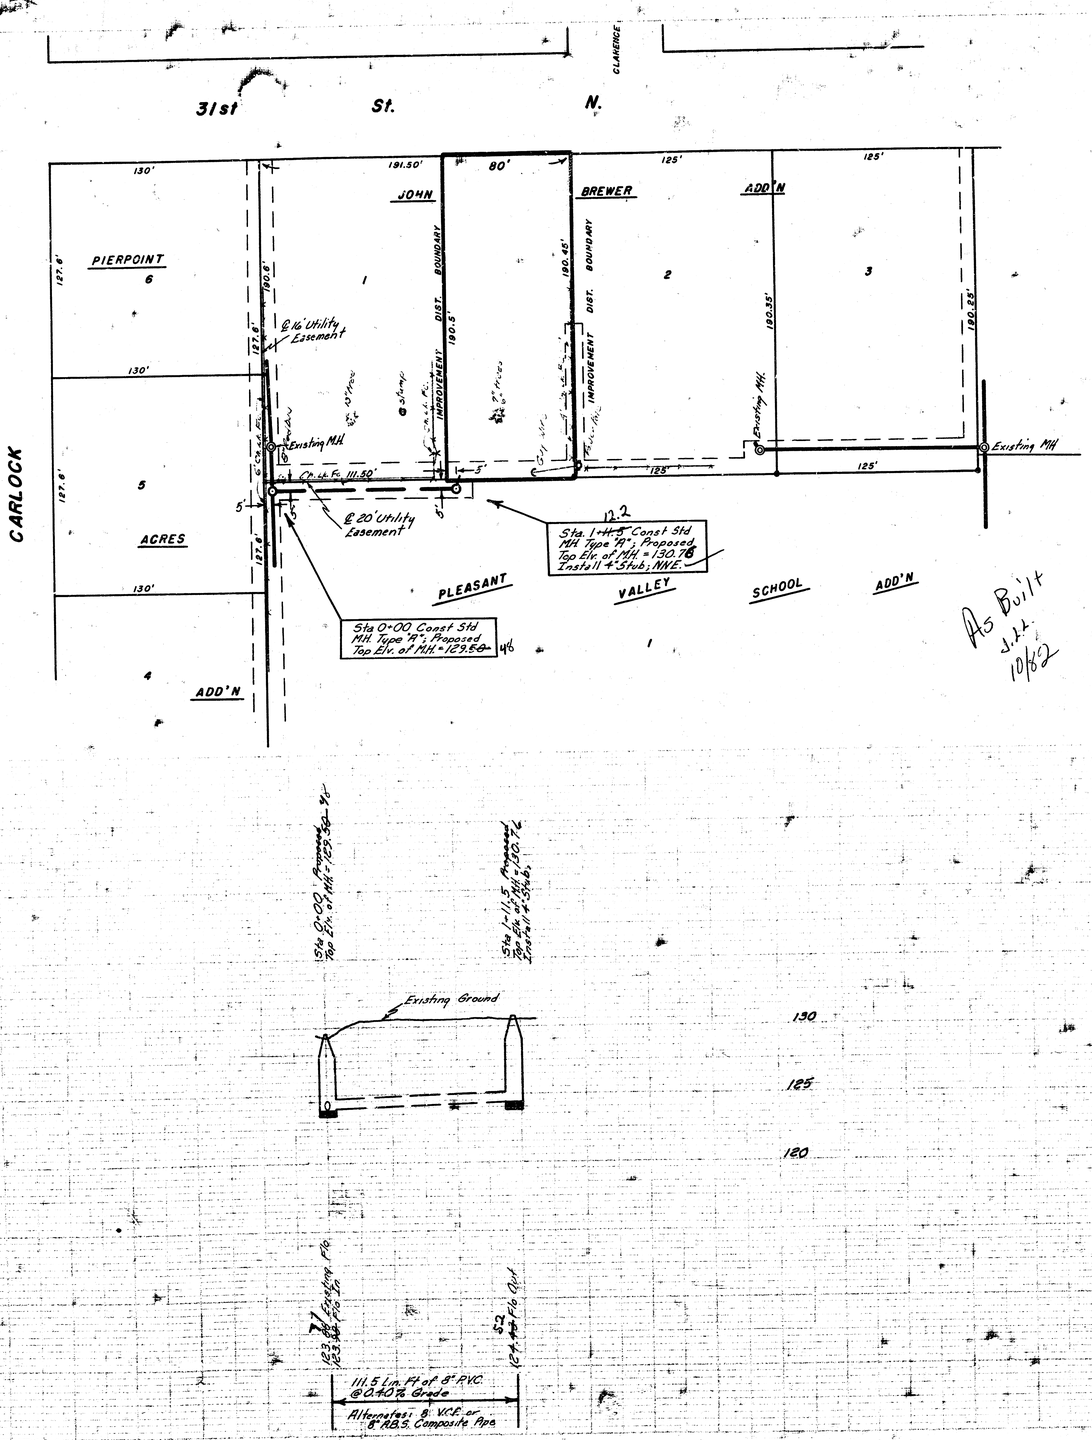

N

SCALE: 1" = 40' Plan
Horz. 1" = 40' Profile
Vert. 1" = 5'

Bench Marks: 130.49 - RR-Spk in S. face of power pole, 62'± N. of S.L. 30th St. No. extended and 138' E. of E.L. Charles.
129.78 - 'D' Cut in top of N. Curb, 31st St. No. @ E.L. Charles.

THE CONTRACTOR SHALL BE RESPONSIBLE FOR PRESERVING PROPERTY IRONS. THE CONTRACTOR SHALL BE REQUIRED TO RE-ESTABLISH ANY PROPERTY IRONS WHICH ARE DAMAGED OR DESTROYED BY HIS CONSTRUCTION OPERATIONS. SUCH IRONS SHALL BE RE-ESTABLISHED BY A LICENSED LAND SURVEYOR OR A LICENSED PROFESSIONAL ENGINEER IN ACCORDANCE WITH STATE LAWS.

NOTE: CONTRACTOR SHALL GIVE ALL OWNERS AND/OR TENANTS OF DEVELOPED PROPERTY DIRECTLY AFFECTED BY THE CONSTRUCTION OF THIS PROJECT A MINIMUM ADVANCE NOTICE OF FORTY-EIGHT (48) HOURS PRIOR TO STARTING CONSTRUCTION.

DONALD E. SCHNEIDER 6311 KANSAS REGISTERED PROFESSIONAL ENGINEER

LAT. 68, MAIN 17, S.S. NO. 22
CITY OF WICHITA, KANSAS
R.W. BRUGGEMAN
DIRECTOR OF ENGINEERING/ CITY ENGINEER
PROJ. NO. 468-76-245-81075-000-000-001

Sheet 1 of 1

10 8 3 1