
CITY OF WICHITA, KANSAS


SANITARY SEWER IMPROVEMENTS

LATERAL 73, MAIN 17, SANITARY SEWER # 22

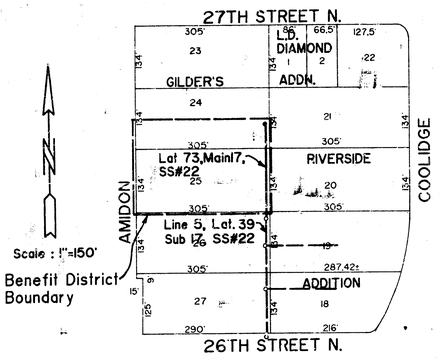

LOCATION MAP

Michael E. Lindebak, P.E., City Engineer

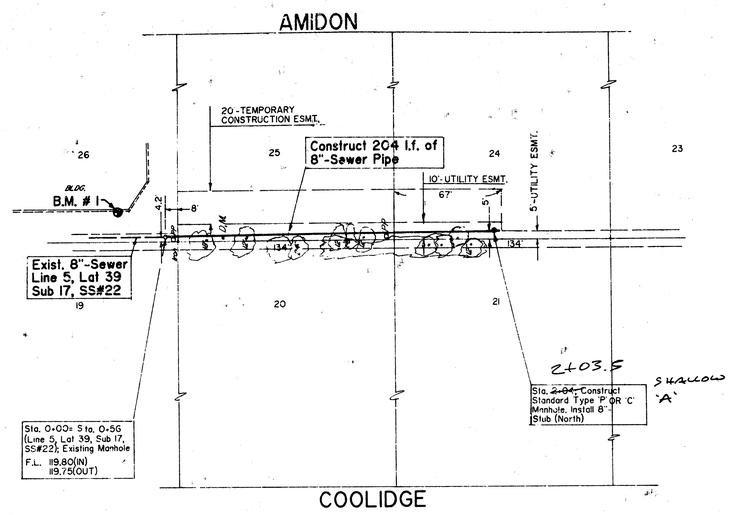

SCALE :
Plan : 1"=40'
Profile : 1"=40' (H)
1"= 5' (V)

NOTES :

1. Trees and shrubs which are in direct conflict with proposed new construction shall be removed by the Contractor with the Engineer's approval. Trees and shrubs which are not in direct conflict with the proposed new construction shall be saved and protected from damage. The cost of any necessary tree trimming and/or grubbing shall be included in the price bid for installed sewer pipe.

2. Power Poles(PP) shown on the plan are owned by Southwestern Bell Telephone Co.. The Contractor shall give the telephone company (Bob Aley, Tel: 265-2256) at least 30 days advance notice before construction so that the power poles may be adjusted and/or relocated.

AS BUILT RDL 2-88

B.M. # 1 : 'a' Cut in conc. footing of building ; 30' South & 19' West of NE Corner of Lot 26, Gilder's riverside Addition, Elev.= 127.52

B.M. # 2 : City of Wichita Standard disk : 44.5' West & 3.8' South of C/L of 25th & Amidon Elev.= 126.34

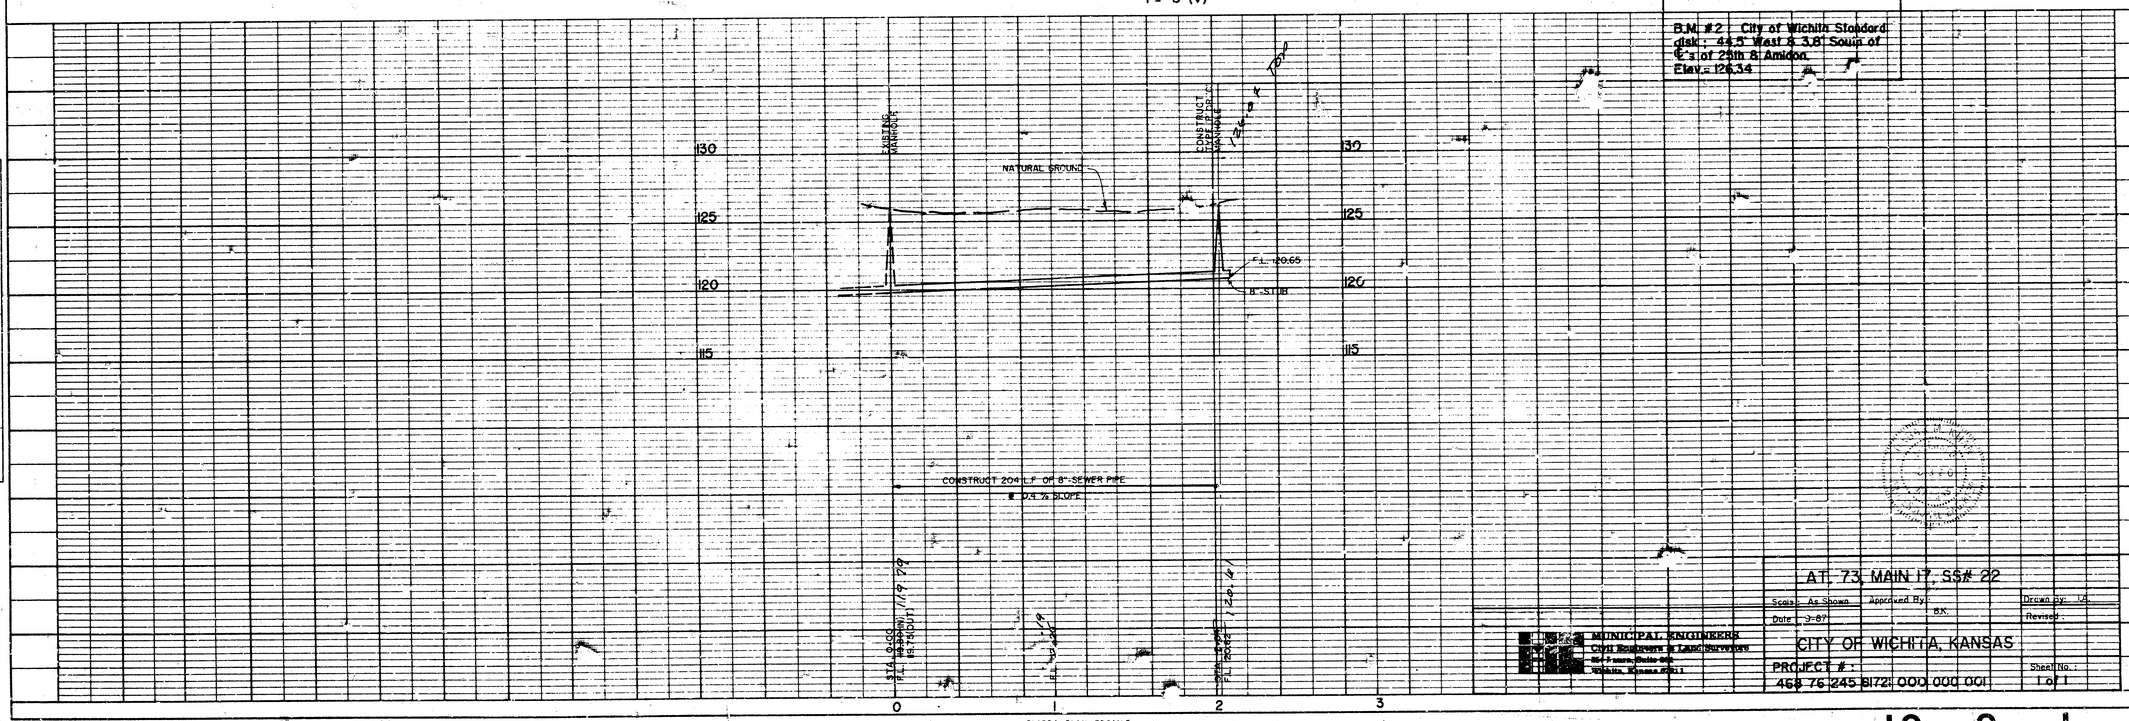


PLATE 1 - PLAN - PROFILE - F A S
DIAZPRINT PAPER CO. OF CAL
NO 1000H !

MUNICIPAL ENGINEERS
Civil Engineers & Land Surveyors
[illegible]
Wichita, Kansas 67211

AT. 73, MAIN 17, SS# 22

Scale : As Shown | Approved By: BK | Drawn by: LB
Date : 3-87 | Revised :

CITY OF WICHITA, KANSAS

PROJECT # :
468 76 245 81 72 000 000 001

Sheet No. 1 of 1

1/1

PLAN: REVISED, ALIGNMENT CHECKED, NOTE BOOK, NO., BY, DATE

PROFILE: SURVEYED, PLOTTED, GRADE CHECKED, NOTE BOOK, NO., STRUCTURE NUMBERS CHECKED, BY, DATE