



PLAN
 11-53
 J.H.L.

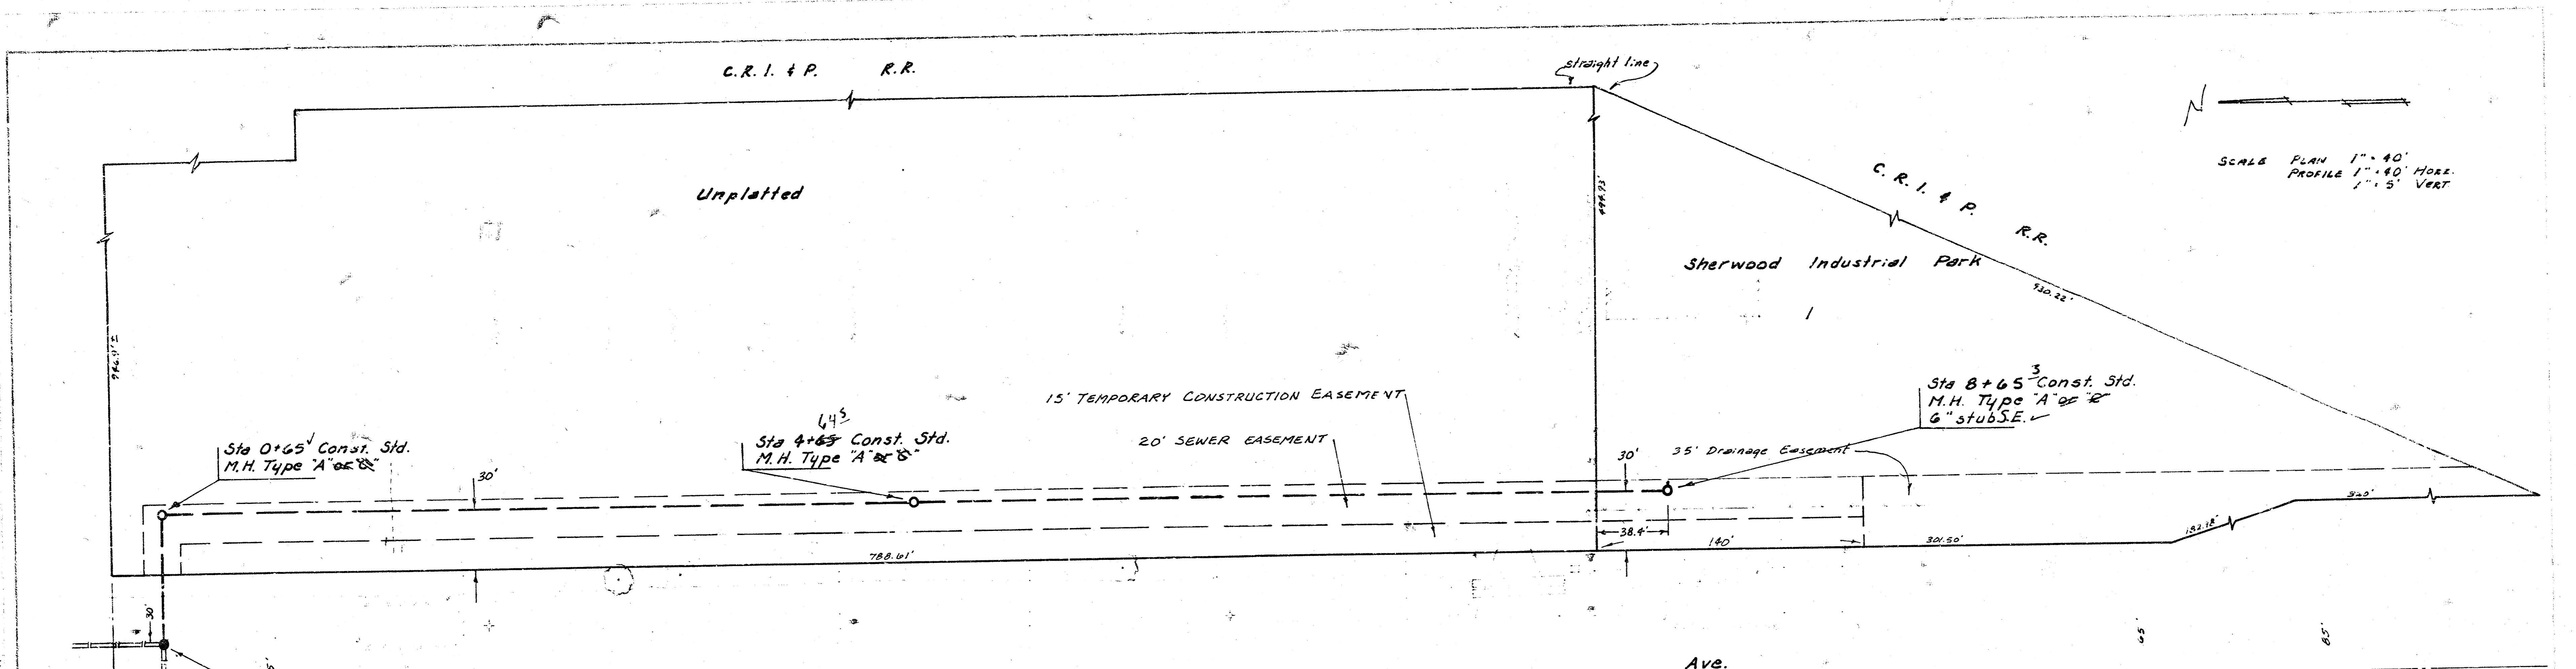

PROFILE

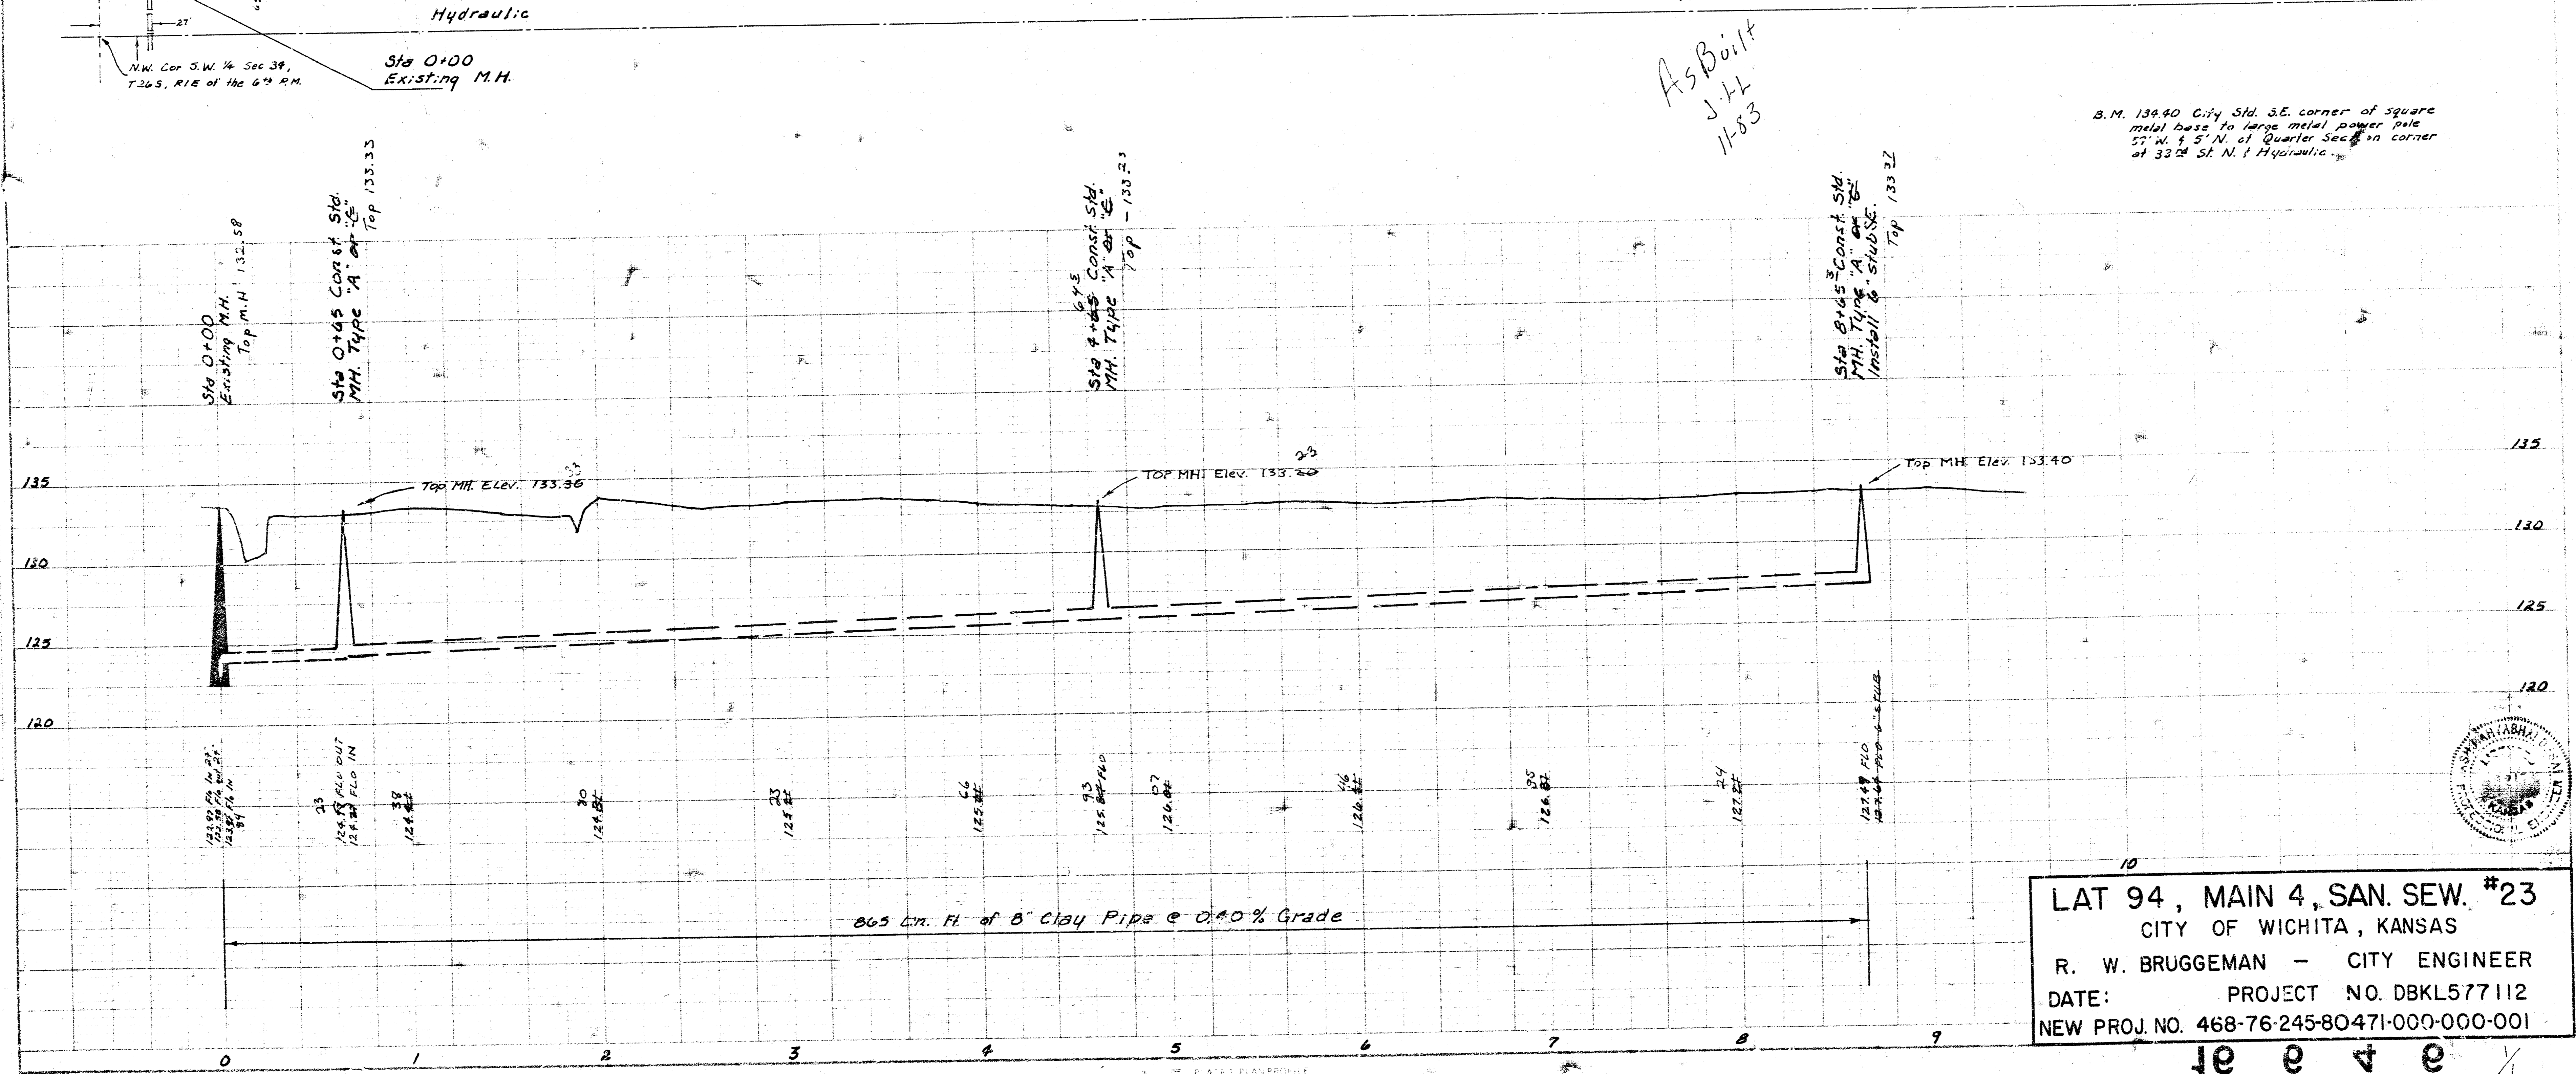

LAT 94, MAIN 4, SAN. SEW. #23
 CITY OF WICHITA, KANSAS
 R. W. BRUGGEMAN - CITY ENGINEER
 DATE: PROJECT NO. DBKL577112
 NEW PROJ. NO. 468-76-245-80471-000-000-001

at 4 a