N

Scale: 1"=40' Plan
Horz. 1"=40' Profile
Vert. 1"=5

Bench Marks:
131.48 - "M" in Mueller Fire Hyd. S.E. Cor. St. Francis and 30th St. No.
131.60 - "M" in Mueller Fire Hyd. S.E. Cor. Mead & 33rd St. No.

Note: Field Engineer shall coordinate construction of sewer such that the restriction of traffic flow is at a minimum during business hours.

THE CONTRACTOR SHALL BE RESPONSIBLE FOR PRESERVING PROPERTY IRONS. THE CONTRACTOR SHALL BE REQUIRED TO RE-SET OR REPLACE ANY PROPERTY IRONS WHICH ARE DAMAGED OR DESTROYED BY HIS CONSTRUCTION OPERATIONS. SUCH IRONS SHALL BE RE-ESTABLISHED BY A LICENSED LAND SURVEYOR OR A LICENSED PROFESSIONAL ENGINEER IN ACCORDANCE WITH STATE LAWS.

CAUTION
UNDERGROUND UTILITIES
Please check with K G & E or Southwestern Bell Telephone Center Location

SANTA FE R. R. R/W.

NORTH

30TH ST.

MEAD AVE.

INDUSTRIAL DISTRICT

Block "A"

Lot 16 Not in Improvement District

Existing MH. Top Elev.=128.36 Flo Elev.=119.12

Existing MH. Top Elev.=129.18 Flo Elev.=119.78

Sta 0+00 Const. Std. MH. Type "A" over existing 8" pipe. Proposed Top Elev. of MH.=127.13

Sta 3+88 Const. Std. MH. Type "A", Proposed Top Elev. of MH.=128.67

Sta 7+82 Const. Std. MH. Type "A". Proposed Top Elev. of MH.=127.76

Sta 9+00 Match Sheet 2

Sanitary Sewer Easement

10' Sanitary Sewer Easement

10' San. Sewer Easm't

Existing Ground

Top of West Curb - MEAD

900 L.F. of 8" V.C.P. @ 0.35% Grade

As Built J.L.L. 3-83



LAT. 108, MAIN 4, S.S.23

PROJECT NO.
468-76-245-81150-000-000-00.


CITY OF WICHITA
DEPT. OF ENGINEERING

R. W. BRUGGEMAN
DIR. of EN. R./CITY ENGINEER

SHEET 1 of 2

N

Scale: 1"=40' Plan
Horz. 1"=40' Profile
Vert. 1"=5'

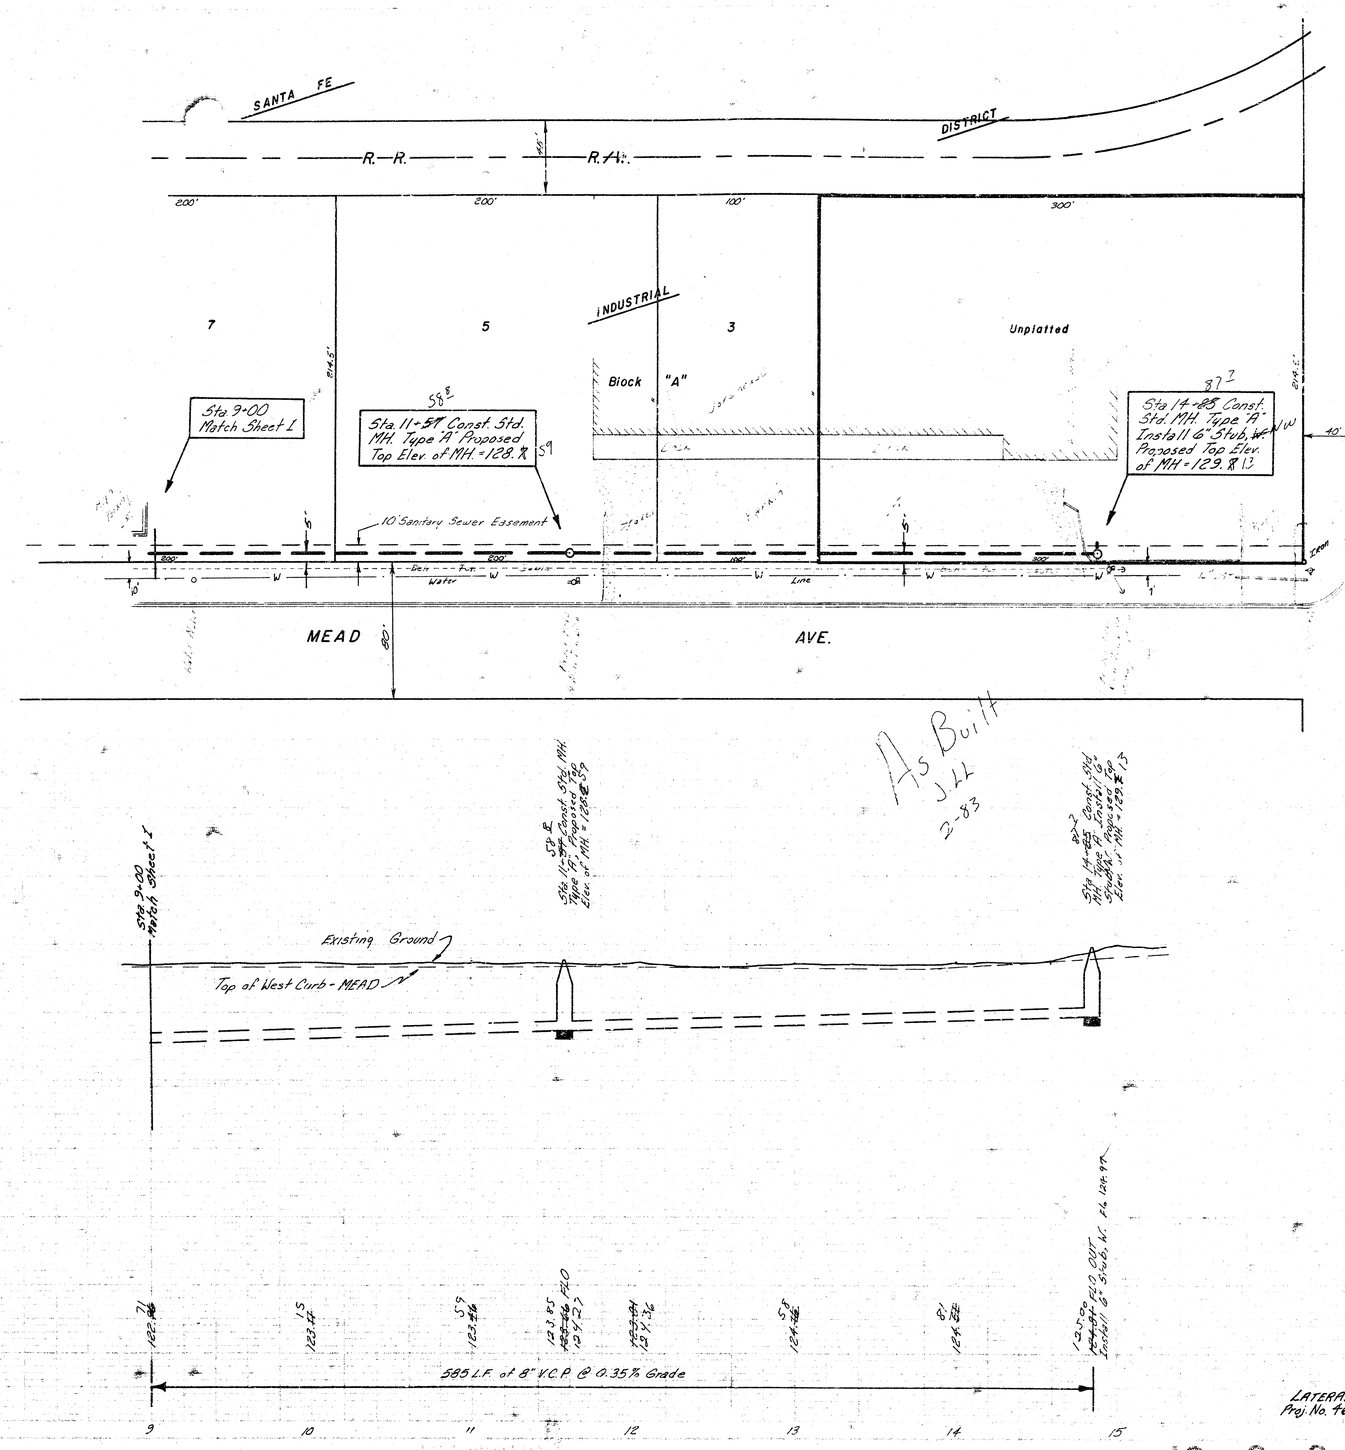

As Built
J.L.L.
2-83

LATERAL 108, MAIN 4, S.S. No. 23
Proj. No. 468-76-245-81150-000-000-001
Sheet 2 of 2