

SHEET
1 of 1

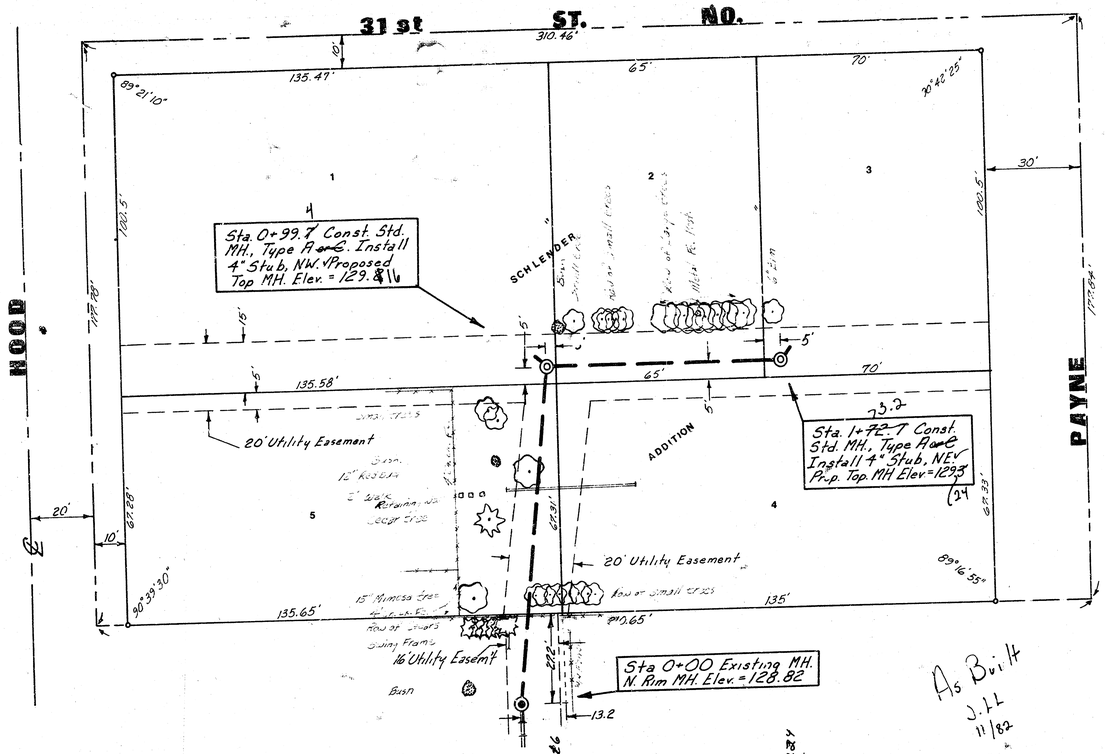

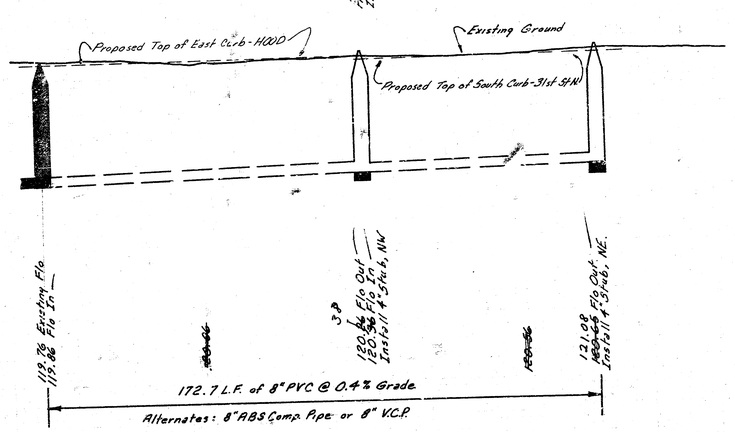

Scale: 1" = 20' Plan
Horz. 1" = 20' Profile
Vert. 1" = 5'

Bench Marks: 125.91 - Disc - NE of 29th & Hood

129.47 - RR Spk., S. fc. PP., N. Side 31st St. No., Across from NE Cor. Lot 1, Schlender Add'n. Pole No. 1320

THE CONTRACTOR SHALL BE RESPONSIBLE FOR PRESERVING PROPERTY IRONS. THE CONTRACTOR SHALL BE REQUIRED TO RE-ESTABLISH ANY PROPERTY IRONS WHICH ARE DAMAGED OR DESTROYED BY HIS CONSTRUCTION OPERATIONS. SUCH IRONS SHALL BE RE-ESTABLISHED BY A LICENSED LAND SURVEYOR OR A LICENSED PROFESSIONAL ENGINEER IN ACCORDANCE WITH STATE LAWS.

As Built
J.L.L.
11/82

NOTE: CONTRACTOR SHALL GIVE ALL PROPERTY OWNERS AND/OR TENANTS OF DEVELOPED PROPERTY WHICH IS DIRECTLY AFFECTED BY THE CONSTRUCTION OF THIS PROJECT A MINIMUM ADVANCE NOTICE OF 48 HOURS PRIOR TO STARTING CONSTRUCTION.

DONALD E. SCHNEIDER
LICENSED
6311
KANSAS
PROFESSIONAL ENGINEER

PROJECT DESCRIPTION	LAT. 709 MAIN 4, S.S. NO. 23
PROJECT NUMBER	468-76-245-81203-000-000-001
BOOK NO. DCD-250	APPROVED BY
DRAWN BY LINDSEY	DATE 6/82 REVISED
CITY OF WICHITA DEPARTMENT OF ENGINEERING	
DIRECTOR OF ENG./CITY ENGINEER R. W. BRUGGEMAN	SCALE

1/1