SHEET 1 OF 1

SCALE
PLAN 1" = 40'
PROFILE 1" = 40' Horz.
1" = 5' Vert.

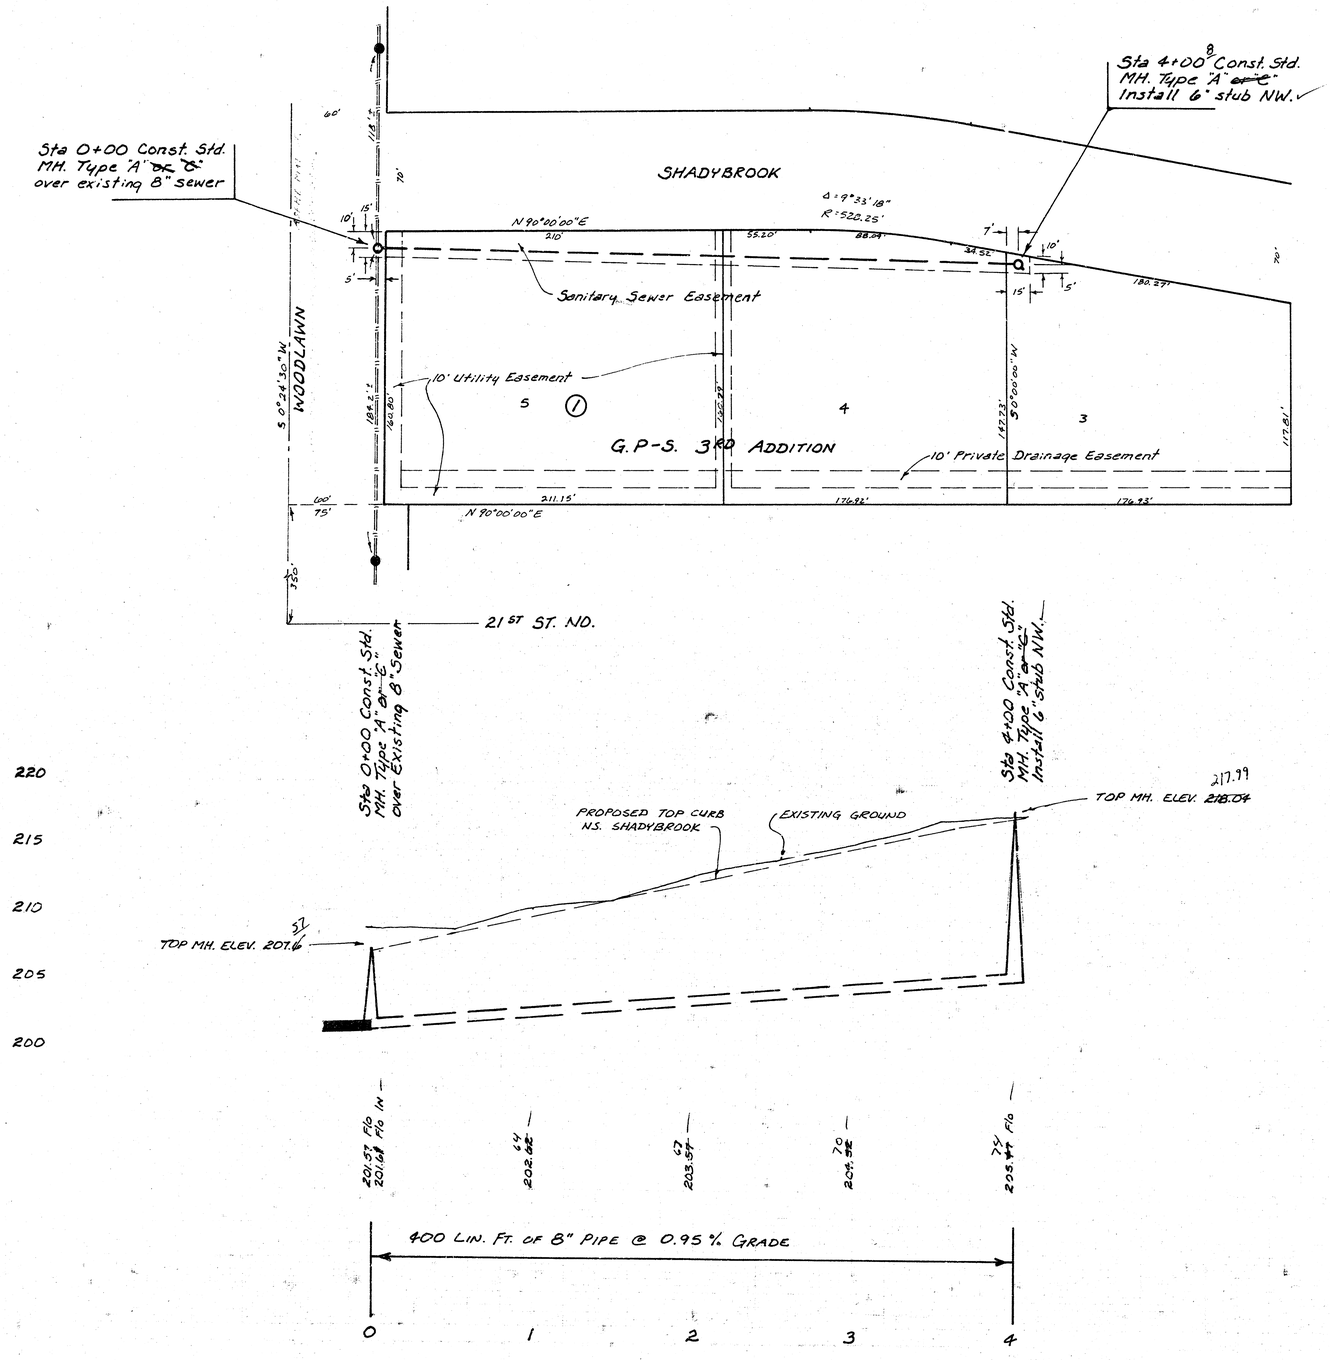

As Built
J.LL
11-82

B.M. 200.65 CITY STD DISC 45.4 FT. EAST AND 45.4 FT. NORTH OF CENTERLINE BOTH WOODLAWN AND 21ST ST. NO.

DONALD E. SCHNEIDER
LICENSED
6311
KANSAS
PROFESSIONAL ENGINEER

PROJECT DESCRIPTION		
LAT 43, MAIN 5, SAN. SEWER NO. 23		
PROJECT NUMBER 468-76-245-81149-000-000-001		
BOOK NO.	APPROVED BY	DATE 4/82
DRAWN BY LOOMIS		REVISED
CITY OF WICHITA DEPARTMENT OF ENGINEERING		
DIRECTOR OF ENG./CITY ENGINEER R. W. BRUGGEMAN		SCALE

13 10 5 2 1/1