

RELOCATION OF A PORTION OF
MAIN 9, SANITARY SEWER 23
PROJ. NO. 468-76-245-80001-000-000-088

SCALE: 1"=40' HORIZ.
1"=5' VERT.

Notes: 1. Rim & Cover from Abandoned MH may be used on a New MH.
2. Bid of Clearing R/W Shall Include:
1. Tree removal if required.
2. Sprinkler system removal & replacement
3. Extra work crossing 27" S.W.S.
4. Reshaping floor of MH 1-4.
5. Sandfill & Plug Abandoned Sewer.

1. Verify elevation of existing 8" sewer on Line 2 @ 0+78.1 before laying Line 2.
2. Reconstruction of berm and reseeding by others.

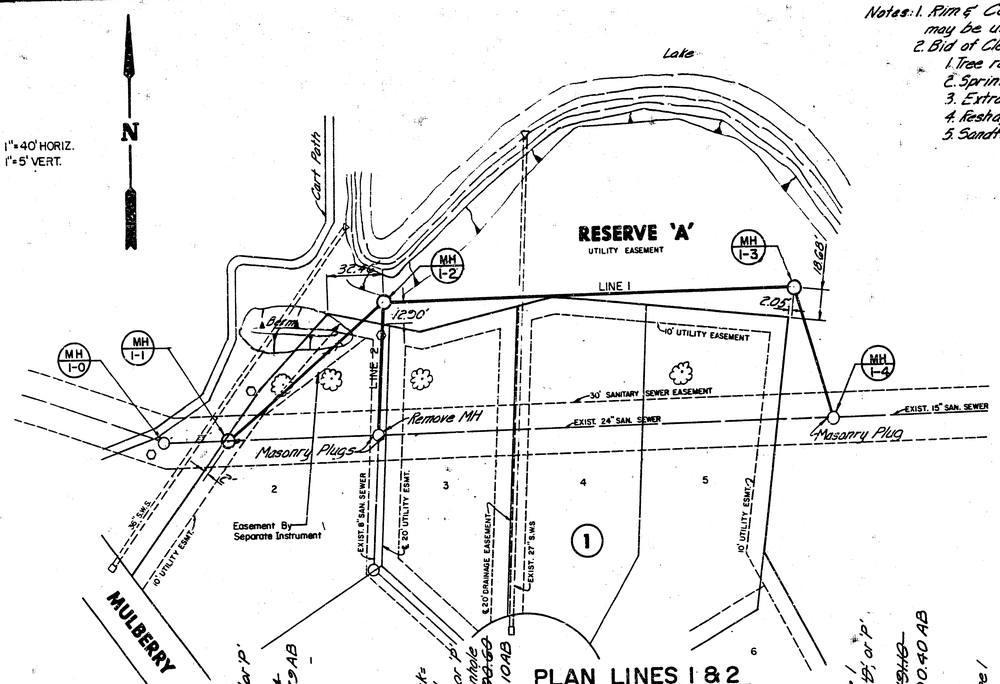

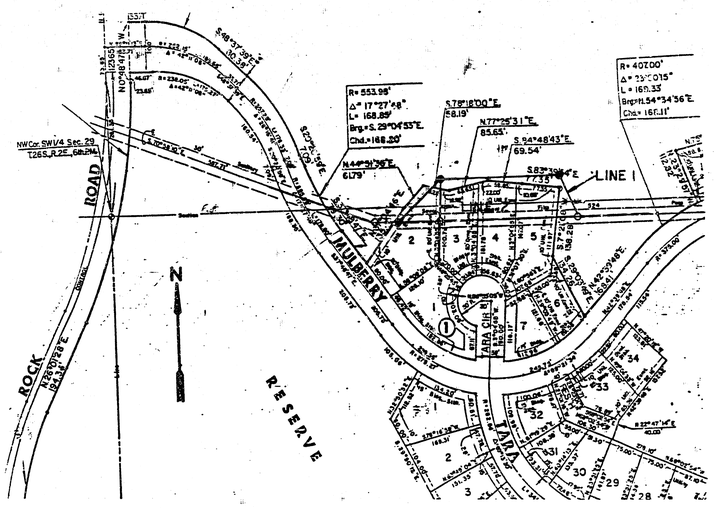

LOCATION MAP

AS BUILT
APRIL, 1987


REVISED
Jan. 21, 1987

REVISED
Feb. 9, 1987


PLAN LINES 1 & 2

B.M. "a" cut on N.E. cor. of Inlet @ the S.W. cor. of Lot 2, Block 1, Willowbend 1st. Elev. 191.82

PROFILE LINE 1

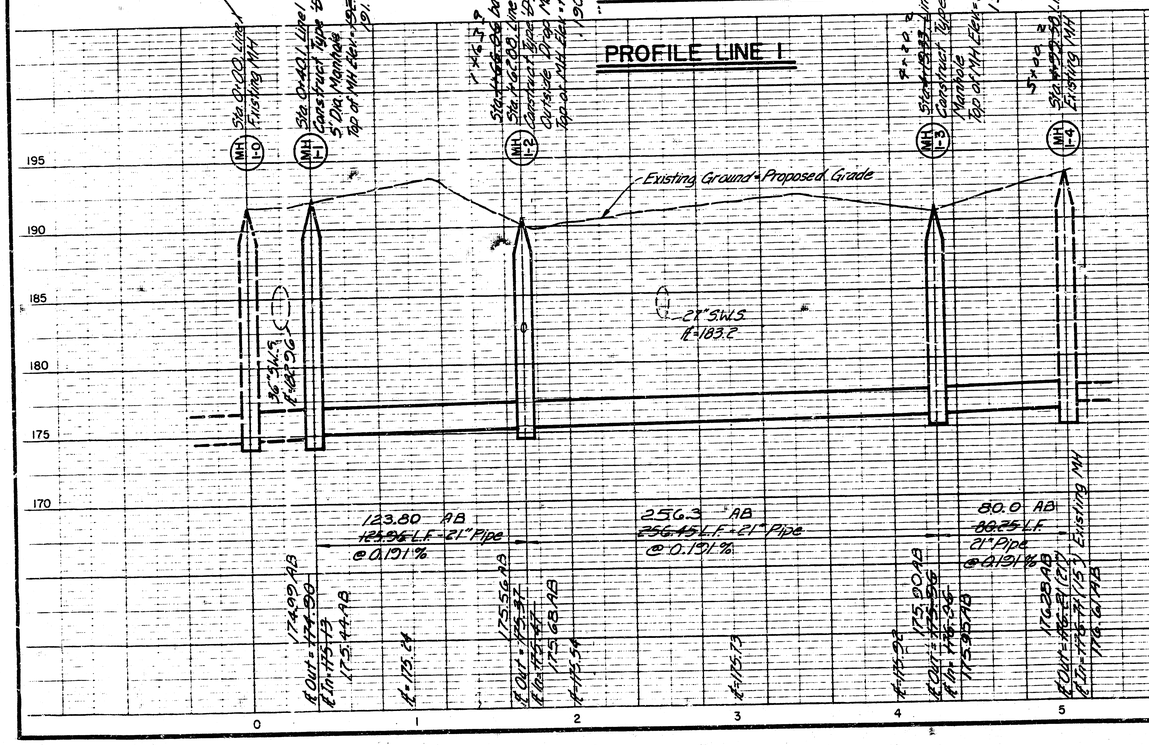

PROFILE LINE 2

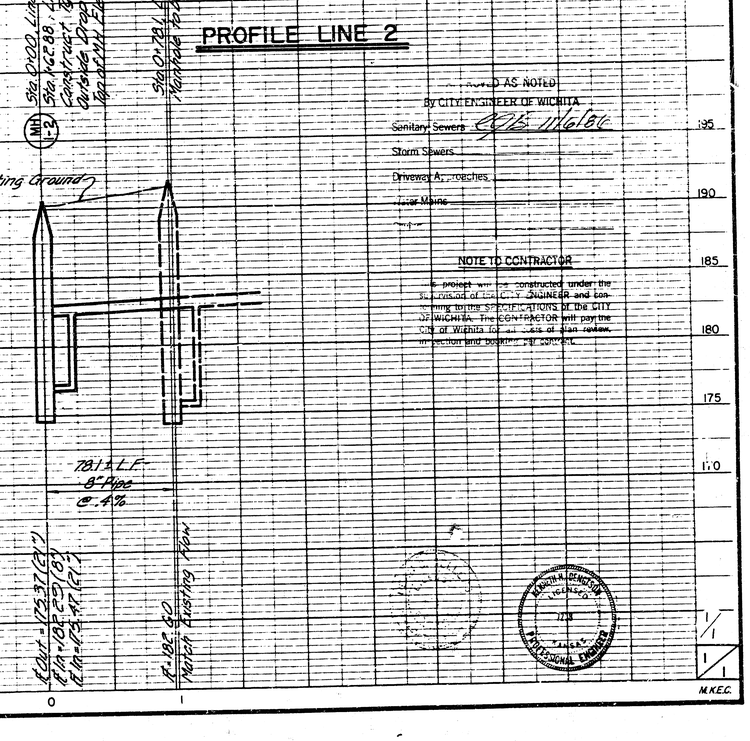

...D AS NOTED
By CITY ENGINEER OF WICHITA
Sanitary Sewers 6/5/1986
Storm Sewers
Driveway Approaches

NOTE TO CONTRACTOR

The project will be constructed under the supervision of the CITY ENGINEER and conforming to the SPECIFICATIONS of the CITY OF WICHITA. The CONTRACTOR will pay the City of Wichita for all costs of plan review, inspection and bookkeeping services.

KEVIN H. DENNISON
LICENSED
7238
PROFESSIONAL ENGINEER

M.K.E.C.

FILMED FROM THE BEST AVAILABLE COPY