
BENCH MARK: Sanitary Sewer Manhole located at the NW corner of the intersection of Harry Street and Hoover Avenue.
Elev. = 113.37 City Datum

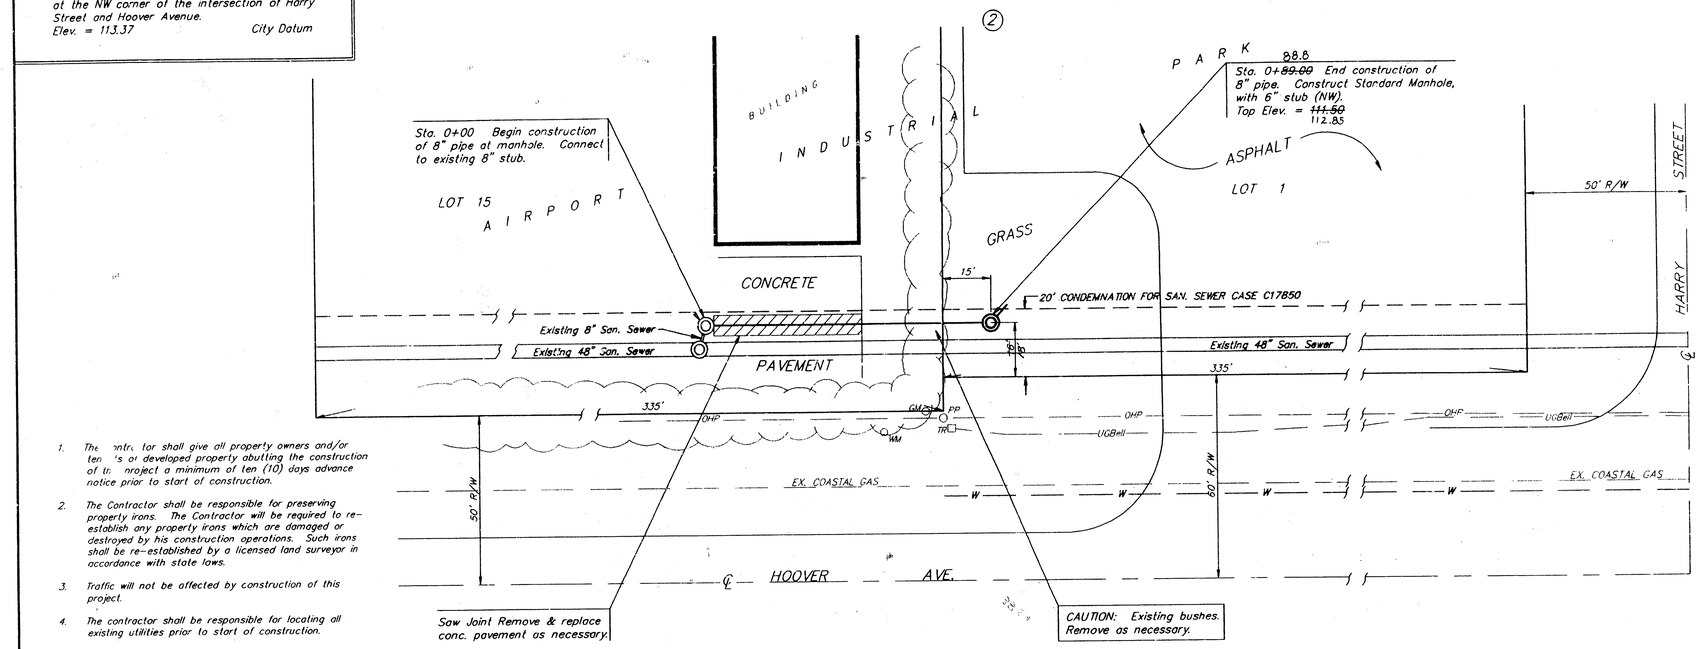


1. The contractor shall give all property owners and/or tenants of developed property abutting the construction of this project a minimum of ten (10) days advance notice prior to start of construction.
2. The Contractor shall be responsible for preserving property irons. The Contractor will be required to re-establish any property irons which are damaged or destroyed by his construction operations. Such irons shall be re-established by a licensed land surveyor in accordance with state laws.
3. Traffic will not be affected by construction of this project.
4. The contractor shall be responsible for locating all existing utilities prior to start of construction.
5. Contractor shall restore project area as required by City of Wichita administration regulation AR-78.

SCALE:
1" = 20' Horiz.
1" = 5' Vert.

APPROVED AS NOTED
BY CITY ENGINEER OF WICHITA
Sanitary Sewers VRH 3/10/93
Storm Sewers
Driveway Approaches
Water Mains
Paving

NOTE TO CONTRACTORS

Inspection and testing for this project is to be provided by a Licensed Consulting Engineering Firm under contract with the Owner/Developer. Said inspection to be in accordance with the City of Wichita standard construction engineering practices and certified by a Licensed Professional Engineer. No work shall be performed in dedicated easements or public right-of-way by the Contractor without such inspection nor shall any work be commenced without written authorization by the City Engineer.

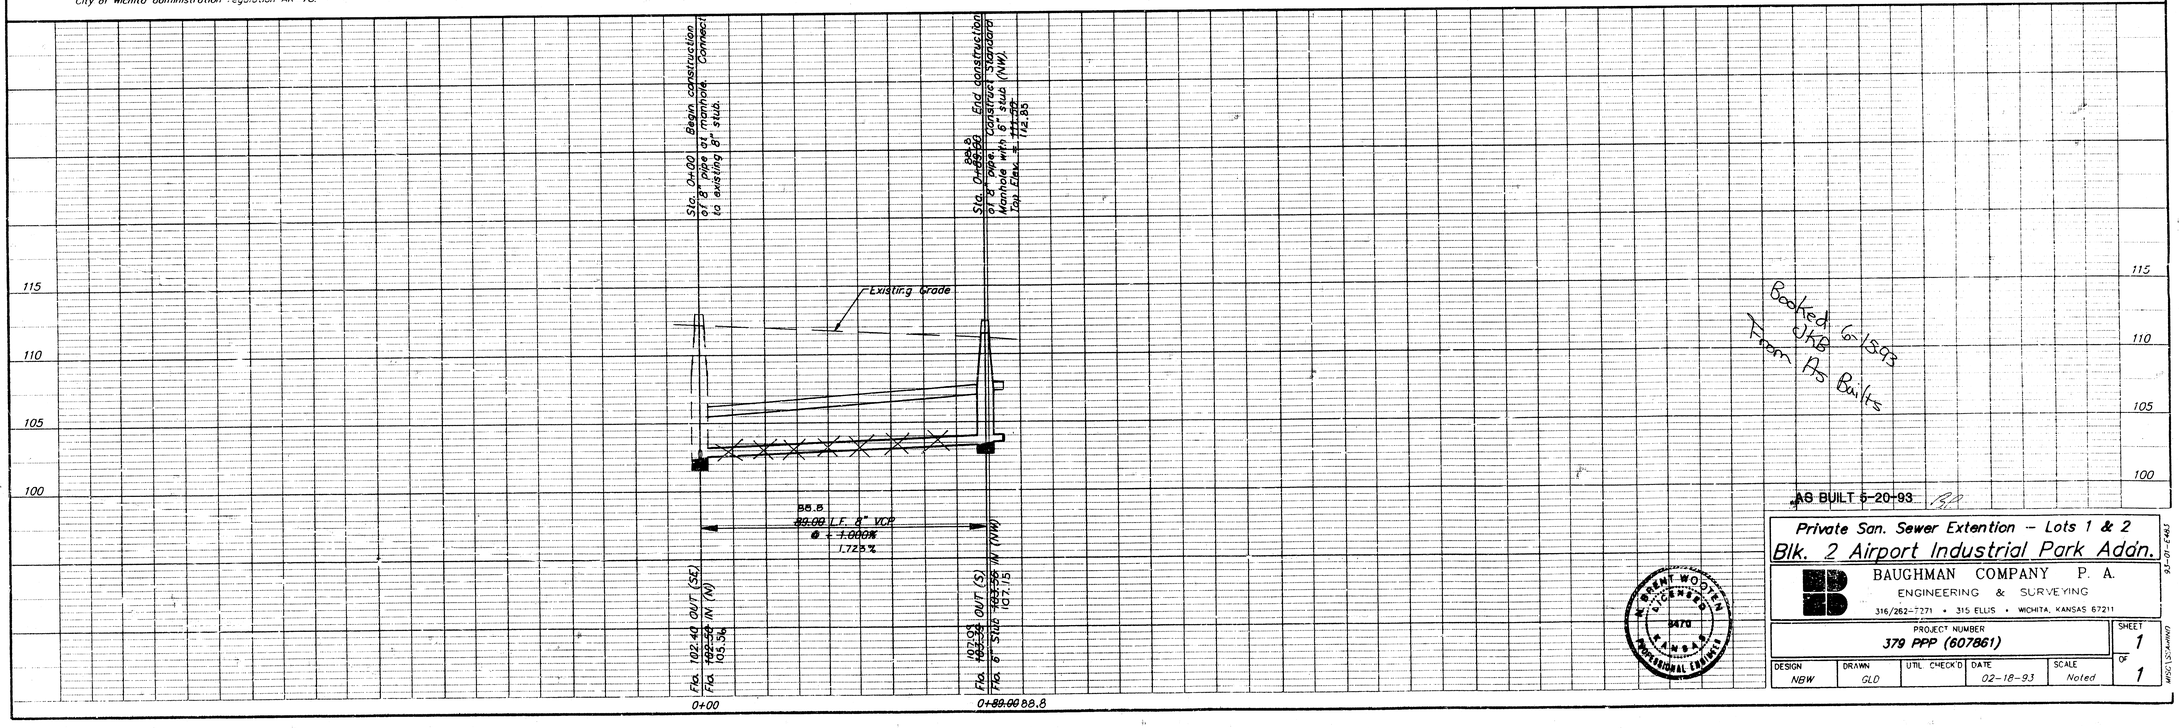

Booked 6/15/93 from As Builts

AS BUILT 5-20-93

Private San. Sewer Extention -- Lots 1 & 2
Blk. 2 Airport Industrial Park Addn.

BAUGHMAN COMPANY P. A.
ENGINEERING & SURVEYING
316/262-7271 • 315 ELLIS • WICHITA, KANSAS 67211

PROJECT NUMBER	SHEET
379 PPP (607861)	1

DESIGN	DRAWN	UTIL CHECK'D	DATE	SCALE	OF
NBW	GLD		02-18-93	Noted	1

W. BRENT WOOTEN LICENSED 9470 KANSAS PROFESSIONAL ENGINEER

93-01-E483